

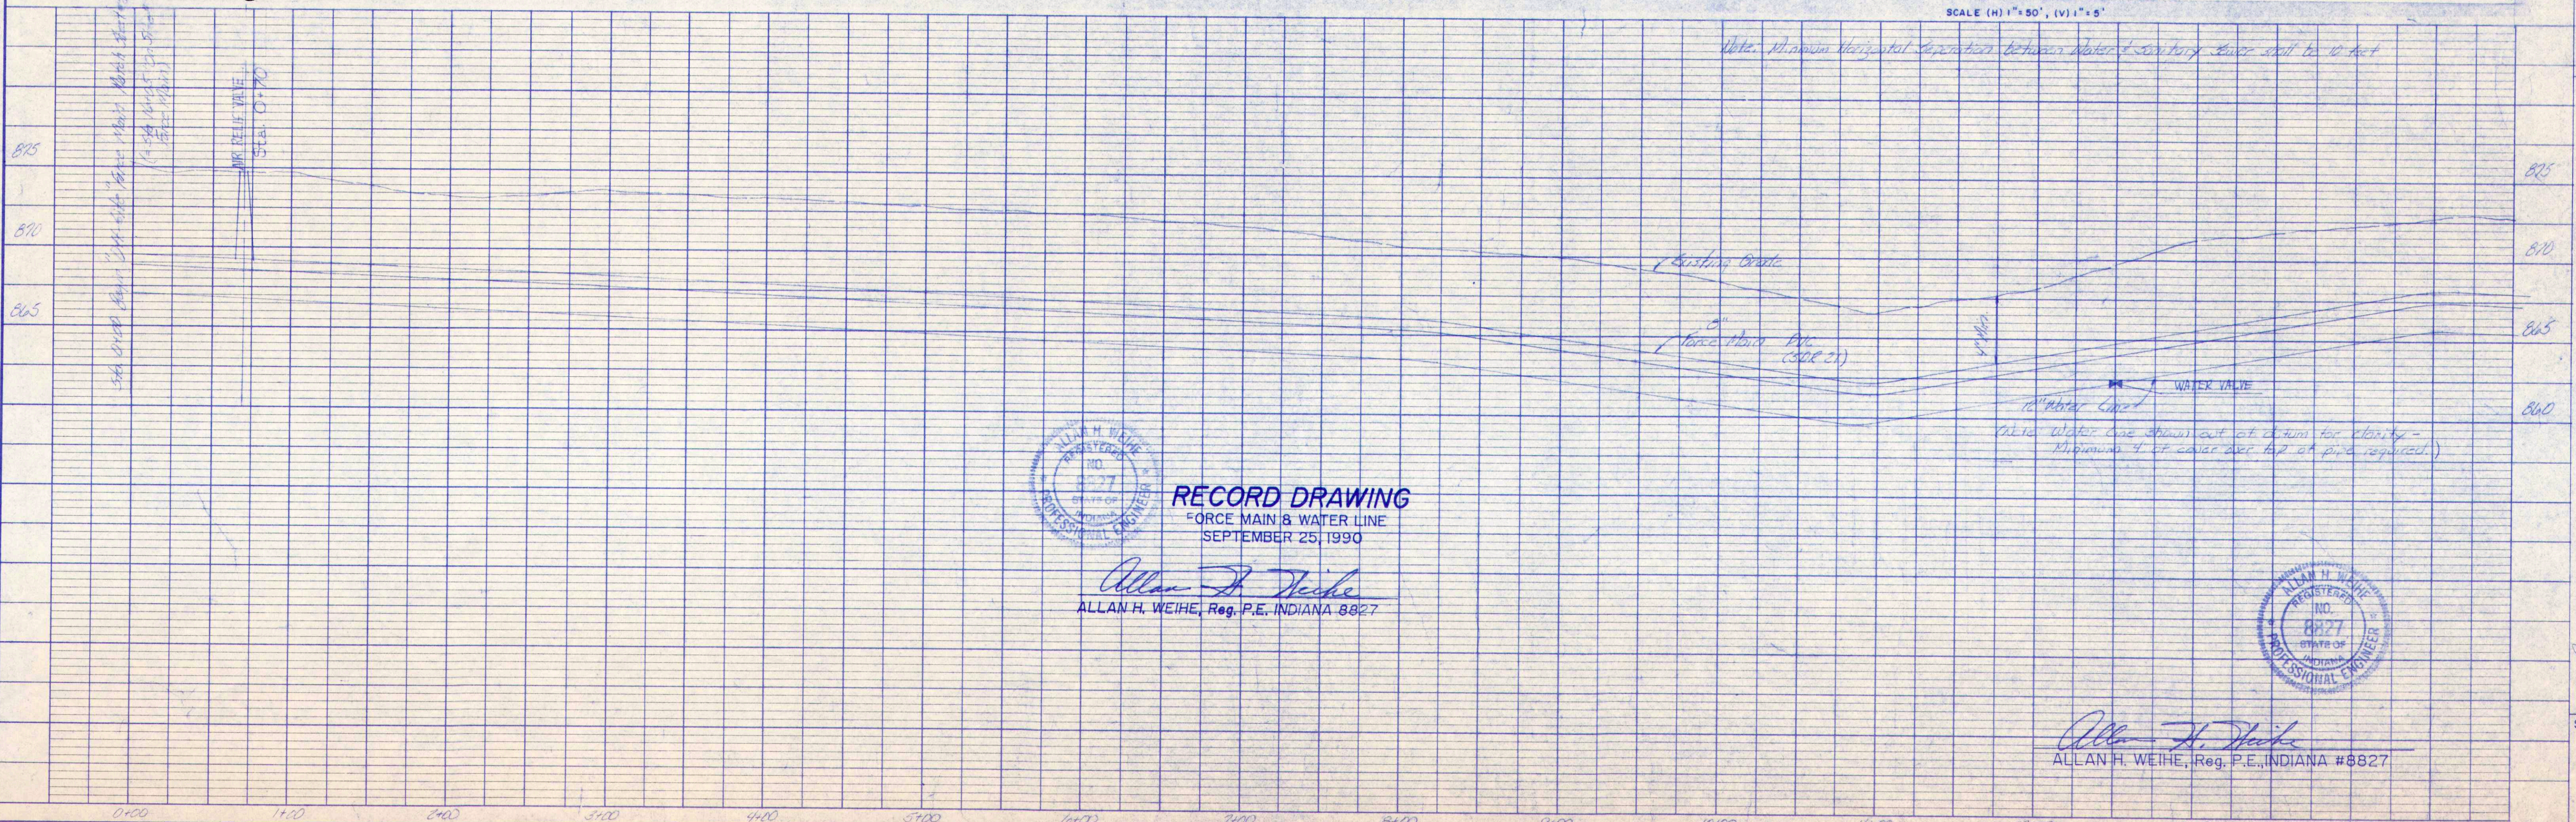


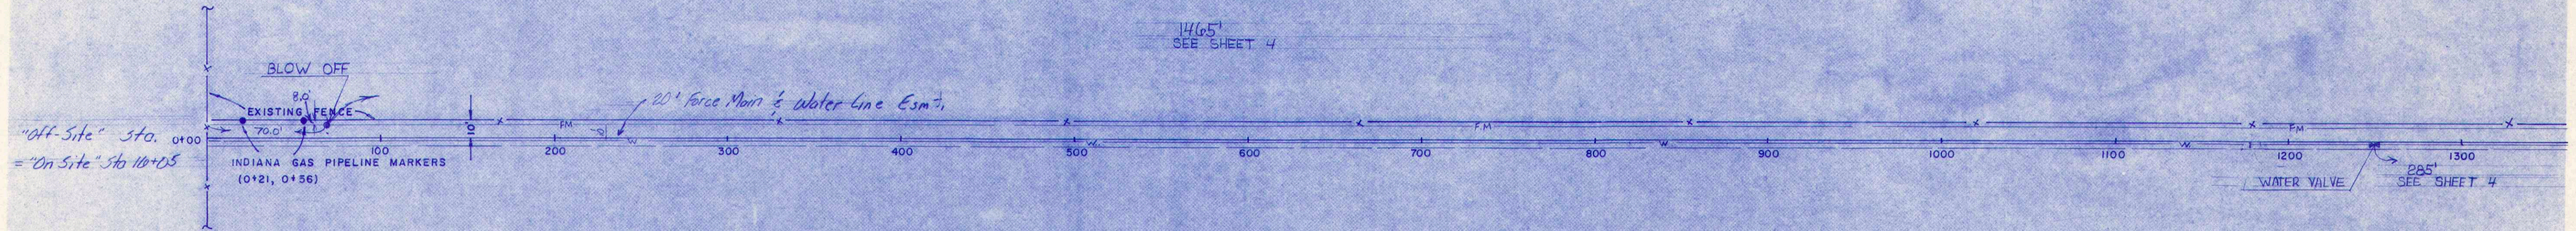

RECORD DRAWING
 FORCE MAIN & WATER LINE
 SEPTEMBER 25, 1990
Allan H. Weihe
 ALLAN H. WEIHE, Reg. P.E., INDIANA 8827

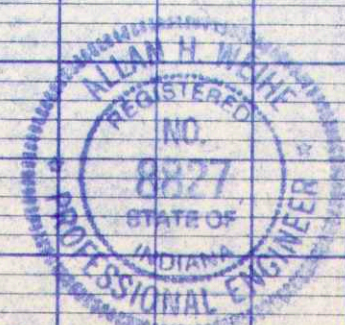

Allan H. Weihe
 ALLAN H. WEIHE, Reg. P.E., INDIANA #8827

WEIHE ENGINEERS INC.
 10505 NORTH COLLEGE AVENUE
 INDIANAPOLIS, INDIANA 46280
 (317) 846 6611

ALLAN H. WEIHE, P.E., L.S.
 PRESIDENT

DATE 9/25/90	BY AWH	CHECKED BY JLS	DATE 9/25/90	#	PAGE
-----------------	-----------	-------------------	-----------------	---	------

REVISIONS
 1. 9/25/90 - 10' to 14' FROM RECORD DRAWING

Prepared For: *Mr. Steve Paul*
 Description: *Ponderton Force Main & Water Line Profile*

SHEET NO
 23

LAND PLANNERS
 LAND SURVEYORS
 CIVIL ENGINEERS