

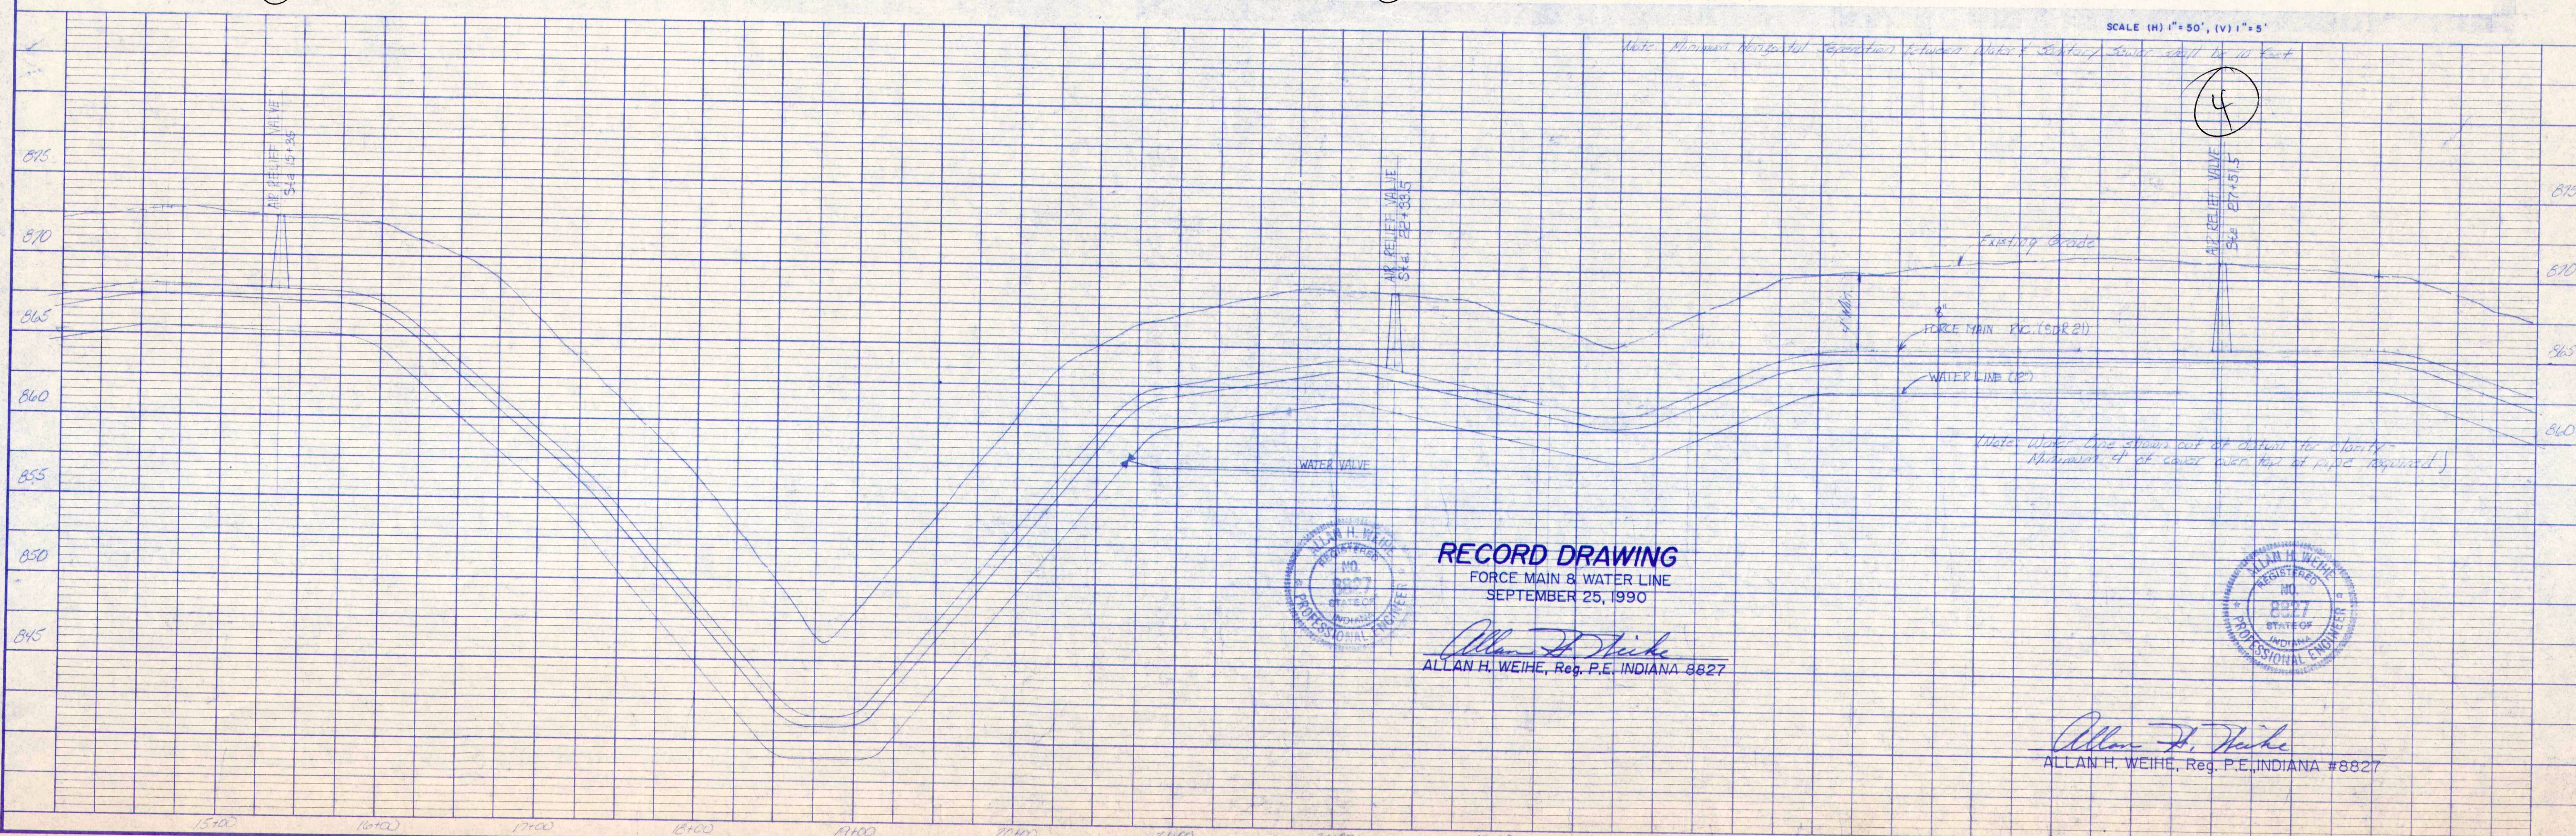


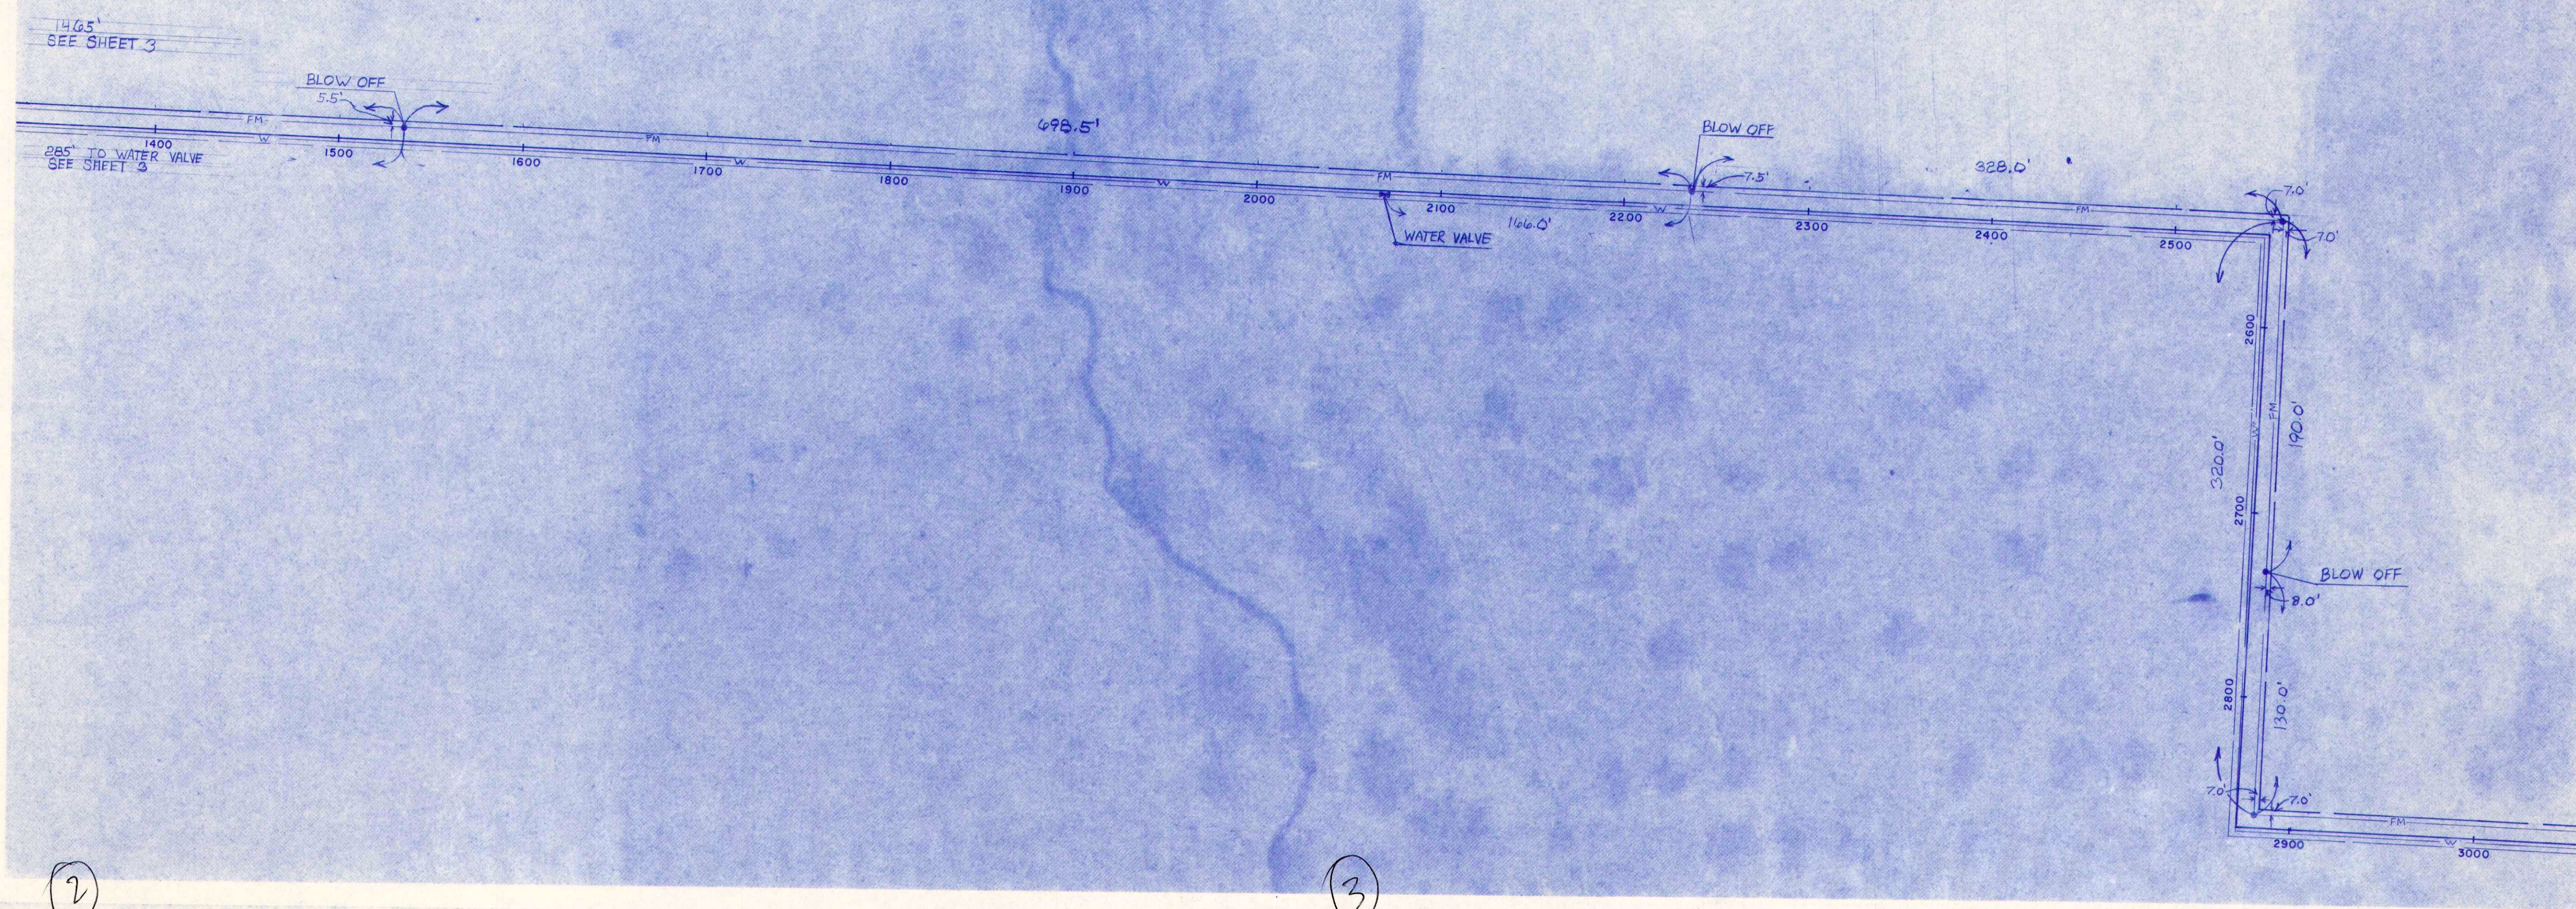

RECORD DRAWING
 FORCE MAIN & WATER LINE
 SEPTEMBER 25, 1990
 Allan H. Weihe
 ALLAN H. WEIHE, Reg. P.E., INDIANA #8827

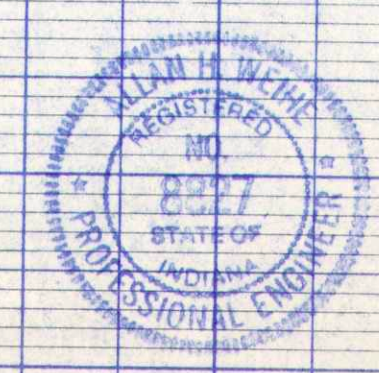

Allan H. Weihe
 ALLAN H. WEIHE, Reg. P.E., INDIANA #8827

WEIHE ENGINEERS INC.
 10505 NORTH COLLEGE AVENUE
 INDIANAPOLIS, INDIANA 46280
 (317) 846-6611

CIVIL ENGINEERS
 LAND SURVEYORS
 LAND PLANNERS

DATE: 9-25-90
 BY: [Signature]
 CHECKED BY: [Signature]
 DATE: 9-25-90

REVISIONS:
 ALL 30' TO 6' MC
 FM 1" W RECORD REMAINING

F. B. PAGE #

SHEET NO. 4