


3/24/90 CH-210, Match Sheet #4

SCALE (H) 1"=50' (V) 1"=5'

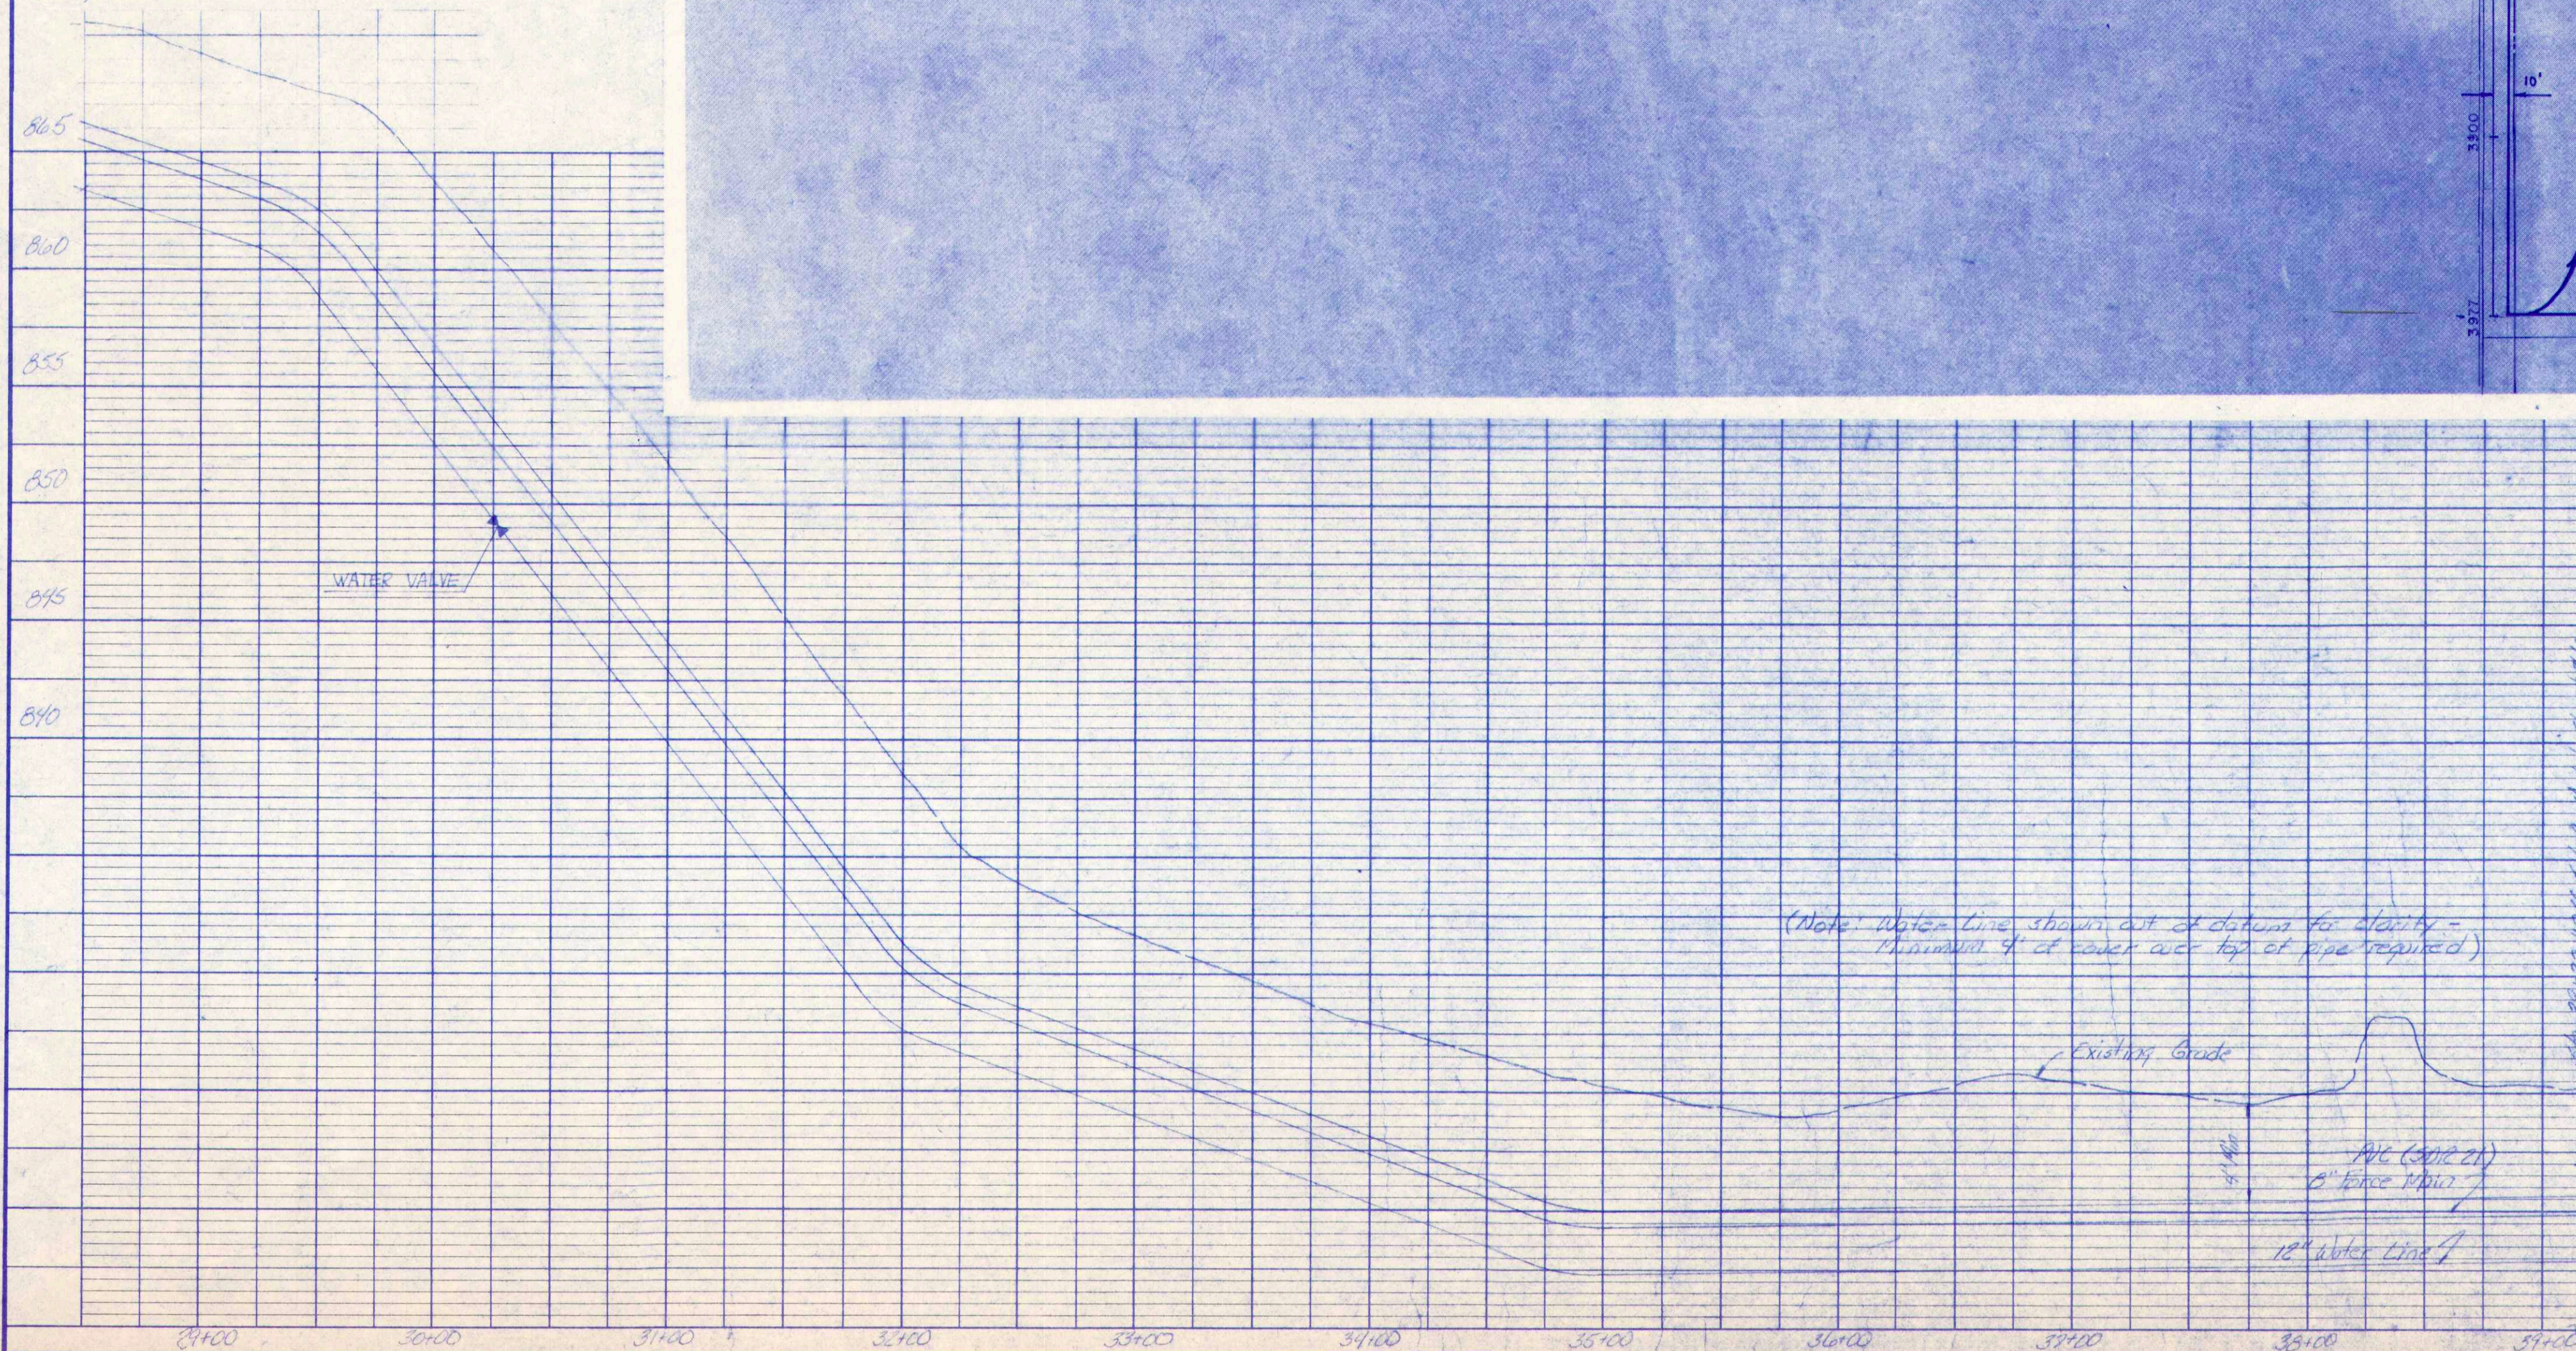

(Note: Water Line shown out of station for clarity - Minimum 4' of cover over top of pipe required)

Existing Grade

12" Water Line




RECORD DRAWING

FORCE MAIN & WATER LINE
SEPTEMBER 25, 1990

Allan H. Weihe
ALLAN H. WEIHE, Reg. P.E., INDIANA 8827



Allan H. Weihe
ALLAN H. WEIHE, Reg. P.E., INDIANA 8827

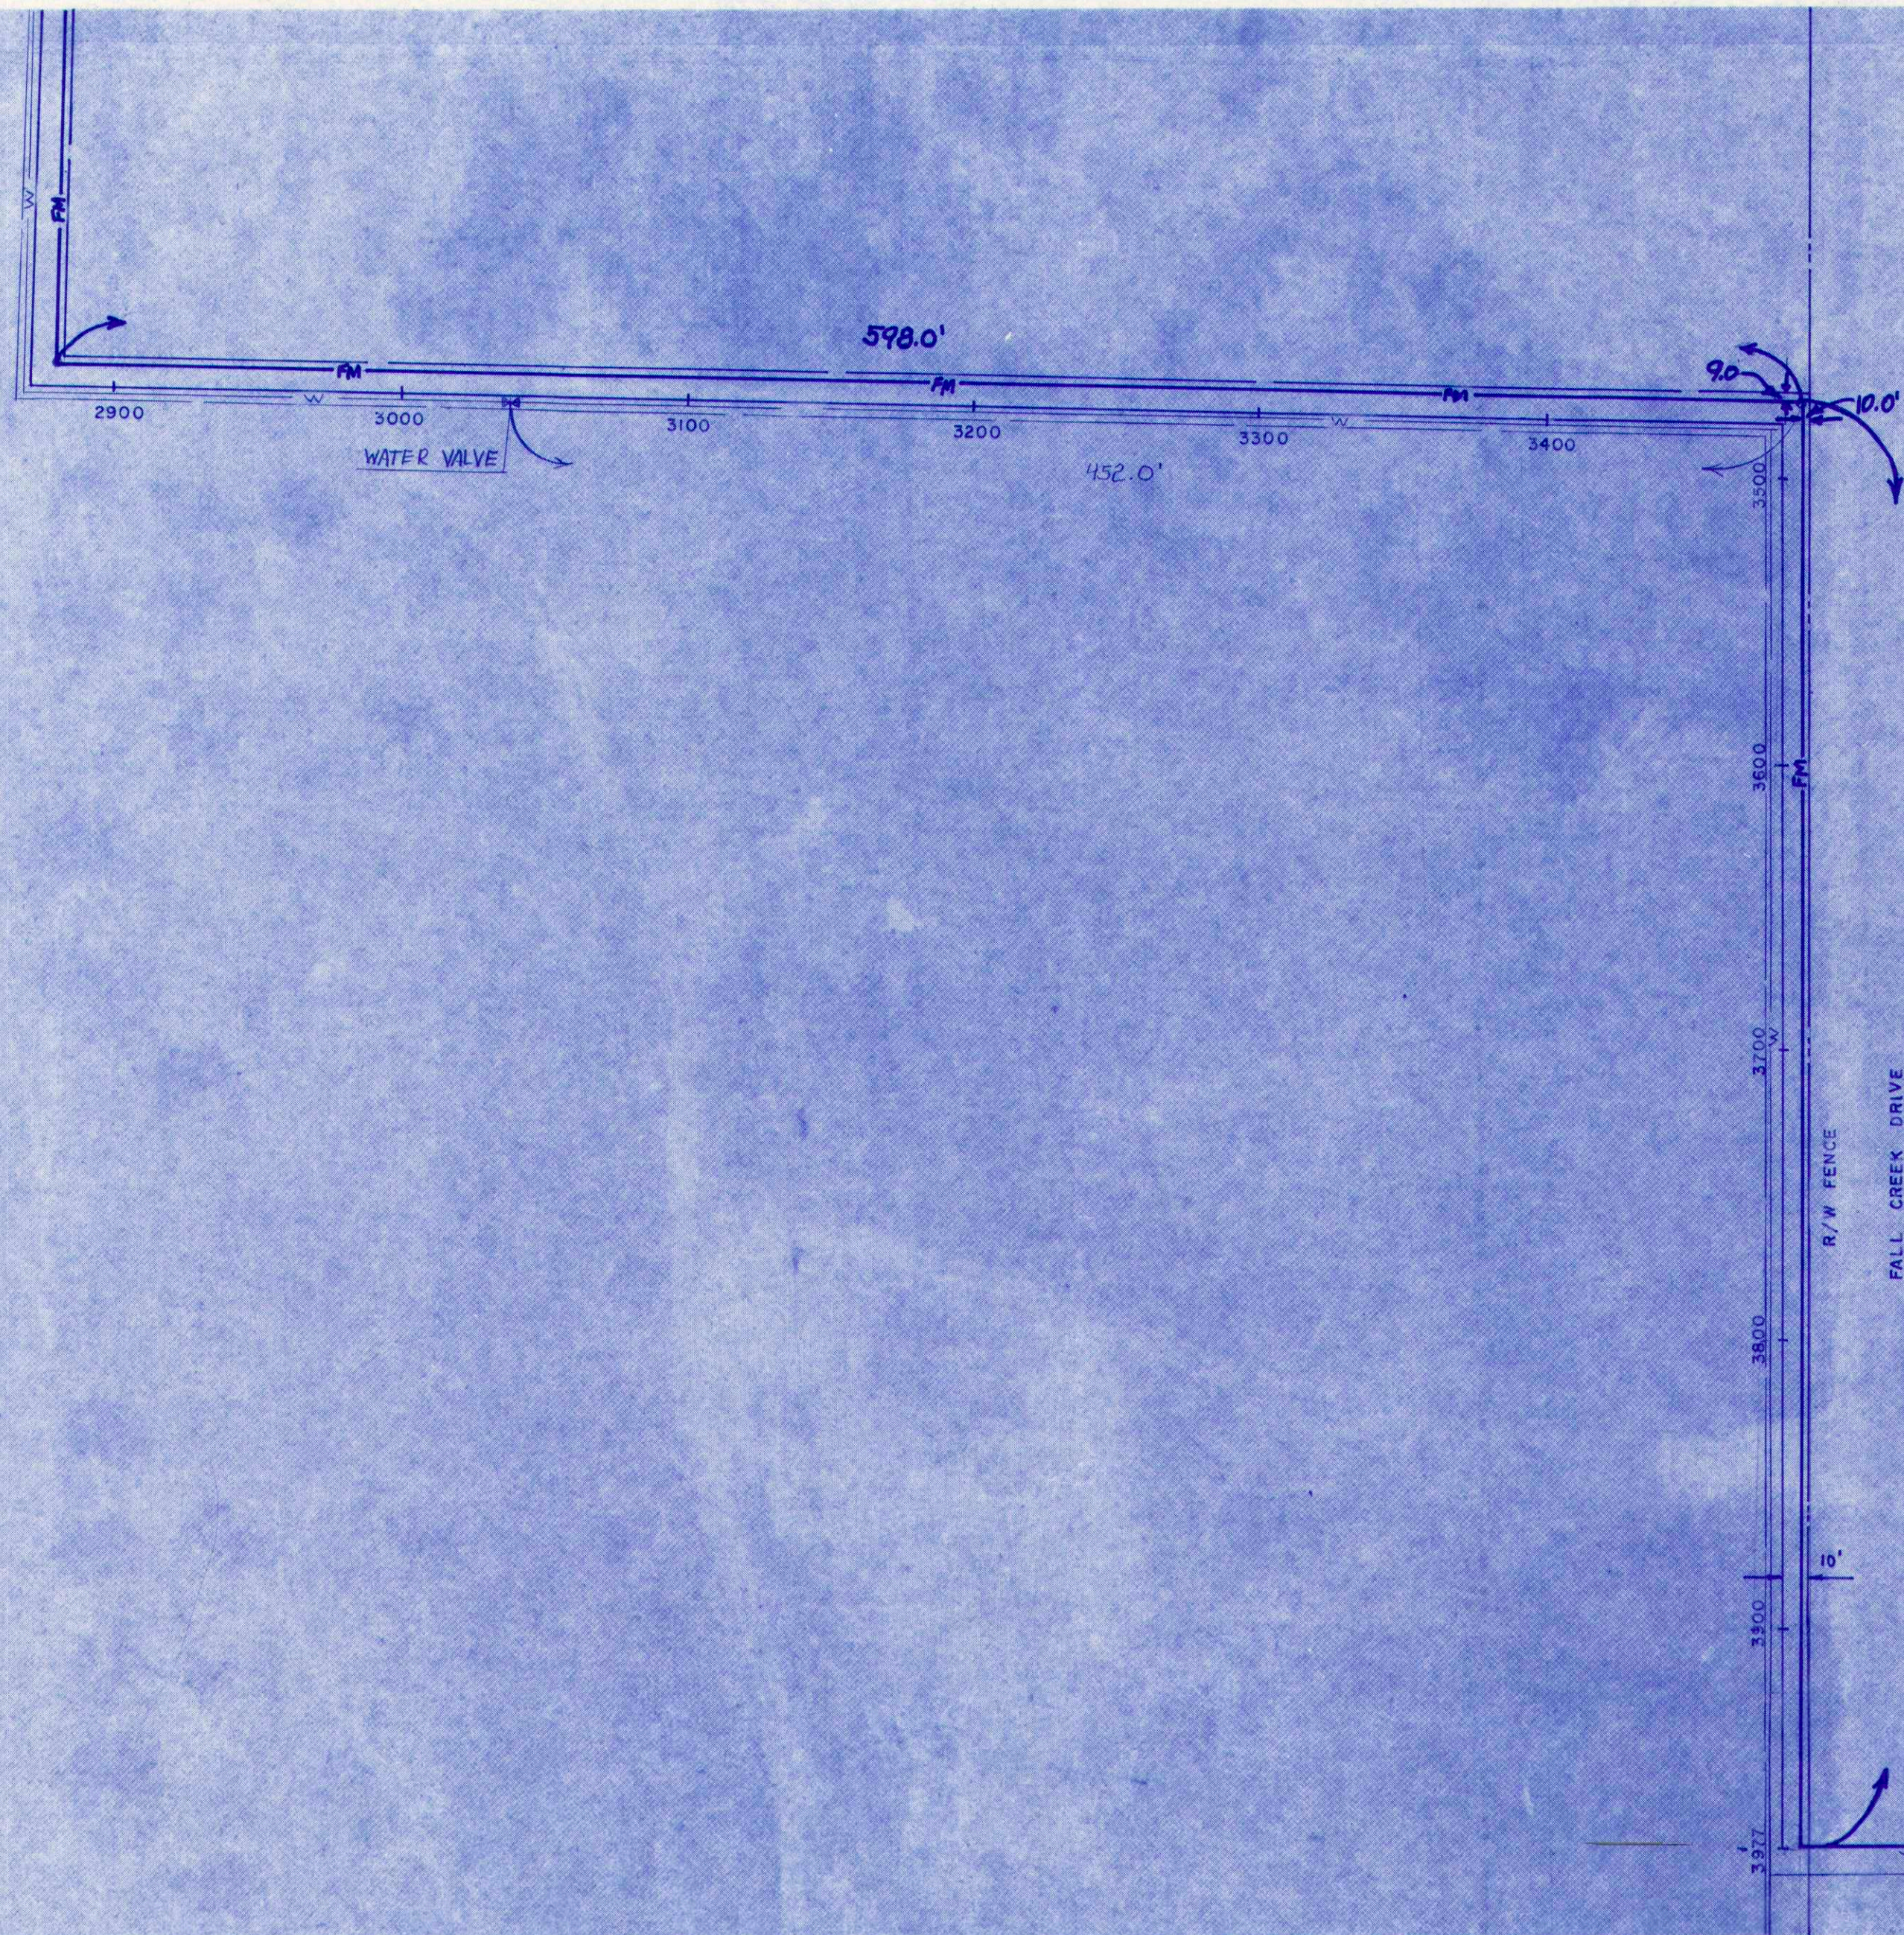

FALL CREEK REGIONAL
WASTE DISTRICT PLANT