



LATERAL LOCATION TABLE

LOT #	PROPOSED STATIONING
55	0+00
56	0+10
57	0+20
58	0+30
59	0+40
60	0+50
61	0+60
62	0+70
63	0+80
64	0+90
65	1+00
66	1+10
67	1+20
68	1+30
69	1+40
70	1+50
71	1+60
72	1+70
73	1+80
74	1+90
75	2+00
76	2+10
77	2+20
78	2+30
79	2+40
80	2+50
81	2+60
82	2+70
83	2+80
84	2+90
85	3+00
86	3+10
87	3+20
88	3+30
89	3+40
90	3+50
91	3+60
92	3+70
93	3+80

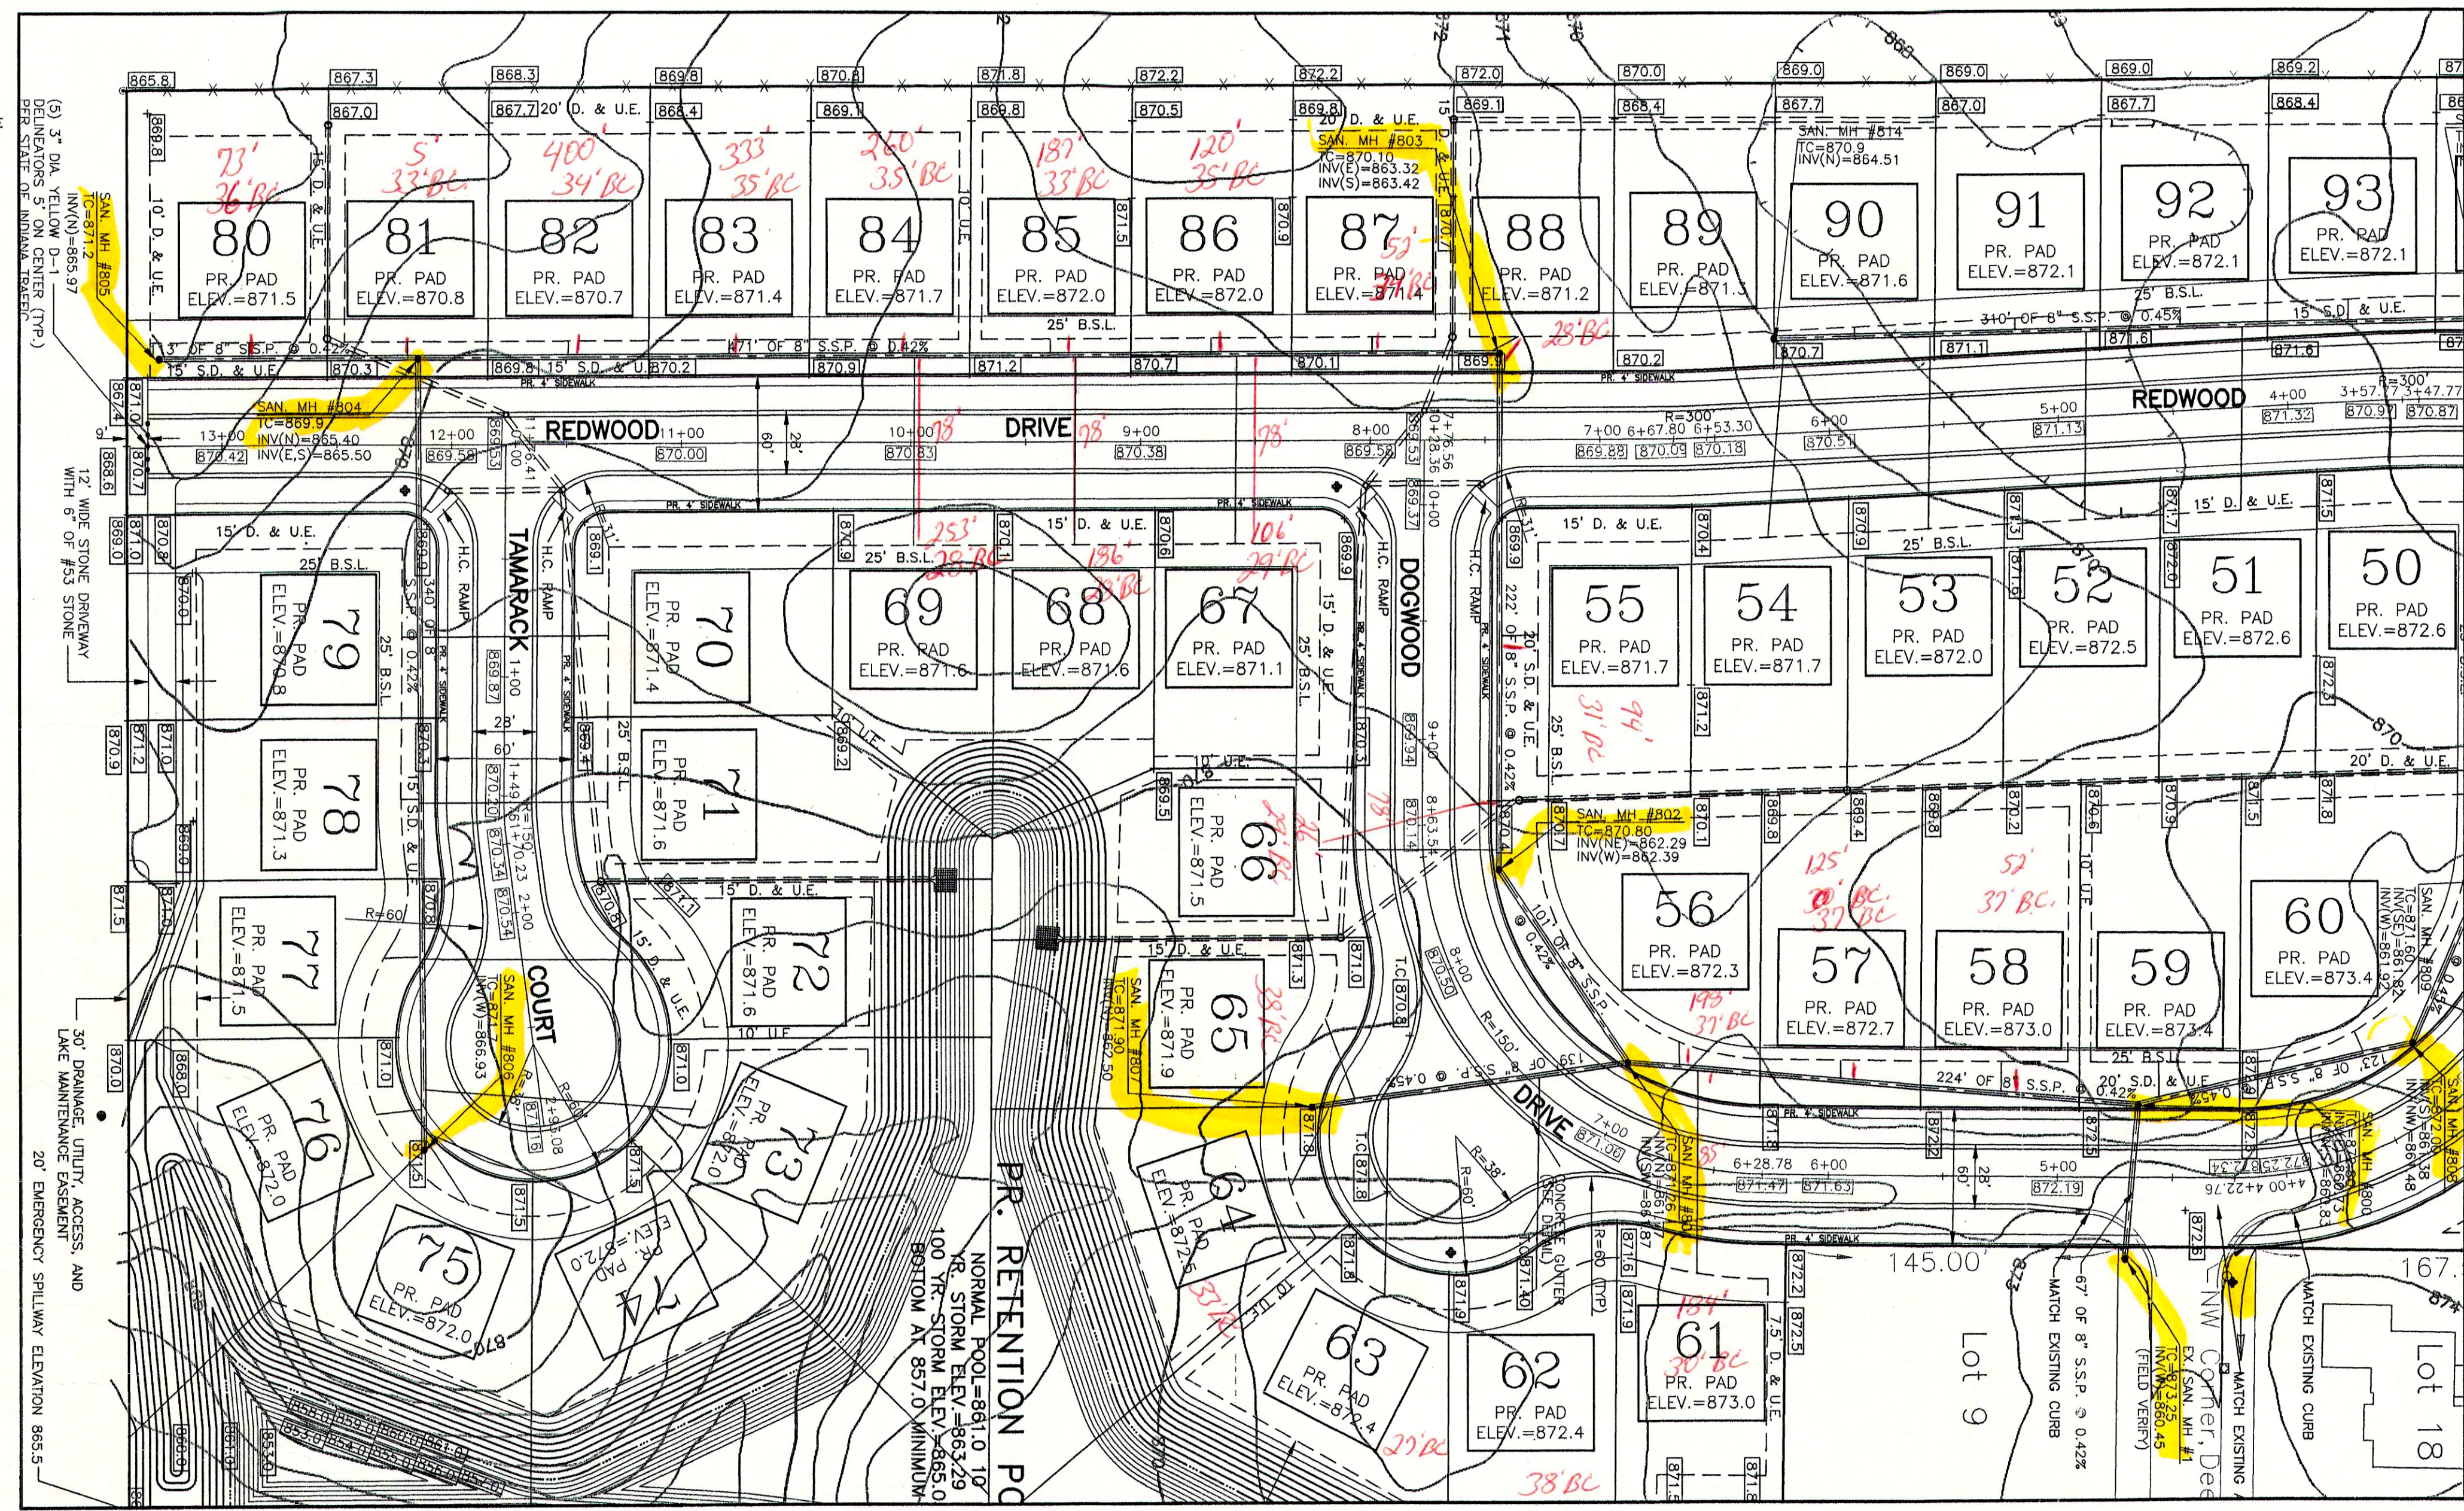


- GENERAL NOTES
- FOR STRUCTURE LOCATIONS SEE DEVELOPMENT PLAN.
 - ALL STATIONING IS SHOWN BEGINNING AT PROPOSED DOWNSTREAM STRUCTURE.
 - IT SHALL BE THE CONTRACTOR'S RESPONSIBILITY TO FIELD VERIFY ALL UTILITY LOCATIONS PRIOR TO ANY CONSTRUCTION ACTIVITY.
 - OCCUPATIONAL SAFETY AND HEALTH ADMINISTRATION (OSHA) STANDARDS FOR EXCAVATIONS: FINAL RULE 29 CFR PART 1926, SUBPART "P" APPLIES TO ALL EXCAVATIONS EXCEEDING FIVE (5) FEET IN DEPTH.
 - IN ADDITION, EXCAVATION EXCEEDING TWENTY (20) FEET IN DEPTH SHALL REQUIRE THE DESIGN OF A TRENCH SAFETY SYSTEM BY A REGISTERED PROFESSIONAL ENGINEER.
 - GRANULAR BACKFILL ALL PIPE LOCATED UNDER AND WITHIN 5' OF PAVED SURFACES. SEE DETAIL SHEET FOR PIPE BEDDING DETAIL.
 - CONTRACTOR SHALL PRESERVE TREES WHERE POSSIBLE.
 - ALL PROPOSED GRADES SHALL MATCH EXISTING GRADES AT PROPERTY LINE.
 - WYE & LATERAL STATIONING IS SHOWN FROM DOWNSTREAM MANHOLE.

- LEGEND
- GRANULAR BACKFILL
 - CONCRETE END SECTION
 - STORM SEWER LINE
 - SANITARY SEWER LINE
 - MANHOLE/INLET
 - CURB INLET
 - TOP OF CASTING
 - INVERT
 - STRUCTURE
 - MANHOLE
 - REINFORCED CONCRETE PIPE
 - SANITARY SEWER PIPE

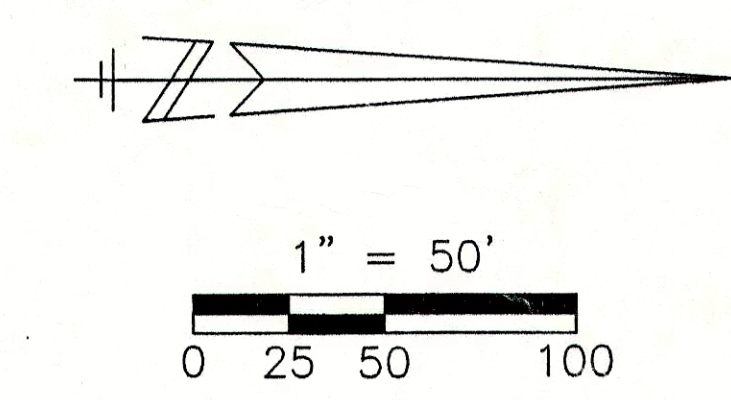

Deerfield Phase II

2447
1-28-82
Robert

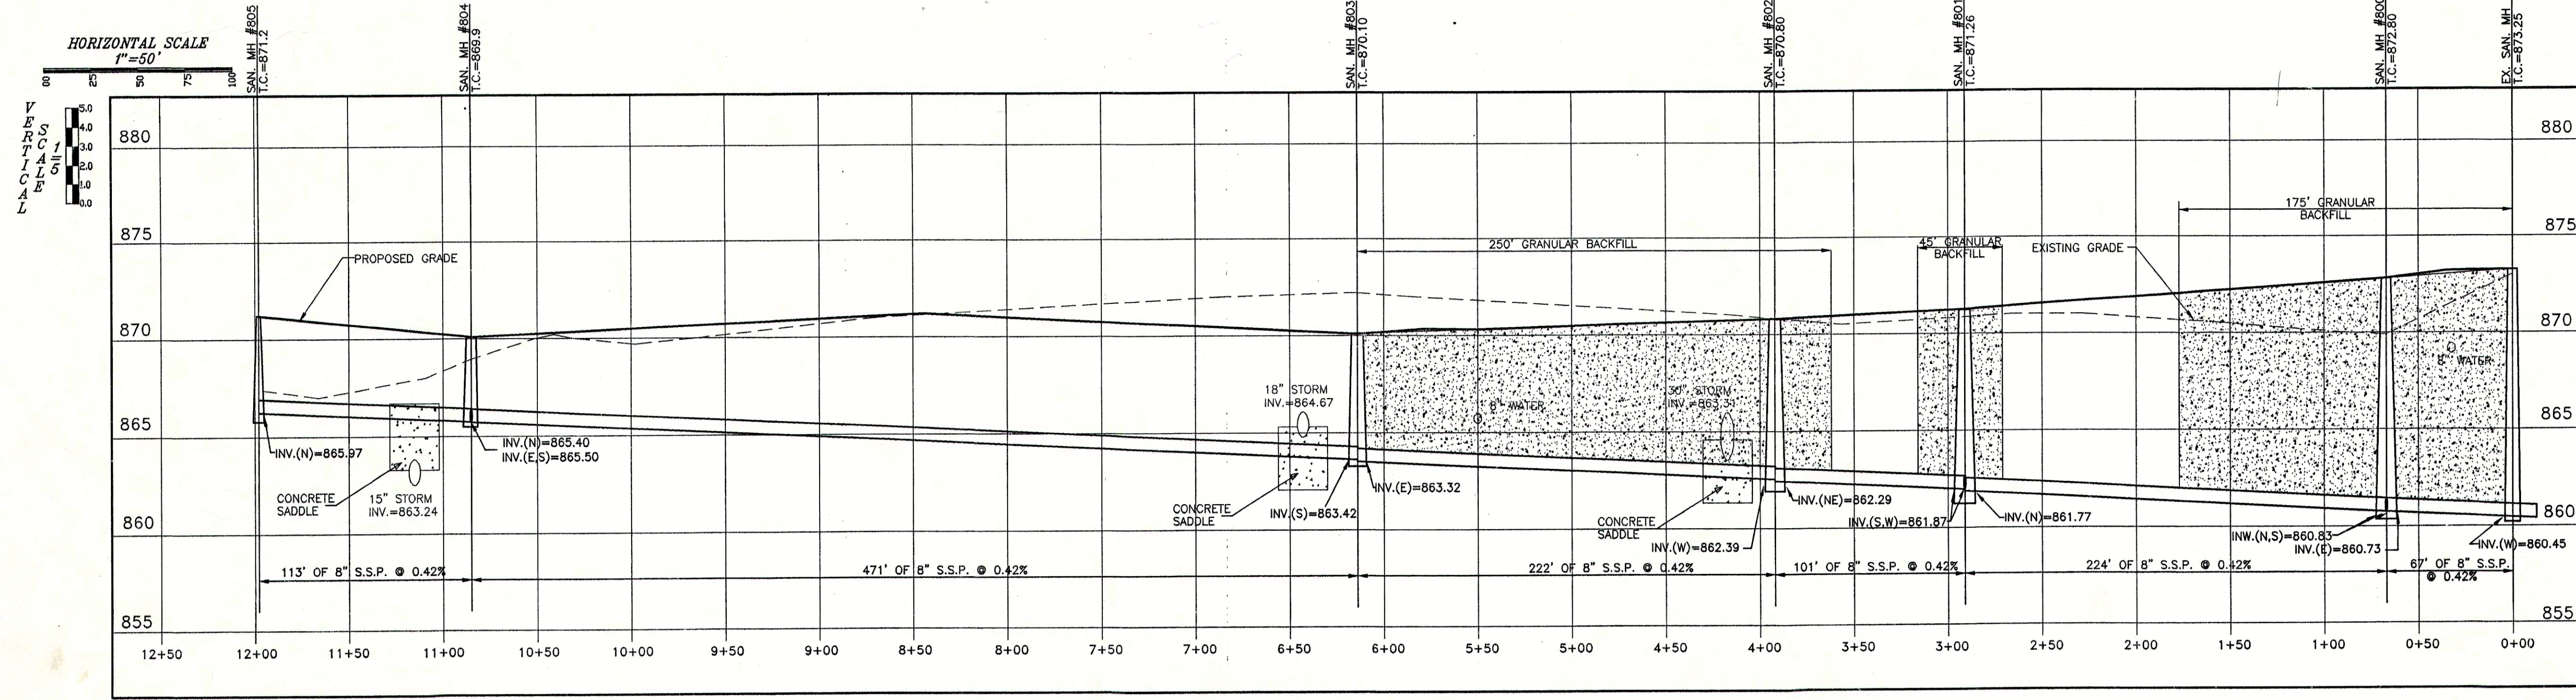

WEIHE ENGINEERS, INC.

10605 NORTH COLLEGE AVENUE
INDIANAPOLIS, INDIANA 46280
(317) 846-6611 FAX: (317) 843-0546
TOLL-FREE (800) 452-6408

ALLAN H. WEIHE
REGISTERED CIVIL ENGINEER
REGISTERED LAND SURVEYOR
PRESIDENT

CIVIL ENGINEERS • LAND SURVEYORS • LAND PLANNERS • LANDSCAPE ARCHITECTS

PROJECT NO.: W02-0541
DATE: 7/22/96
BY: SAG
CHECKED BY: M.M./SAG/LSP
DATE: 7/19/96

REVISIONS AND ISSUES

MINOR REVISIONS PER F.C.R. 6.0.1 & 6.0.2

MINOR REVISIONS PER F.C.R. 6.0.1 & 6.0.2

ALLAN H. WEIHE
REGISTERED
NO. 8827
STATE OF INDIANA
PROFESSIONAL ENGINEER

ALLAN H. WEIHE P.E. 8827

THE PINES AT DEERFIELD SECTION TWO

CORONADO DEVELOPMENT CORP.

SANITARY SEWER PLAN & PROFILE

Part of the #75 Sub. 16, T18N, R2E in Paul Creek Twp., Madison Co., IN

PREPARED FOR:

SHEET NO. 11

PROJECT NO. W02-0541