





LATERAL LOCATION TABLE

LOT #	PROPOSED STATIONING
42	3+09
43	2+70
44	1+95
45	1+25
46	1+26
47	0+52
48	0+12
49	0+22
50	1+25
59	0+10
60	1+00
94	0+14
95	0+87
96	1+60
97	2+30
98	0+42
99	0+37
100	1+15
101	1+85
102	2+65
103	3+08

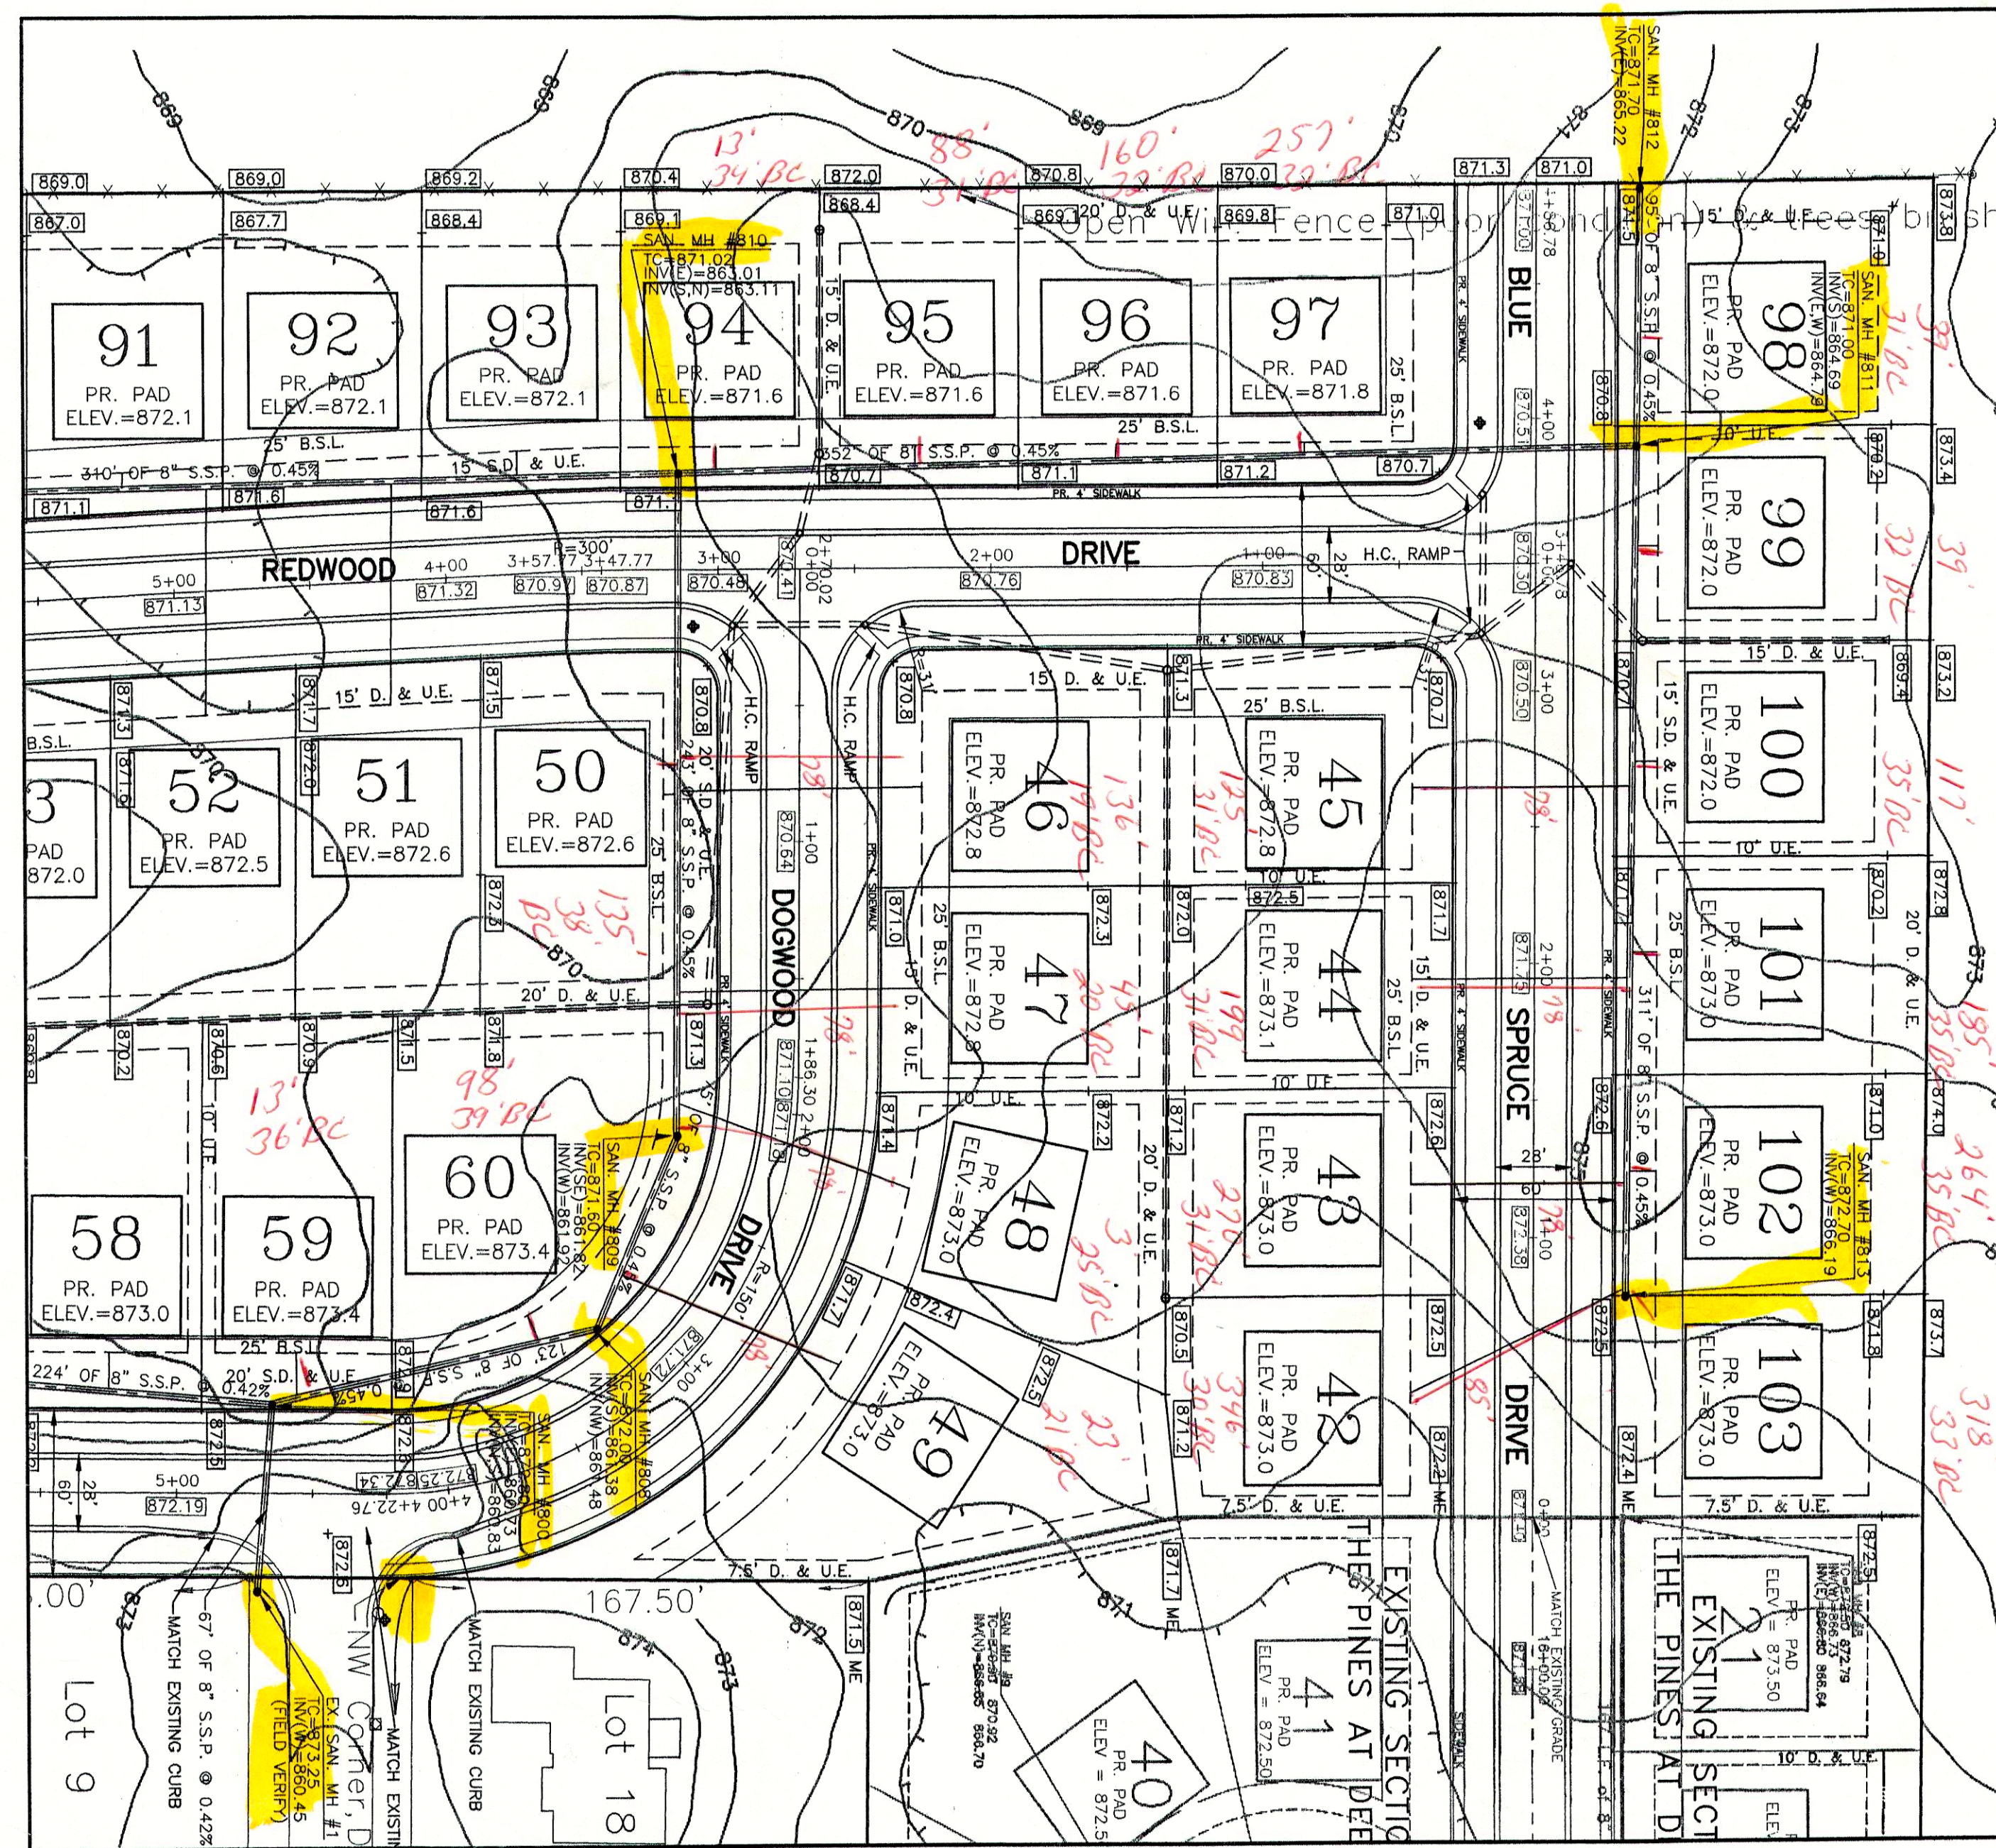

- GENERAL NOTES
- FOR STRUCTURE LOCATIONS SEE DEVELOPMENT PLAN.
 - ALL STATIONING IS SHOWN BEGINNING AT PROPOSED DOWNSIDE STRUCTURE.
 - IT SHALL BE THE CONTRACTOR'S RESPONSIBILITY TO FIELD VERIFY ALL UTILITY LOCATIONS PRIOR TO ANY CONSTRUCTION ACTIVITY.
 - OCCUPATIONAL SAFETY AND HEALTH ADMINISTRATION (OSHA) STANDARDS FOR EXCAVATIONS: FINAL RULE 29 CFR PART 1926, SUBPART "P" APPLIES TO ALL EXCAVATIONS EXCEEDING FIVE (5) FEET IN DEPTH.
 - IN ADDITION, EXCAVATION EXCEEDING TWENTY (20) FEET IN DEPTH SHALL REQUIRE THE DESIGN OF A TRENCH SAFETY SYSTEM BY A REGISTERED PROFESSIONAL ENGINEER.
 - GRANULAR BACKFILL: ALL PIPE LOCATED UNDER AND WITHIN 5' OF PAVED SURFACES: SEE DETAIL SHEET FOR PIPE BEDDING DETAIL.
 - CONTRACTOR SHALL PRESERVE TREES WHERE POSSIBLE.
 - ALL PROPOSED GRADES SHALL MATCH EXISTING GRADES AT PROPERTY LINE.
 - WYE & LATERAL STATIONING IS SHOWN FROM DOWNSIDE MANHOLE.

- LEGEND
- GRANULAR BACKFILL
 - CONCRETE END SECTION
 - STORM SEWER LINE
 - SANITARY SEWER LINE
 - MANHOLE/INLET
 - CURB INLET
 - INV.=INVERT
 - STR.=STRUCTURE
 - MH.=MANHOLE
 - RCP=REINFORCED CONCRETE PIPE
 - SSP=SANITARY SEWER PIPE

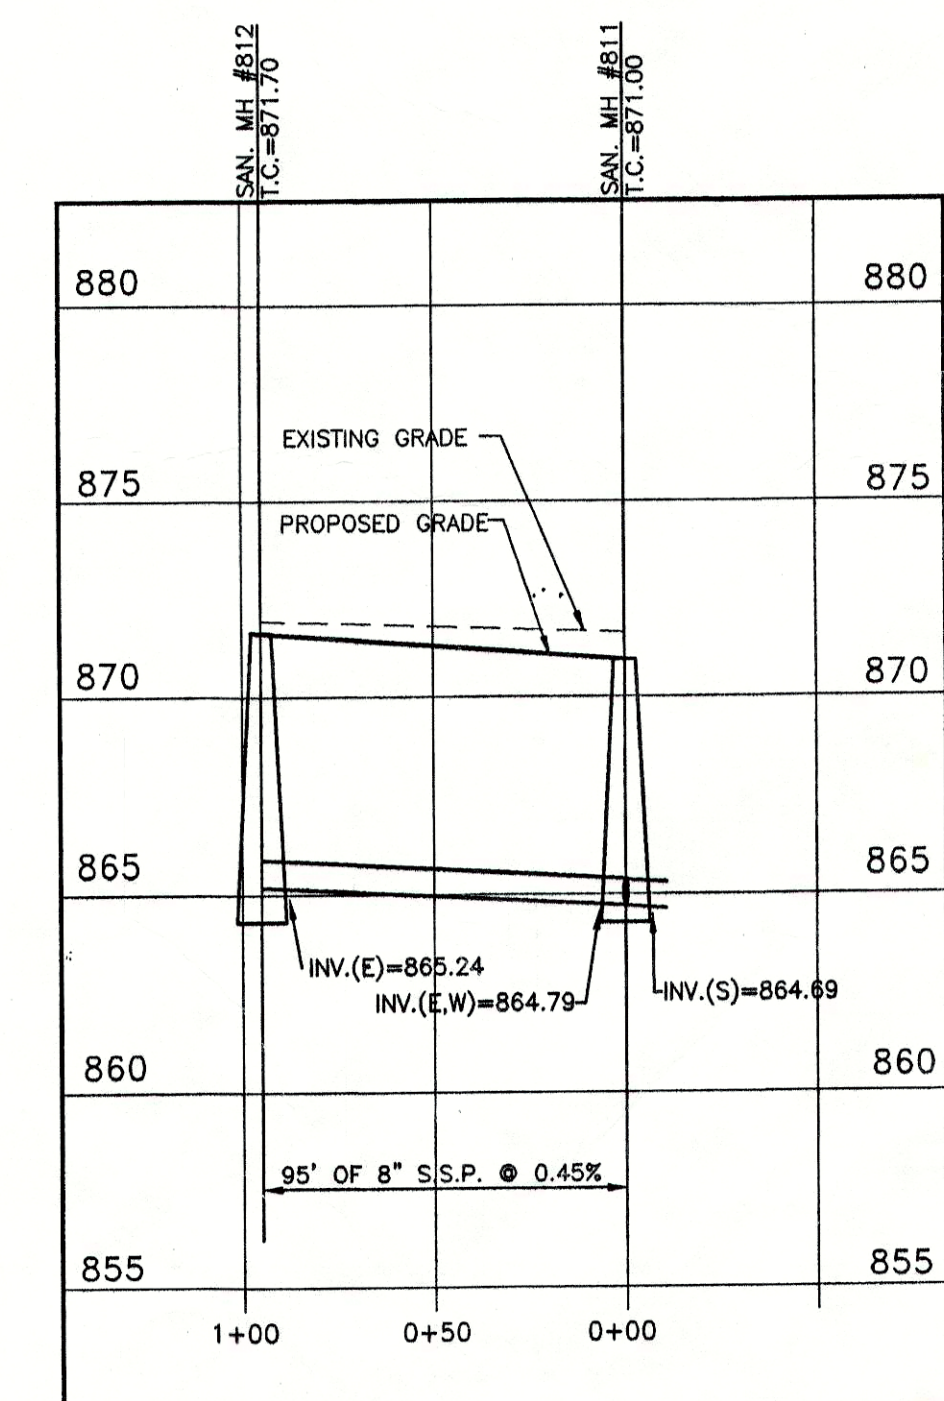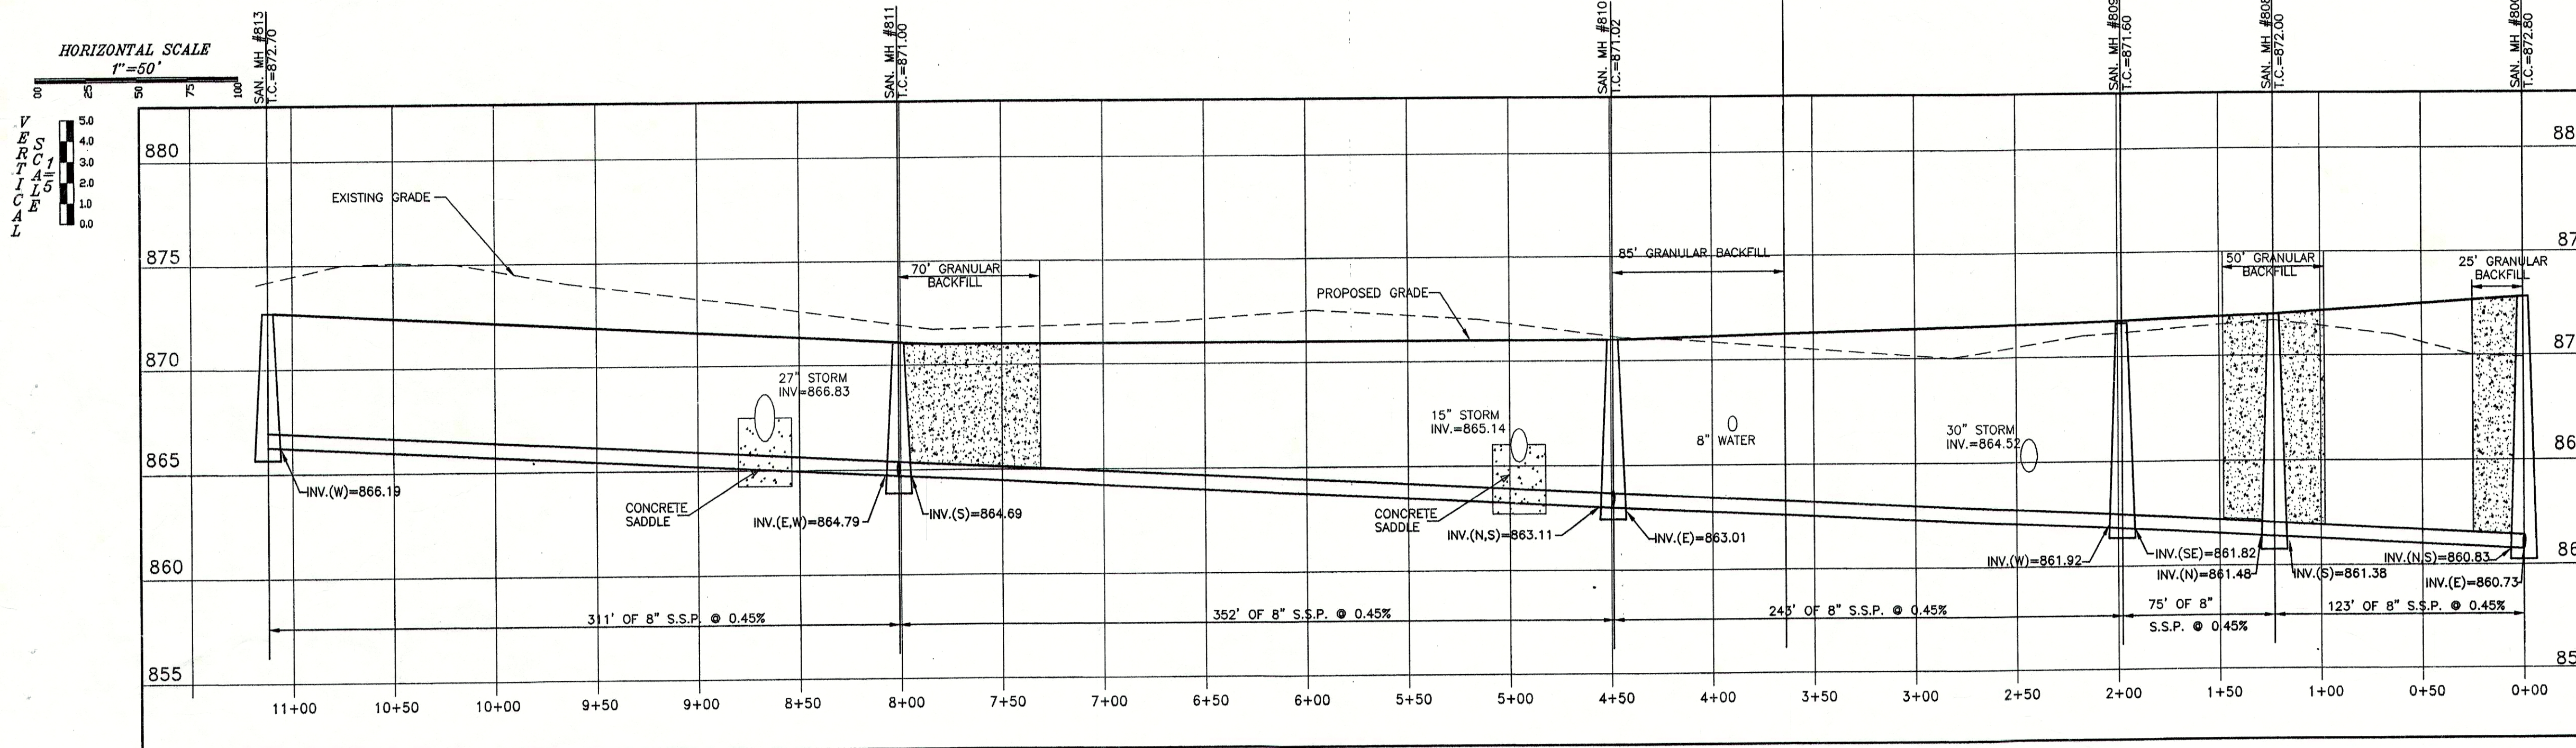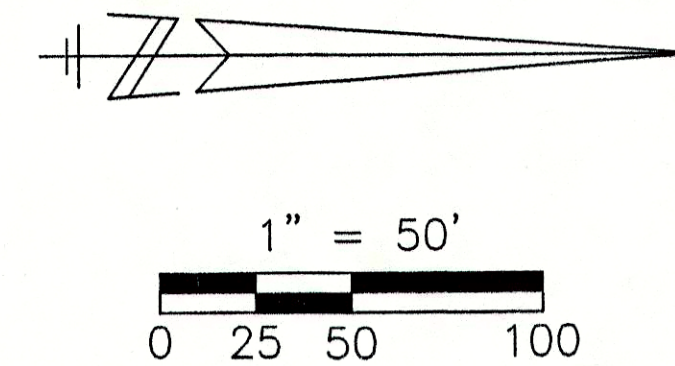


WEIHE ENGINEERS, INC.

10505 NORTH COLLEGE AVENUE
INDIANAPOLIS, INDIANA 46280
(317) 846-6611 FAX: (317) 843-0546
TOLL-FREE: (800) 452-6408

ALLAN H. WEIHE
REGISTERED CIVIL ENGINEER
REGISTERED LAND SURVEYOR
PRESIDENT

CIVIL ENGINEERS • LAND SURVEYORS • LAND PLANNERS • LANDSCAPE ARCHITECTS

PROJECT NO.	W02-0541
DATE	7/22/96
BY	SMC
CHECKED BY	DM
DATE	7/19/96
REVISIONS AND ISSUES	
MAJOR REVISIONS	
MINOR REVISIONS	
MAJOR REVISIONS PER C.E.W.D. & PROBLEM UTILITIES	

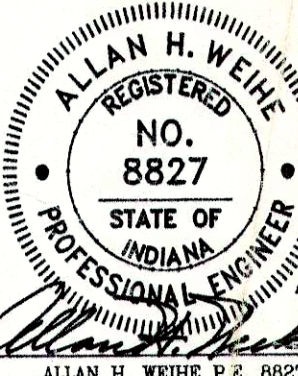

PREPARED FOR:
THE PINES AT DEERFIELD SECTION TWO
CORONADO DEVELOPMENT CORP.

SANITARY SEWER PLAN & PROFILE

PROJECT NO.
W02-0541

SHEET NO.
12