
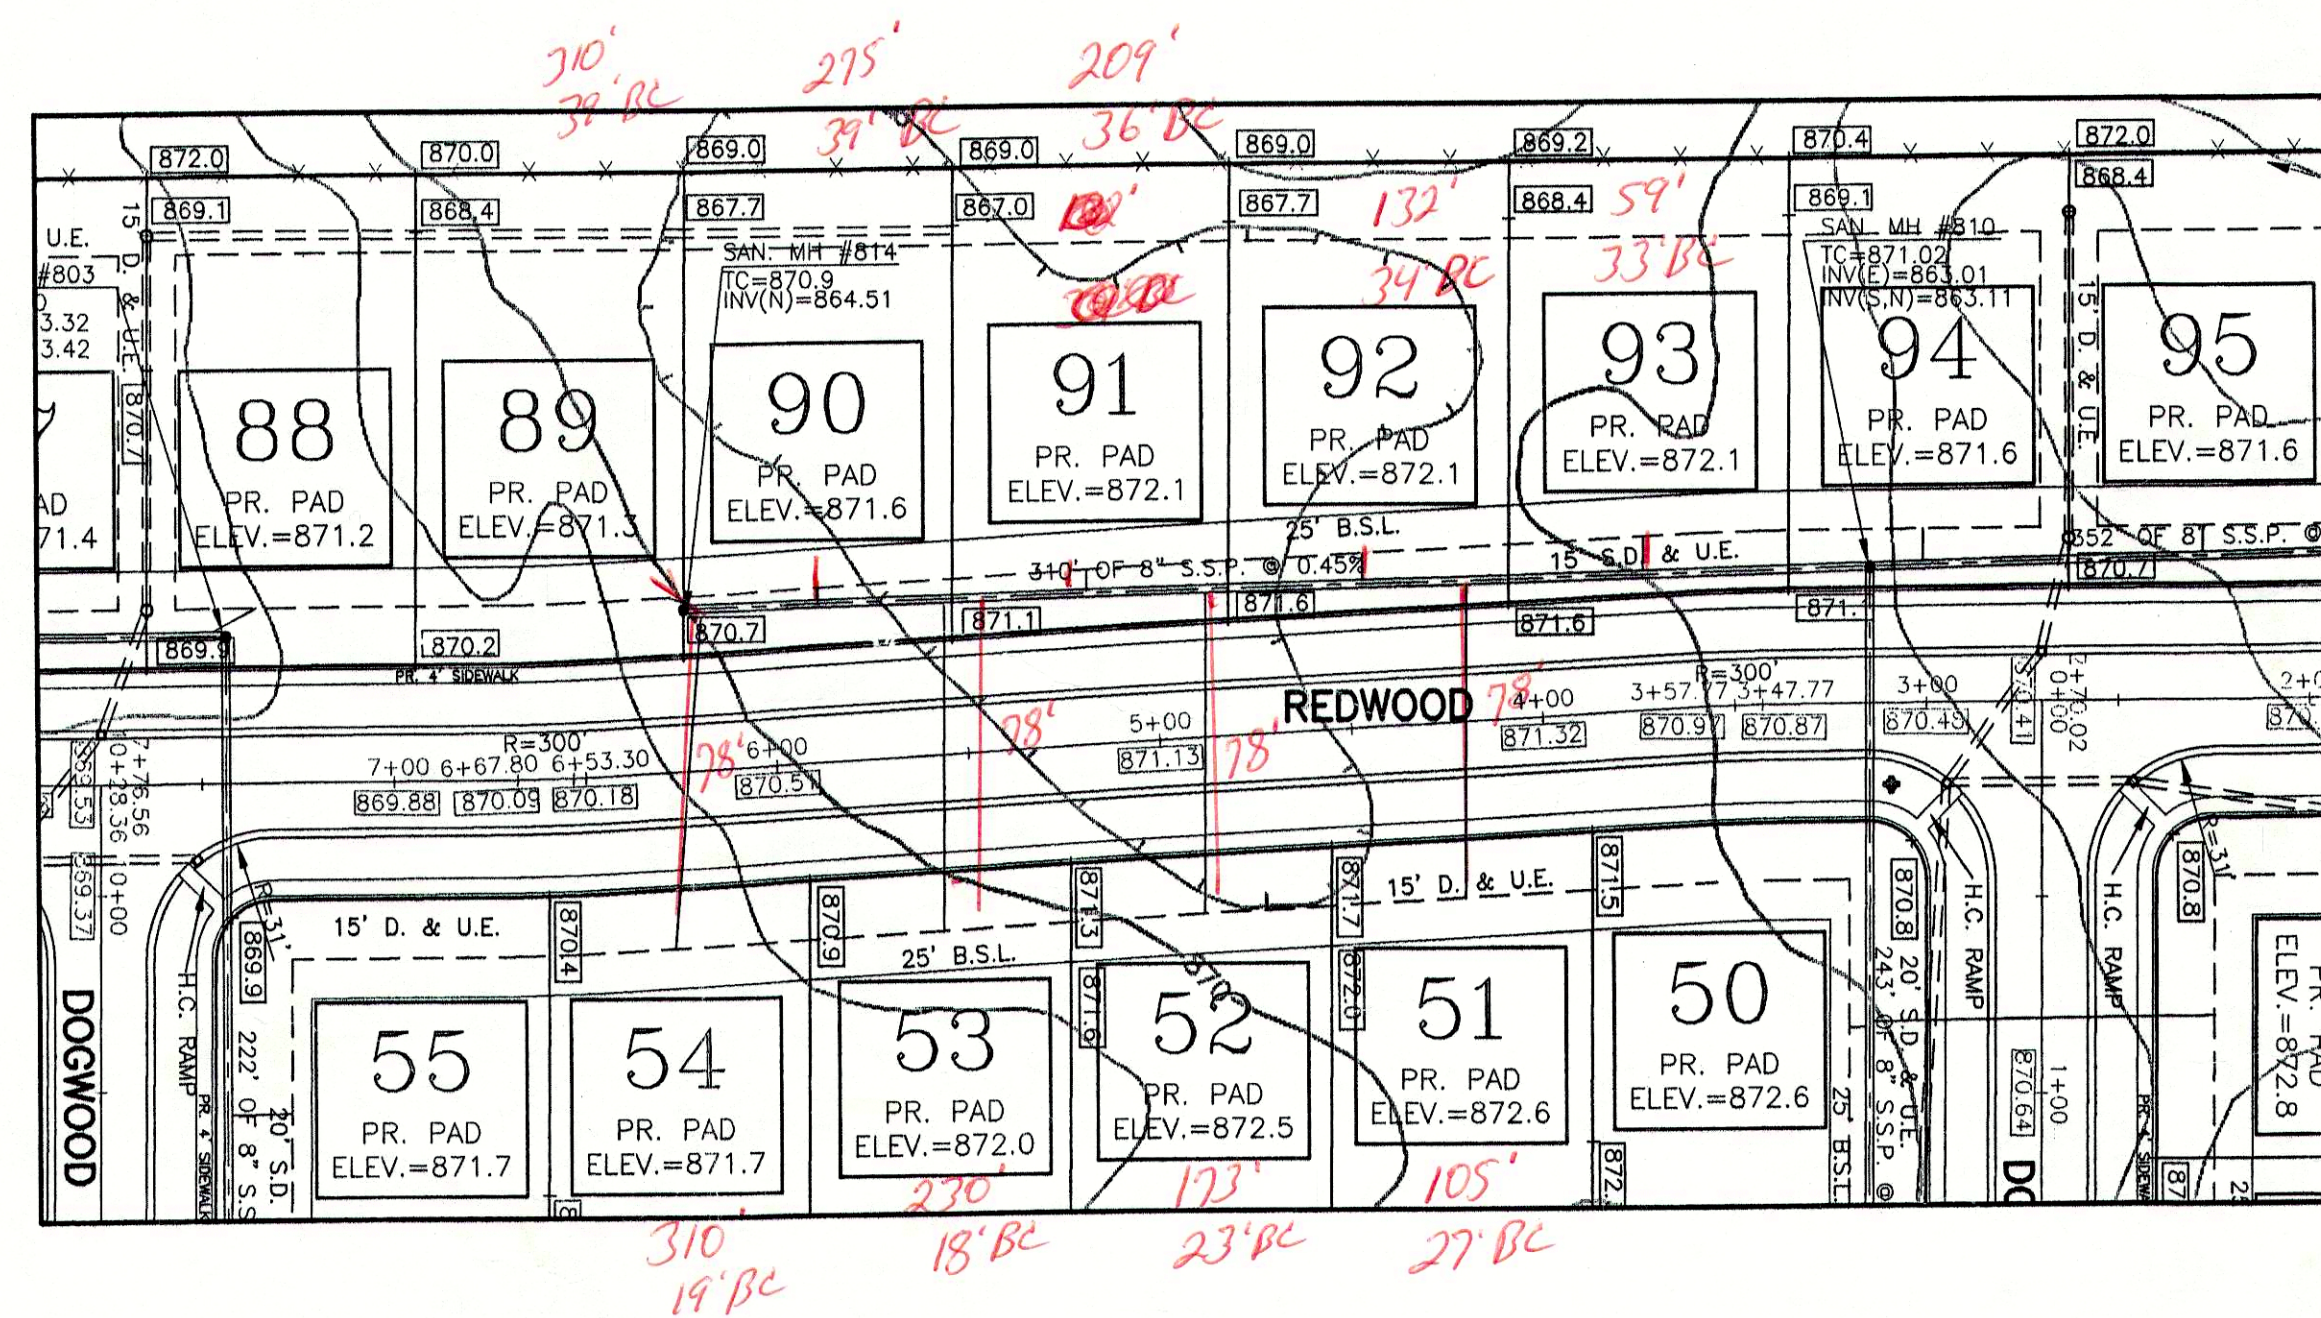
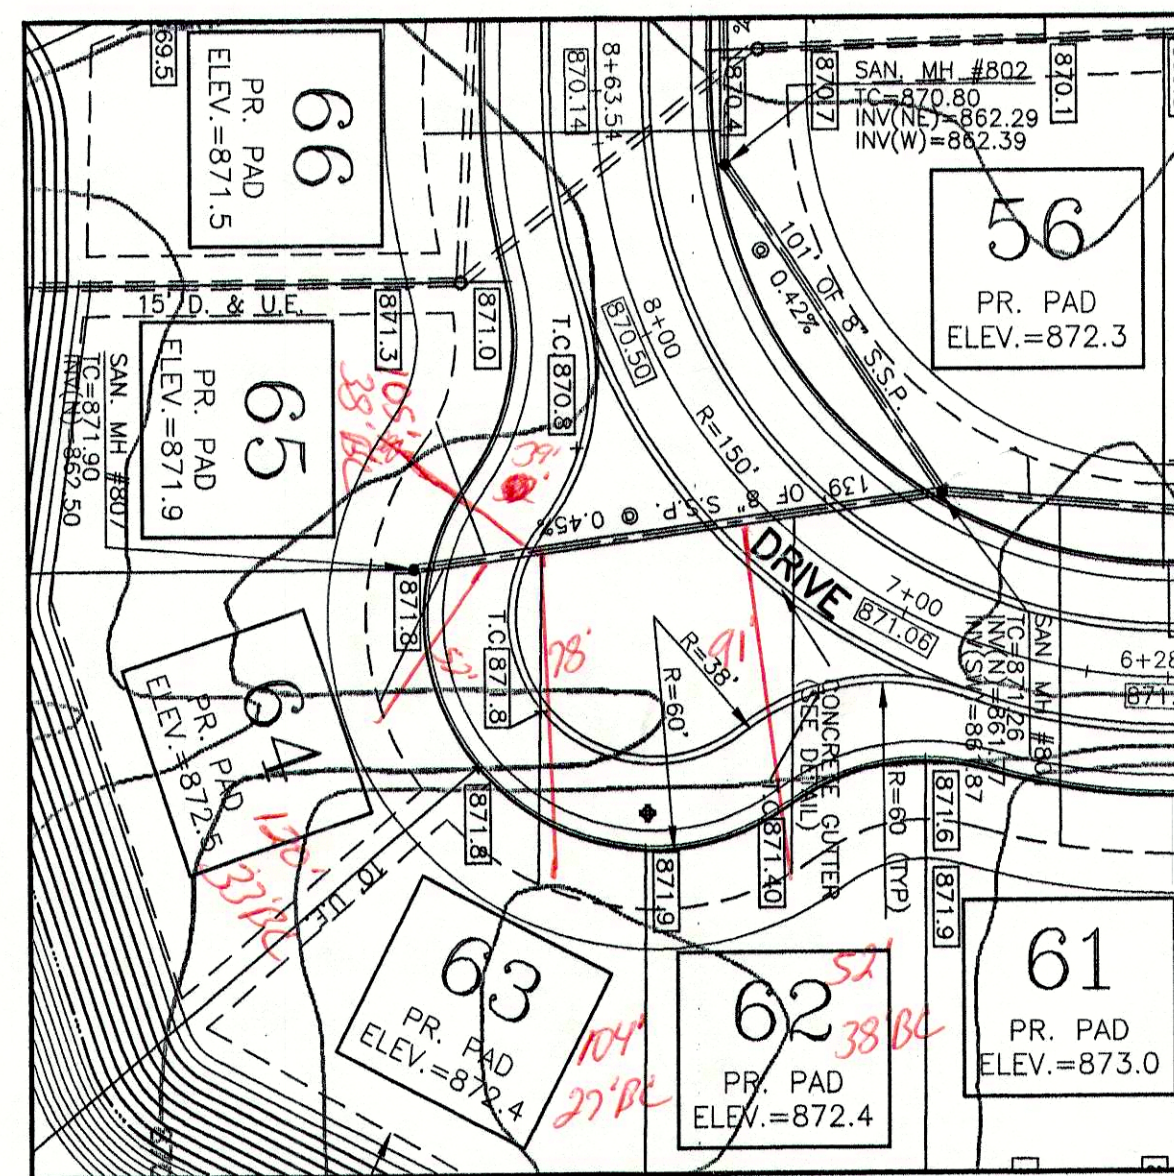




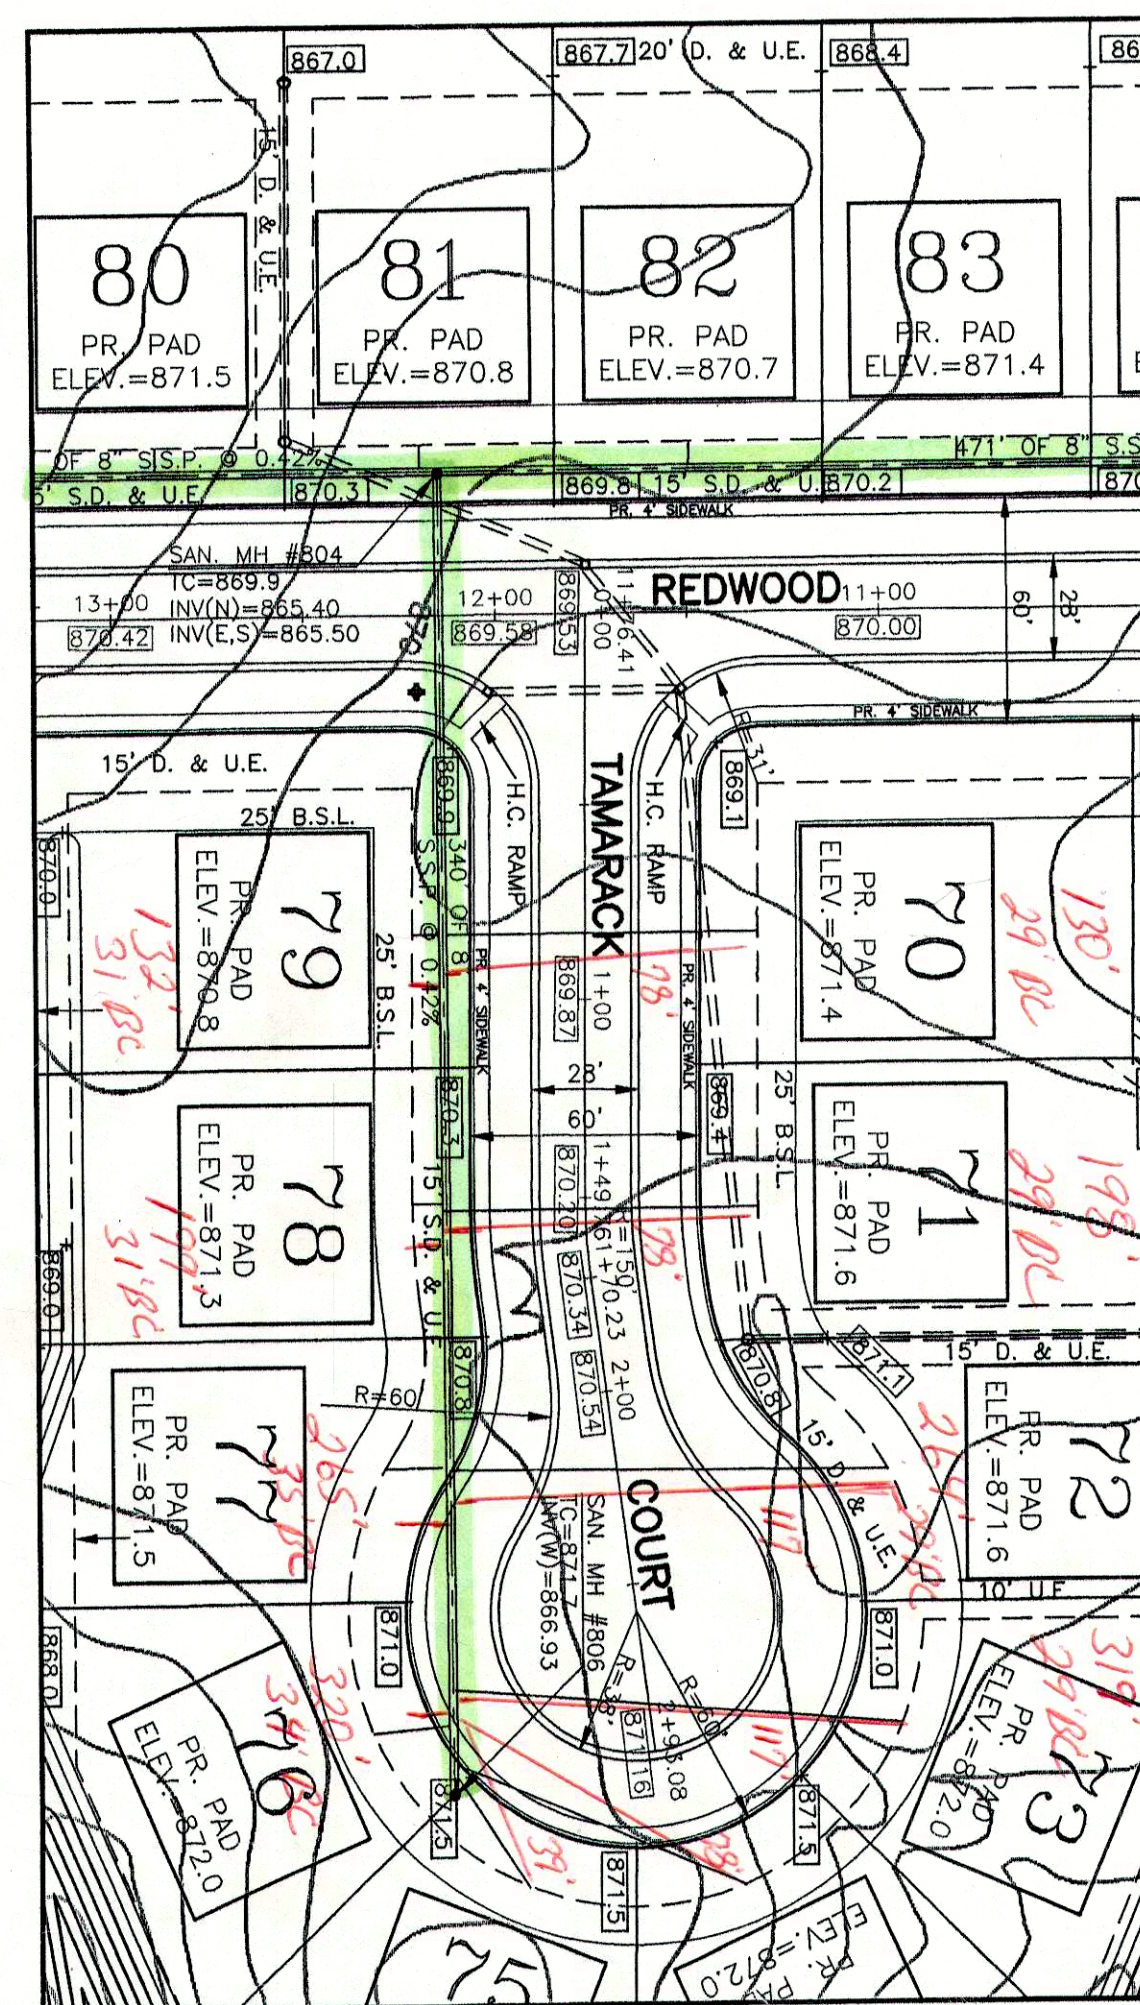


LATERAL LOCATION TABLE

LOT #	PROPOSED STATIONING
70	1+20
71	1+90
72	2+58
73	3+13
74	3+33
75	3+35
76	3+22
77	2+58
78	1+90
79	1+20
82	0+38
83	1+08
84	1+30
85	1+20
51	1+05
52	1+72
53	2+41
54	3+04
89	3+09
90	2+74
91	2+05
92	1+32
93	0+59


- LEGEND**
- GRANULAR BACKFILL
 - CONCRETE END SECTION
 - STORM SEWER LINE
 - SANITARY SEWER LINE
 - MANHOLE/INLET
 - CURB INLET
 - T.C. = TOP OF CASTING
 - INV. = INVERT
 - STR. = STRUCTURE
 - M.H. = MANHOLE
 - RCP = REINFORCED CONCRETE PIPE
 - SSP = SANITARY SEWER PIPE

- GENERAL NOTES**
- FOR STRUCTURE LOCATIONS SEE DEVELOPMENT PLAN.
 - ALL STATIONING IS SHOWN BEGINNING AT PROPOSED DOWNSTREAM STRUCTURE.
 - IT SHALL BE THE CONTRACTOR'S RESPONSIBILITY TO FIELD VERIFY ALL UTILITY LOCATIONS PRIOR TO ANY CONSTRUCTION ACTIVITY.
 - OCCUPATIONAL SAFETY AND HEALTH ADMINISTRATION (OSHA) STANDARDS FOR EXCAVATIONS; FINAL RULE 29 CFR PART 1926, SUBPART "P" APPLIES TO ALL EXCAVATIONS EXCEEDING FIVE (5) FEET IN DEPTH.
 - IN ADDITION, EXCAVATION EXCEEDING TWENTY (20) FEET IN DEPTH SHALL REQUIRE THE DESIGN OF A TRENCH SAFETY SYSTEM BY A REGISTERED PROFESSIONAL ENGINEER.
 - GRANULAR BACKFILL ALL PIPE LOCATED UNDER AND WITHIN 5' OF PAVED SURFACES. SEE DETAIL SHEET FOR PIPE BEDDING DETAIL.
 - CONTRACTOR SHALL PRESERVE TREES WHERE POSSIBLE.
 - ALL PROPOSED GRADES SHALL MATCH EXISTING GRADES AT PROPERTY LINE.
 - WYE & LATERAL STATIONING IS SHOWN FROM DOWNSTREAM MANHOLE.

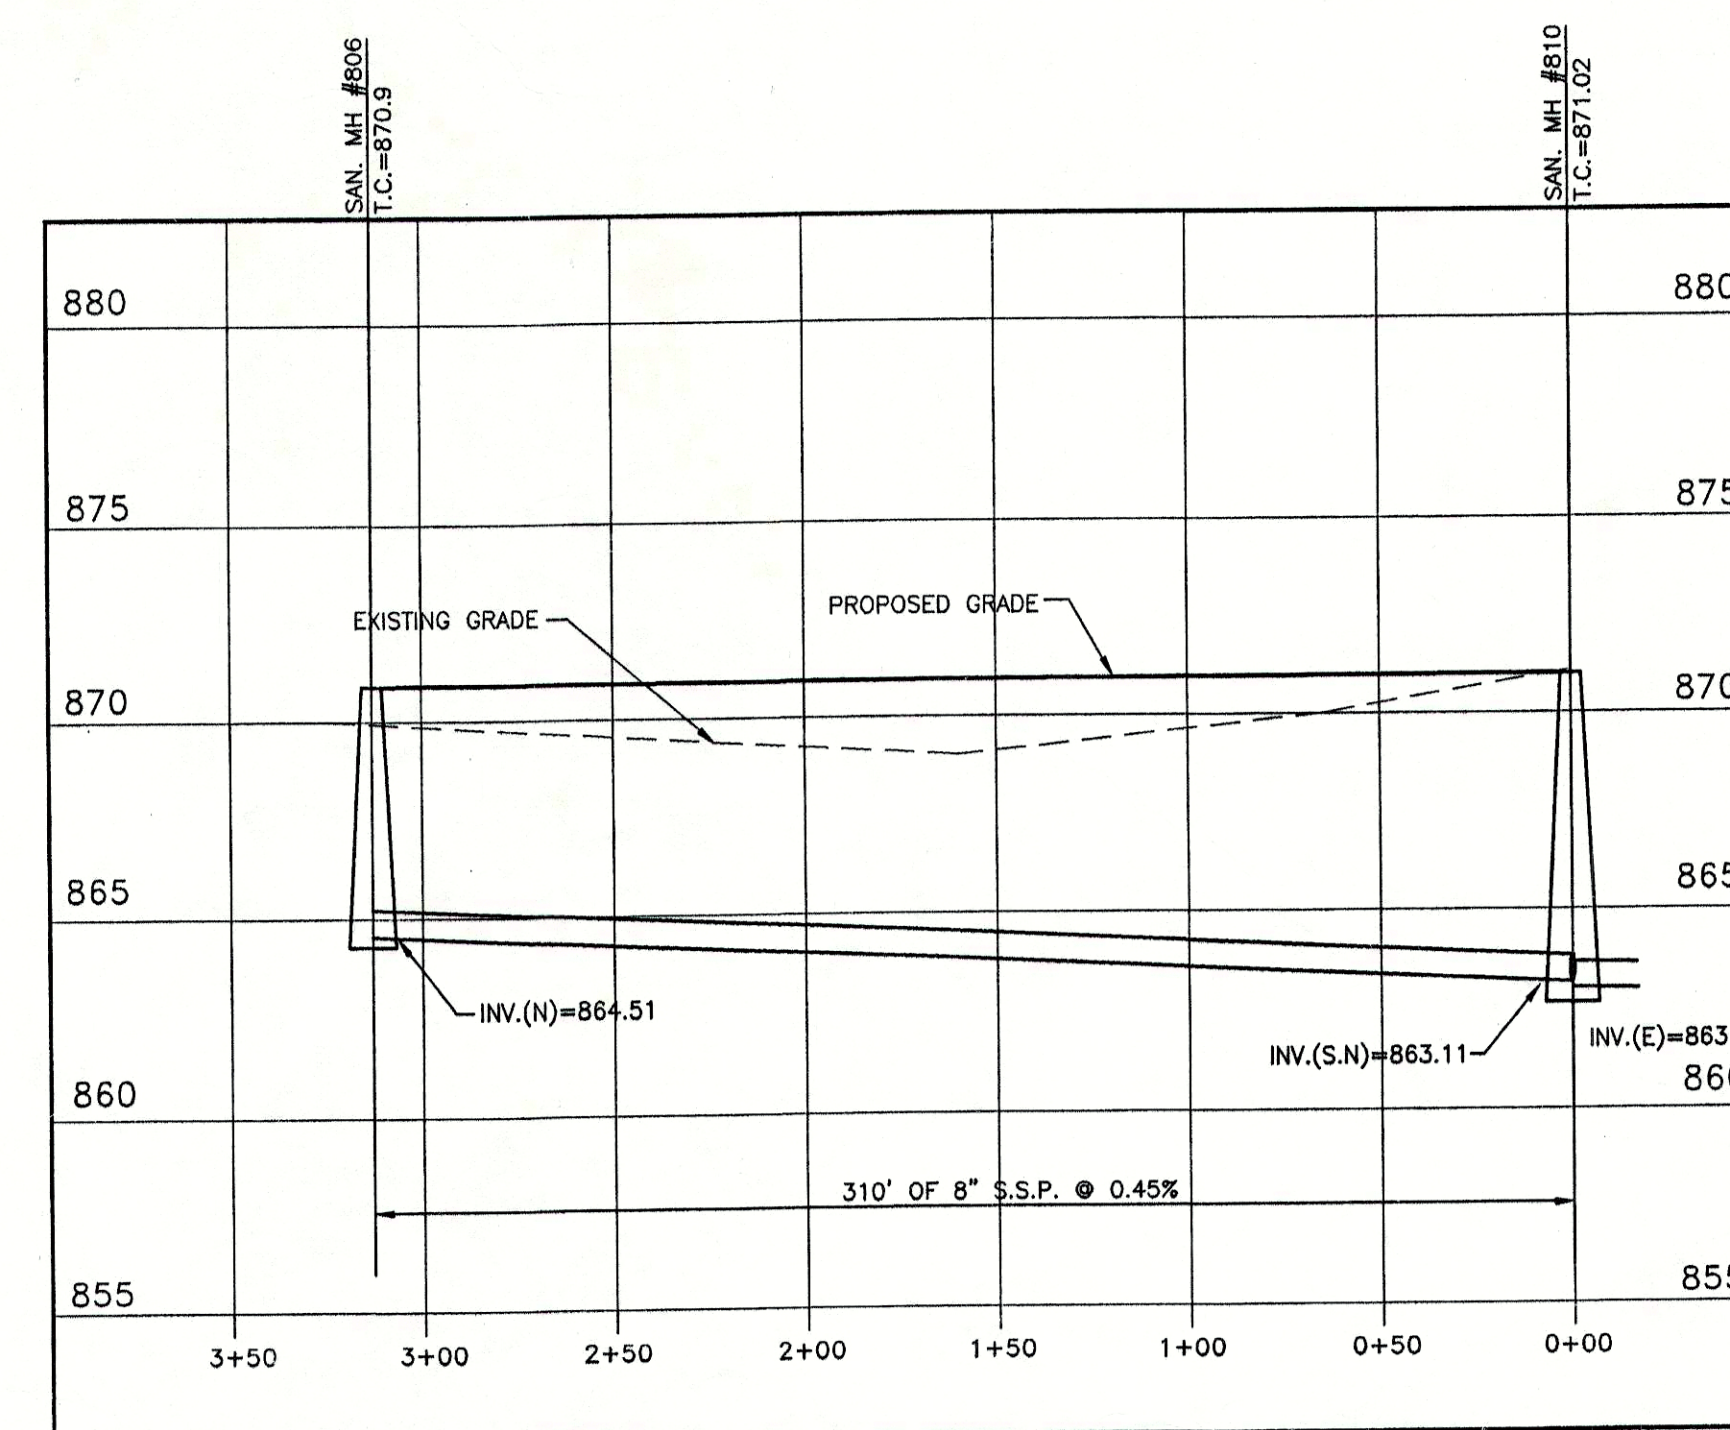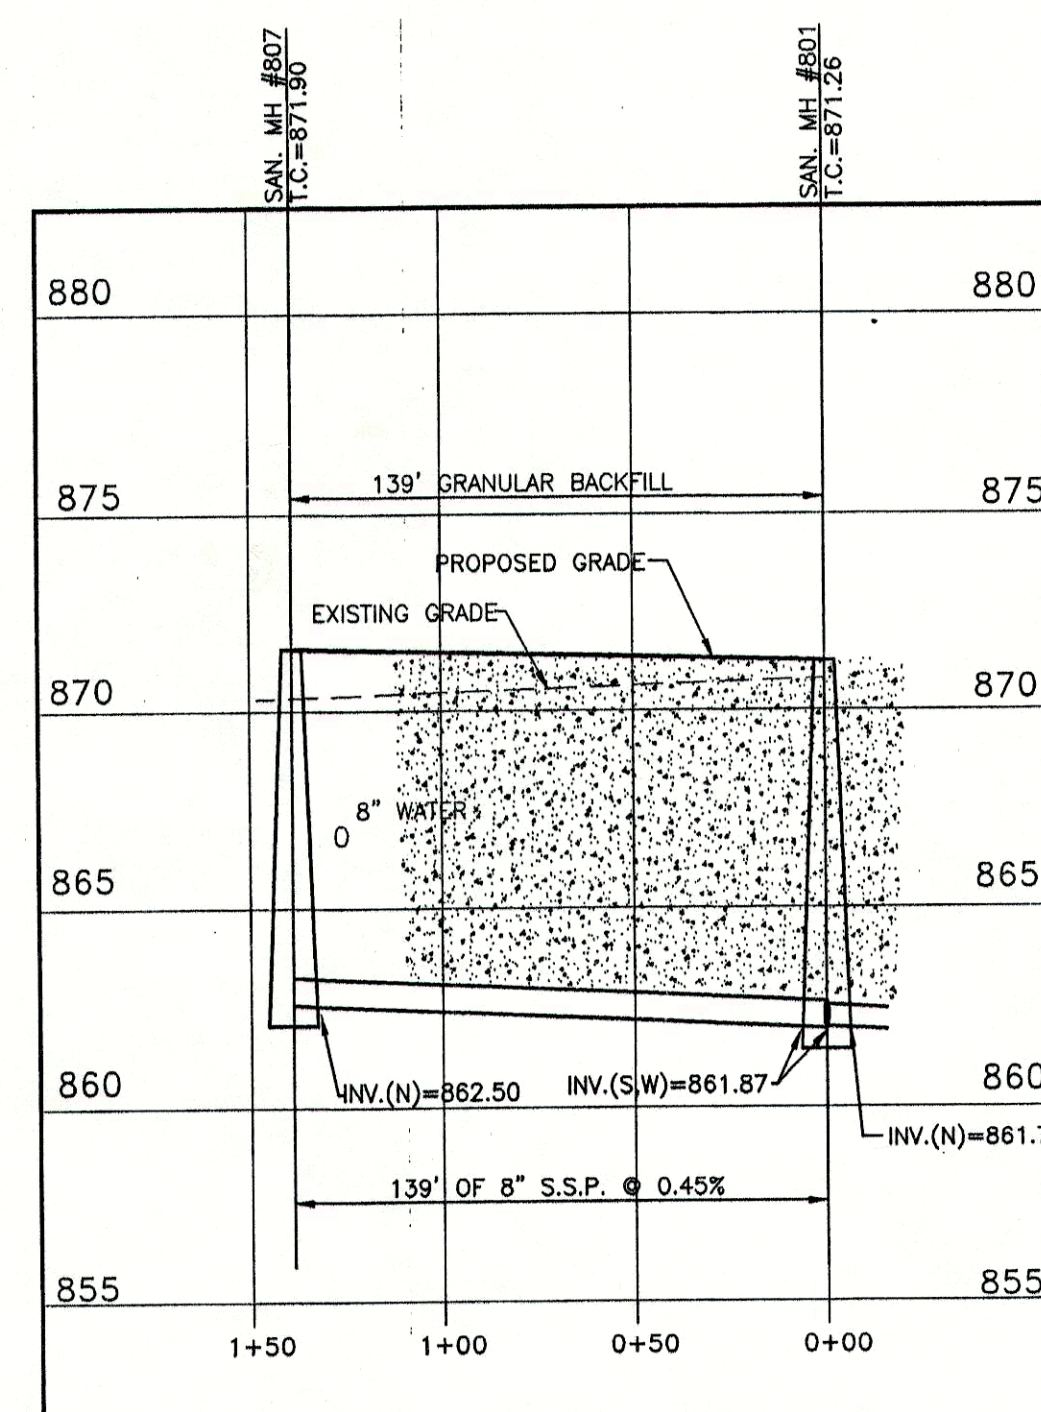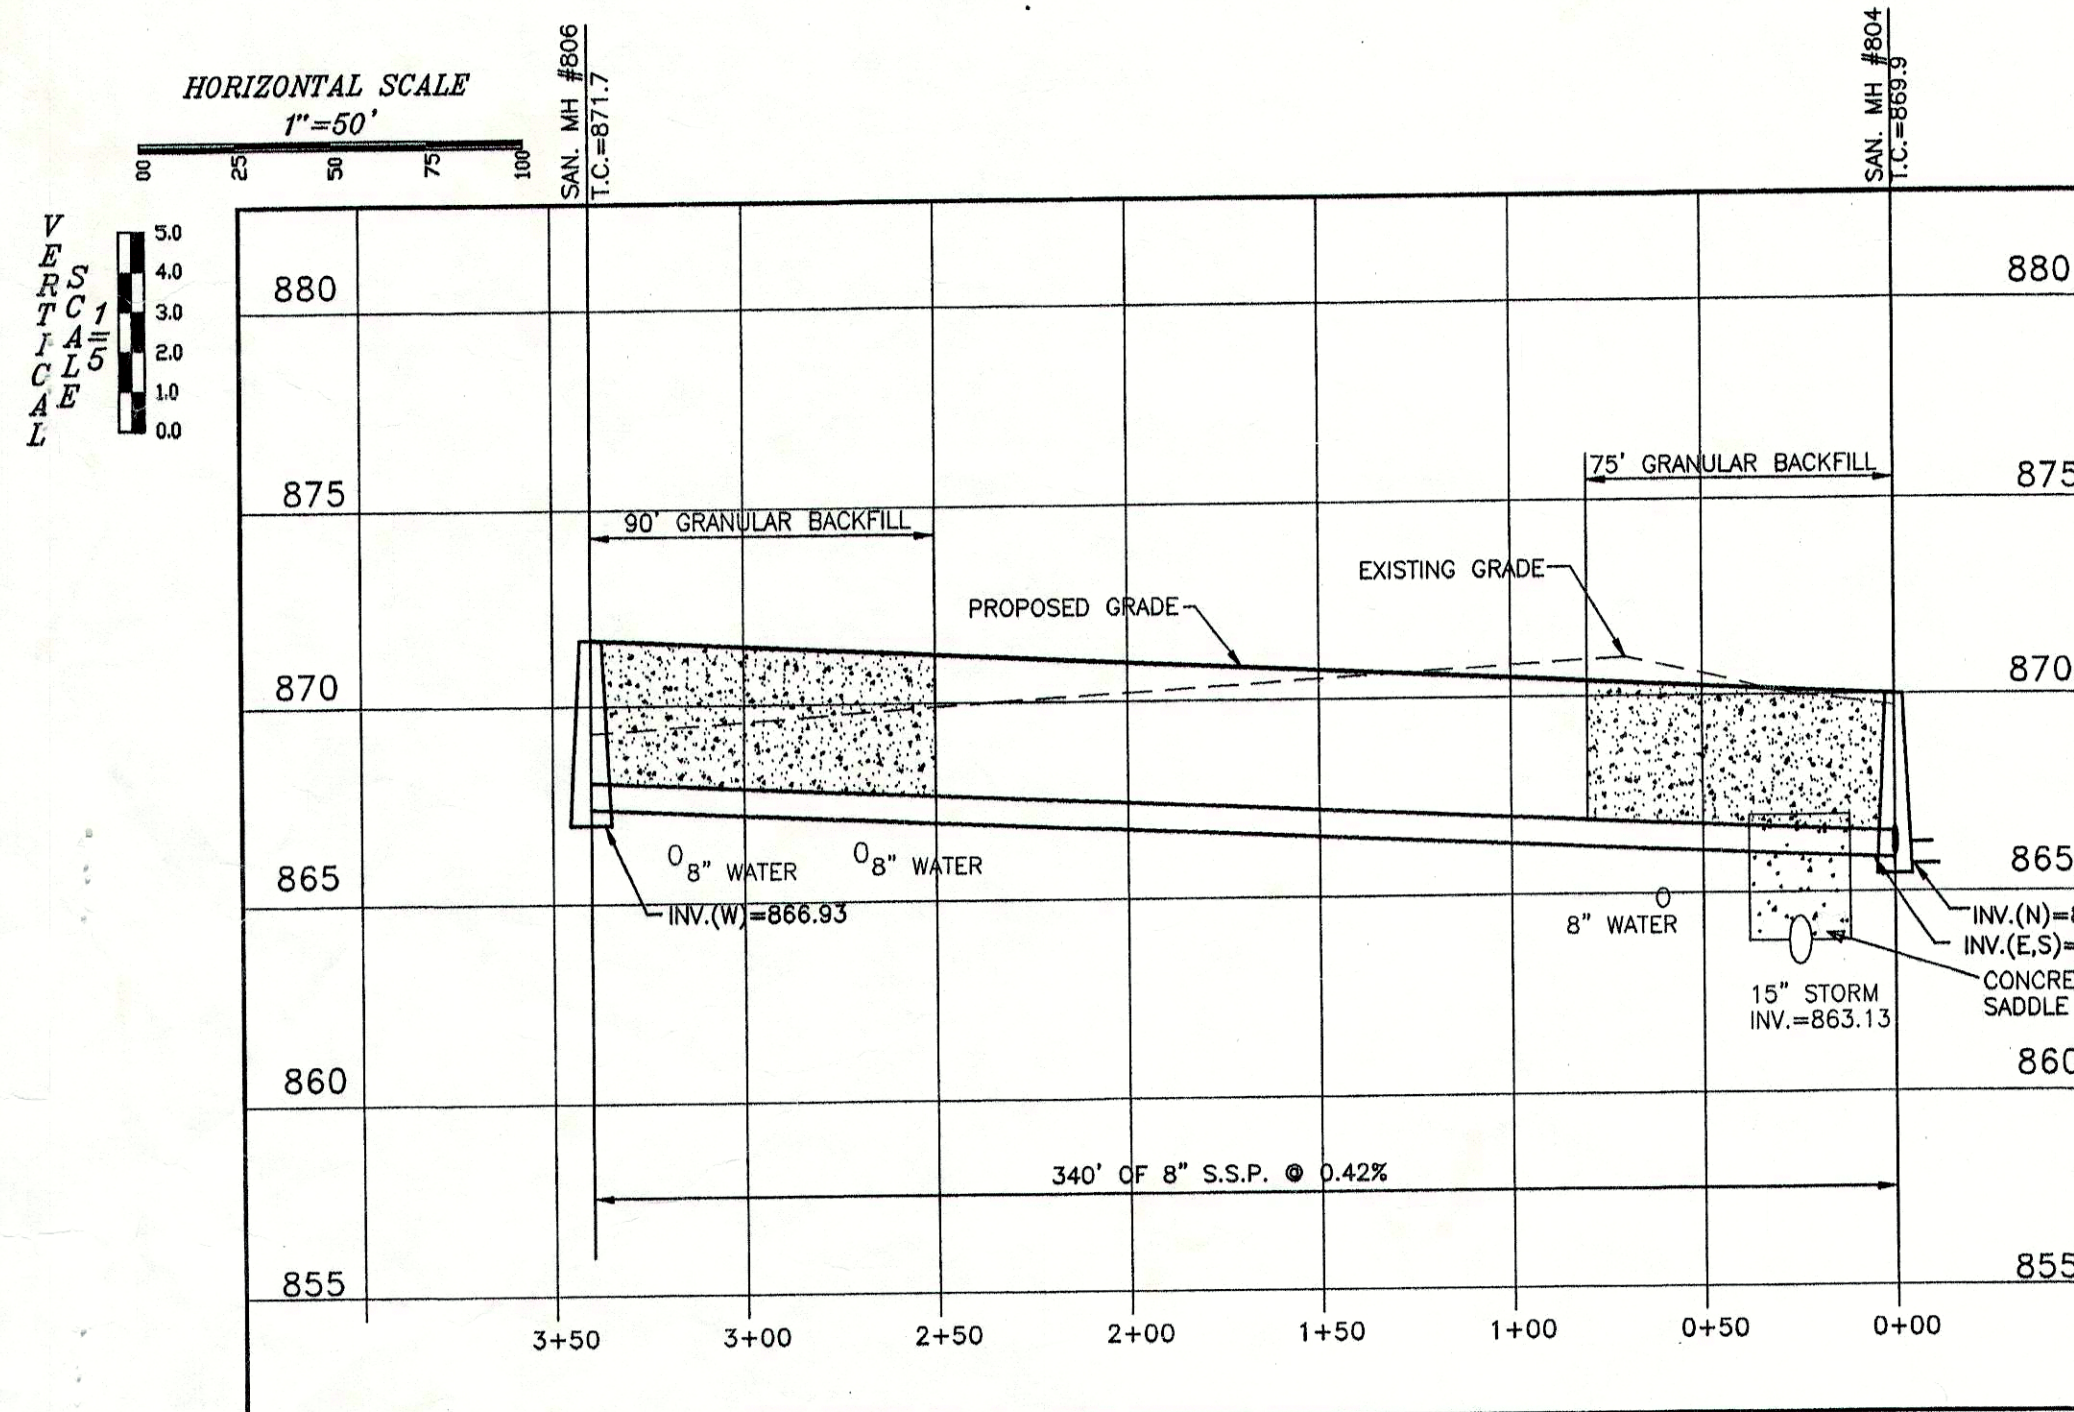

WEIHE ENGINEERS, INC.
 1065 NORTH COLLEGE AVENUE
 SUITE 100
 DENVER, CO 80202
 (303) 733-8888
 TOLL FREE (800) 452-6008
 CIVIL ENGINEERS • LAND SURVEYORS • LAND PLANNERS • LANDSCAPE ARCHITECTS

PROJECT NO.	DATE	BY	DATE	BY	DATE
W02-0541	7/1/02	ALLAN H. WEIHE	7/1/02	ALLAN H. WEIHE	7/1/02
DESIGNED BY	CHECKED BY	DATE	BY	DATE	BY
ALLAN H. WEIHE	ALLAN H. WEIHE	7/1/02	ALLAN H. WEIHE	7/1/02	ALLAN H. WEIHE

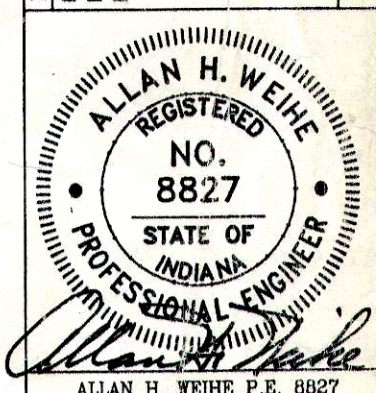

THE PINES AT DEERFIELD SECTION TWO
 CORONADO DEVELOPMENT CORP.
 SANITARY SEWER PLAN & PROFILE
 SHEET NO. 13
 PROJECT NO. W02-0541