


STATIONING IS FROM NEAREST
CONCRETE SADDLE

LOT #	PROPOSED STATIONING
55	0+00
56	0+10
57	0+20
58	0+30
59	0+40
60	0+50
61	0+60
62	0+70
63	0+80
64	0+90
65	1+00
66	1+10
67	1+20
68	1+30
69	1+40
70	1+50
71	1+60
72	1+70
73	1+80
74	1+90
75	2+00
76	2+10
77	2+20
78	2+30
79	2+40
80	2+50
81	2+60
82	2+70
83	2+80
84	2+90
85	3+00
86	3+10
87	3+20
88	3+30

(5) 3" DIA. YARD MANHOLE (TYP)
DELINATIONS 5' ON CENTER (TYP)
PER STATE OF INDIANA T&E/C


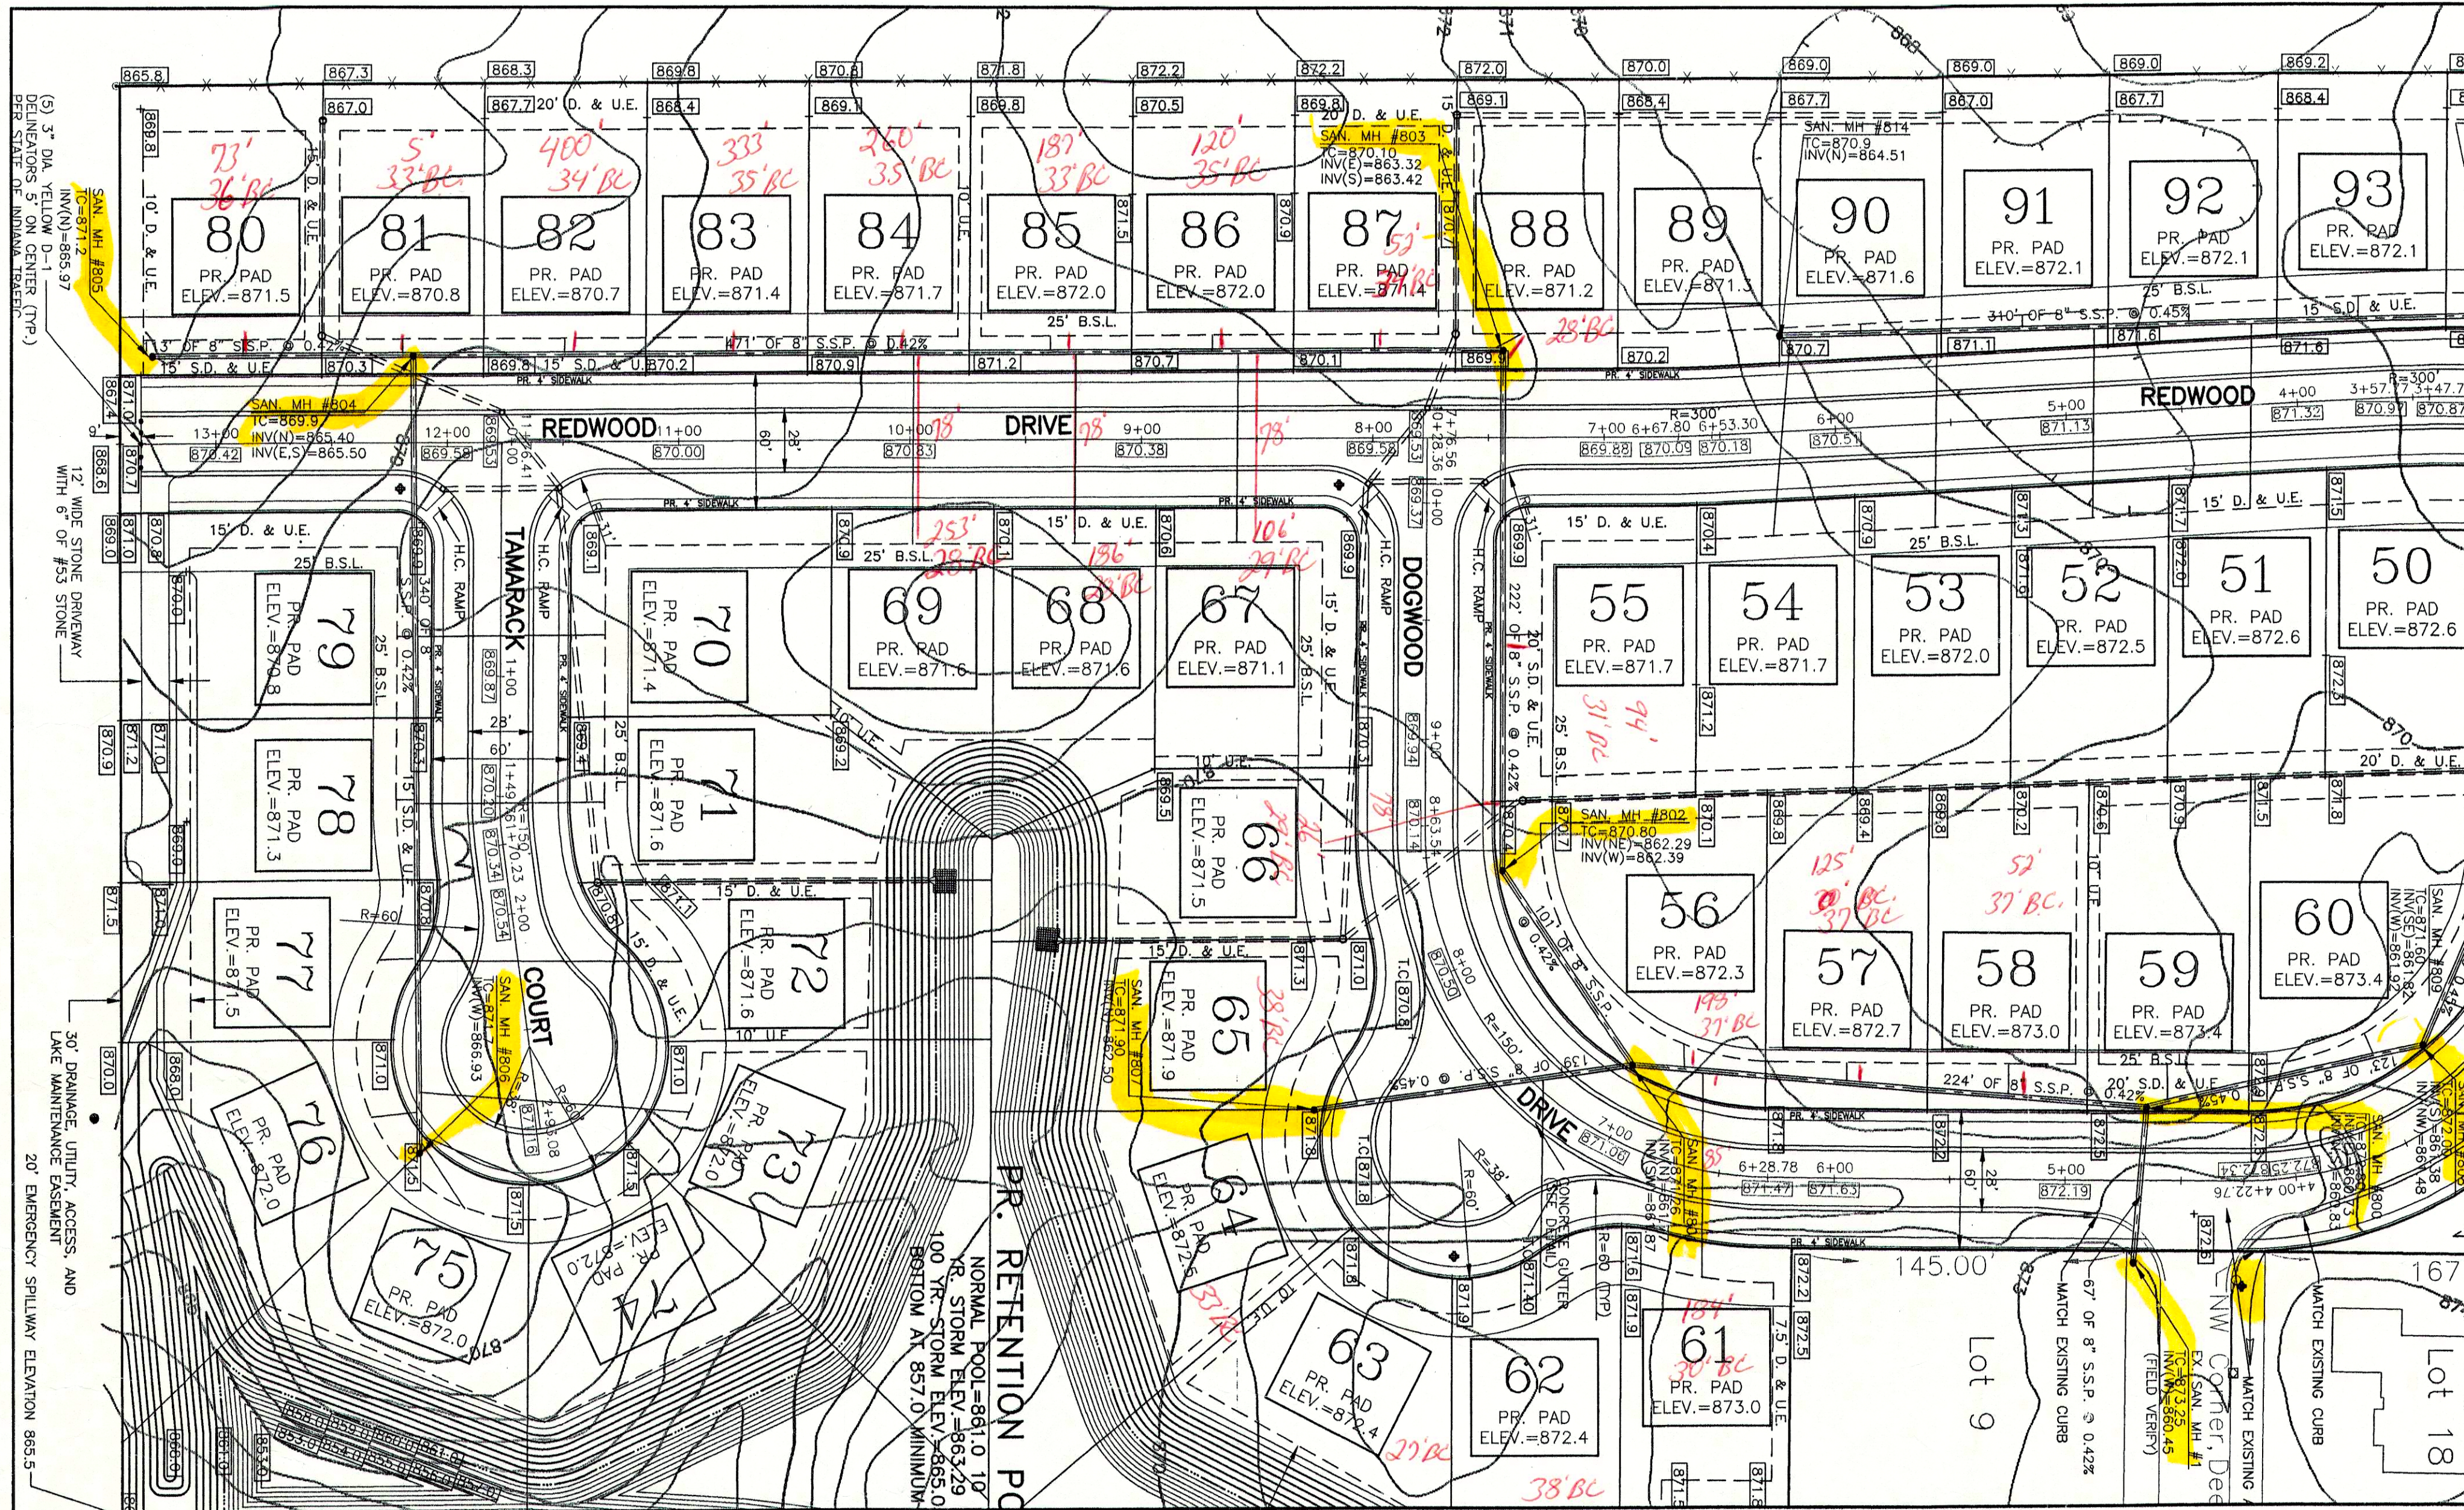


GENERAL NOTES

- FOR STRUCTURE LOCATIONS SEE DEVELOPMENT PLAN.
- ALL STATIONING IS SHOWN BEGINNING AT PROPOSED DOWNSTREAM STRUCTURE.
- IT SHALL BE THE CONTRACTOR'S RESPONSIBILITY TO FIELD VERIFY ALL UTILITY LOCATIONS PRIOR TO ANY CONSTRUCTION ACTIVITY.
- OCCUPATIONAL SAFETY AND HEALTH ADMINISTRATION (OSHA) STANDARDS FOR EXCAVATIONS: FINAL RULE 29 CFR PART 1926, SUBPART "P" APPLIES TO ALL EXCAVATIONS EXCEEDING FIVE (5) FEET IN DEPTH.
- IN ADDITION, EXCAVATION EXCEEDING TWENTY (20) FEET IN DEPTH SHALL REQUIRE THE DESIGN OF A TRENCH SAFETY SYSTEM BY A REGISTERED PROFESSIONAL ENGINEER.
- GRANULAR BACKFILL ALL PIPE LOCATED UNDER AND WITHIN 5' OF PAVED SURFACES. SEE DETAIL SHEET FOR PIPE BEDDING DETAIL.
- CONTRACTOR SHALL PRESERVE TREES WHERE POSSIBLE.
- ALL PROPOSED GRADES SHALL MATCH EXISTING GRADES AT PROPERTY LINE.
- WYE & LATERAL STATIONING IS SHOWN FROM DOWNSTREAM MANHOLE.

LEGEND

- GRANULAR BACKFILL
- CONCRETE END SECTION
- STORM SEWER LINE
- SANITARY SEWER LINE
- MANHOLE/INLET
- CURB INLET
- T.C. = TOP OF CASTING
- INV. = INVERT
- STR. = STRUCTURE
- MH. = MANHOLE
- RCP = REINFORCED CONCRETE PIPE
- SSP = SANITARY SEWER PIPE

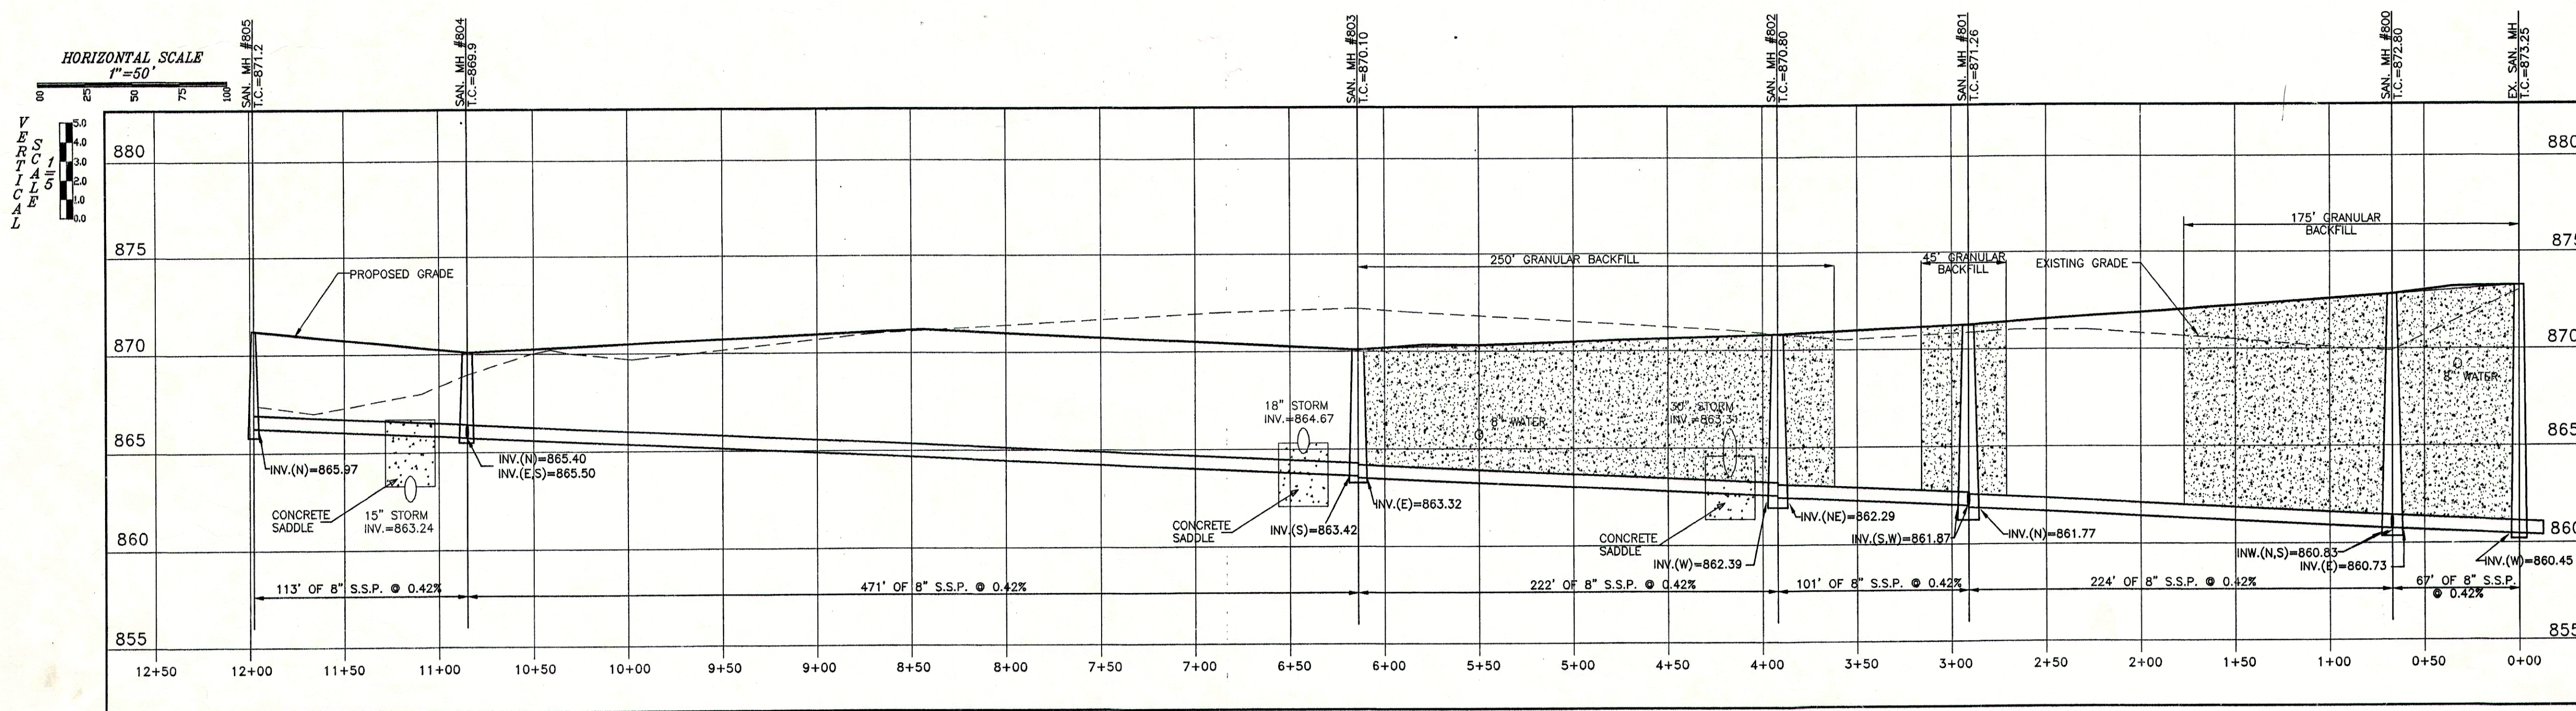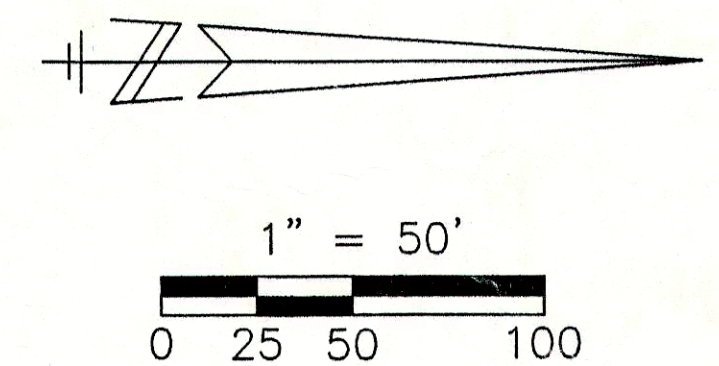

WEIHE ENGINEERS, INC.
1006 NORTH COLLEGE AVENUE
INDIANAPOLIS, INDIANA 46280
(317) 846-6611 FAX: (317) 843-0546
TOLL-FREE (800) 452-6408

ALLAN H. WEIHE
REGISTERED CIVIL ENGINEER
REGISTERED LAND SURVEYOR
PRESIDENT

CIVIL ENGINEERS • LAND SURVEYORS • LAND PLANNERS • LANDSCAPE ARCHITECTS

PROJECT NO.:	W02-0541
DATE:	7/22/96
BY:	SMG
DATE:	9/12/96
BY:	TC
DATE:	7/19/96
BY:	DA
REVISIONS AND ISSUES:	
MINOR REVISIONS:	MINOR REVISIONS PER F.C.R. 6.0 & 6.0.1
MINOR REVISIONS:	MINOR REVISIONS PER F.C.R. 6.0 & 6.0.1



THE PINES AT DEERFIELD SECTION TWO

CORONADO DEVELOPMENT CORP.

SANITARY SEWER PLAN & PROFILE

PREPARED FOR:


SHEET NO.

11

PROJECT NO.

W02-0541




LATERAL LOCATION TABLE		
STATIONING IS FROM NEAREST DOWNSTREAM MANHOLE	LOT #	PROPOSED STATIONING
	42	3+09
	43	2+70
	44	1+95
	45	1+25
	46	1+28
	47	0+52
	48	0+12
	49	0+22
	50	1+25
	59	0+10
	60	1+00
	94	0+14
95	0+87	
96	1+60	
97	2+30	
98	0+42	
99	0+37	
100	1+15	
101	1+85	
102	2+65	
103	3+08	

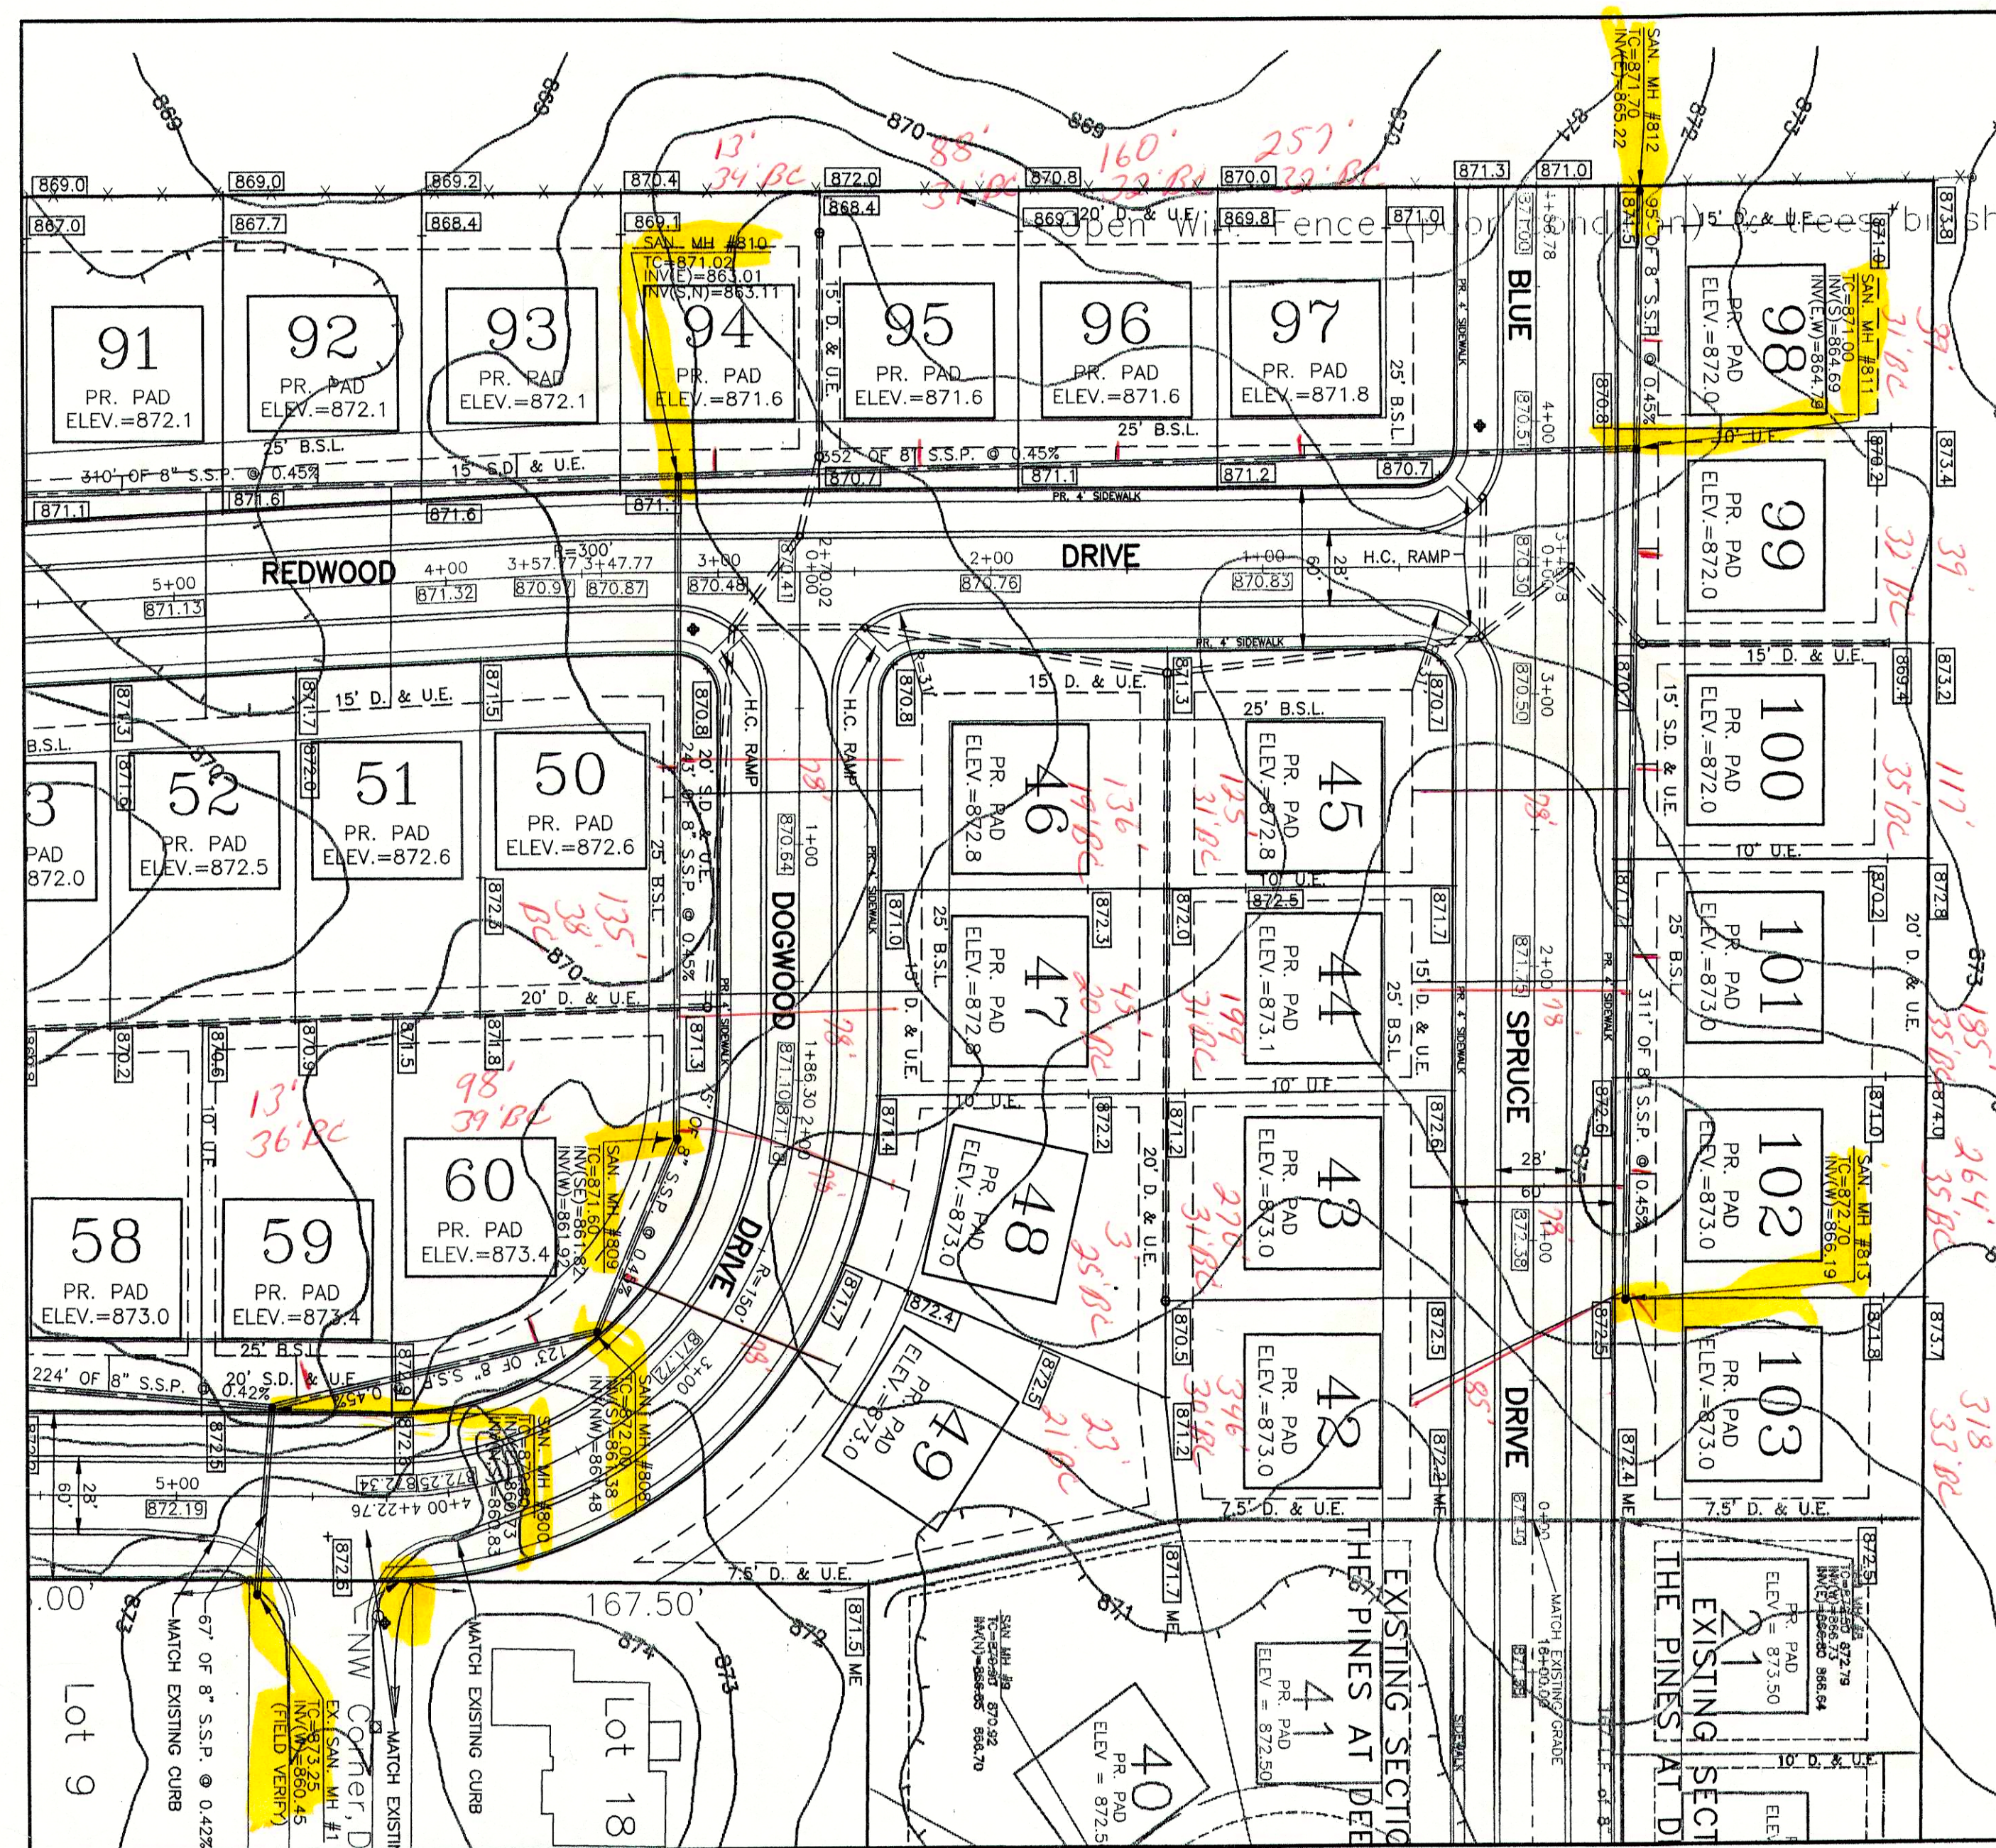

- ### GENERAL NOTES
1. FOR STRUCTURE LOCATIONS SEE DEVELOPMENT PLAN.
 2. ALL STATIONING IS SHOWN BEGINNING AT PROPOSED DOWNSTREAM STRUCTURE.
 3. IT SHALL BE THE CONTRACTORS RESPONSIBILITY TO FIELD VERIFY ALL UTILITY LOCATIONS PRIOR TO ANY CONSTRUCTION ACTIVITY.
 4. OCCUPATIONAL SAFETY AND HEALTH ADMINISTRATION (OSHA) STANDARDS FOR EXCAVATIONS: FINAL RULE 29 PART 1926, SUBPART 121 APPLIES TO ALL EXCAVATIONS EXCEEDING FIVE (5) FEET IN DEPTH.
 5. IN ADDITION, EXCAVATION EXCEEDING TWENTY (20) FEET IN DEPTH SHALL REQUIRE THE DESIGN OF A TRENCH SAFETY SYSTEM BY A REGISTERED PROFESSIONAL ENGINEER.
 6. GRANULAR BACKFILL ALL PIPE LOCATED UNDER AND WITHIN 5' OF PAVED SURFACES. SEE DETAIL SHEET FOR PIPE BEDDING DETAIL.
 7. CONTRACTOR SHALL PRESERVE TREES WHERE POSSIBLE.
 8. ALL PROPOSED GRADES SHALL MATCH EXISTING GRADES AT PROPERTY LINE.
 9. WYE & LATERAL STATIONING IS SHOWN FROM DOWNSTREAM MANHOLE.

LEGEND

- = GRANULAR BACKFILL
 < = CONCRETE END SECTION
 = STORM SEWER LINE
 = SANITARY SEWER LINE
 ○ = MANHOLE / INLET
 □ = CURB / INLET
 T.C. = TOP OF CASTING
 INV. = INVERT
 STR. = STRUCTURE
 MH. = MANHOLE
 RCP = REINFORCED CONCRETE PIPE
 SSP = SANITARY SEWER PIPE

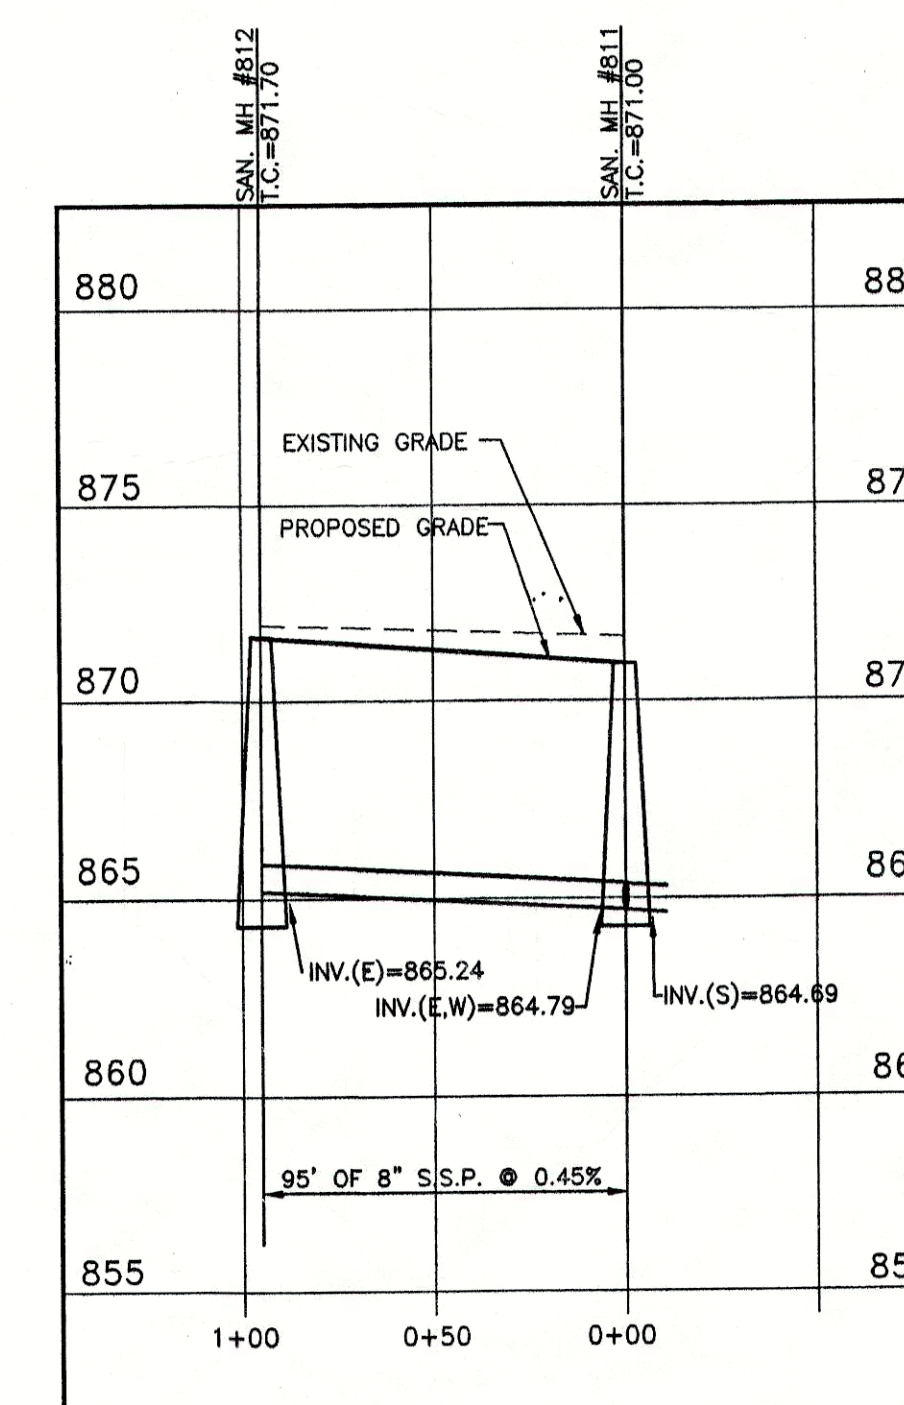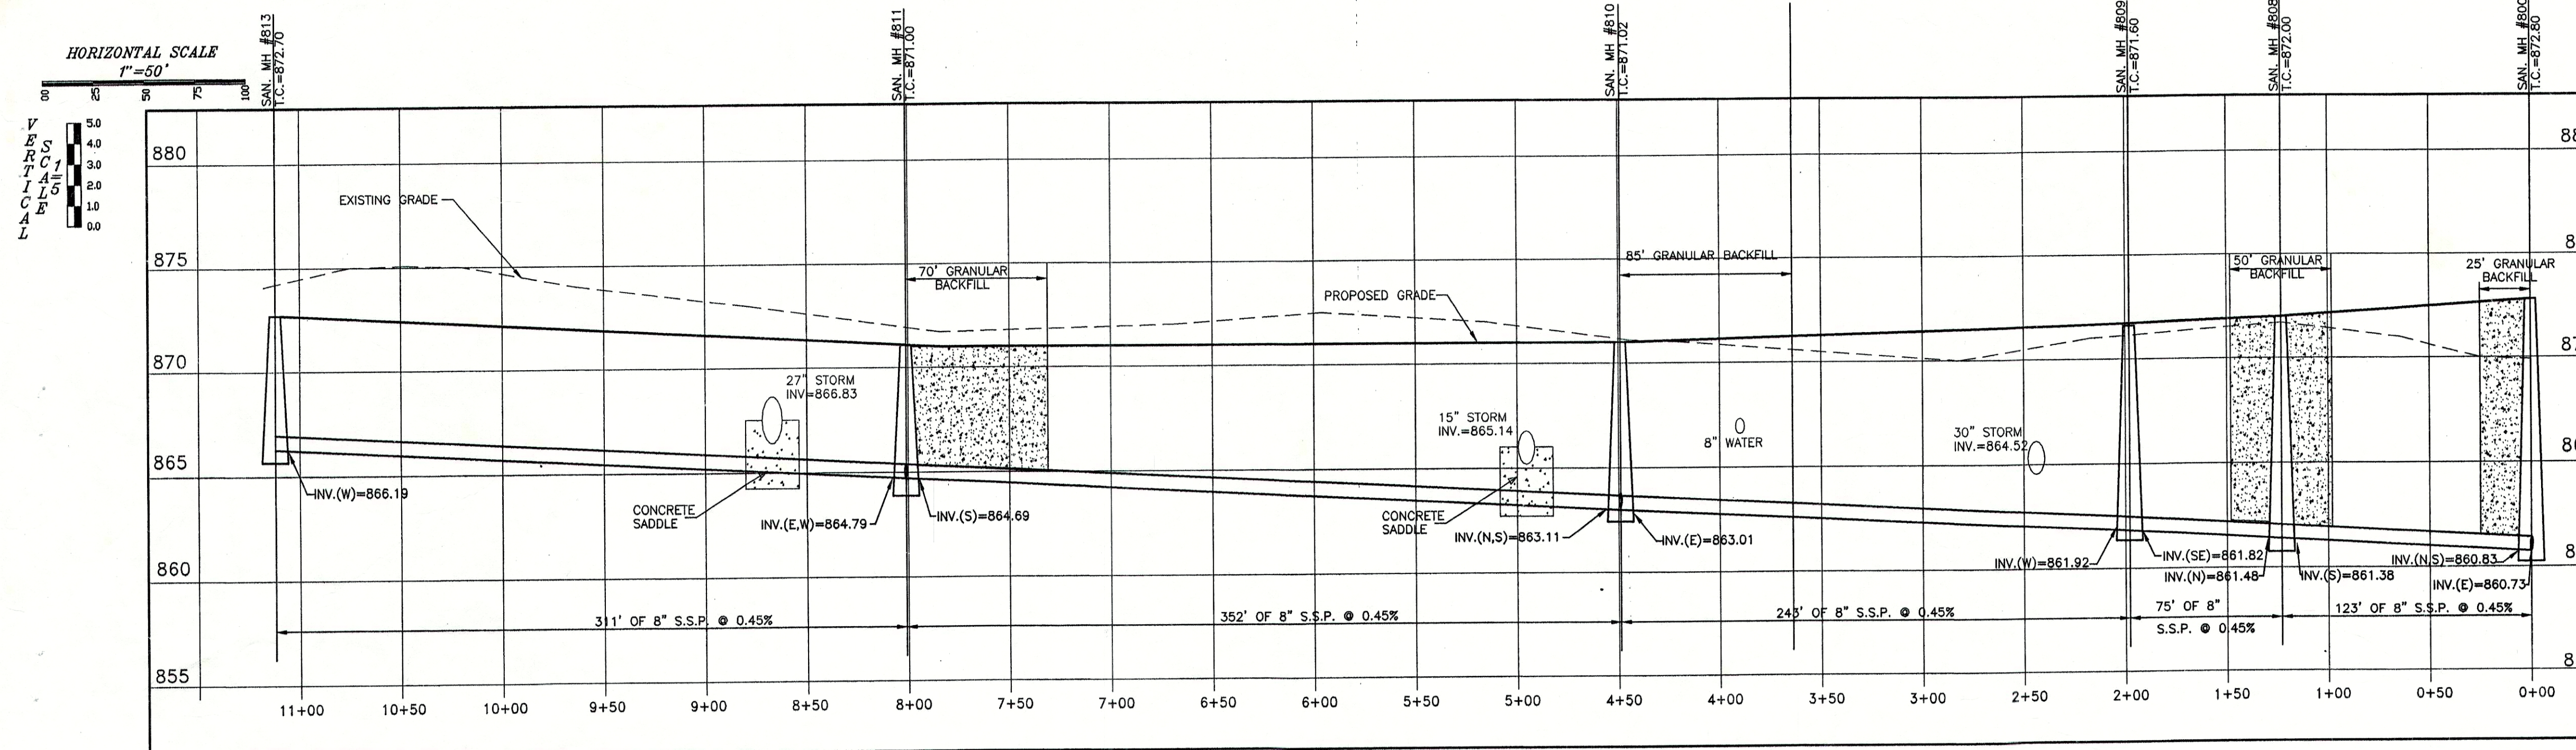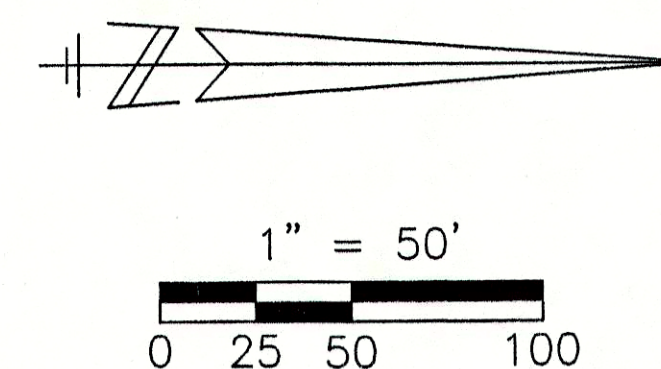


WEIHE ENGINEERS, INC.



ALLAN H. WEIHE
REGISTERED CIVIL ENGINEER
REGISTERED LAND SURVEYOR
PRESIDENT

10505 NORTH COLLEGE AVENUE
INDIANAPOLIS, INDIANA 46290
TEL: (317) 455-4546
TOLL-FREE (800) 435-6408

REVISIONS AND ISSUES	DATE	BY	PROJECT NO.:
MINOR REVISIONS	7/22/96	SMG	W02-0541
MINOR REVISIONS	9/1/96	TC	DRAWN BY:
MINOR REVISIONS PER F.C.R.W.D. & PENNSULTION UTILITIES	7/7/97	DUT	MLM/SMG/LSP
			CHECKED BY:
			MMO
			DATE:



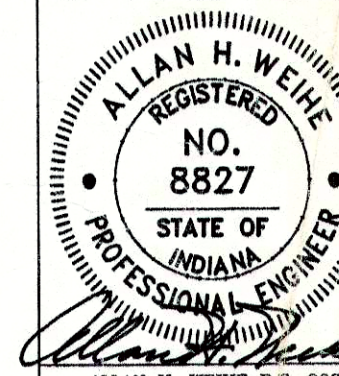


PREPARED FOR:

THE PINES AT DEERFIELD SECTION TWO

CORONADO DEVELOPMENT CORP.

SANITARY SEWER PLAN & PROFILE

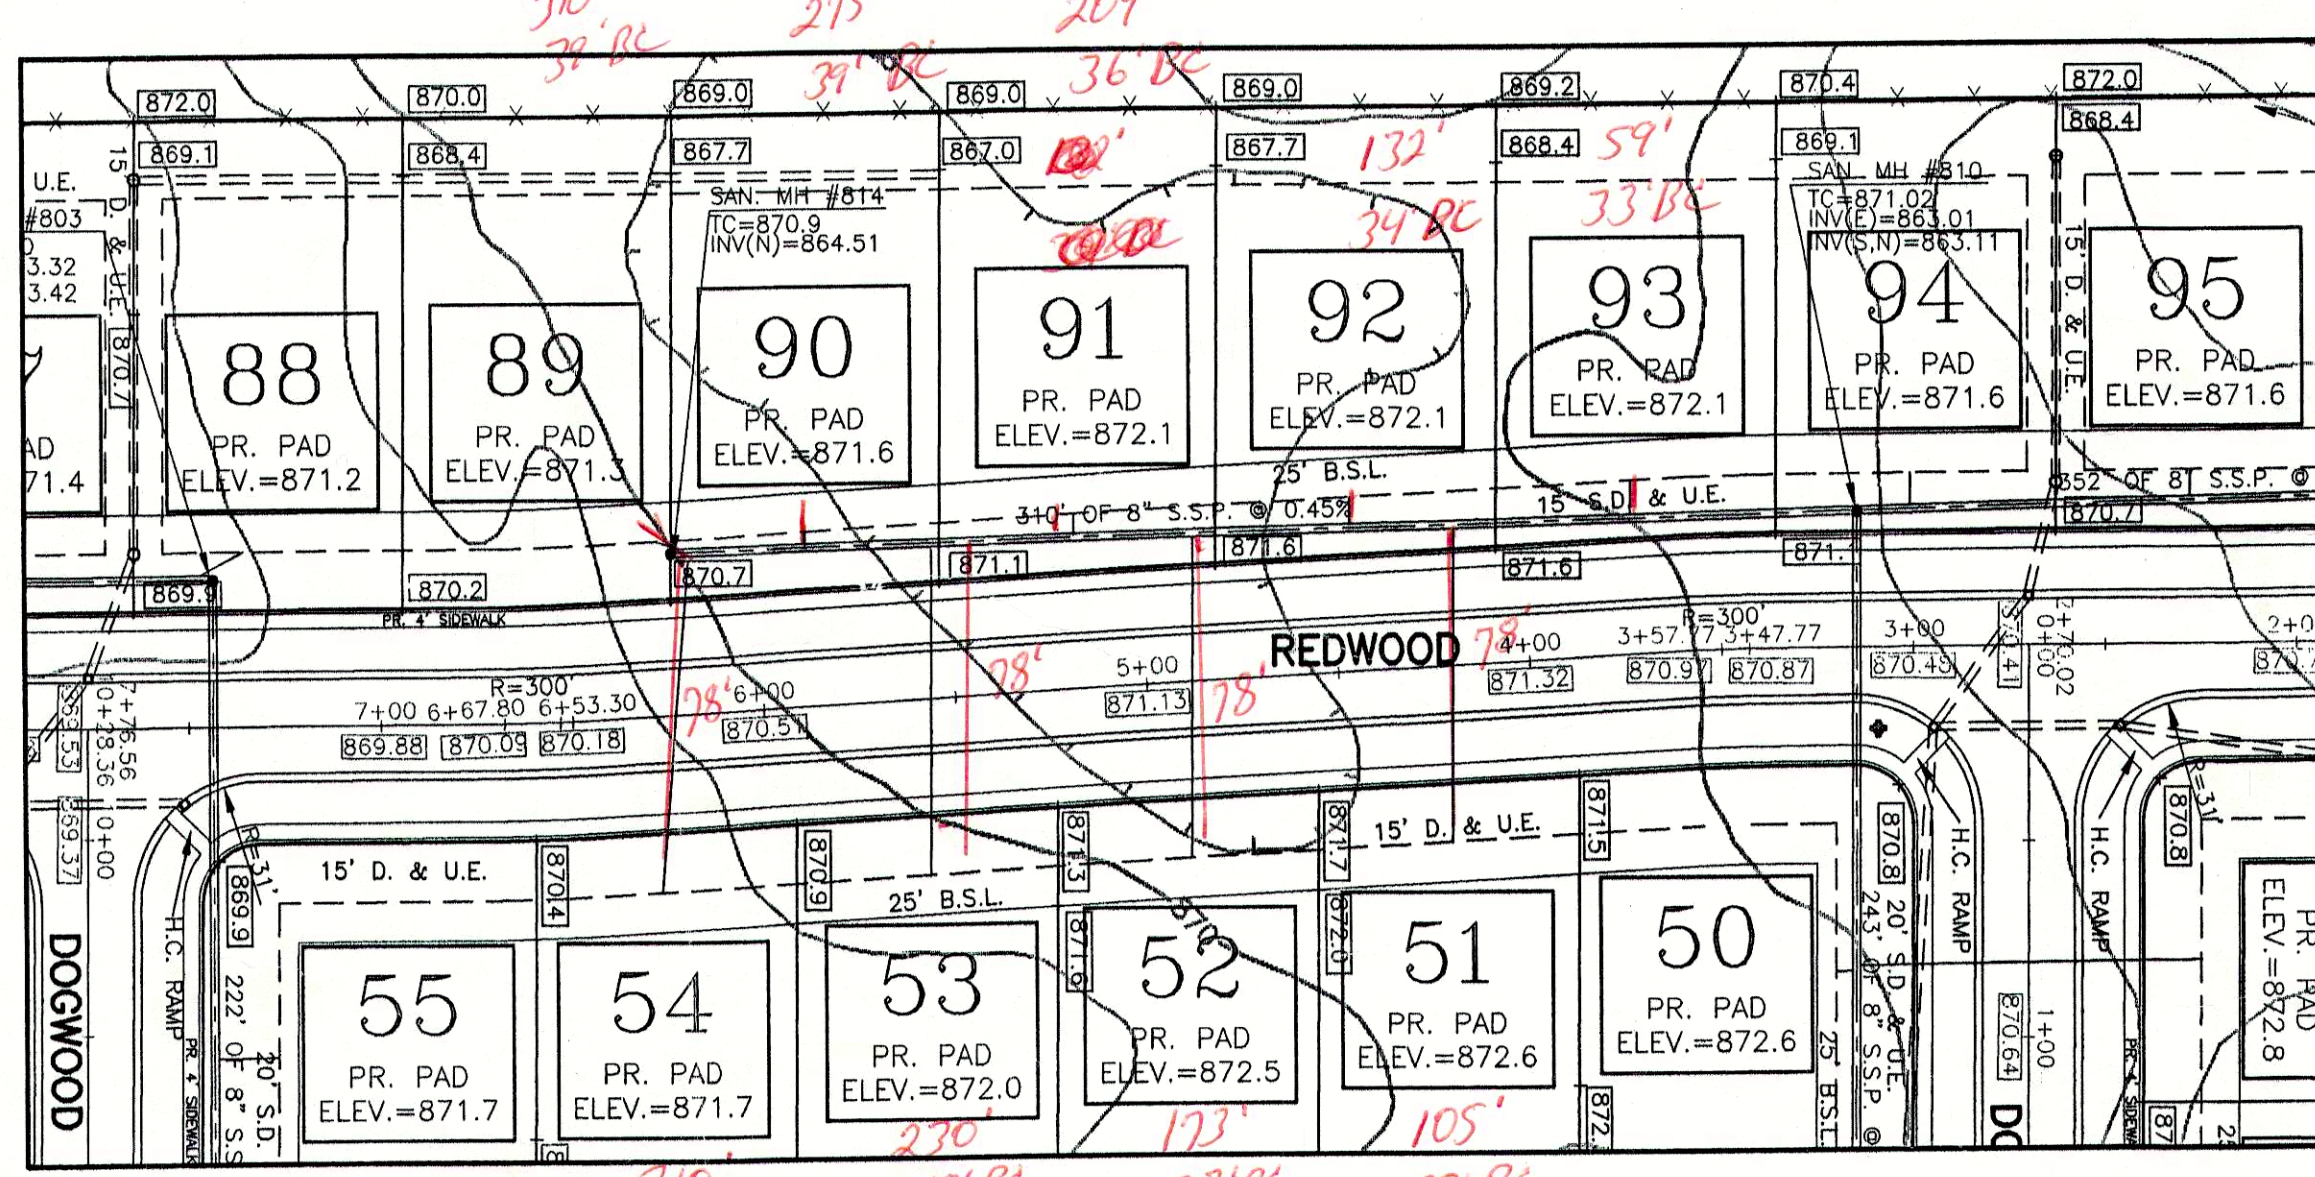
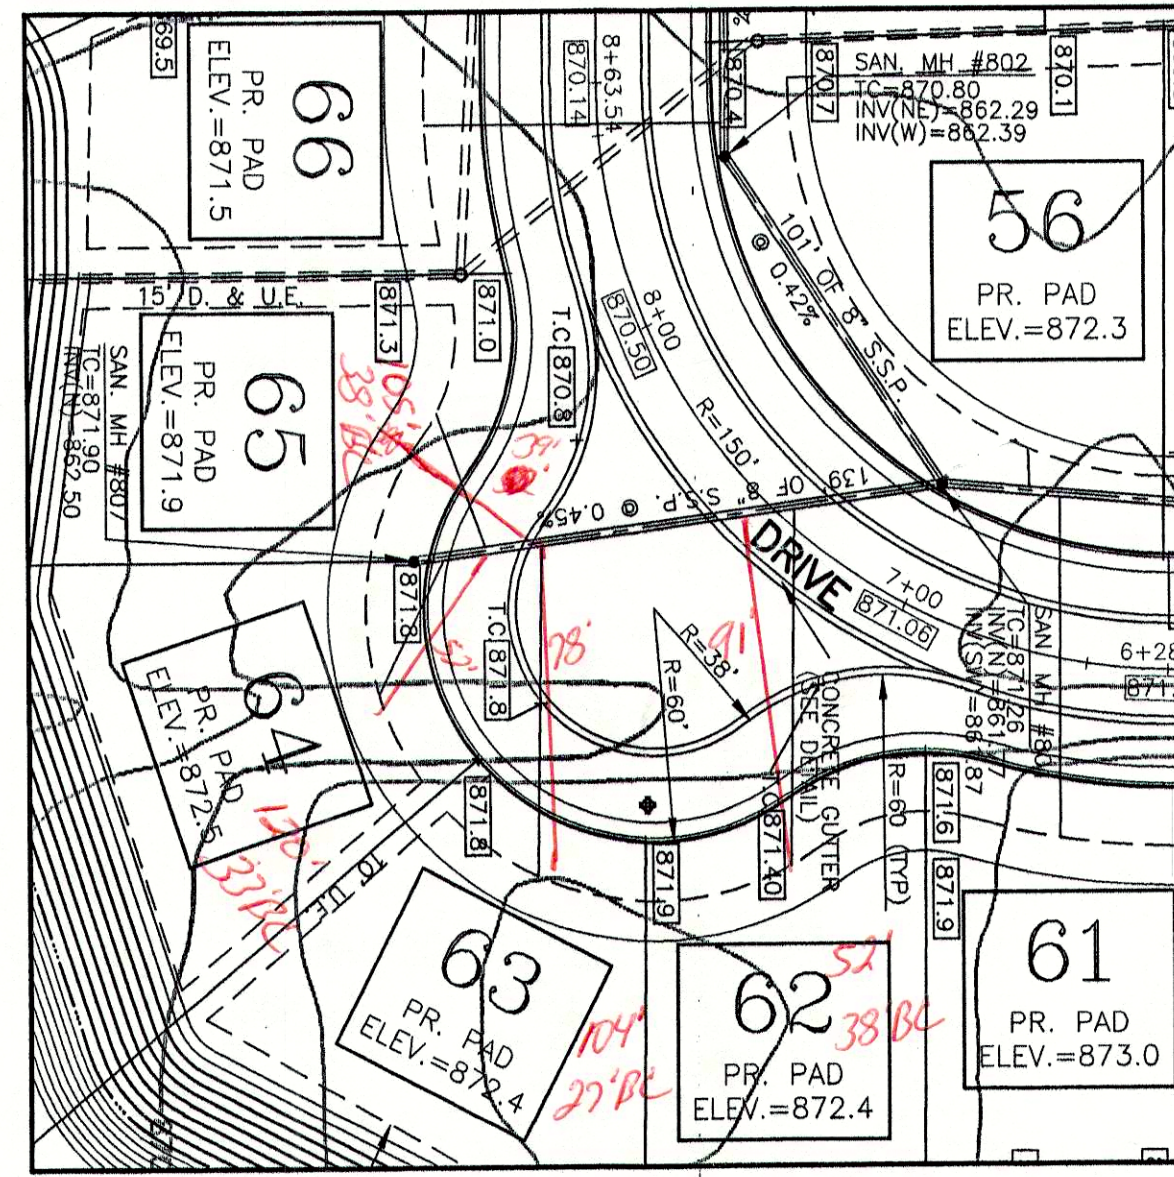
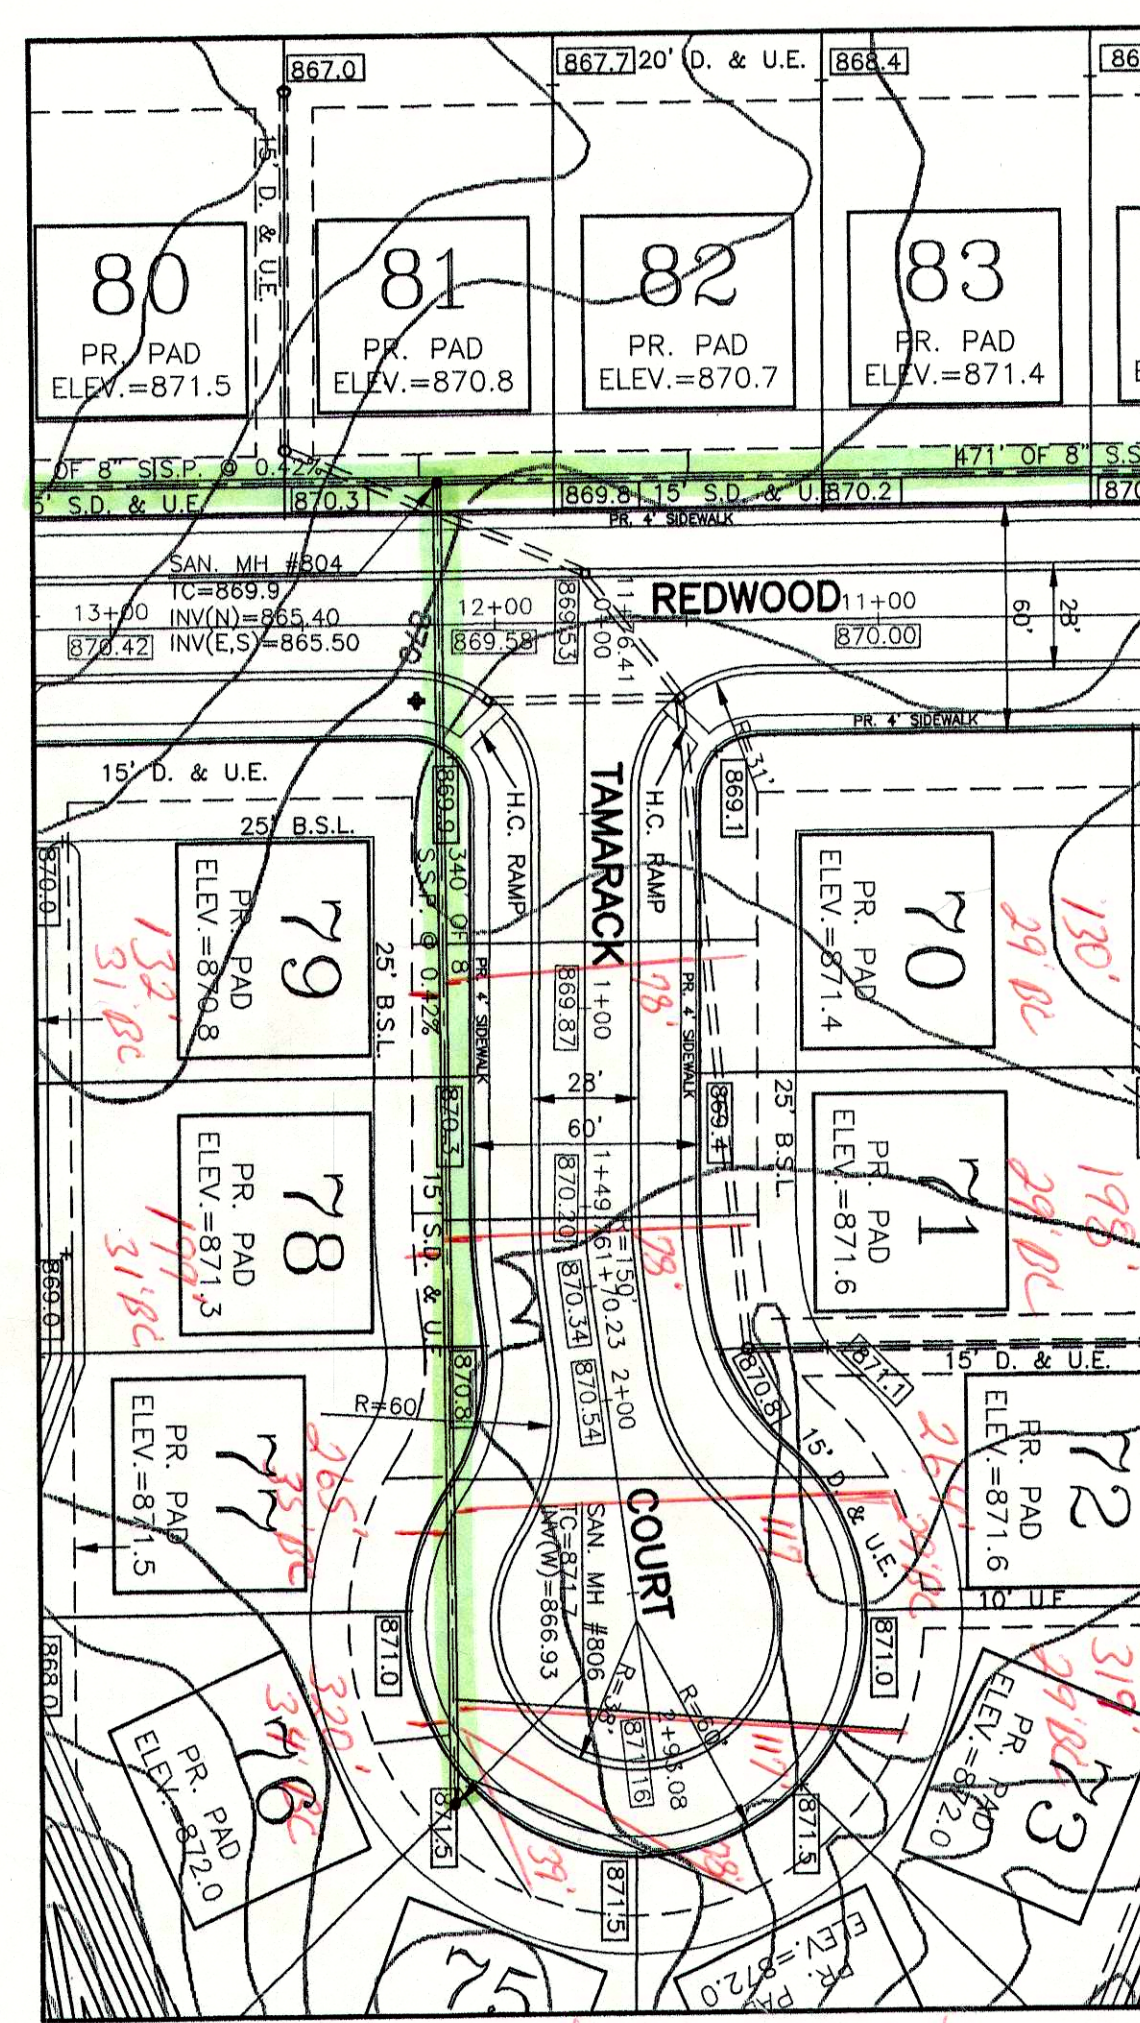


LATERAL LOCATION TABLE

LOT #	PROPOSED STATIONING
70	1+20
71	1+90
72	2+58
73	3+13
74	3+33
75	3+35
76	3+22
77	2+58
78	1+90
79	1+20
82	0+38
83	1+08
84	1+30
85	1+20
51	1+05
52	1+72
53	2+41
54	3+04
89	3+09
90	2+74
91	2+05
92	1+32
93	0+59

- LEGEND**
- GRANULAR BACKFILL
 - CONCRETE END SECTION
 - STORM SEWER LINE
 - SANITARY SEWER LINE
 - MANHOLE/INLET
 - CURB INLET
 - T.C. = TOP OF CASTING
 - INV. = INVERT
 - STR. = STRUCTURE
 - M.H. = MANHOLE
 - RCP = REINFORCED CONCRETE PIPE
 - SSP = SANITARY SEWER PIPE

- GENERAL NOTES**
- FOR STRUCTURE LOCATIONS SEE DEVELOPMENT PLAN.
 - ALL STATIONING IS SHOWN BEGINNING AT PROPOSED DOWNSTREAM STRUCTURE.
 - IT SHALL BE THE CONTRACTORS RESPONSIBILITY TO FIELD VERIFY ALL UTILITY LOCATIONS PRIOR TO ANY CONSTRUCTION ACTIVITY.
 - OCCUPATIONAL SAFETY AND HEALTH ADMINISTRATION (OSHA) STANDARDS FOR EXCAVATIONS; FINAL RULE 29 CFR PART 1926, SUBPART "P" APPLIES TO ALL EXCAVATIONS EXCEEDING FIVE (5) FEET IN DEPTH.
 - IN ADDITION, EXCAVATION EXCEEDING TWENTY (20) FEET IN DEPTH SHALL REQUIRE THE DESIGN OF A TRENCH SAFETY SYSTEM BY A REGISTERED PROFESSIONAL ENGINEER.
 - GRANULAR BACKFILL ALL PIPE LOCATED UNDER AND WITHIN 5' OF PAVED SURFACES. SEE DETAIL SHEET FOR PIPE BEDDING DETAIL.
 - CONTRACTOR SHALL PRESERVE TREES WHERE POSSIBLE.
 - ALL PROPOSED GRADES SHALL MATCH EXISTING GRADES AT PROPERTY LINE.
 - WYE & LATERAL STATIONING IS SHOWN FROM DOWNSTREAM MANHOLE.

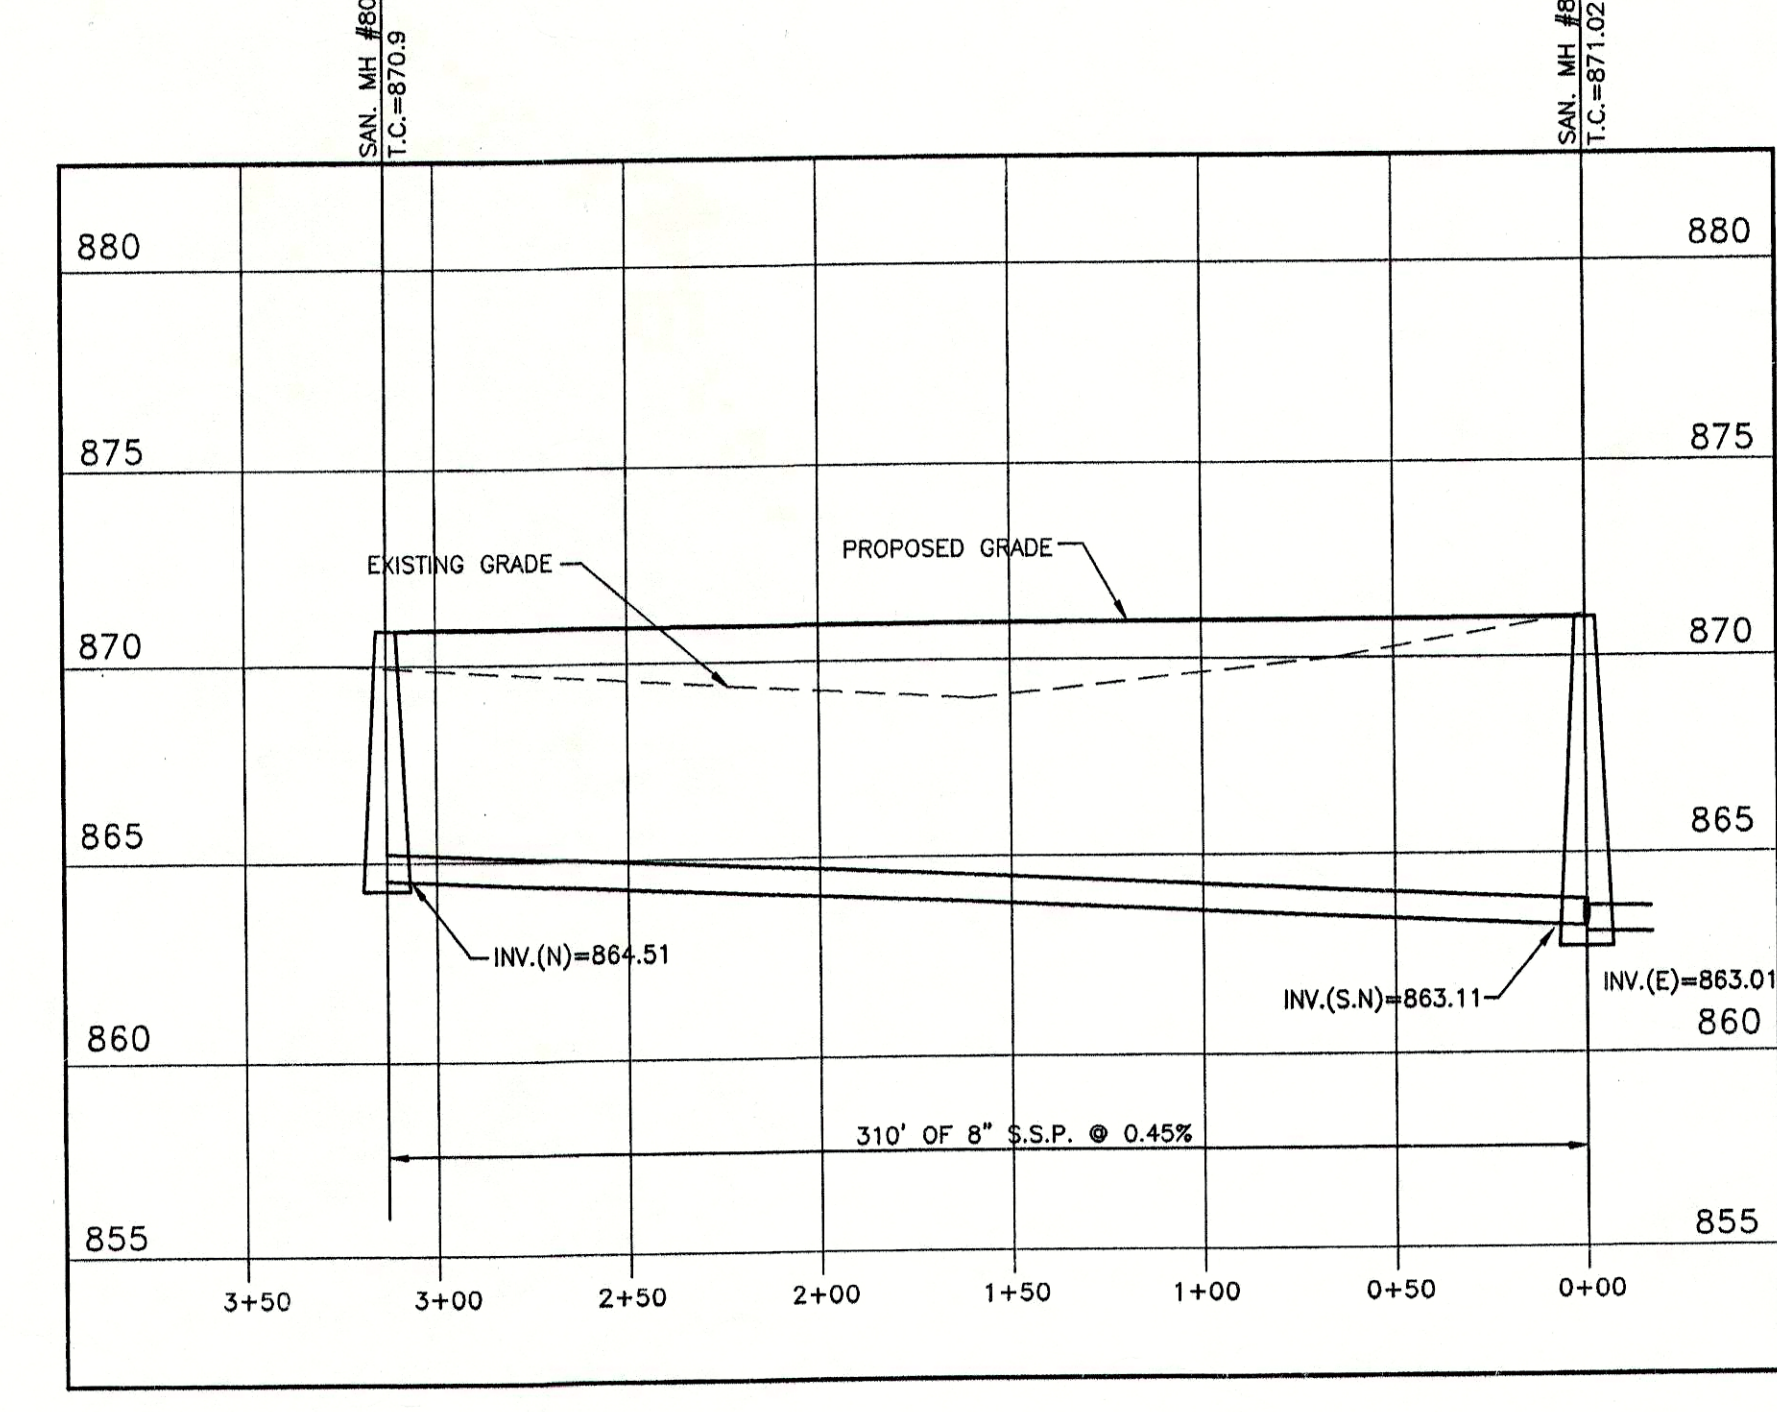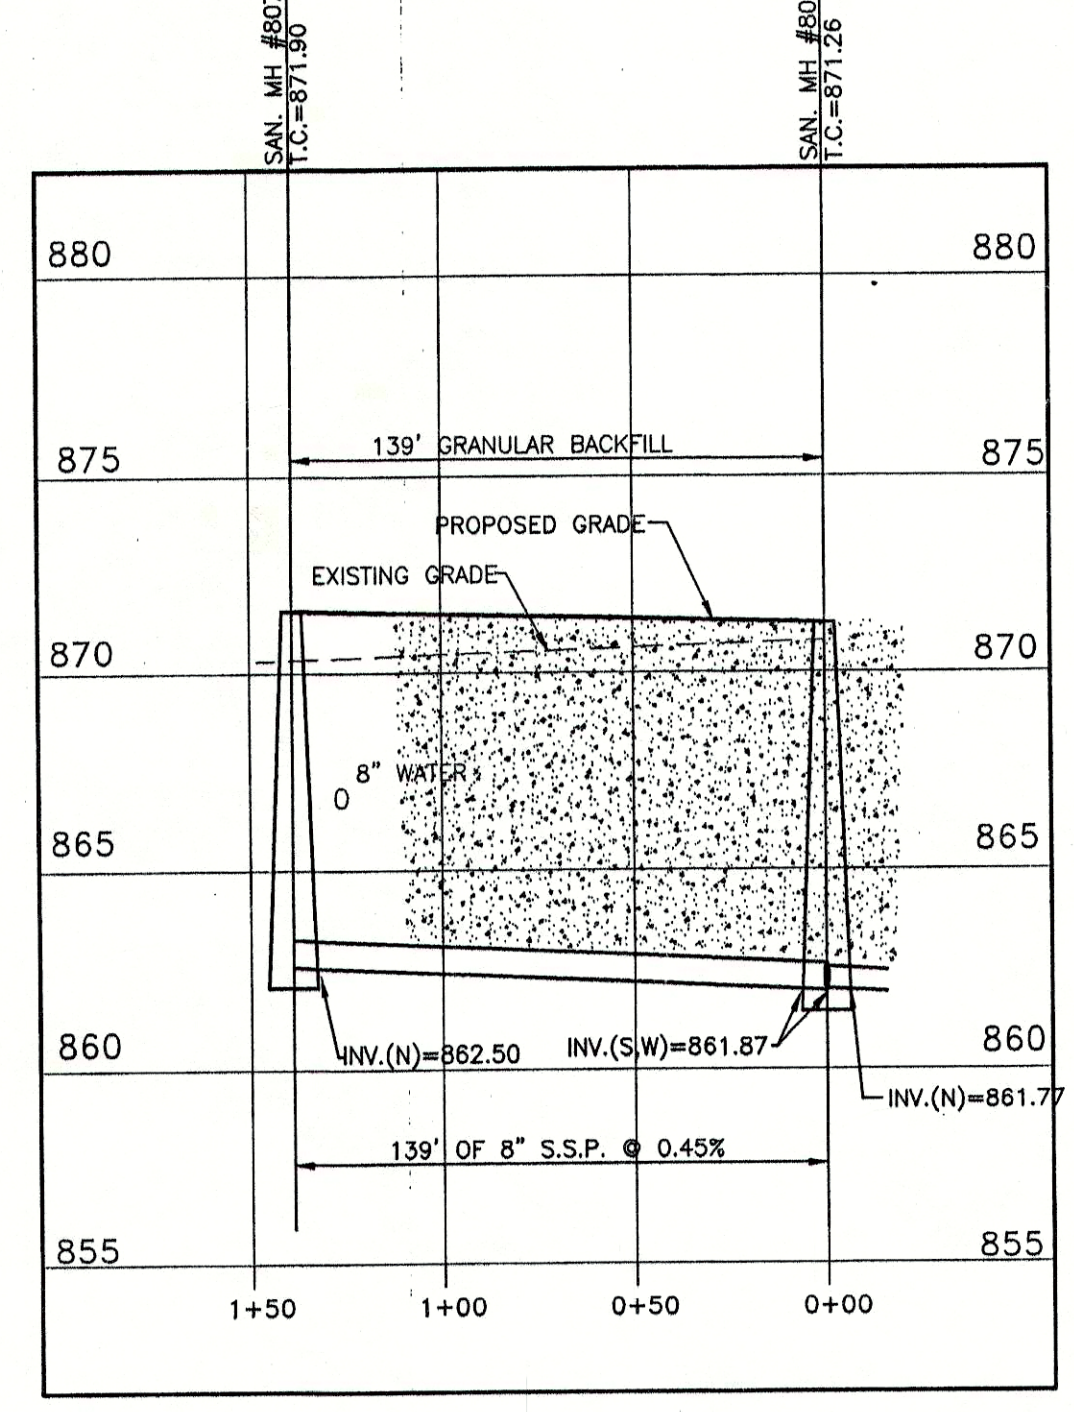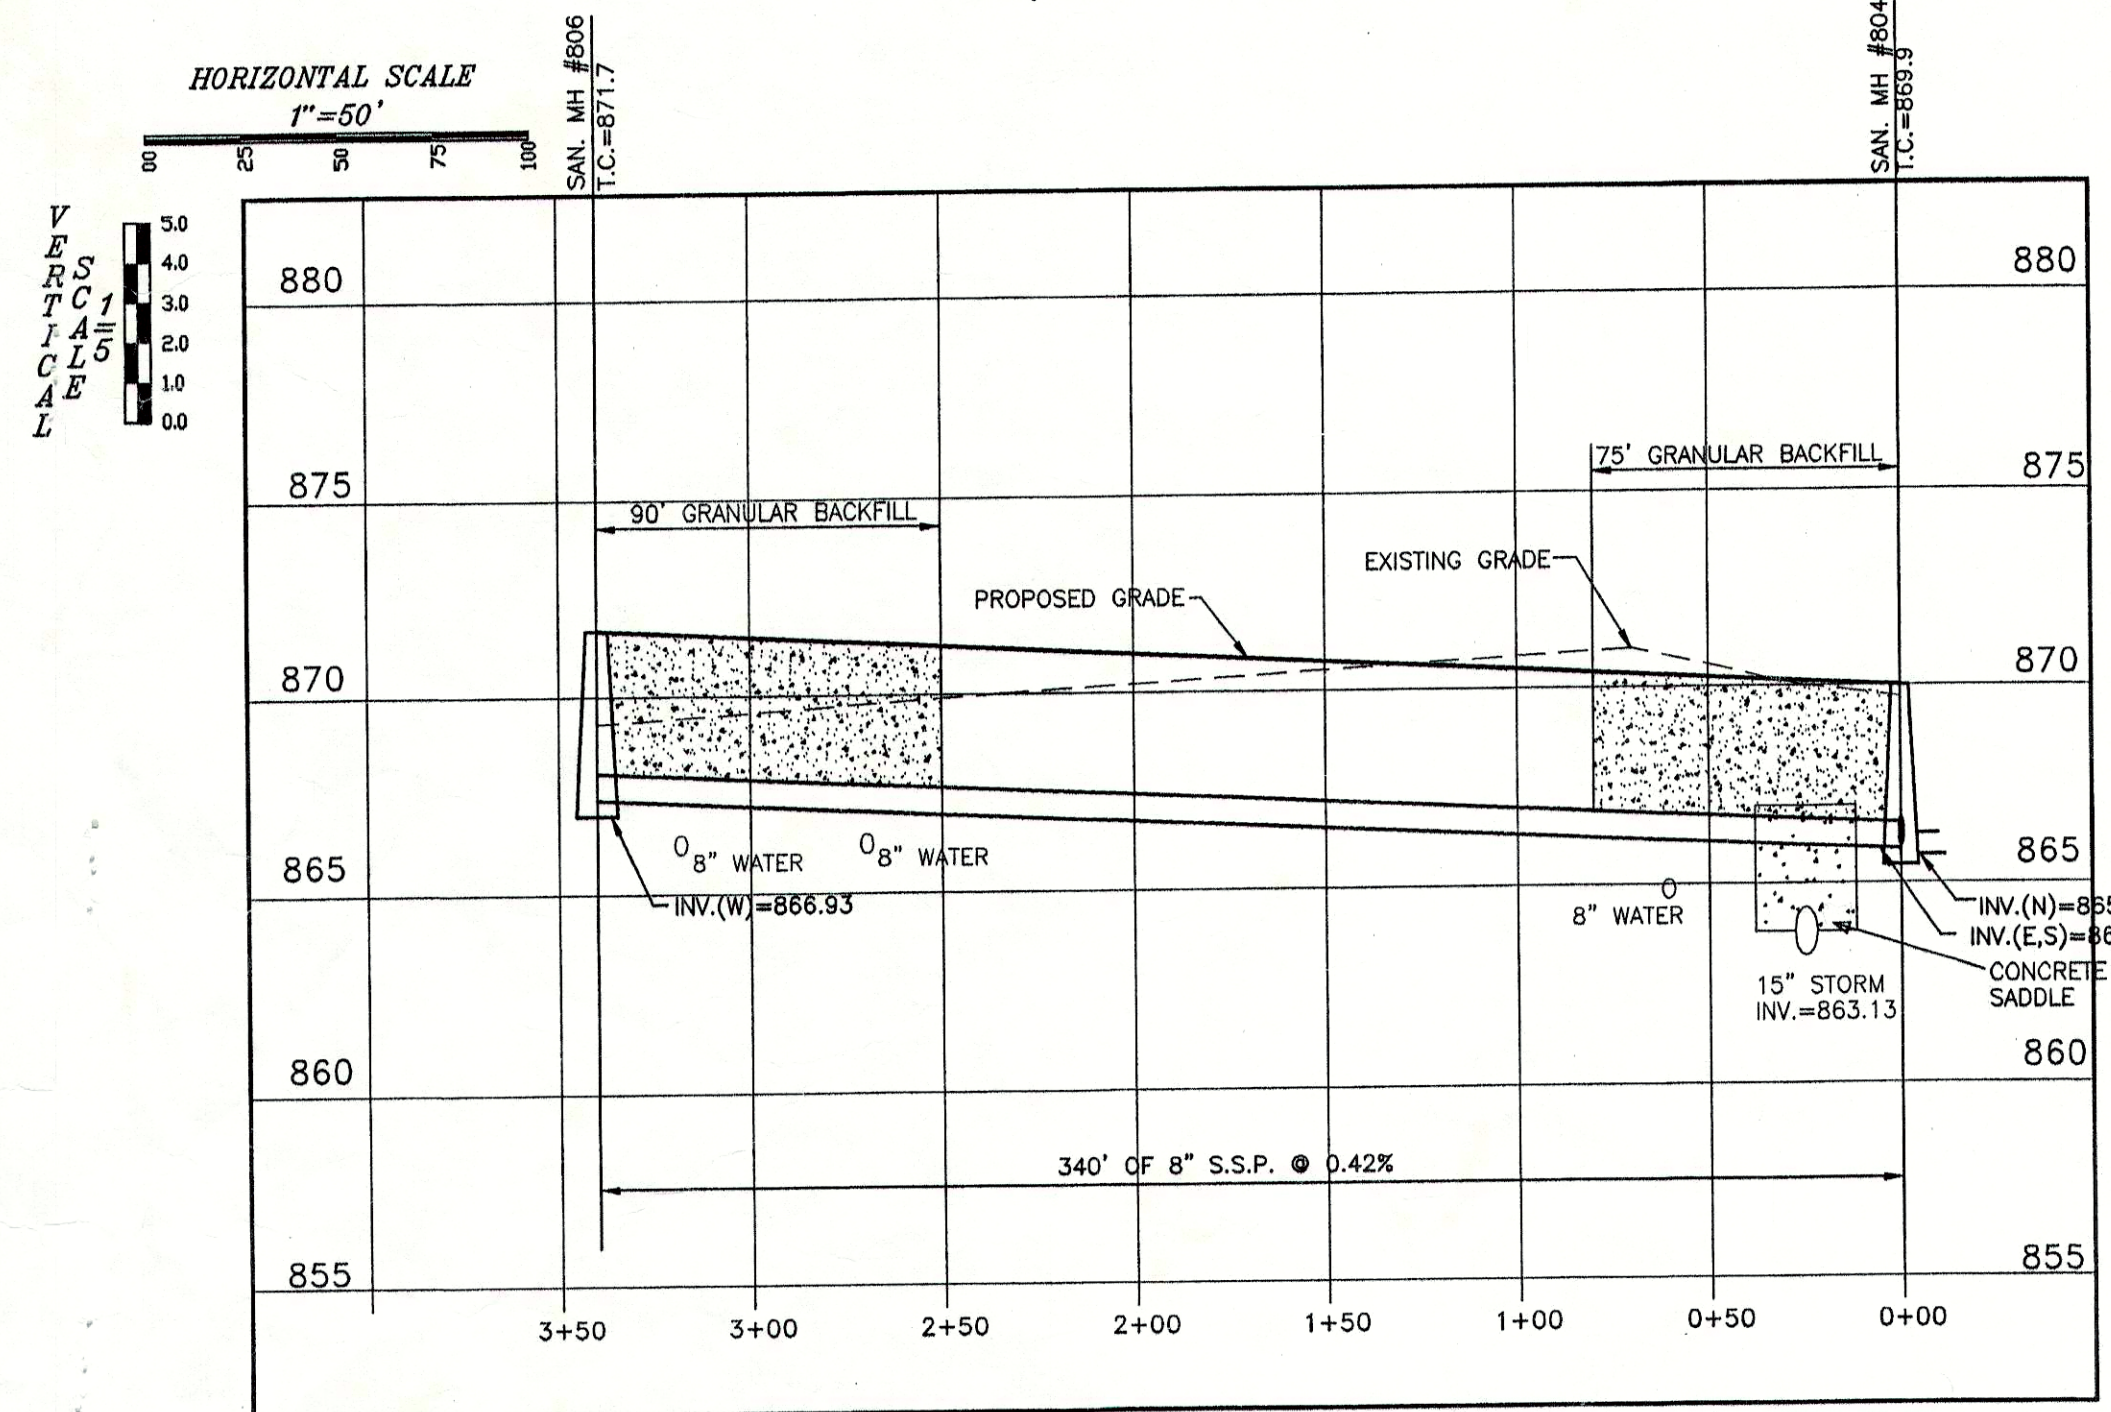

WEIHE ENGINEERS, INC.

1065 NORTH COLLEGE AVENUE
CITY, MO 64304
(314) 864-6611 FAX (314) 864-6646
TOLL-FREE (800) 452-6008

ALLAN H. WEIHE
REGISTERED CIVIL ENGINEER
REGISTERED LAND SURVEYOR
PRESIDENT

CIVIL ENGINEERS • LAND SURVEYORS • LAND PLANNERS • LANDSCAPE ARCHITECTS

PROJECT NO. 13
DATE 7/19/02
BY: [Signature]
CHECKED BY: [Signature]
DATE 7/19/02

THE PINES AT DEERFIELD SECTION TWO
CORONADO DEVELOPMENT CORP.
SANITARY SEWER PLAN & PROFILE

REVISIONS AND ISSUES

NO. 8827
STATE OF MISSOURI
REGISTERED PROFESSIONAL ENGINEER

PREPARED FOR: [Signature]
SHEET NO. 13
PROJECT NO. W02-0541