
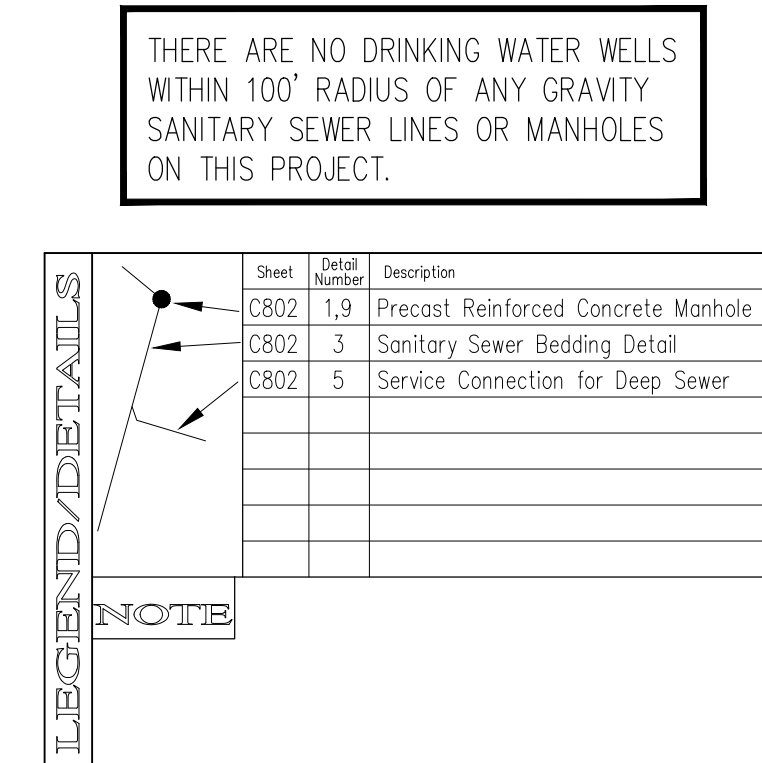


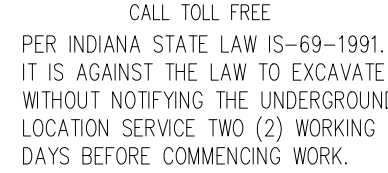

NOTE:
Record drawing certification for top of casting, invert elevations, lengths of pipe, and lateral marker location only. Slope percentage represents a calculated figure and is for general information only.

REVISIONS:

1. DTR, 8/7/03, CHANGED PROJECT NAME AND 3 STREET NAMES.
2. BMM, 3/5/04-UPDATED PER RECORD DRAWING INFORMATION.

DATE:

THIS DRAWING AND THE IDEAS, DESIGNS AND CONCEPTS CONTAINED HEREIN ARE THE EXCLUSIVE INTELLECTUAL PROPERTY OF THE SCHNEIDER CORPORATION, AND ARE NOT TO BE USED OR REPRODUCED, IN WHOLE OR IN PART, WITHOUT THE WRITTEN CONSENT OF THE SCHNEIDER CORPORATION.

© COPYRIGHTED BY THE SCHNEIDER CORP. (2003)



- Architecture
- Civil Engineering
- Environmental Engineering
- Geotechnical Services
- GIS * LIS
- Home Builder Services
- Interior Design
- Land Surveying
- Landscape Architecture
- Transportation Engineering

PRAIRIE HOLLOW
SECTION 1
INGALLS, INDIANA


C. P. MORGAN COMMUNITIES, L.
4670 HAVEN POINT BLVD., INDIANAPOLIS, IN.

SHEET TITLE: **SANITARY SEWER
PLAN & PROFILES**

DRAWING FILES:
R:\4K\4496\001\DWG\SC401-4
XREF: R:\4K\4496\001\DWG\1BS
XREF: R:\4K\4496\001\DWG\SANITARY
XREF: R:\4K\4496\002\DWG\2BS
XREF: R:\4K\4496\003\DWG\3BS
XREF: R:\4K\4496\001\DWG\SAN_03
XREF: R:\4K\4496\001\DWG\4496001S

SHEET NO.:

C402

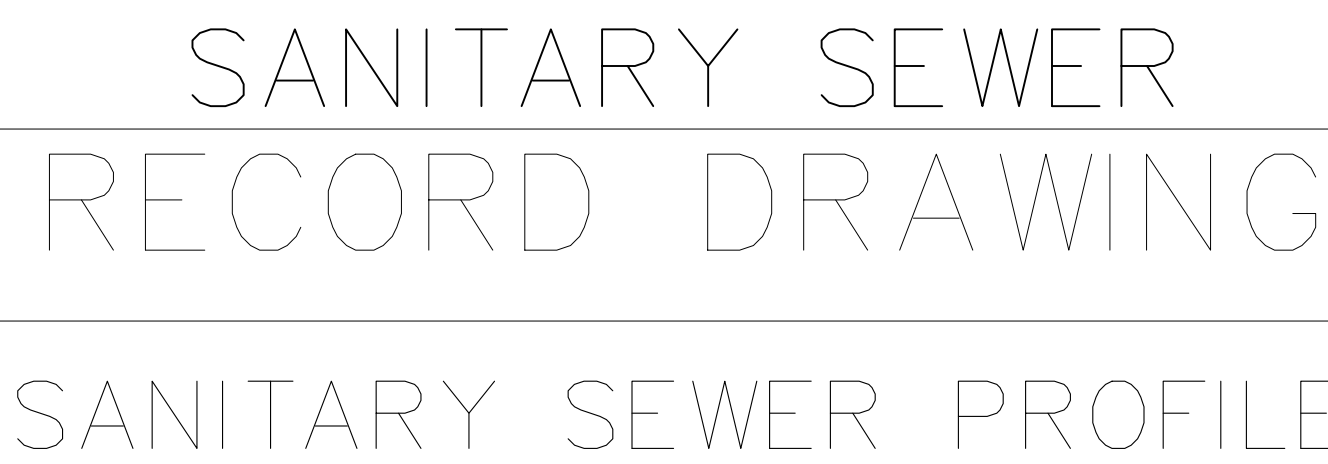

LEGEND		
		
Existing Grade	New Grade	Granular Backfill

$$\text{SCALE: } \frac{\text{HORIZ.: } 1''=50'}{\text{VERT.: } 1''=5'}$$