

FOR CONTINUATION
SEE SHEET C404

FOR CONTINUATION
SEE SHEET C402

BENCHMARK

BM - ABOUT 3.05 MILES NORTH ALONG STATE HIGHWAY 13 FROM ITS JUNCTION WITH STATE ROAD 238 AT FORTVILLE, ABOUT 0.55 MILE NORTH OF A BRIDGE OVER FALL CREEK, AT THE JUNCTION OF A ROAD LEADING WEST, 30 FEET WEST OF THE CENTERLINE OF THE HIGHWAY, 3 FEET SOUTH OF THE CENTERLINE OF THE SIDE ROAD, 14.5 FEET SOUTH OF A CONCRETE HIGHWAY RIGHT-OF-WAY MARKER POST, 1.5 FEET EAST OF THE FENCE LINE, 1.5 FEET SOUTH OF A WHITE WOODEN WITNESS POST, ABOUT LEVEL WITH THE HIGHWAY AND SET IN THE TOP OF A CONCRETE POST PROJECTING ABOUT 6 INCHES, BEING A STANDARD DISK STAMPED 70236 1947
ELEVATION = 860.48 (NOV 1929)

TM 1 - CUT "X" ON THE NORTHERN MOST BONNET BOLT OF A FIRE HYDRANT ON THE EAST SIDE OF COUNTY ROAD 750 WEST, ABOUT 850 FEET NORTH OF COUNTY ROAD 1100 NORTH
ELEVATION = 860.075 (NOV 29)

TM 2 - MAG NAIL 1.0 FEET UP ON THE EAST SIDE OF POWER POLE #17-366 ON THE WEST SIDE OF COUNTY ROAD 750 WEST, ABOUT 200 FEET NORTH OF STATE ROAD 67
ELEVATION = 858.075 (NOV 29)

TM 3 - MAG NAIL 1.0 FEET UP ON THE NORTH SIDE OF POWER POLE #17-361 ON THE SOUTH SIDE OF STATE ROAD 67, ABOUT 1300 FEET SOUTHWESTERLY OF COUNTY ROAD 750 WEST
ELEVATION = 854.68 (NOV 29)

TM 4 - MAG NAIL 1.0 FEET UP ON THE EAST SIDE OF A 60 INCH DIAM. TREE IN THE NORTHWEST CORNER OF THE SUBJECT TRACT
ELEVATION = 858.12 (NOV 29)

FOR CONTINUATION
SEE SHEET C501

THERE ARE NO DRINKING WATER WELLS
WITHIN 100' RADIUS OF ANY GRAVITY
SANITARY SEWER LINES OR MANHOLES
ON THIS PROJECT.

GENERAL NOTES

- ALL WYE, LATERAL AND PROFILE STATIONS ARE FROM THE NEAREST DOWNSTREAM MANHOLE. (MH)
- WYES AND LATERALS TO BE 6" PIPE UNLESS OTHERWISE SPECIFIED.
- ALL WYE CONNECTIONS SHALL HAVE A MINIMUM OF FIVE FOOT LATERAL EXTENSION CONNECTED TO THE WYE, OR EXTEND TO THE UTILITY AND DRAINAGE EASEMENT OF THE LOT, WHICHEVER IS GREATER, BUT IN NO CASE SHOULD BE CLOSER THAN 7' TO THE PAD/BUILDING LINE. THE END OF THE LATERAL SHALL BE PLUGGED OR CAPPED, UNLESS OTHERWISE NOTED.
- LATERALS RUNNING TO THE OPPOSITE SIDE OF STREET SHALL EXTEND TO THE UTILITY AND DRAINAGE EASEMENT OF THE LOT, BUT IN NO CASE SHOULD BE CLOSER THAN 7' TO THE PAD/BUILDING LINE, UNLESS OTHERWISE NOTED.
- IT SHALL BE THE CONTRACTORS RESPONSIBILITY TO FIELD VERIFY ALL UTILITY LOCATIONS BEFORE CONSTRUCTION BEGINS.
- TEMPORARY TRAFFIC CONTROL DURING CONSTRUCTION TO CONFORM TO APPLICABLE LOCAL AND STATE STANDARDS.
- ALL CONSTRUCTION ACTIVITY ON THIS SITE TO BE PERFORMED IN COMPLIANCE WITH APPLICABLE O.S.H.A. STANDARDS FOR WORKER SAFETY.
- CONTRACTOR SHALL MINIMIZE DAMAGE TO EXISTING TREES.
- THE LOWEST FLOOR ELEVATION OF A HOME TO HAVE A GRAVITY SANITARY SEWER CONNECTION MUST BE A MINIMUM OF ONE (1) FOOT ABOVE THE TOP OF CASTING ELEVATION OF EITHER THE FIRST UPSTREAM OR DOWNSTREAM MANHOLE ON THE PUBLIC SEWER TO WHICH THE CONNECTION IS TO BE MADE, OR A GRINDER PUMP SHALL BE REQUIRED.
- THE FINISHED FLOOR OF THE HOME IS SIXTEEN (16) INCHES HIGHER THAN THE NOTED PAD ELEVATION.

SURVEYED LOCATION OF SANITARY SEWER
LATERAL MARKER. STATION IS FROM
NEAREST DOWNSTREAM MANHOLE.
* INDICATES BASELINE EXTENSION.

LEGEND/DETAILS		
Sheet	Detail	Description
C802	1,9	Precast Reinforced Concrete Manhole
C802	3	Sanitary Sewer Bedding Detail
C802	5	Service Connection for Deep Sewer
C802	4	Service Connection for Shallow Sewer

CERTIFICATION FOR "RECORD DRAWING"

NOTE:
Record drawing certification for top of casting, invert elevations, lengths of pipe, and lateral marker locations only. Slope percentage represents a calculated figure and is for general information only.

SANITARY SEWER PLAN

SCALE: 1"=50'

875

870

865

860

855

850

845

840

835

830

875

870

865

860

855

850

845

840

835

830

SANITARY SEWER RECORD DRAWING

SANITARY SEWER PROFILE

LEGEND

Existing Grade	New Grade	Granular Backfill
----------------	-----------	-------------------

SCALE: $\frac{\text{HORZ.}}{\text{VERT.}}: 1"=50'$

HOLEY MOLEY SAYS
"DON'T
DIG
BLIND"




"IT'S THE LAW"
CALL 2 WORKING DAYS BEFORE 100 DGS
1-800-382-5544

CALL TOLL FREE
PER INDIANA STATE LAW 15-59-1991
IT IS AGAINST THE LAW TO EXCAVATE
WITHOUT NOTIFYING THE UNDERGROUND
LOCATION SERVICE TWO (2) WORKING
DAYS BEFORE COMMENCING WORK.

REVISIONS:
1. DTR 8/7/03 CHANGED PROJECT NAME AND 3 STREET NAMES. ADDED MANHOLE #11
SANITARY LATERAL TO HOME LOT TO NORTH OF SITE.
2. DMR 3/5/04 UPDATED PER RECORD DRAWING INFORMATION.

DATE:
THIS DRAWING AND THE IDEAS, DESIGNS AND
CONCEPTS CONTAINED HEREIN ARE THE EXCLUSIVE
INTELLECTUAL PROPERTY OF THE SCHNEIDER
CORPORATION, AND ARE NOT TO BE USED OR
REPRODUCED, IN WHOLE OR IN PART, WITHOUT THE
WRITTEN CONSENT OF THE SCHNEIDER
CORPORATION.
© COPYRIGHTED BY THE SCHNEIDER CORP. (2003)

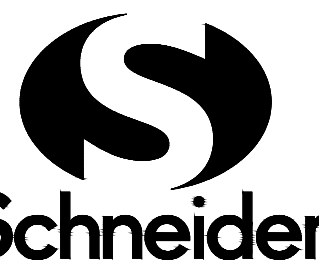

THE SCHNEIDER CORPORATION
Historic Fort Harrison
8901 Otis Avenue
Indianapolis, IN 46216-1037
Telephone: 317.826.7100
Fax: 317.826.7300
www.schneidercorp.com

Architecture
Civil Engineering
Environmental Engineering
Geotechnical Services
GIS * LIS
Home Builder Services
Interior Design
Land Surveying
Landscape Architecture
Transportation Engineering

PRAIRIE HOLLOW

SECTION 1

INGALLS, INDIANA

C. P. MORGAN COMMUNITIES, L.P.

4670 HAVEN POINT BLVD., INDIANAPOLIS, IN 46280

DATE: 7/1/03 PROJECT NO.: 4496.001
DRAWN BY: DMW CHECKED BY:

SHEET TITLE:
SANITARY SEWER
PLAN & PROFILES

DRAWING FILES:
R:\44\4496\001\DWG\SC401-4
XREF: R:\44\4496\001\DWG\1B5
XREF: R:\44\4496\001\DWG\SANITARY
XREF: R:\44\4496\002\DWG\S2B5
XREF: R:\44\4496\003\DWG\S3B5
XREF: R:\44\4496\001\DWG\SAN_05
XREF: R:\44\4496\001\DWG\44960015

SHEET NO.:

C401