

FALL CREEK REGIONAL
WASTE DISTRICT
HICKORY HILLS III
SHEET No. 4 OF 6

KEYNOTES

- ① STANDARD MANHOLE
TC = 872.92
INV. C = 869.46
- ② STANDARD MANHOLE
TC = 880.84
INV. C = 870.30
- ③ STANDARD MANHOLE
TC = 882.93
INV. C = 871.49
- ④ DROP MANHOLE
TC = 893.09
INV. C = 872.99


NOTE:

ALL LATERAL LOCATIONS ARE
MEASURED FROM DOWNSTREAM MANHOLE

A&E

644-2504

Home 778-4081

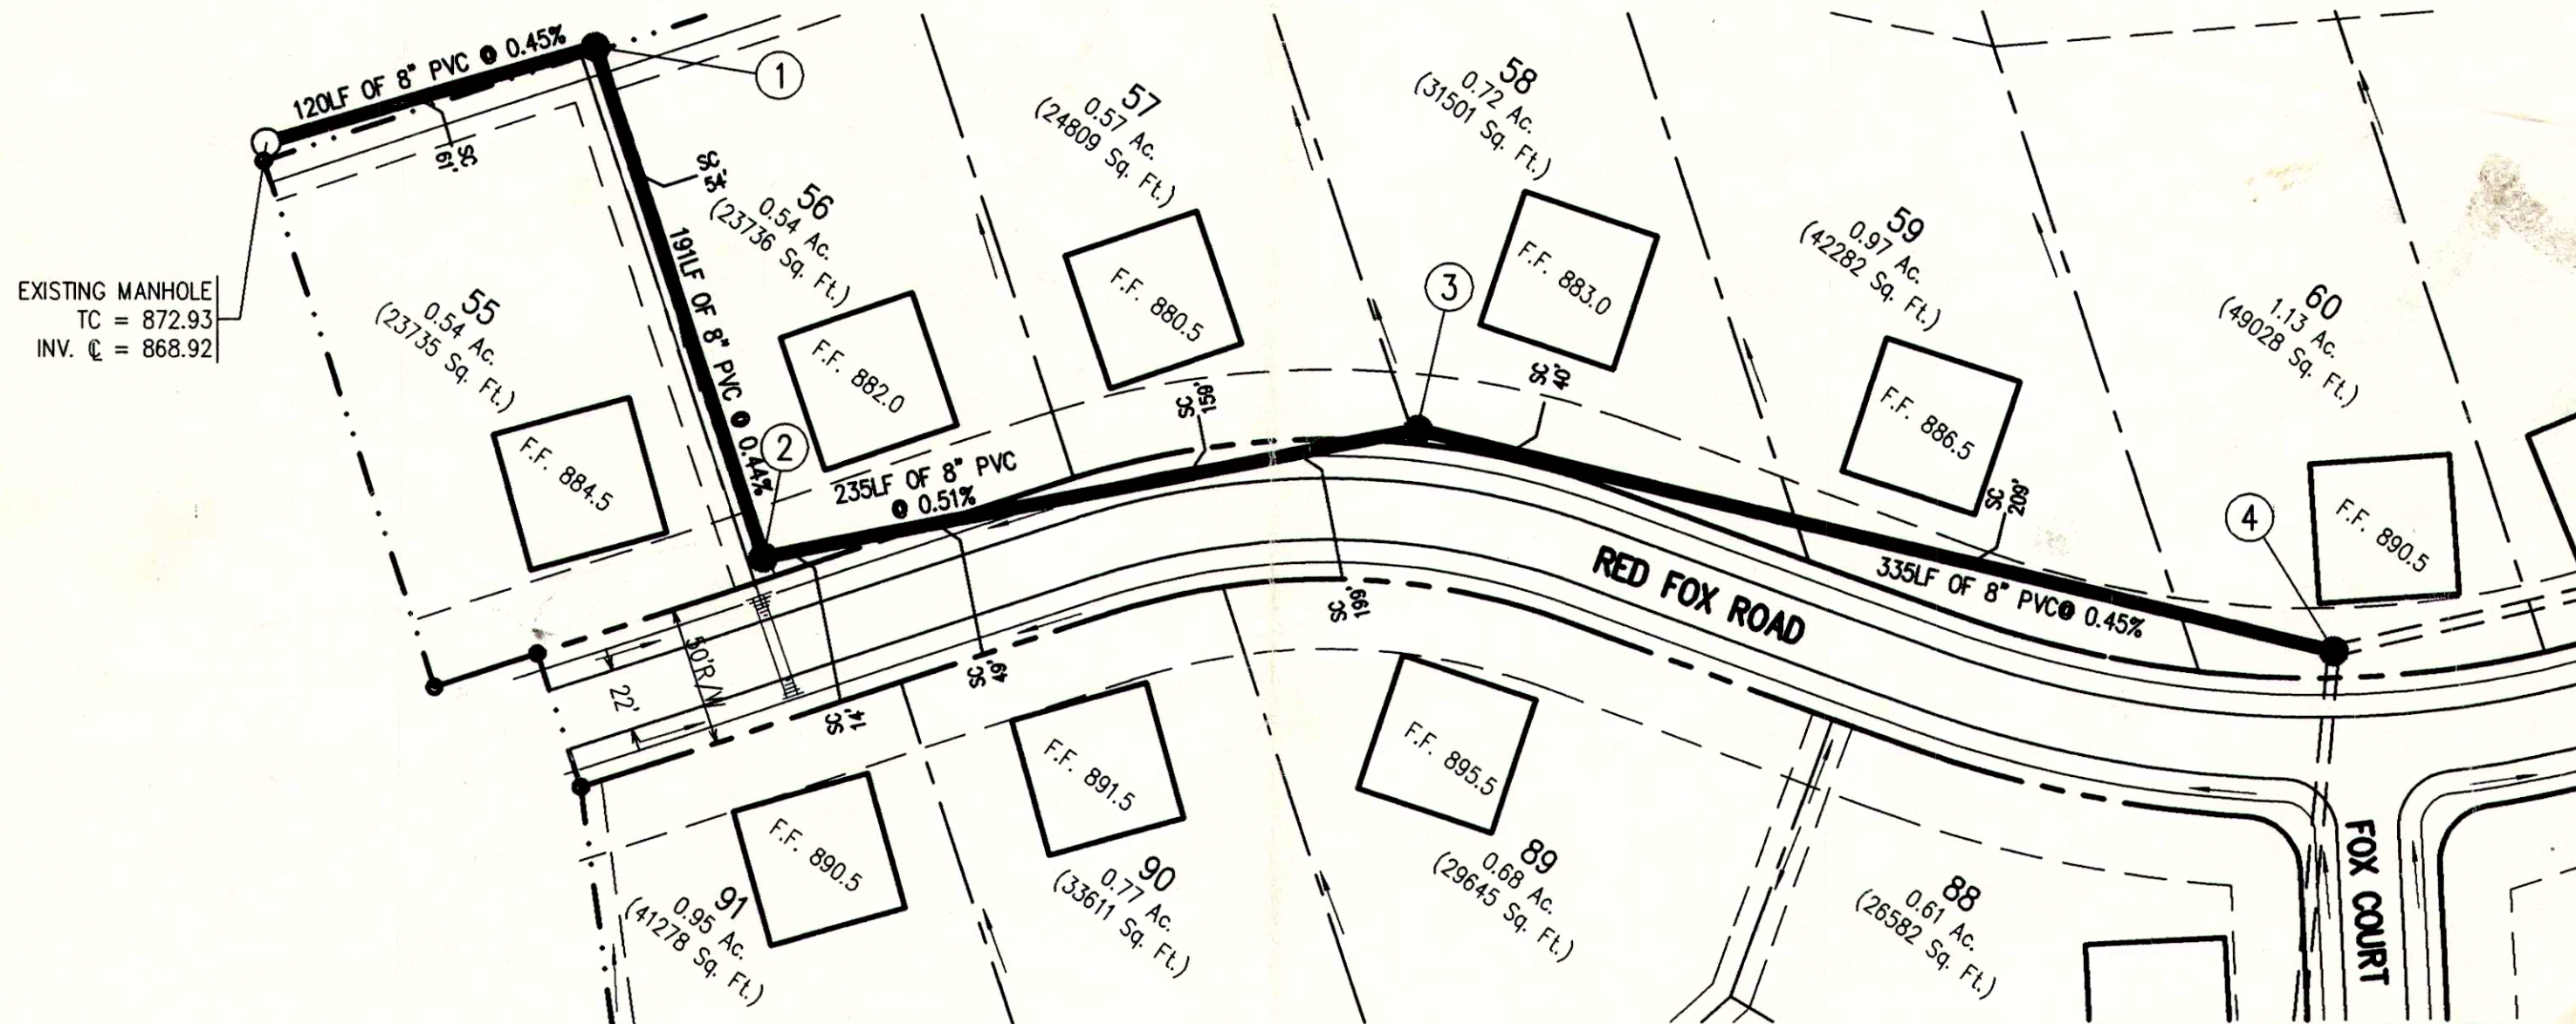

AS-BUILT INFORMATION

SCALE: 1" = 60'



NORTH

TRIAD
ASSOCIATES
INC.

INDIANAPOLIS, INDIANA

