


FALL CREEK REGIONAL
WASTE DISTRICT
HICKORY HILLS III
SHEET No. 5 OF 6

KEYNOTES

- ④ DROP MANHOLE
TC = 893.09
INV. CL = 872.99
- ⑤ STANDARD MANHOLE
TC = 881.31
INV. CL = 873.71
- ⑥ STANDARD MANHOLE
TC = 878.27
INV. CL = 874.80
- ⑦ STANDARD MANHOLE
TC = 889.75
INV. CL (W) = 876.00
INV. CL (E) = 878.02

NOTE:

ALL LATERAL LOCATIONS ARE
MEASURED FROM DOWNSTREAM MANHOLE

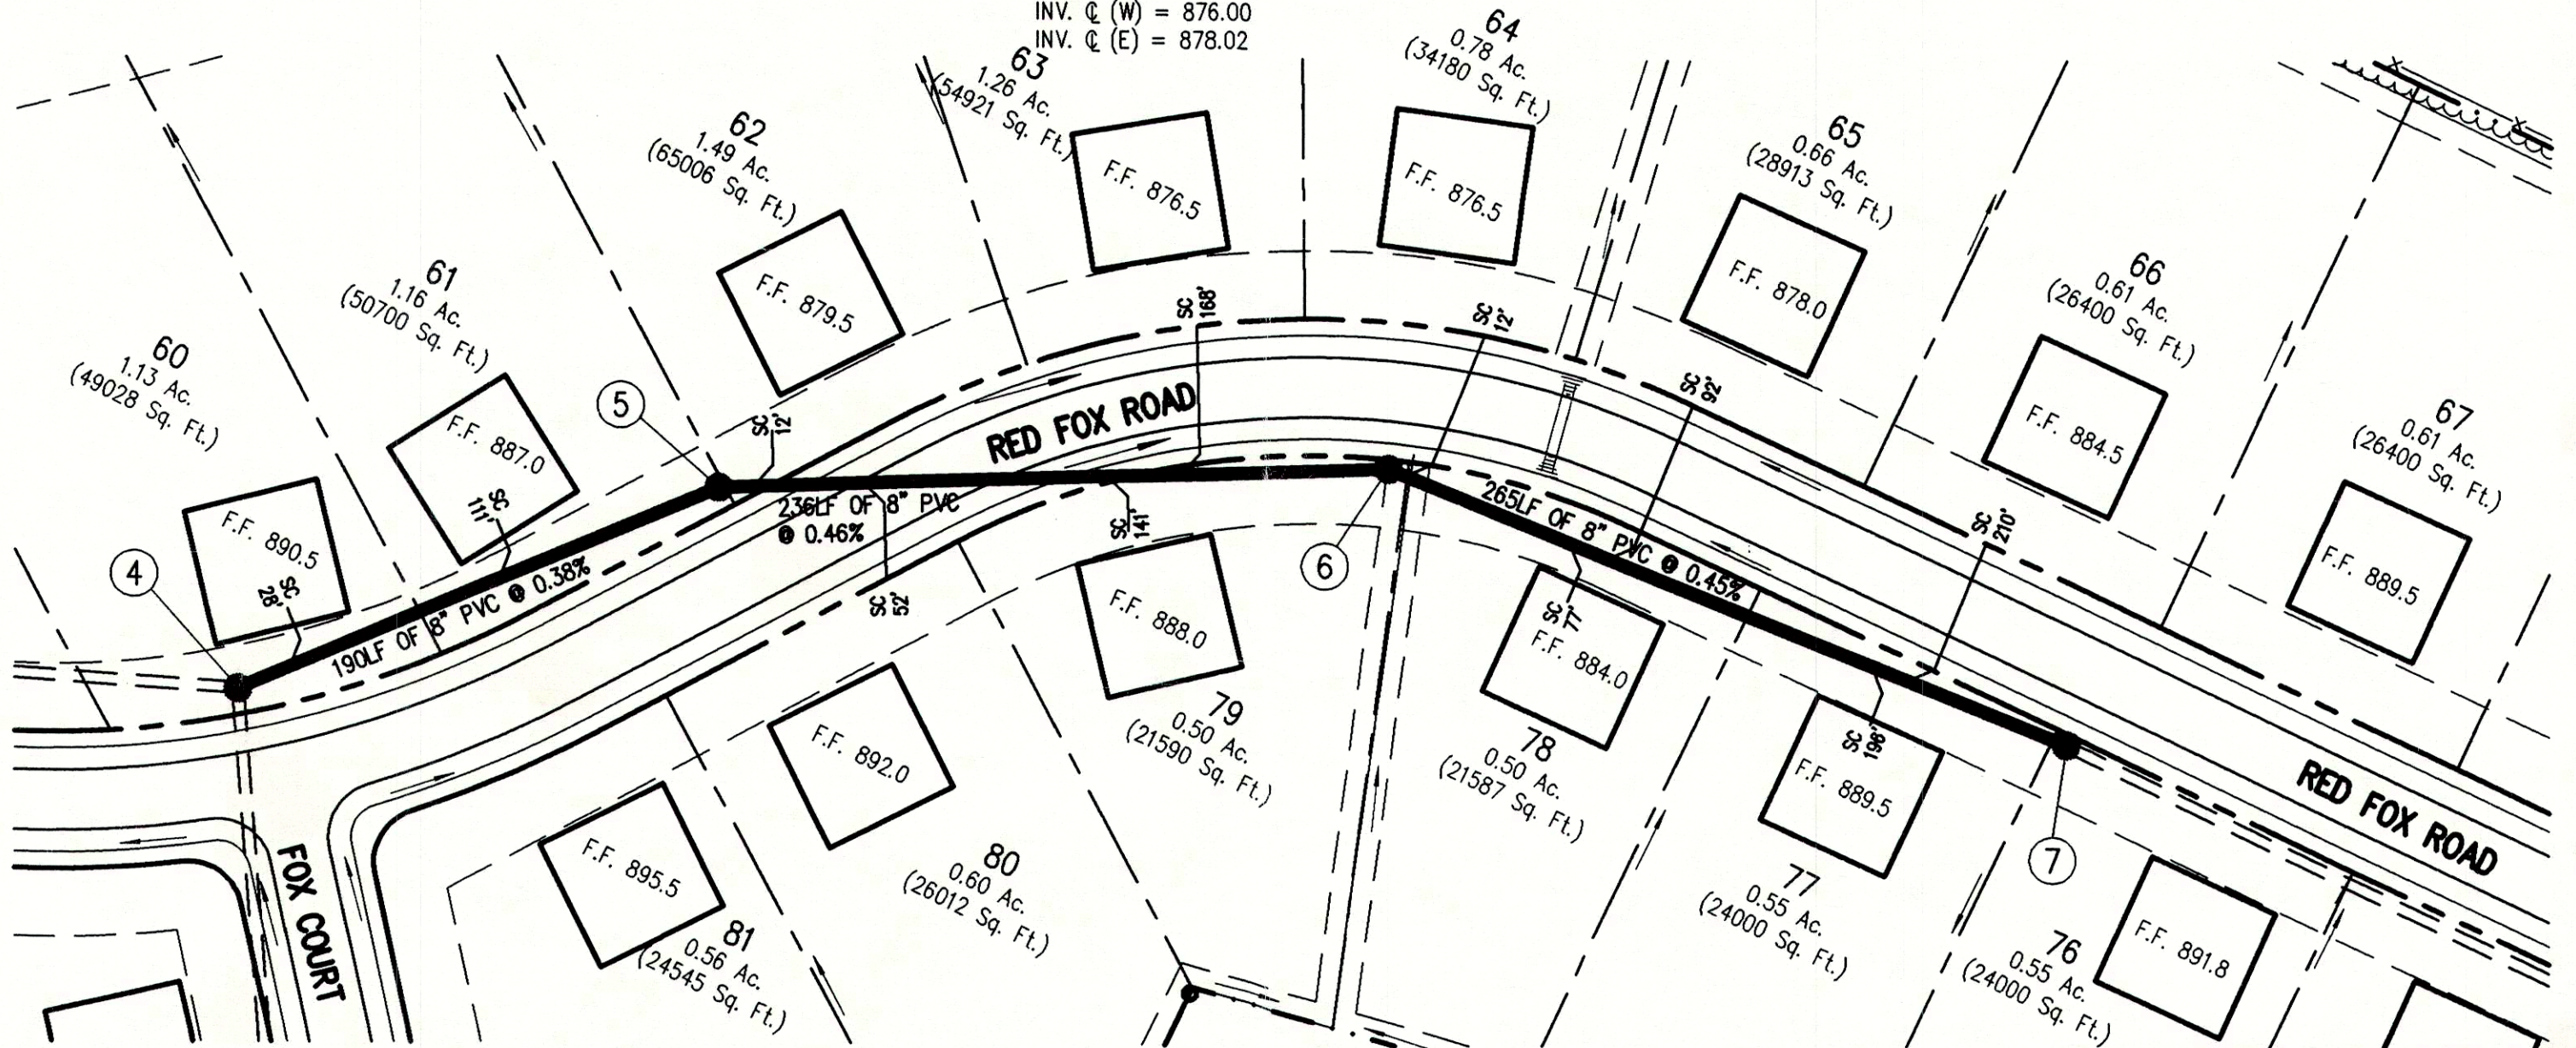

AS-BUILT INFORMATION

SCALE: 1" = 60'



TRIAD
ASSOCIATES
INC.
INDIANAPOLIS, INDIANA