


FALL CREEK REGIONAL
WASTE DISTRICT
HICKORY HILLS III
SHEET No. 5 & 6 OF 6

KEYNOTES

- ⑦ STANDARD MANHOLE
TC = 889.75
INV. $\text{C}(\text{W})$ = 876.00
INV. $\text{C}(\text{E})$ = 878.02
- ⑧ STANDARD MANHOLE
TC = 887.98
INV. $\text{C}(\text{W})$ = 879.56
INV. $\text{C}(\text{S})$ = 881.59
- ⑨ STANDARD MANHOLE
TC = 889.29
INV. $\text{C}(\text{W})$ = 882.42

NOTE:

ALL LATERAL LOCATIONS ARE
MEASURED FROM DOWNSTREAM MANHOLE

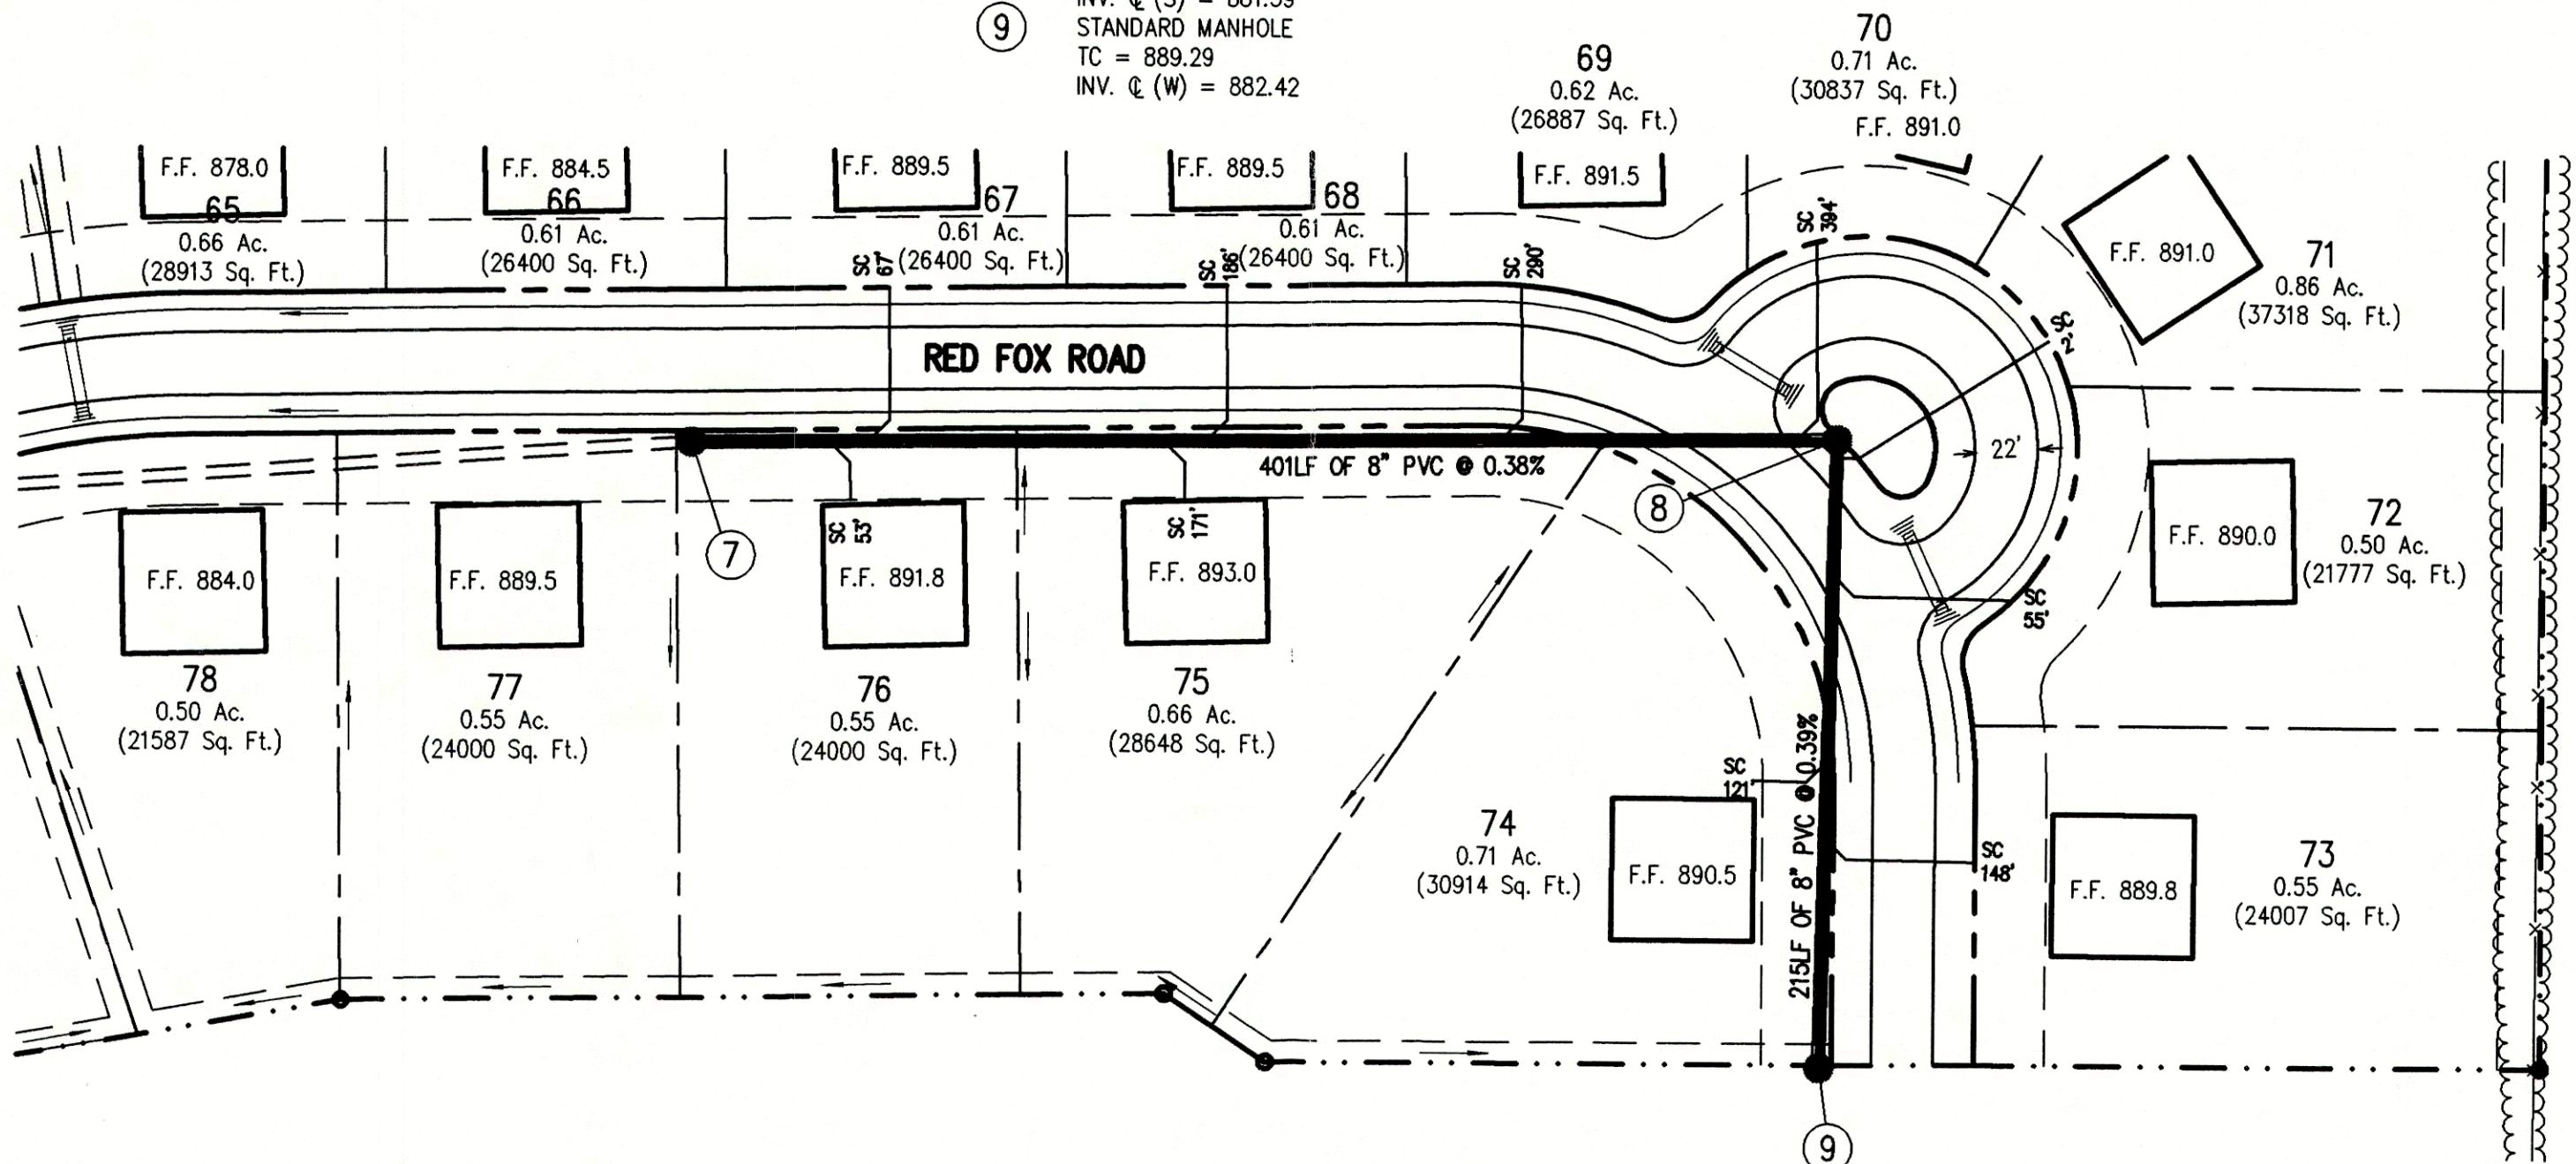

AS-BUILT INFORMATION

SCALE: 1" = 60'



TRIAD
ASSOCIATES
INC.
INDIANAPOLIS, INDIANA