


FALL CREEK REGIONAL
WASTE DISTRICT
HICKORY HILLS III
SHEET No. 6 OF 6

KEYNOTES

- ④ DROP MANHOLE
TC = 889.75
INV. ℓ (E & W) = 872.99
INV. ℓ (S) = 886.02
- ⑩ STANDARD MANHOLE
TC = 894.17
INV. ℓ = 889.69

NOTE:

ALL LATERAL LOCATIONS ARE
MEASURED FROM DOWNSTREAM MANHOLE

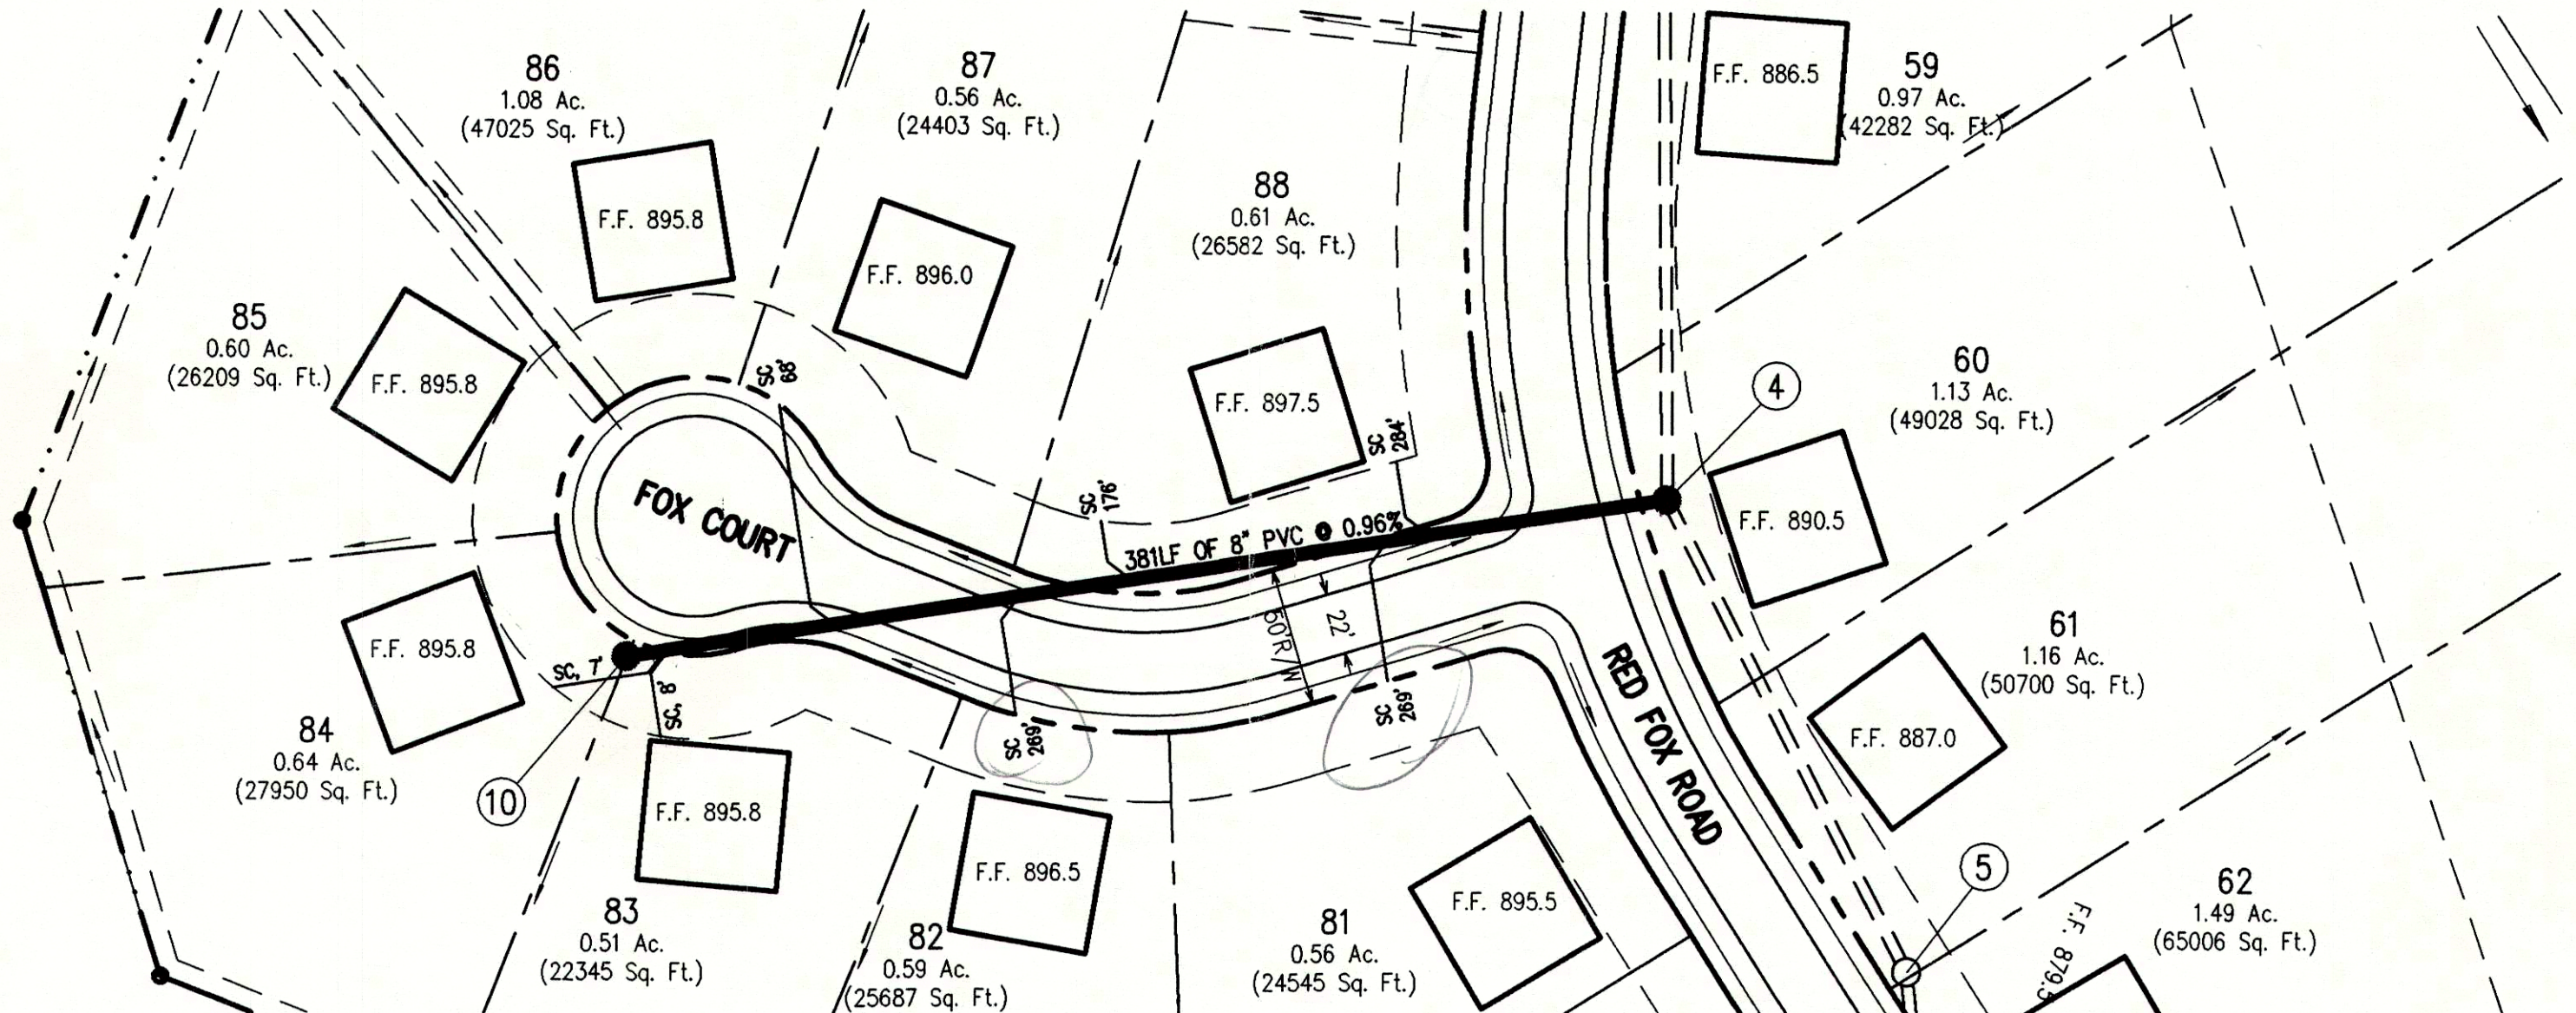

AS-BUILT INFORMATION

SCALE: 1" = 60'



TRIAD
ASSOCIATES
INC.
INDIANAPOLIS, INDIANA