


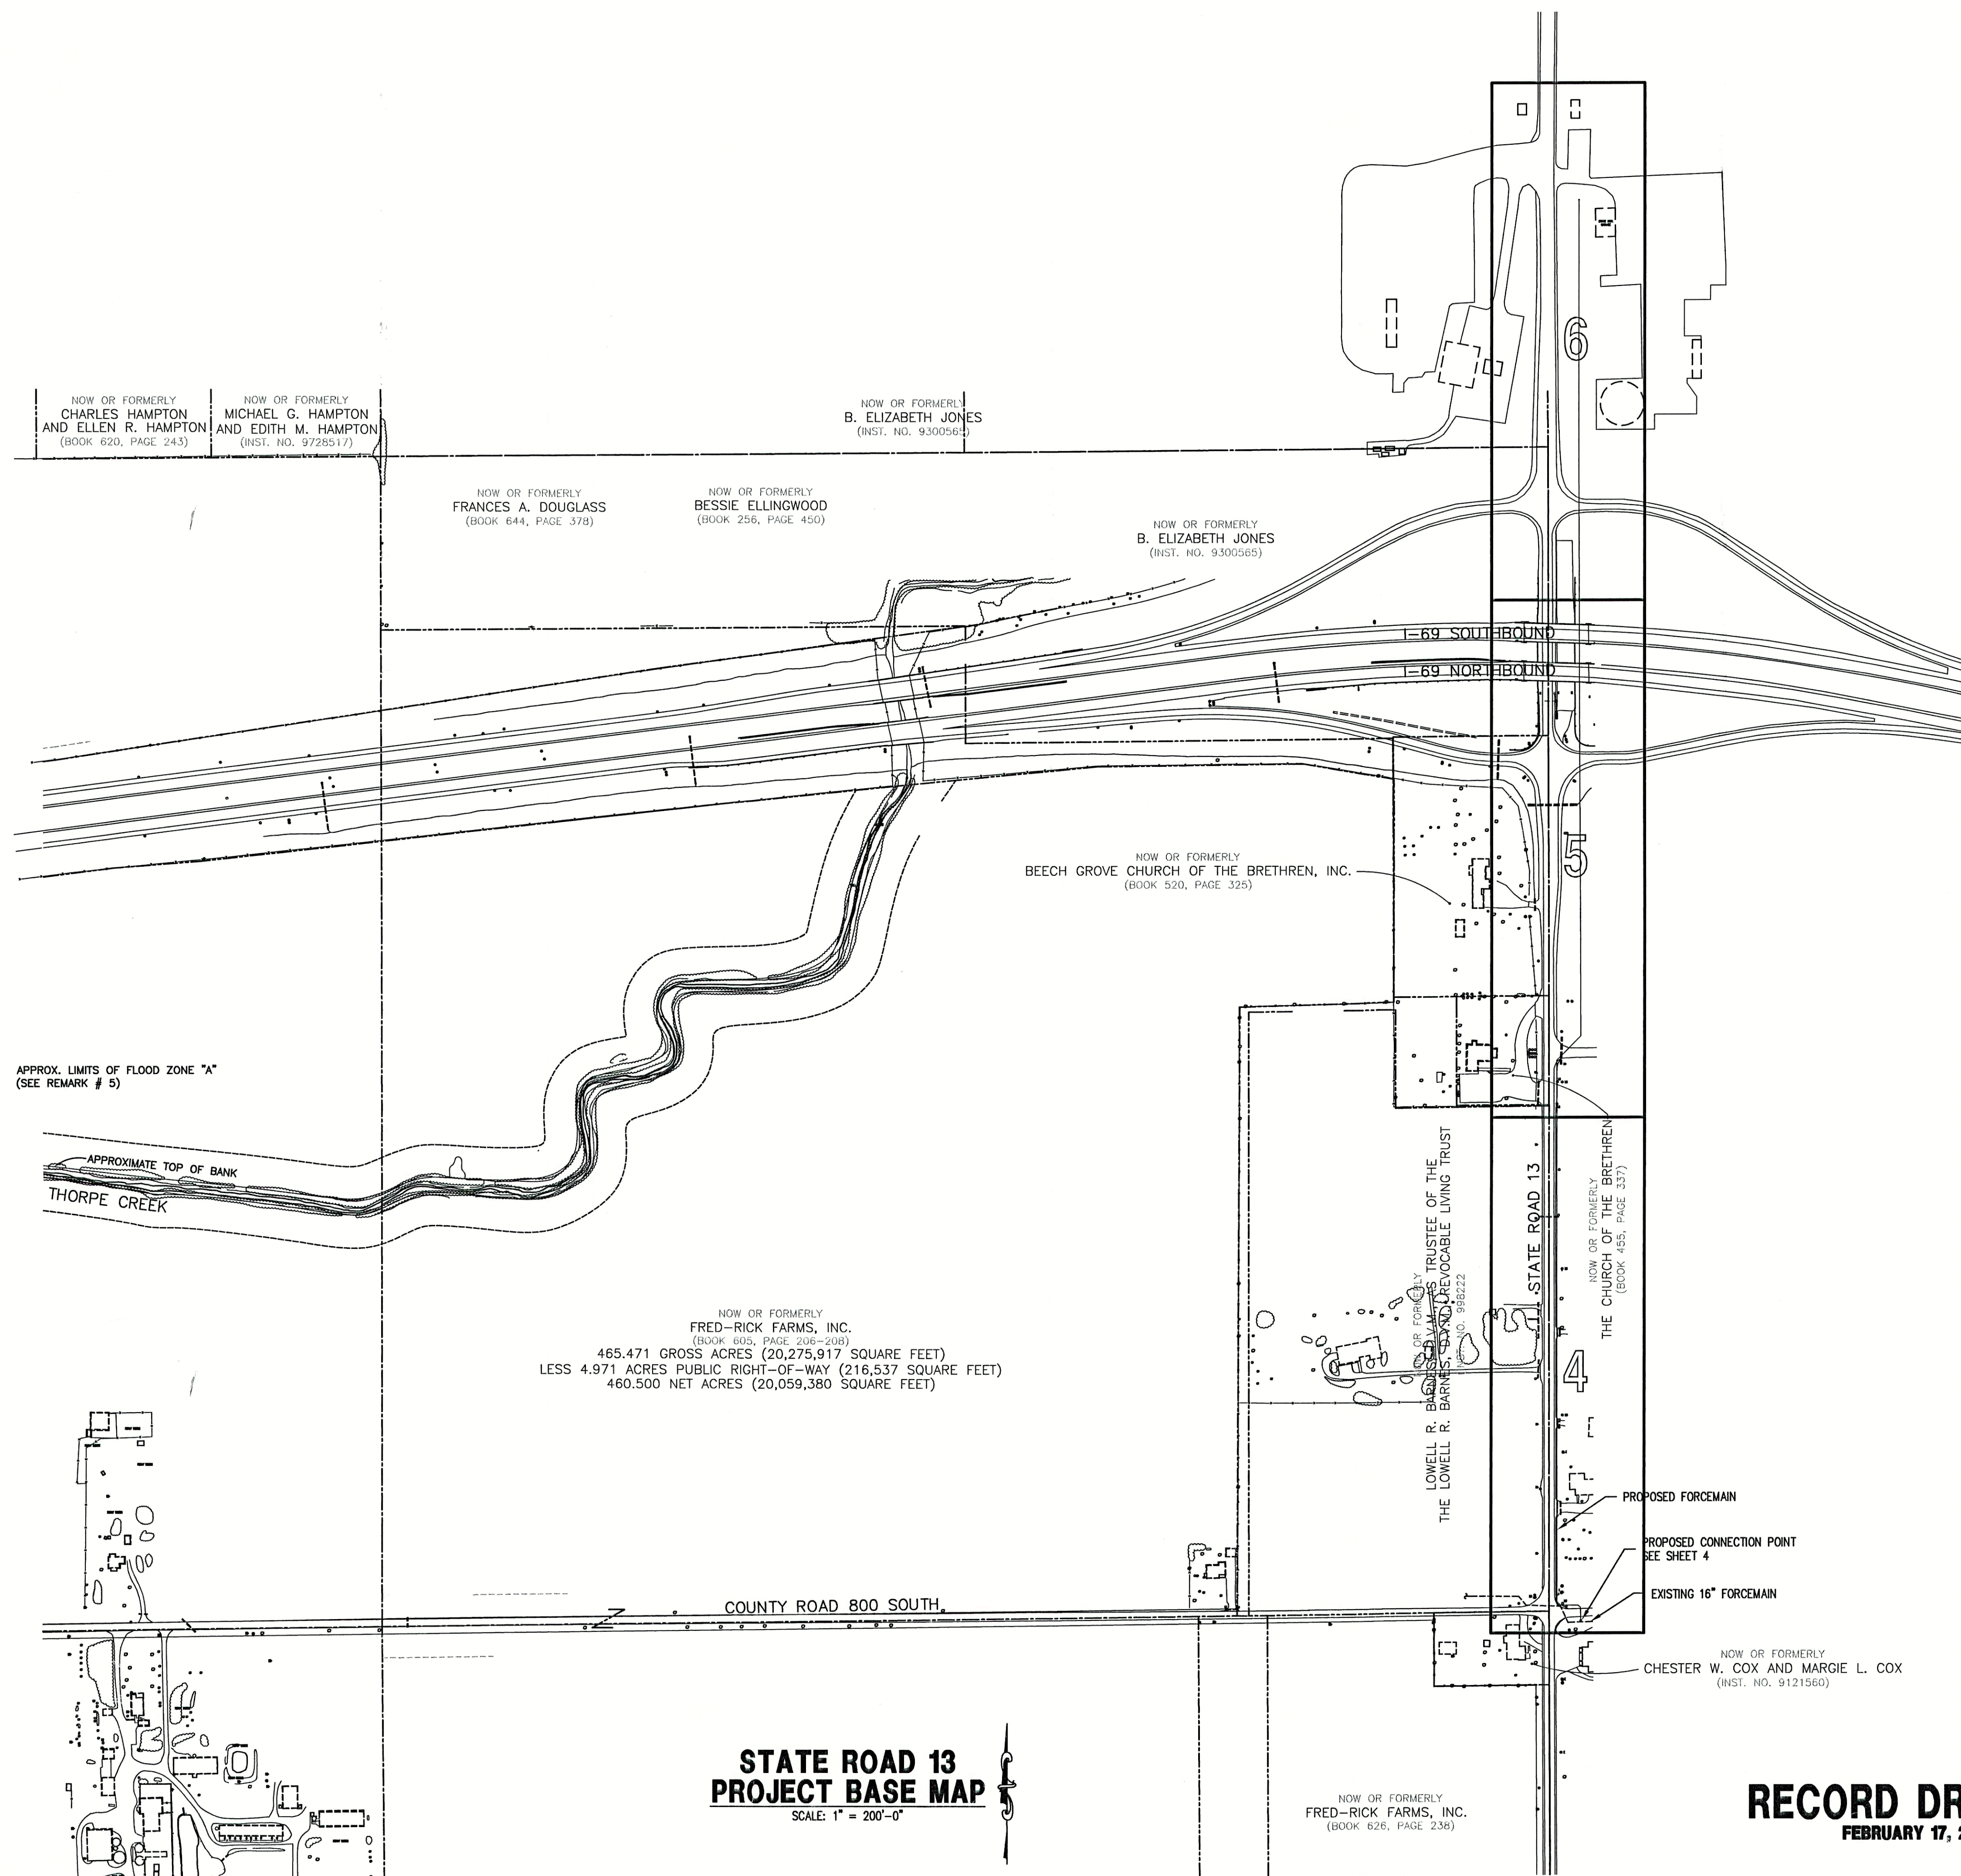

**STATE ROAD 13
PROJECT BASE MAP**

SCALE: 1" = 200'-0"


RECORD DRAWING
FEBRUARY 17, 2003

CONSULTANT:


REVISIONS:

DATE	DESCRIPTION	BY

APPROVED BY:

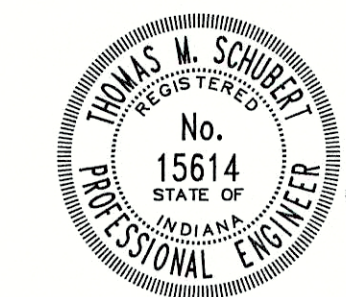

THIS DRAWING AND THE IDEAS, DESIGNS
AND CONCEPTS CONTAINED HEREIN ARE
THE EXCLUSIVE INTELLECTUAL PROPERTY
OF TRIAD ASSOCIATES, INC., AND ARE NOT
TO BE USED OR REPRODUCED, IN WHOLE
OR IN PART, WITHOUT THE WRITTEN
CONSENT OF TRIAD ASSOCIATES, INC.

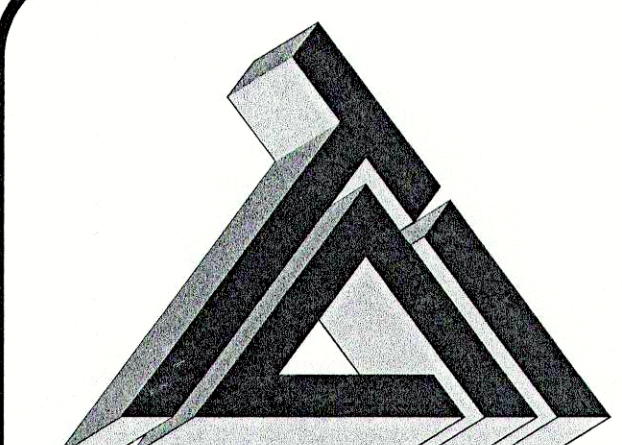

TRIAD ASSOCIATES INC.
5835 LAWTON LOOP EAST DRIVE
INDIANAPOLIS, INDIANA 46216
PHONE: 317-377-5230 FAX: 317-377-5241

DESIGNED FOR:

FALL CREEK REGIONAL WASTE DISTRICT
STATE ROAD 13 SANIATRY
FORCEMAIN EXTENSION PROJECT

SHEET TITLE:

PROJECT BASE MAP

JOB NUMBER: 200202F	CHECKED BY: J.W.F.
SCALE: AS NOTED	PLOT DATE: 10/09/02
PLOT SCALE: 1" = 200	DATE: JULY 2002
DRAWN BY: B.K.Y.	DESIGNED BY: THOMAS M. SCHUBERT, P.E.
DRAWING NAME: 200202F-BASE-RD.DWG	

SHEET No.

3

OF 9