


0/9/02 /1\ REV'D INSTALLATION METHOD



THIS DRAWING AND THE IDEAS, DESIGNS AND CONCEPTS CONTAINED HEREIN ARE THE EXCLUSIVE INTELLECTUAL PROPERTY OF TRIAD ASSOCIATES, INC., AND ARE NOT TO BE USED OR REPRODUCED, IN WHOLE OR IN PART, WITHOUT THE WRITTEN CONSENT OF TRIAD ASSOCIATES, INC.

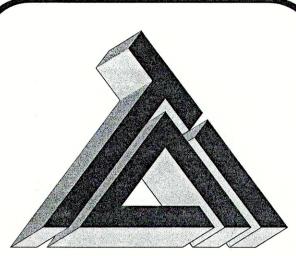

TRIAD ASSOCIATES INC. **5835 LAWTON LOOP EAST DRIVE INDIANAPOLIS, INDIANA 46216** PHONE: 317-377-5230 FAX: 317-377-5241

DESIGNED FOR:

HEET TITLE:	
PLAN AND PROFILE SHEET	
OB NUMBER: 200202F	
CALE: AS NOTED	CHECKED BY: J.W.F.
LOT SCALE: 1 = 1	PLOT DATE: 10/23/02
RAWN BY: B.K.Y.	DATE: JULY 2002
ESIGNED BY: THOMAS M. SCHUBERT, P.E.	
PAWING NAME: RCP01001-RD DWG	