



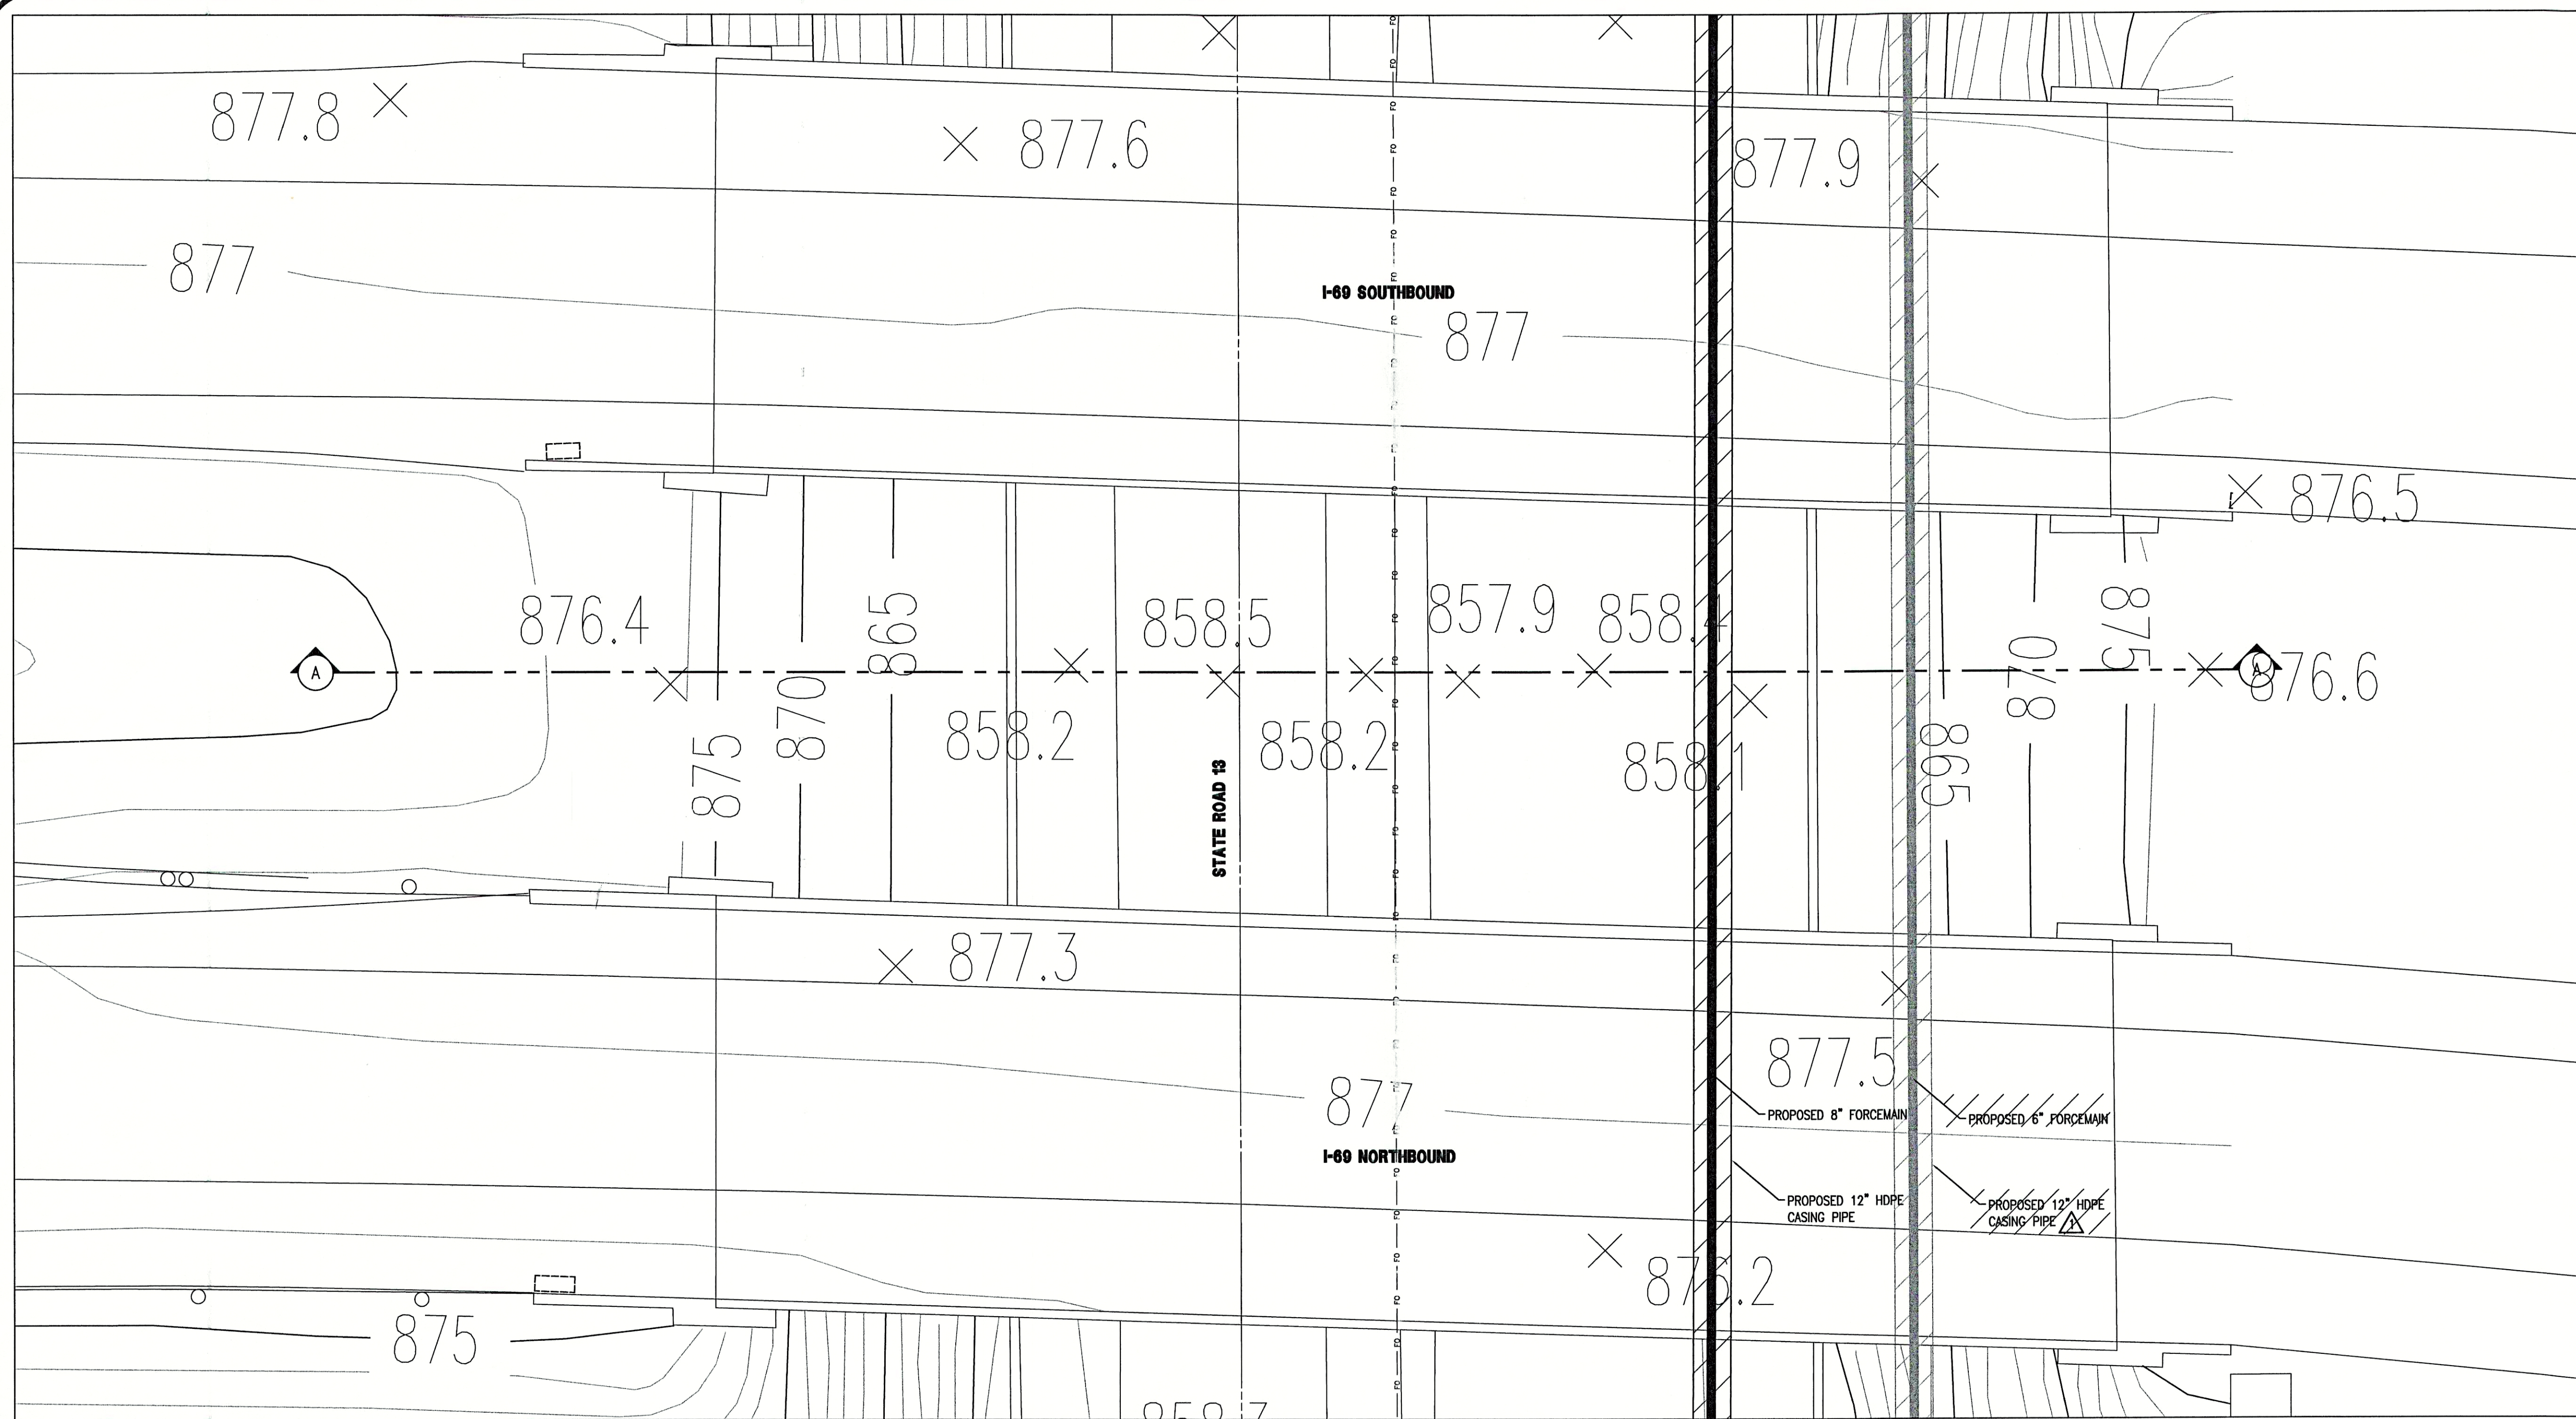

PLAN VIEW
SCALE: 1" = 10'-0"

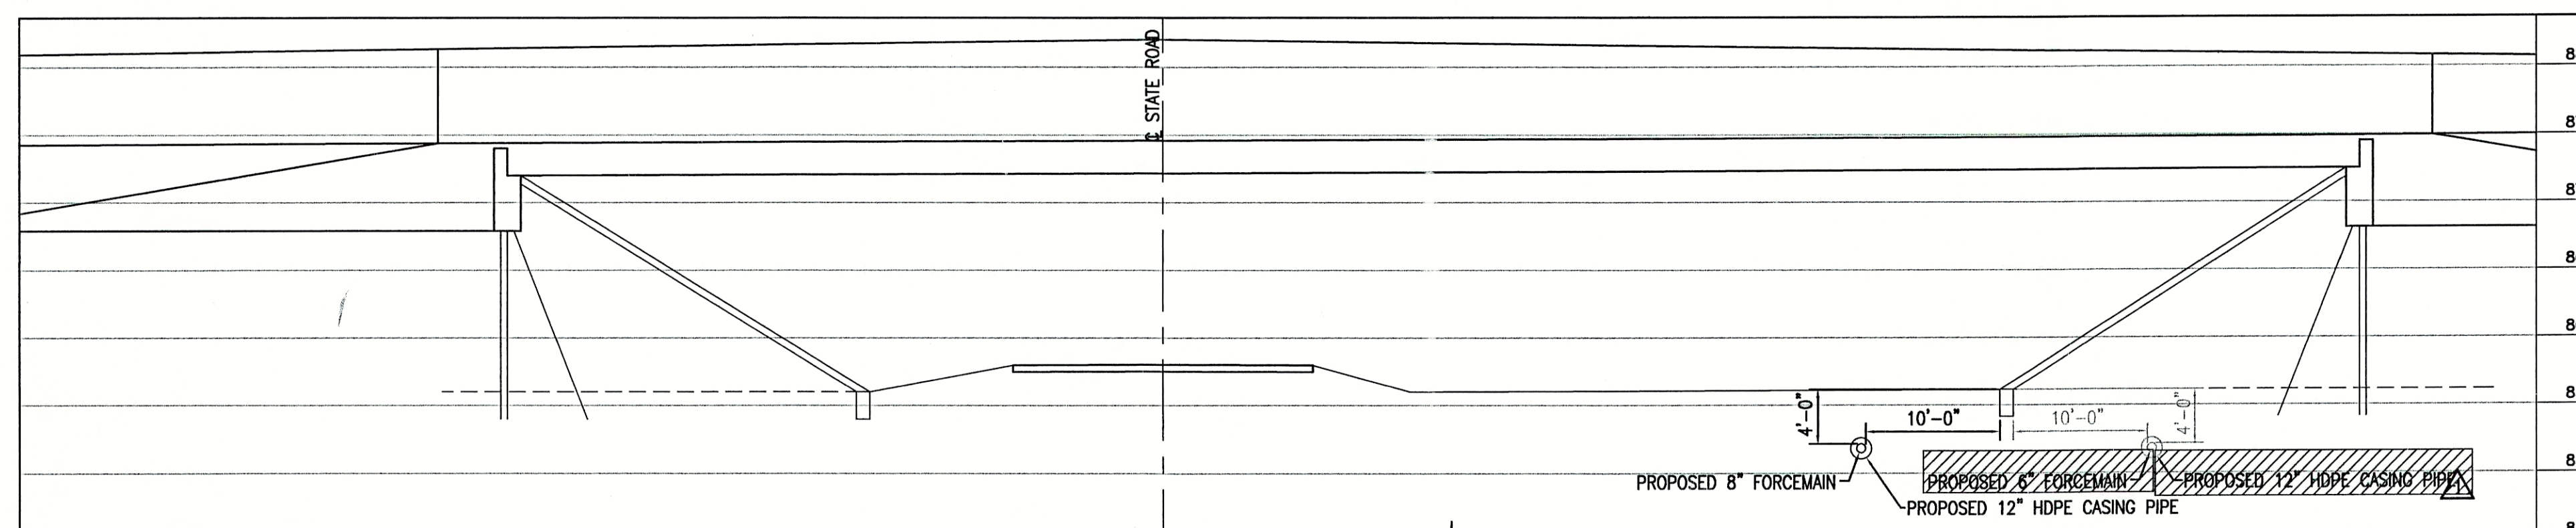

SECTION A-A
SCALE: 1" = 10'-0"


RECORD DRAWING
FEBRUARY 17, 2003

CONSULTANT:


REVISIONS:

DATE	DESCRIPTION	BY
10/23/02	ADDED 12" HDPE CASING PIPE	D.A.P.

APPROVED BY:

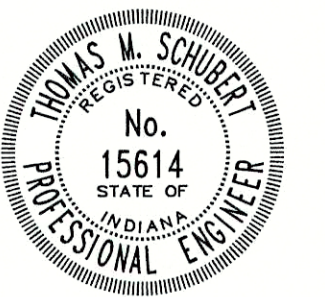

THIS DRAWING AND THE IDEAS, DESIGNS AND CONCEPTS CONTAINED HEREIN ARE THE EXCLUSIVE INTELLECTUAL PROPERTY OF TRIAD ASSOCIATES, INC., AND ARE NOT TO BE USED OR REPRODUCED, IN WHOLE OR IN PART, WITHOUT THE WRITTEN CONSENT OF TRIAD ASSOCIATES, INC.

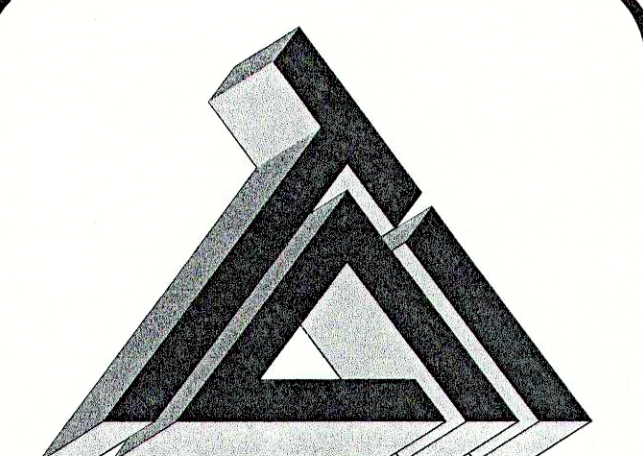

TRIAD ASSOCIATES INC.
5835 LAWTON LOOP EAST DRIVE
INDIANAPOLIS, INDIANA 46216
PHONE: 317-377-5230 FAX: 317-377-5241

DESIGNED FOR:

FALL CREEK REGIONAL WASTE DISTRICT
STATE ROAD 13 SANITARY
FORCEMAIN EXTENSION PROJECT

SHEET TITLE:

BRIDGE BORING SECTION

JOB NUMBER: 200202F	CHECKED BY: J.W.F.
SCALE: AS NOTED	PLOT DATE: 10/23/02
PLOT SCALE: 1" = 1'	DATE: JULY 2002
DRAWN BY: B.K.Y.	DESIGNED BY: THOMAS M. SCHUBERT
DRAWING NAME: 200202F-BRSEC-RD.DWG	

SHEET No.

7
OF 9