




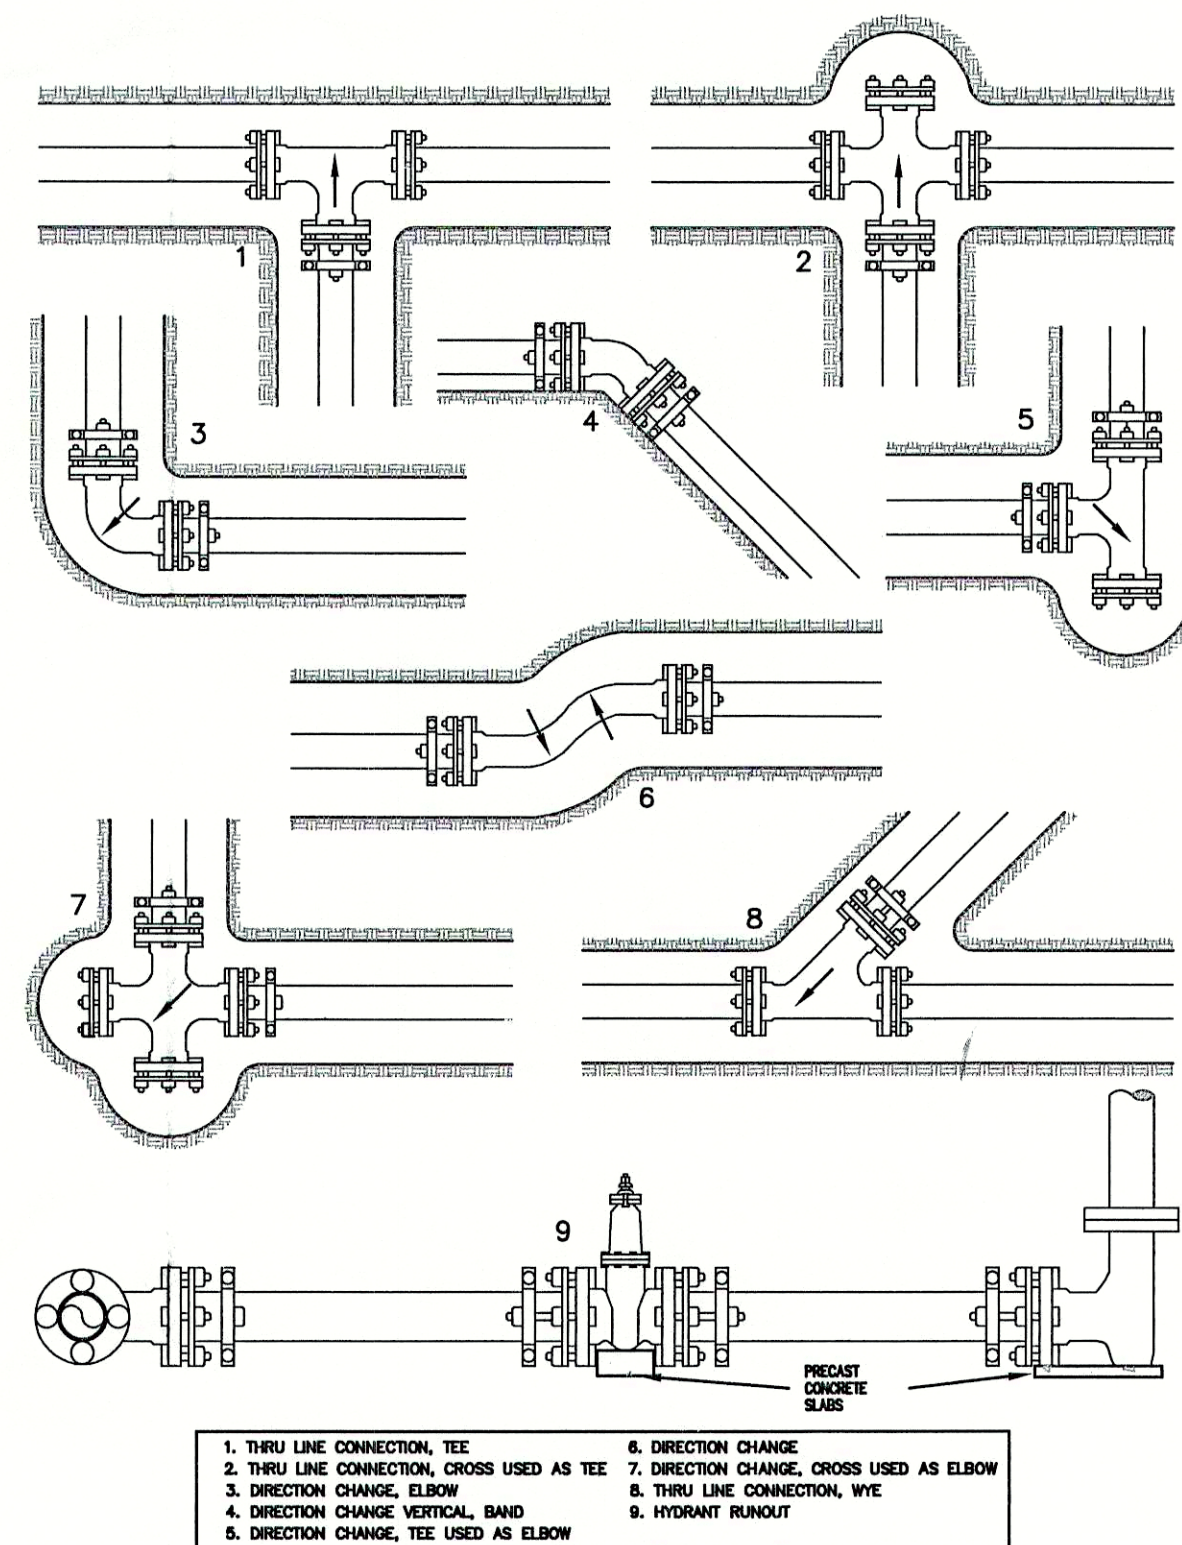


1 TYPES OF JOINT RESTRAINING  
NOT TO SCALE

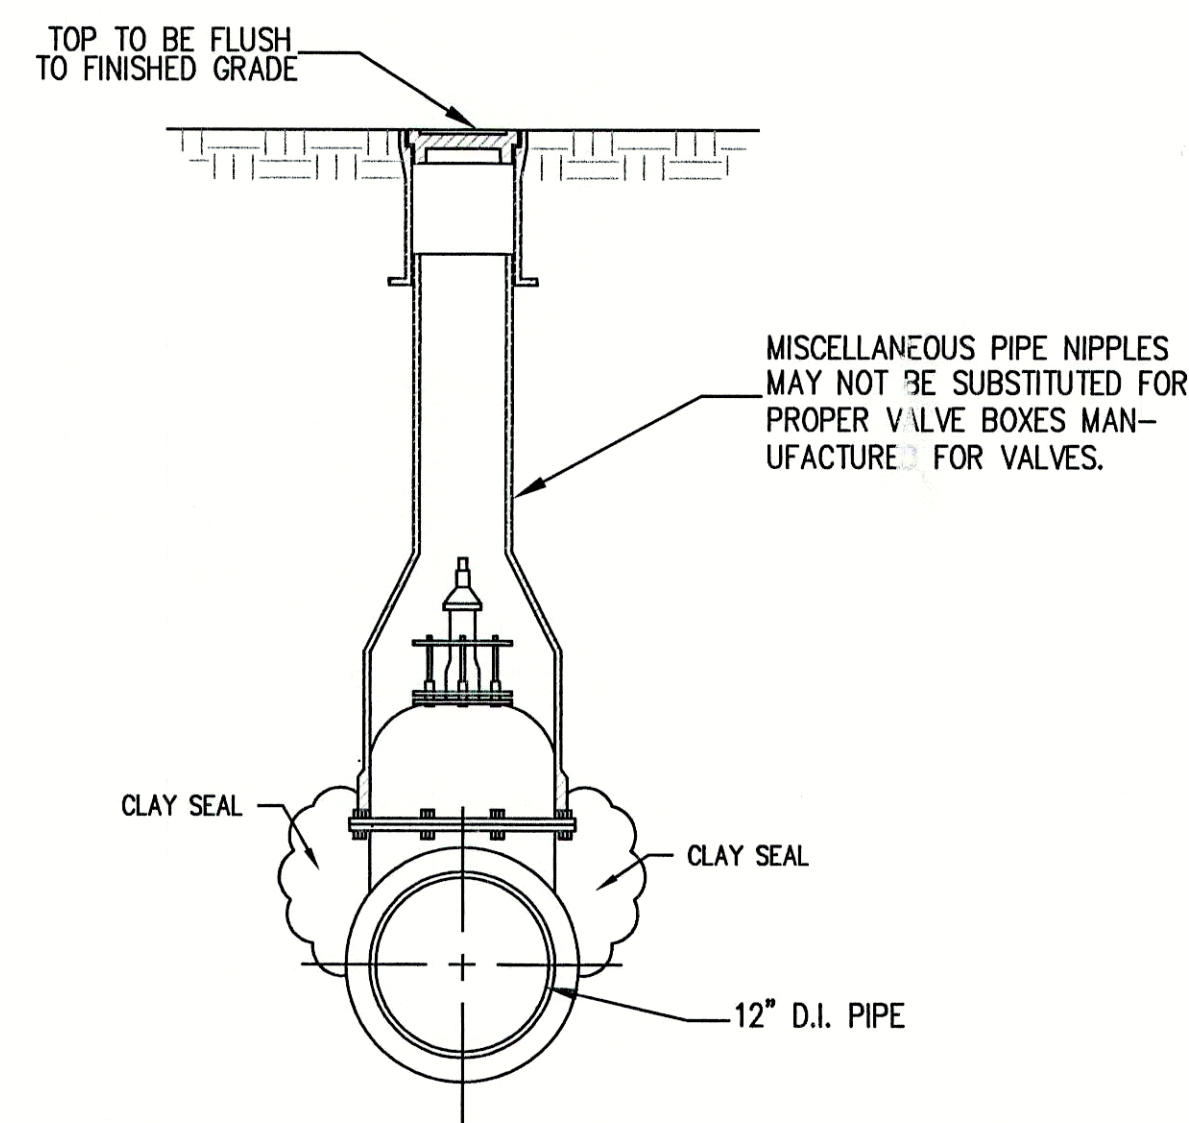

2 VALVE BOX SECTION  
NOT TO SCALE

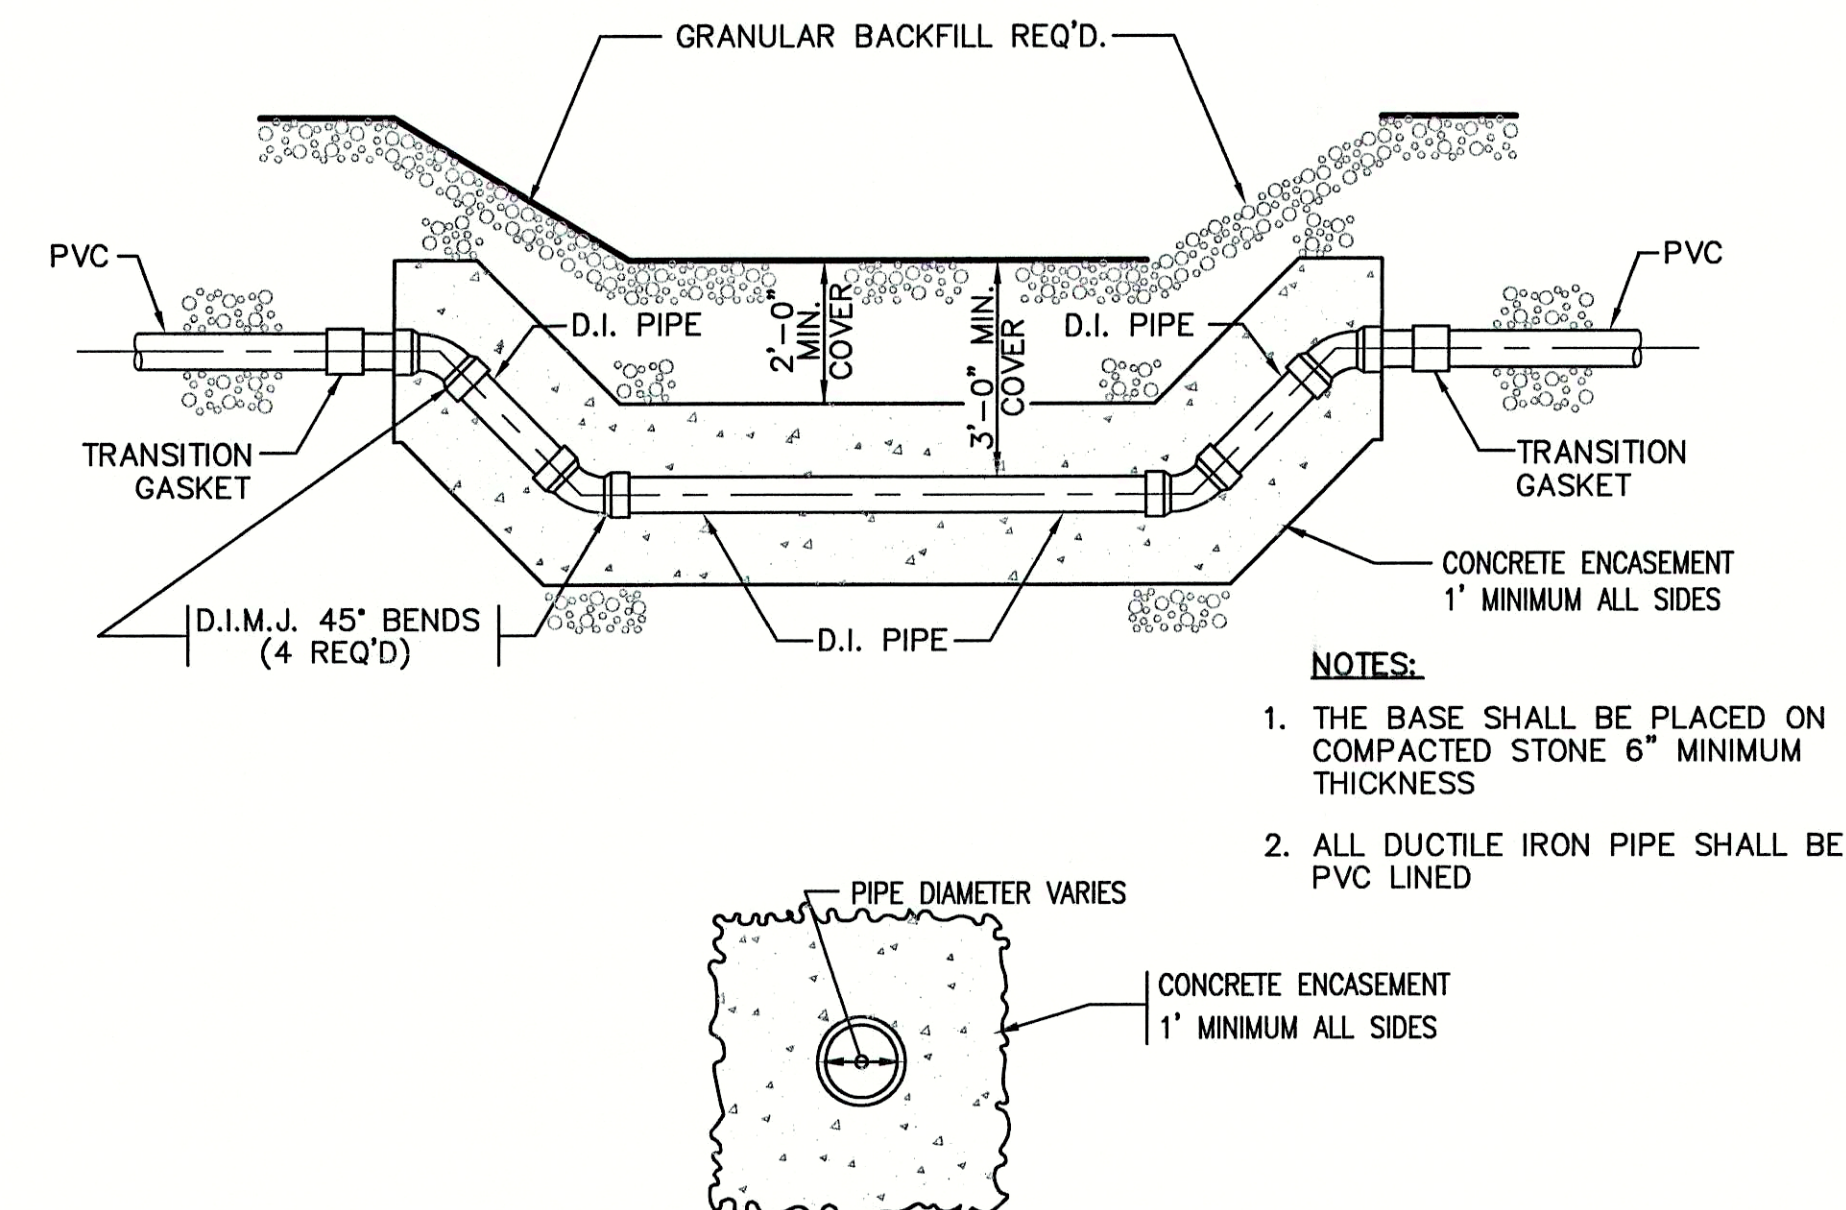

3 TYPICAL CREEK CROSSING FOR FORCEMAIN  
NOT TO SCALE

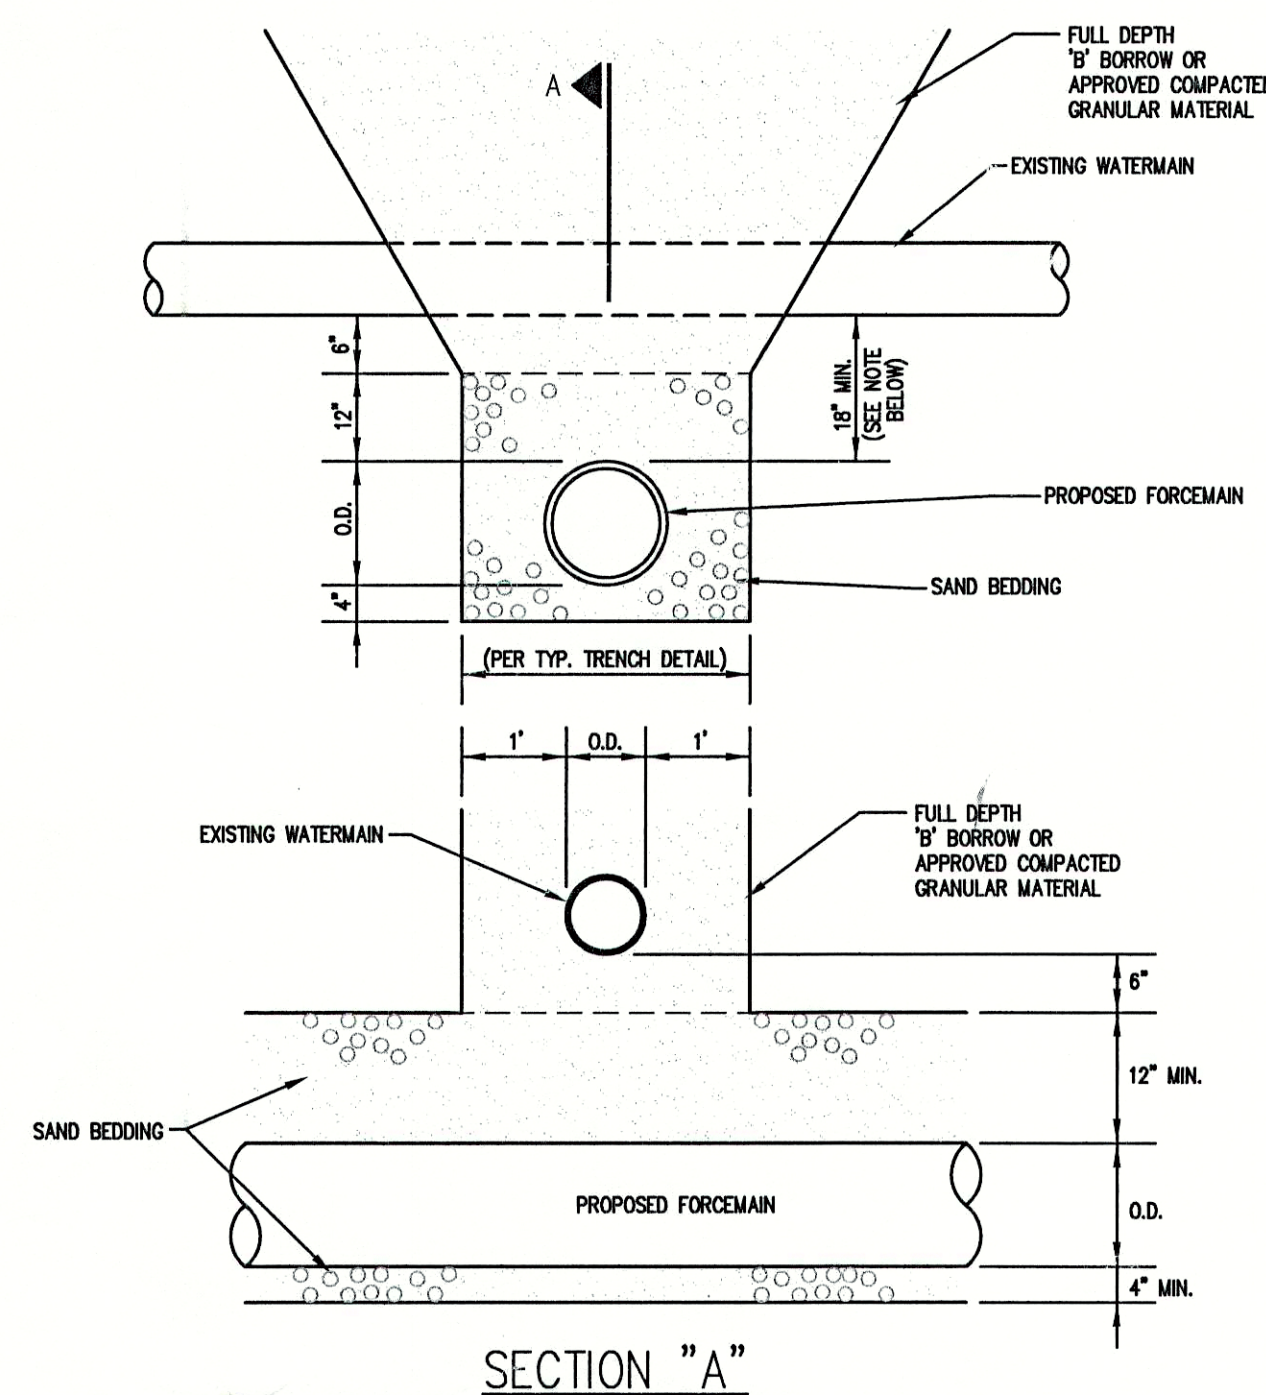

4 WATERMAIN / FORCEMAIN TYPICAL CROSSING DETAIL  
NOT TO SCALE

**RECORD DRAWING**  
FEBRUARY 17, 2003

CONSULTANT:


REVISIONS:

| DATE | DESCRIPTION | BY |
|------|-------------|----|
|      |             |    |
|      |             |    |
|      |             |    |
|      |             |    |

APPROVED BY:



THIS DRAWING AND THE IDEAS, DESIGNS AND CONCEPTS CONTAINED HEREIN ARE THE EXCLUSIVE INTELLECTUAL PROPERTY OF TRIAD ASSOCIATES, INC., AND ARE NOT TO BE USED OR REPRODUCED, IN WHOLE OR IN PART, WITHOUT THE WRITTEN CONSENT OF TRIAD ASSOCIATES, INC.

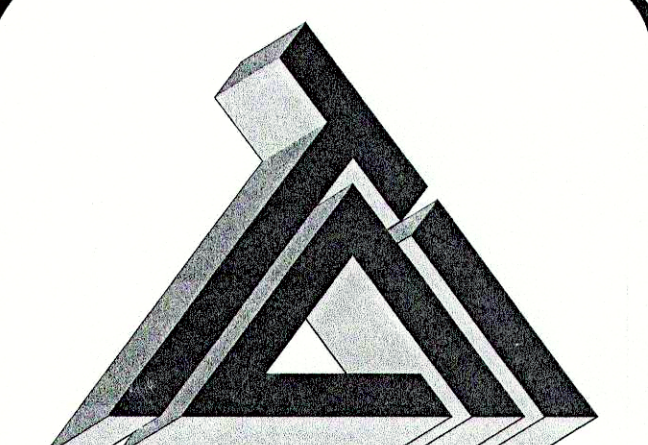

**TRIAD ASSOCIATES INC.**  
5835 LAWTON LOOP EAST DRIVE  
INDIANAPOLIS, INDIANA 46216  
PHONE: 317-377-5230 FAX: 317-377-5241

DESIGNED FOR:

FALL CREEK REGIONAL WASTE DISTRICT  
STATE ROAD 13 SANITARY  
SEWER FORCEMAIN EXTENSION PROJECT

SHEET TITLE:

MISCELLANEOUS DETAIL SHEET

|                                  |                                       |
|----------------------------------|---------------------------------------|
| JOB NUMBER: 200202F              | CHECKED BY: J.W.F.                    |
| SCALE: AS NOTED                  | DATE: 09/24/02                        |
| PLOT SCALE: 1" = 1'              | DATE: JULY 2002                       |
| DRAWN BY: B.K.Y.                 | DESIGNED BY: THOMAS M. SCHUBERT, P.E. |
| DRAWING NAME: 200202FDET2-RD.DWG |                                       |

SHEET No.

**9**  
OF 9