


STATE ROAD 13 SANITARY SEWER FORCEMAIN EXTENSION PROJECT

FOR THE
FALL CREEK REGIONAL WASTE DISTRICT
MADISON CO., IN.


JULY 2002

AREA MAP

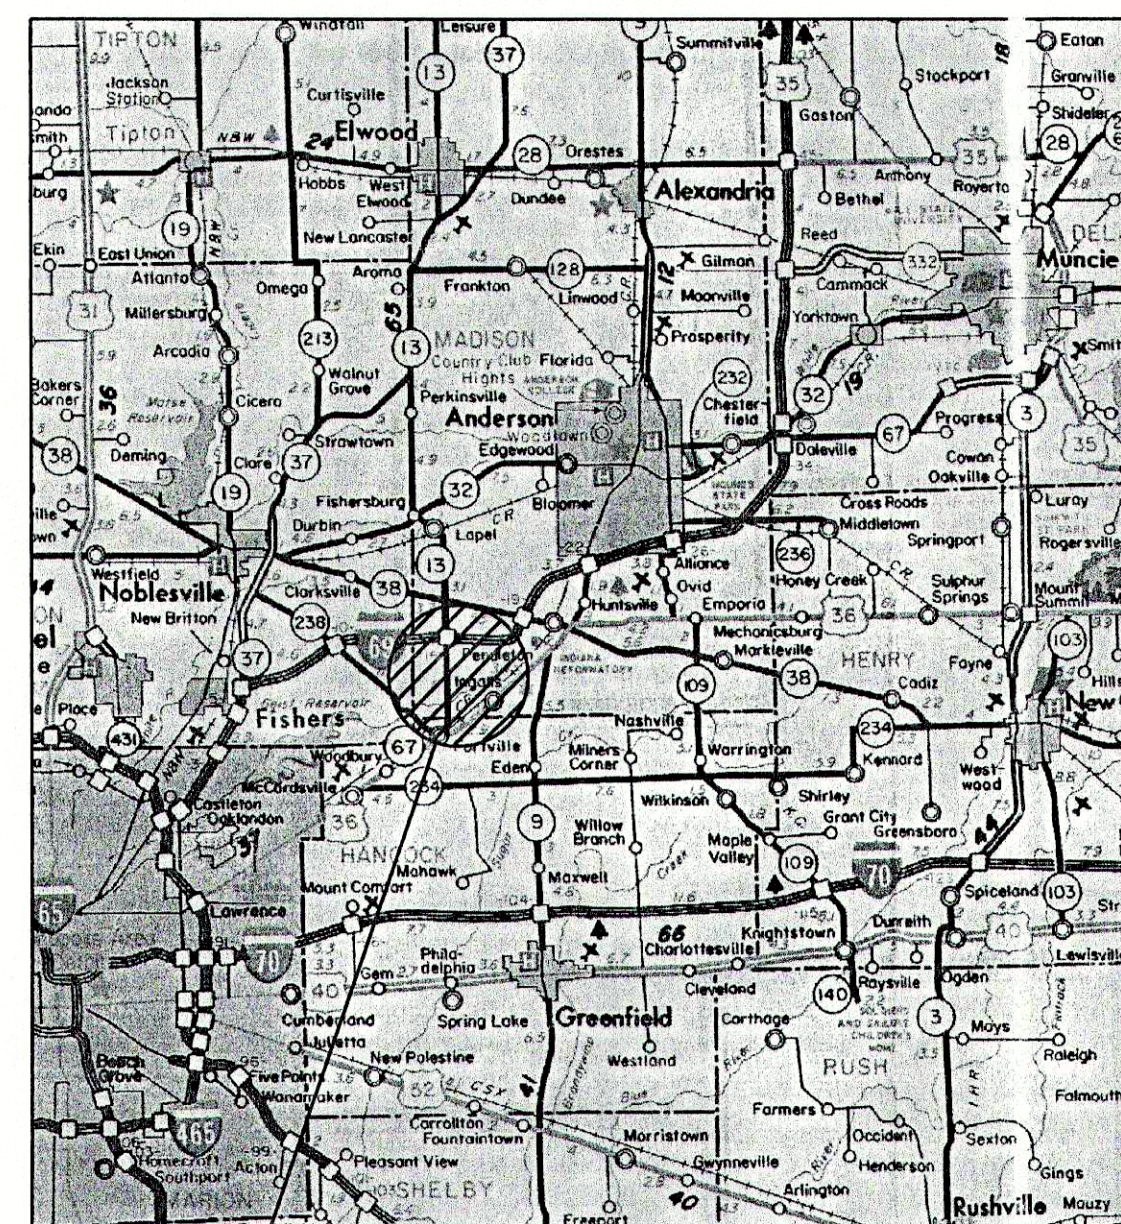

AREA
LOCATION

LOCATION MAP

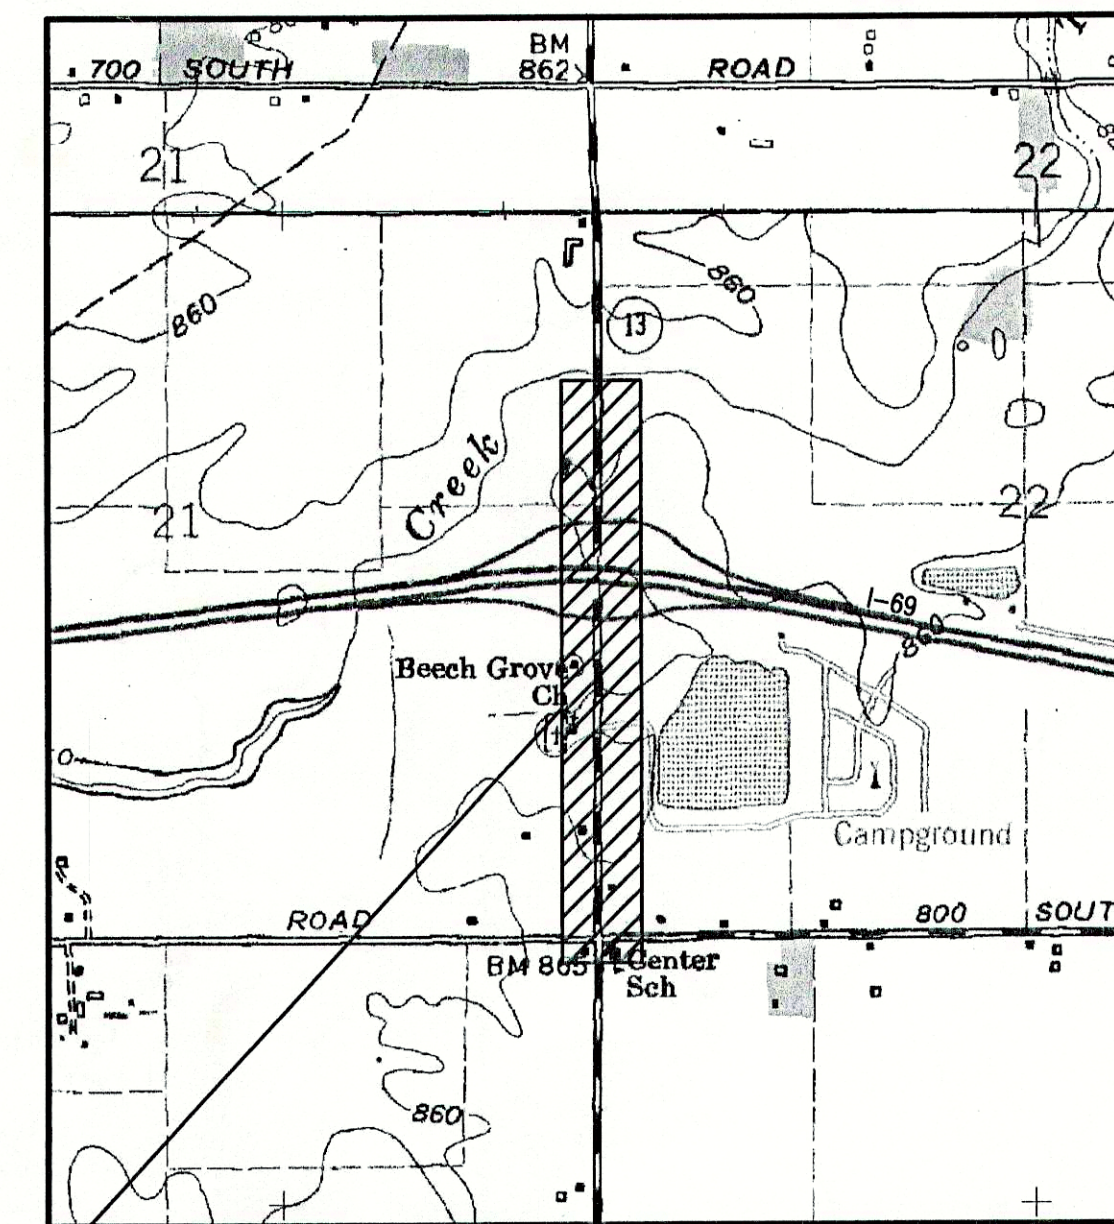

PROJECT
LOCATION

RECORD DRAWING
FEBRUARY 17, 2003

PLANS PREPARED BY:

TRIAD
ASSOCIATES
INC.
INDIANAPOLIS, INDIANA

NOTE:

ADDITIONAL RIGHT-OF-WAY OR EASEMENTS MAY
NEED TO BE ACQUIRED FOR INSTALLATION OF SEWER.



DON'T DIG BLIND
CALL BEFORE YOU DIG
1-800-382-5544
1-800-428-5200

PER INDIANA STATE LAW IS-69-1991, IT IS
AGAINST THE LAW TO EXCAVATE WITHOUT
NOTIFYING THE UNDERGROUND LOCATION SERVICE
TWO (2) WORKING DAYS BEFORE COMMENCING WORK.
NOTE: CONTRACTOR TO VERIFY ALL UTILITY LOCATIONS
PRIOR TO THE START OF CONSTRUCTION

THESE PLANS CERTIFIED BY:

James W. Frazell, Professional Engineer

Thomas M. Schubert, Professional Engineer

