

SUPPLEMENTAL UTILITY CONFLICT INFORMATION

PROPERTY/STREET/ALLEY CROSSED

INTERSECTION MARCY AVE + Jeffery Lane

N-2214

LOT _____ CITY PEWEE COUNTY MADISONUTILITY LOCATE PERFORMED BY BUSTAMANTE-BAYLESSDATE 7/1/23

DOCUMENT SIZE/DEPTH OF SEWERS WHEN CROSSING WITH PROPOSED GAS PIPELINE.

	#1	#2	#3	#4	#5	#6
SEWER DIAMETER	"	"	"	"	"	"
SEWER DEPTH	"	"	"	"	"	"
GAS DEPTH	"	"	"	"	"	"

ACTUAL PROTECTIVE METHOD(S) AGAINST SEWER TRANSECTIONS (LIST ALL THAT APPLY):

GAS MAIN _____ GAS SVC _____

PROTECTIVE METHODS AGAINST SEWER TRANSECTIONS

(A) BORING/PLOWING

- 1 NO FACILITIES
- 2 BORING SAFEGARDS
- 3 STEEL CONDUIT
- 4 STEEL CARRIER

INSTALLATION TYPE

(B) OPEN TRENCH

- 1 NO FACILITIES
- 5 OPEN EXCAVATION


(C) INSERTION

- 1 NO FACILITIES
- 6 INSERTION/CONDUIT



LOCATION OF SEWER FROM FIXED POINT

POINT	#FEET DIR ORIGIN	#FEET DIR ORIGIN	DEPTH (IN)
a	FT.	FT.	"
b	FT.	FT.	"
c	FT.	FT.	"
d	FT.	FT.	"
e	FT.	FT.	"
f	FT.	FT.	"
g	FT.	FT.	"
h	FT.	FT.	"
i	FT.	FT.	"
j	FT.	FT.	"

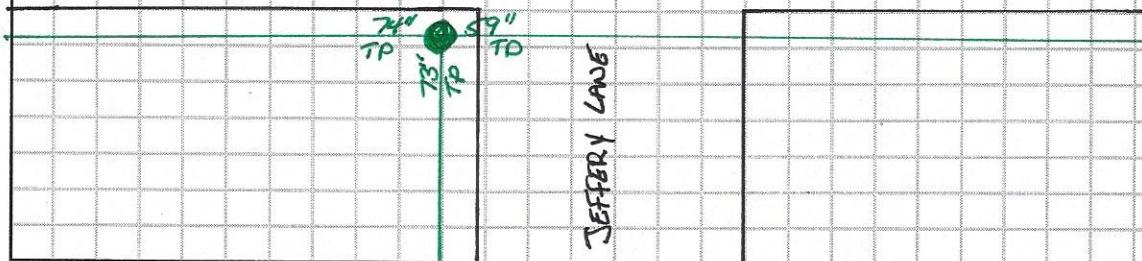

BORE REVIEW INSPECTOR _____

COMPANY _____

FOREMAN/CREW LEAD _____

COMPANY _____

BORE OPERATOR _____

COMPANY _____

DATE OF BORE REVIEW _____

SERVICE RECORD SKETCH

MAIN LOCATION _____ FT.

SERVICE TAP DIMENSIONS: _____ X _____ Y _____ Z

CURRENT TOTAL LENGTH OF ACTIVE SERVICE _____

SUPPLEMENTAL DIMENSIONS: _____ A _____ B _____ C _____ D _____ E _____ F

LENGTH OF TEST PIPE _____

SERVICE TEST PRESSURE _____ PSIG

TEST DURATION _____

TEST PERFORMED BY _____

COMPANY NAME _____

DATE _____

INDICATE
NORTH

NOTES:

CONSTRUCTED BY _____

COMPANY NAME _____

EMP. NO. _____

DATE _____

INSPECTED BY _____

COMPANY NAME _____

EMP. NO. _____

DATE _____

SUPERVISOR CARD REVIEW _____

DATE _____