

## SUPPLEMENTAL UTILITY CONFLICT INFORMATION

PROPERTY/STREET/ALLEY CROSSED


LOT \_\_\_\_\_ CITY Pendleton COUNTY MadisonUTILITY LOCATE PERFORMED BY N. Wolf / J. Storm-DayDATE 1-30-23

ACTUAL PROTECTIVE METHOD(S) AGAINST SEWER TRANSECTIONS (LIST ALL THAT APPLY):

GAS MAIN \_\_\_\_\_ GAS SVC \_\_\_\_\_

DOCUMENT SIZE/DEPTH OF SEWERS WHEN CROSSING WITH PROPOSED GAS PIPELINE.

	#1	#2	#3	#4	#5	#6
SEWER DIAMETER	"	"	"	"	"	"
SEWER DEPTH	"	"	"	"	"	"
GAS DEPTH	"	"	"	"	"	"

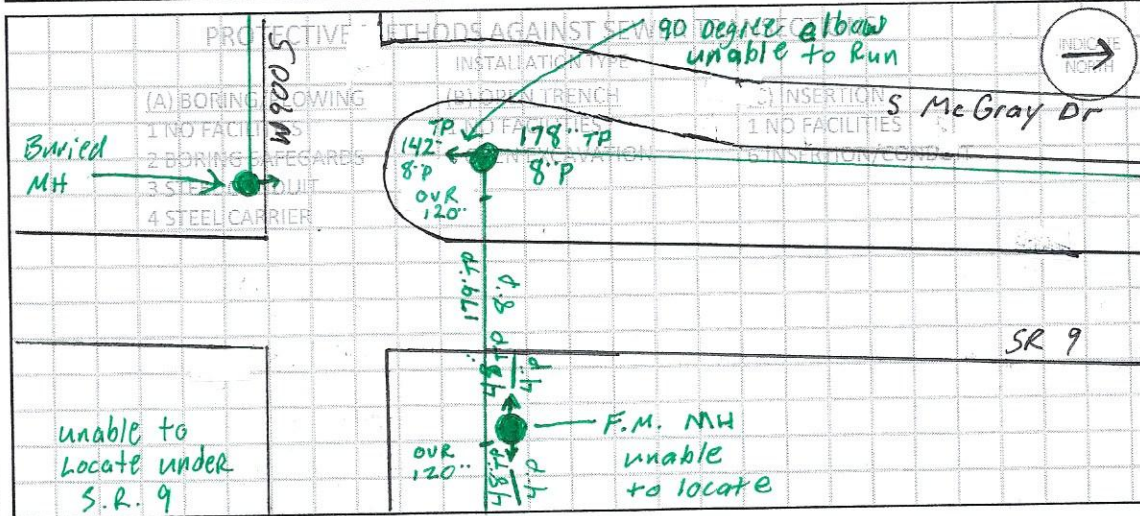

LOCATION OF SEWER FROM FIXED POINT

POINT	#FEET DIR ORIGIN	#FEET DIR ORIGIN	DEPTH (IN)
a	FT.	FT.	"
b	FT.	FT.	"
c	FT.	FT.	"
d	FT.	FT.	"
e	FT.	FT.	"
f	FT.	FT.	"
g	FT.	FT.	"
h	FT.	FT.	"
i	FT.	FT.	"
j	FT.	FT.	"

BORE REVIEW INSPECTOR \_\_\_\_\_

COMPANY \_\_\_\_\_

FOREMAN/CREW LEAD \_\_\_\_\_

COMPANY \_\_\_\_\_

BORE OPERATOR \_\_\_\_\_

COMPANY \_\_\_\_\_

DATE OF BORE REVIEW \_\_\_\_\_

## SERVICE RECORD SKETCH

MAIN LOCATION \_\_\_\_\_ FT.

SERVICE TAP DIMENSIONS: \_\_\_\_\_ X \_\_\_\_\_ Y \_\_\_\_\_ Z

CURRENT TOTAL LENGTH OF ACTIVE SERVICE \_\_\_\_\_

SUPPLEMENTAL DIMENSIONS: \_\_\_\_\_ A \_\_\_\_\_ B \_\_\_\_\_ C \_\_\_\_\_ D \_\_\_\_\_ E \_\_\_\_\_ F

LENGTH OF TEST PIPE \_\_\_\_\_

SERVICE TEST PRESSURE \_\_\_\_\_ PSIG

TEST DURATION \_\_\_\_\_

TEST PERFORMED BY \_\_\_\_\_

COMPANY NAME \_\_\_\_\_

DATE \_\_\_\_\_

NOTES:

CONSTRUCTED BY \_\_\_\_\_

COMPANY NAME \_\_\_\_\_

EMP. NO. \_\_\_\_\_

DATE \_\_\_\_\_

INSPECTED BY \_\_\_\_\_

COMPANY NAME \_\_\_\_\_

EMP. NO. \_\_\_\_\_

DATE \_\_\_\_\_

SUPERVISOR CARD REVIEW \_\_\_\_\_

DATE \_\_\_\_\_