

SUPPLEMENTAL UTILITY CONFLICT INFORMATION

N. 1644

PROPERTY/STREET/ALLEY CROSSED

Stm @ South entrance of 8386 SR 67

LOT

CITY

Pendleton

COUNTY

Madison

UTILITY LOCATE PERFORMED BY

A. Wolf / J. Agan

DATE 1-26-23


ACTUAL PROTECTIVE METHOD(S) AGAINST SEWER TRANSECTIONS (LIST ALL THAT APPLY):

GAS MAIN

GAS SVC

DOCUMENT SIZE/DEPTH OF SEWERS WHEN CROSSING WITH
PROPOSED GAS PIPELINE:

	#1	#2	#3	#4	#5	#6
SEWER DIAMETER	"	"	"	"	"	"
SEWER DEPTH	"	"	"	"	"	"
GAS DEPTH	"	"	"	"	"	"

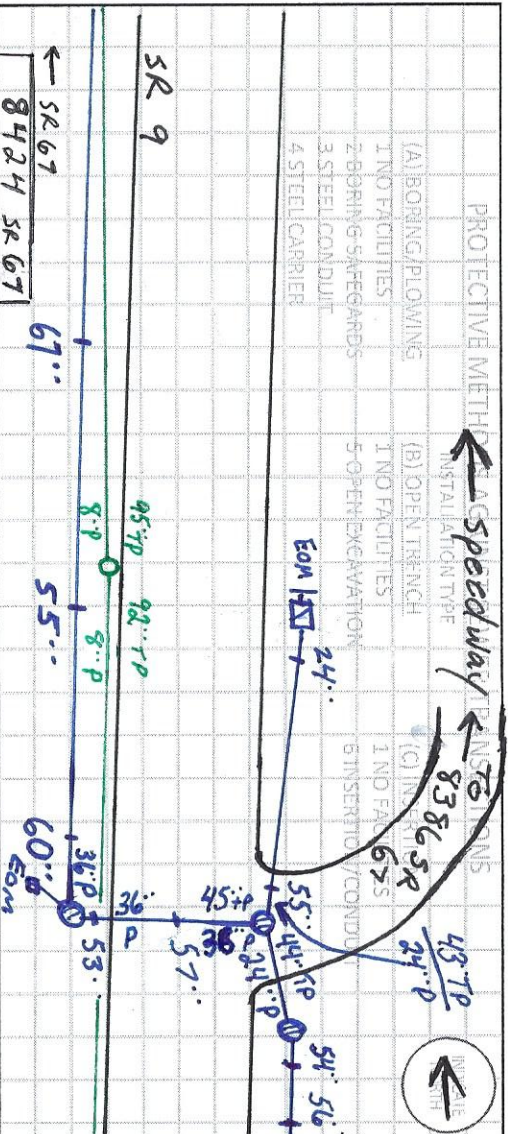

LOCATION OF SEWER FROM FIXED POINT			
POINT	#FEET DIR ORIGIN	#FEET DIR ORIGIN	DEPTH (IN)
a	ft.	ft.	"
b	ft.	ft.	"
c	ft.	ft.	"
d	ft.	ft.	"
e	ft.	ft.	"
f	ft.	ft.	"
g	ft.	ft.	"
h	ft.	ft.	"
i	ft.	ft.	"
j	ft.	ft.	"

BORE REVIEW INSPECTOR

COMPANY

FOREMAN/CREW LEAD

COMPANY

BORE OPERATOR

COMPANY

DATE OF BORE REVIEW

SERVICE RECORD SKETCH

MAIN LOCATION

FT.

SERVICE TAP DIMENSIONS: X Y Z

CURRENT TOTAL LENGTH OF ACTIVE SERVICE

SUPPLEMENTAL DIMENSIONS: A B C D E F

LENGTH OF TEST PIPE

SERVICE TEST PRESSURE

PSIG

TEST DURATION

TEST PERFORMED BY

COMPANY NAME

DATE

INDICATE
NORTH

NOTES:

CONSTRUCTED BY

COMPANY NAME

EMP. NO.

DATE

INSPECTED BY

COMPANY NAME

EMP. NO.

DATE

SUPERVISOR CARD REVIEW

DATE