

SUPPLEMENTAL UTILITY CONFLICT INFORMATION

PROPERTY/STREET/ALLEY CROSSED

STM on 8386 SR 67

N-1644

LOT

CITY Pendleton

COUNTY Madison

UTILITY LOCATE PERFORMED BY

N. Wolf / J. Storm-Day

DATE 1-31-23

ACTUAL PROTECTIVE METHOD(S) AGAINST SEWER TRANSECTIONS (LIST ALL THAT APPLY):

GAS MAIN

GAS SVC

DOCUMENT SIZE/DEPTH OF SEWERS WHEN CROSSING WITH PROPOSED GAS PIPELINE.

	#1	#2	#3	#4	#5	#6
SEWER DIAMETER	"	"	"	"	"	"
SEWER DEPTH	"	"	"	"	"	"
GAS DEPTH	"	"	"	"	"	"

PROTECTIVE METHODS AGAINST SEWER TRANSECTIONS

(A) BORING/PLOWING

1 NO FACILITIES

2 BORING SAFEGARDS

3 STEEL CONDUIT

4 STEEL CARRIER

INSTALLATION TYPE

(B) OPEN TRENCH

1 NO FACILITIES

2 OPEN EXCAVATION


To out of scope

(C) INSERTION

1 NO FACILITIES

2 INSERT (V/COR)

To out of scope

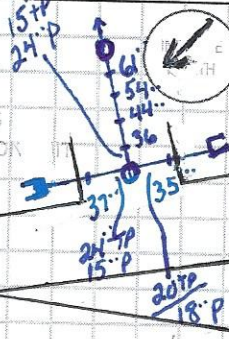

LOCATION OF SEWER FROM FIXED POINT

POINT	#FEET	DIR	#FEET	DIR	DEPTH (IN)
	DIR	ORIGIN	DIR	ORIGIN	
a	FT.	FT.	FT.	FT.	"
b	FT.	FT.	FT.	FT.	"
c	FT.	FT.	FT.	FT.	"
d	FT.	FT.	FT.	FT.	"
e	FT.	FT.	FT.	FT.	"
f	FT.	FT.	FT.	FT.	"
g	FT.	FT.	FT.	FT.	"
h	FT.	FT.	FT.	FT.	"
i	FT.	FT.	FT.	FT.	"
j	FT.	FT.	FT.	FT.	"

BORE REVIEW INSPECTOR

COMPANY

FOREMAN/CREW LEAD

COMPANY

BORE OPERATOR

COMPANY

DATE OF BORE REVIEW

SERVICE RECORD SKETCH

MAIN LOCATION

FT.

SERVICE TAP DIMENSIONS:

X

Y

Z

CURRENT TOTAL LENGTH OF ACTIVE SERVICE

SUPPLEMENTAL DIMENSIONS:

A

B

C

D

E

F

LENGTH OF TEST PIPE

SERVICE TEST PRESSURE

PSIG

TEST DURATION

TEST PERFORMED BY

COMPANY NAME

DATE

INDICATE NORTH

NOTES:

CONSTRUCTED BY

COMPANY NAME

EMP. NO.

DATE

INSPECTED BY

COMPANY NAME

EMP. NO.

DATE

SUPERVISOR CARD REVIEW

DATE