




NOTE:
ADDITIONAL RIGHT-OF-WAY OR EASEMENTS MAY
NEED TO BE ACQUIRED FOR INSTALLATION OF SEWER.

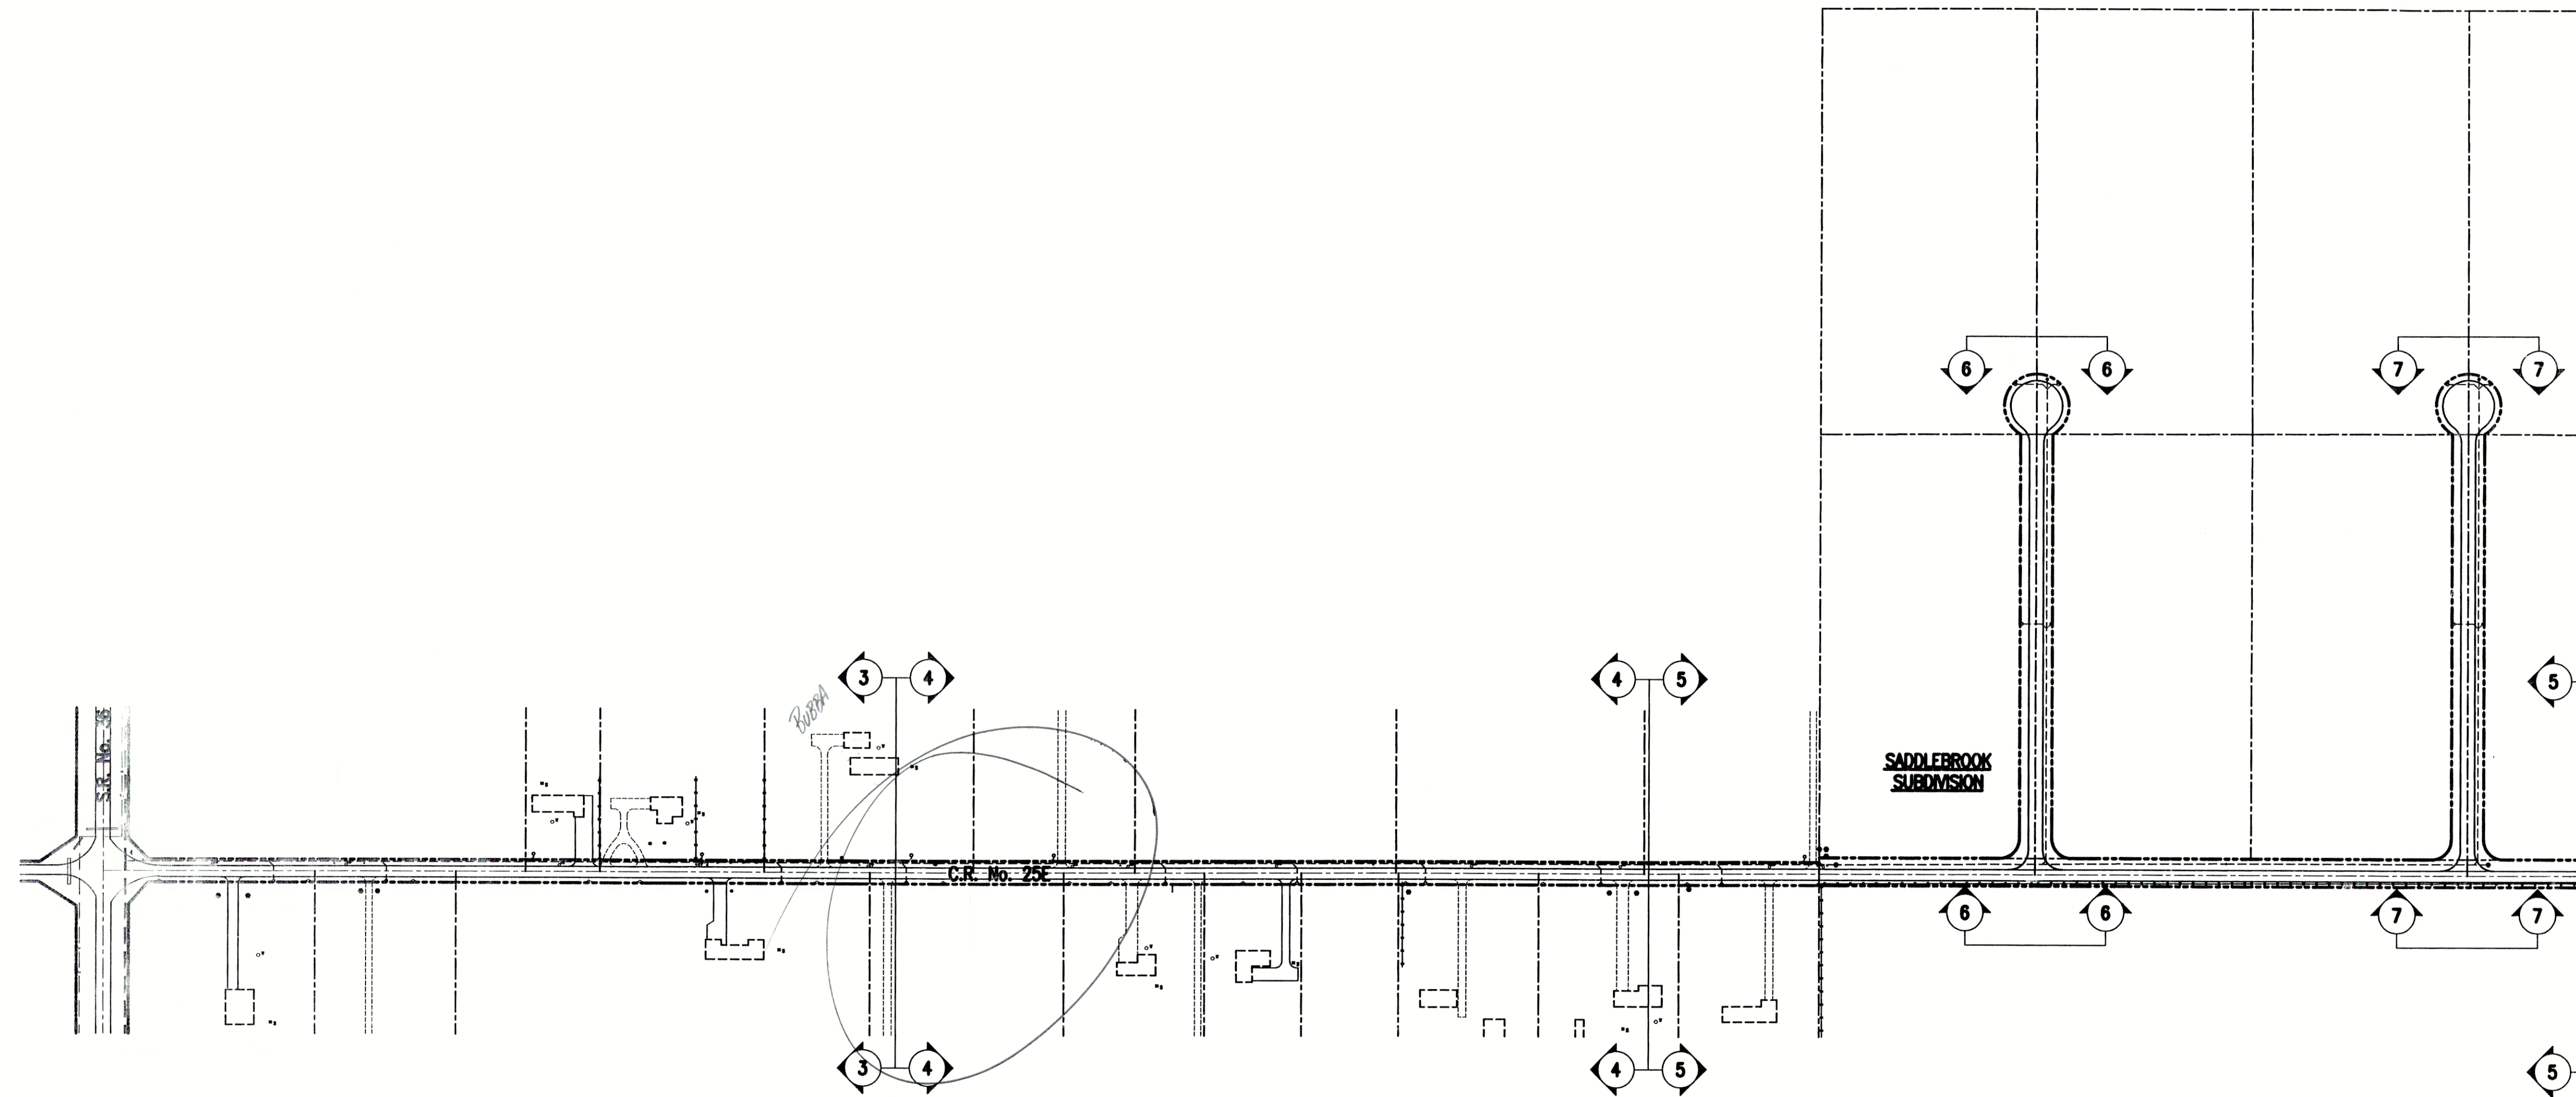

**DON'T DIG BLIND.
CALL BEFORE YOU DIG**
1-800-382-5544
1-800-428-5200

PER INDIANA STATE LAW IS-89-1991, IT IS
AGAINST THE LAW TO EXCAVATE WITHOUT
NOTIFYING THE UNDERGROUND LOCATION SERVICE
TWO (2) WORKING DAYS BEFORE COMMENCING WORK.

NOTE: CONTRACTOR TO VERIFY ALL UTILITY LOCATIONS
PRIOR TO THE START OF CONSTRUCTION

ANDERSON LIGHT AND POWER
550 BAXTER ROAD
ANDERSON, INDIANA 46016
1 (765) 648-6187

CYENERGY/PSI
100 S. MILL CREEK ROAD
P.O. BOX 312
NOBLESVILLE, INDIANA 46060
1 (800) 521-2232

TCI OF CENTRAL INDIANA
633 JACKSON STREET
ANDERSON, INDIANA 46016
1 (765) 649-0407


GTE
P.O. BOX 1406
RICHMOND, INDIANA 47375
1 (800) 832-0129

INDIANA GAS COMPANY, INC.
2001 LOUISE STREET
ANDERSON, INDIANA 46016
1 (800) 777-2060


LEGEND



SHEET DESIGNATION

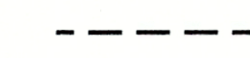

EXISTING SANITARY FORCEMAIN

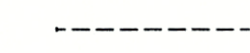

PROPOSED SANITARY FORCEMAIN

UTILITIES

**COUNTY ROAD 25E
BASE MAP**

SCALE: 1" = 150'



CONSULTANT:

REVISIONS:


DATE	DESCRIPTION	BY

APPROVED BY:

12-16-99



Thomas M. Schubert
Thomas M. Schubert, P.E.

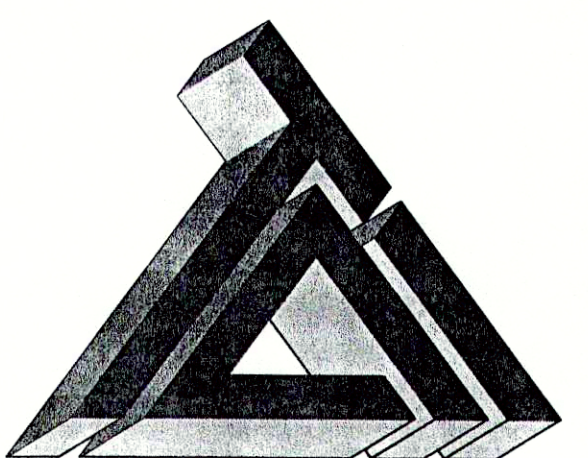

TRIAD ASSOCIATES INC.
5835 LAWTON LOOP EAST DRIVE
INDIANAPOLIS, INDIANA 46216
PHONE: 317-377-5230 FAX: 317-377-5241

DESIGNED FOR:

**SADDLE BROOK ADDITION
OWNER: MR. LARRY KEESLING**

SHEET TITLE:

**SANITARY SEWER COLLECTION
SYSTEM BASE MAP**

JOB NUMBER: 980021	CHECKED BY: J.W.F.
SCALE: AS NOTED	PLOT DATE: 12/17/99
PLOT SCALE: 1"=150'	DATE: 04/12/98
DRAWN BY: D.A.P.	DESIGNED BY: D.A. Pauling
DRAWING NAME: CR25E_OA	

SHEET No.

02

OF 08