


REVISIONS:		
DATE	DESCRIPTION	BY

APPROVED BY: 12-22-99

THOMAS M. SCHUBERT
REGISTERED
No.
15614
STATE OF
INDIANA
PROFESSIONAL ENGINEER

Thomas M. Schubert
Thomas M. Schubert, P.E.

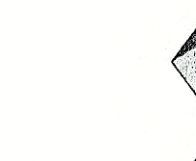

TRIAD ASSOCIATES INC.
 5835 LAWTON LOOP EAST DRIVE
 INDIANAPOLIS, INDIANA 46216
 PHONE: 317-377-5230 FAX: 317-377-5241

DESIGNED FOR:	
SADDLE BROOK ADDITION OWNER: MR. LARRY KEESLING	
SHEET TITLE:	
SANITARY SEWER COLLECTION SYSTEM PLAN AND PROFILES	
JOB NUMBER: 980021	
SCALE: AS NOTED	CHECKED BY: J.W.F.
PLOT SCALE: 1=50	PLOT DATE: 12/21/99
DRAWN BY: DAP	DATE: 04/12/98
DESIGNED BY: D.A. Pauling	
DRAWING NAME: CR25E C3	

SECRET No. 05 OF 08

OF OF

