

CONSULTANT:

REVISIONS:

DATE	MISC. REVISIONS	BY
12-20-04	DESCRIPTION	BKY
5-18-06	RECORD DRAWINGS	CJF

APPROVED BY:




RECORD DRAWING

This drawing has been revised from the original contract drawings to show minor / major changes made during construction. This drawing is not warranted to be complete and accurate in all respects.

GRW Engineers, Inc.

Date: 5-18-06 By: CJF

THIS DRAWING AND THE IDEAS, DESIGNS AND CONCEPTS CONTAINED HEREIN ARE THE EXCLUSIVE INTELLECTUAL PROPERTY OF TRIAD ASSOCIATES, INC., AND ARE NOT TO BE USED OR REPRODUCED, IN WHOLE OR IN PART, WITHOUT THE WRITTEN CONSENT OF TRIAD ASSOCIATES, INC.

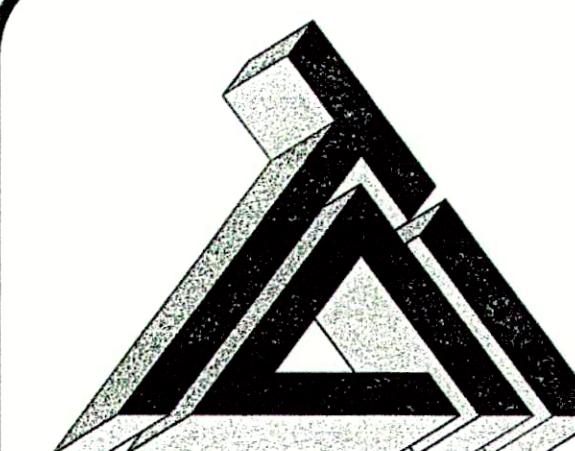

TRIAD ASSOCIATES INC.
5835 LAWTON LOOP EAST DRIVE
INDIANAPOLIS, INDIANA 46216
PHONE: 317-377-5230 FAX: 317-377-5241

DESIGNED FOR:

FALL CREEK REGIONAL WASTE DISTRICT
SANITARY SEWER ADDITIONAL
CONNECTIONS AND SERVICE CONNECTIONS

SHEET TITLE:

PROJECT BASE MAP

JOB NUMBER: 200402E

SCALE: AS NOTED

PLOT SCALE: 1" = 50'

DRAWN BY: DAP

DESIGNED BY: Michael P. Hunter, P.E.

DRAWING NAME: 200402E-BAS

CHECKED BY: J.W.F.

PLOT DATE: 12/20/04

DATE: NOVEMBER 2004

SHEET No.

3

OF 21