


CONSULTANT:

REVISIONS:		
DATE	DESCRIPTION	BY
12-20-04	MISC. REVISIONS	BKY
5-18-06	RECORD DRAWINGS	CJF

APPROVED BY:



<p style="text-align: center;"><u>RECORD DRAWING</u></p> <p>This drawing has been revised from the original contract drawings to show minor/ major changes made during construction. This drawing is not warranted to be complete and accurate in all respects.</p> <p style="text-align: center;">GRW Engineers, Inc.</p> <p>Date: <u>5-18-06</u> By: <u>CJF</u></p>

THIS DRAWING AND THE IDEAS, DESIGNS AND CONCEPTS CONTAINED HEREIN ARE THE EXCLUSIVE INTELLECTUAL PROPERTY OF TRIAD ASSOCIATES, INC., AND ARE NOT TO BE USED OR REPRODUCED, IN WHOLE OR IN PART, WITHOUT THE WRITTEN CONSENT OF TRIAD ASSOCIATES, INC.



TRIAD ASSOCIATES INC.
 5835 LAWTON LOOP EAST DRIVE
 INDIANAPOLIS, INDIANA 46216
 PHONE: 317-377-5230 FAX: 317-377-5241


<p align="center">DESIGNED FOR:</p> <p align="center">FALL CREEK REGIONAL WASTE DISTRICT SANITARY SEWER ADDITIONAL CONNECTIONS AND SERVICE CONNECTIONS</p>	
<p>SHEET TITLE:</p> <p align="center">PLANT CONNECTION PLAN AND PROFILE SHEET</p>	
<p>JOB NUMBER: 200402E</p>	
<p>SCALE: AS NOTED</p>	<p>CHECKED BY: J.W.F.</p>
<p>PLOT SCALE: 1 = 50</p>	<p>PLOT DATE: 12/20/04</p>
<p>DRAWN BY: DAP</p>	<p>DATE: NOVEMBER 2004</p>
<p>DESIGNED BY: Michael P. Hunter, P.E.</p>	
<p>DRAWING NAME: 200402E-C4</p>	

SHEET No. **4** OF 21



HORIZONTAL SCALE: 1" = 50'
VERTICAL SCALE: 1" = 5'

SEE SHEET 5

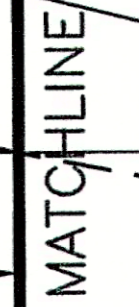

TRIAD ASSOCIATES INC.
5835 LAWTON LOOP EAST DRIVE
INDIANAPOLIS, INDIANA 46216
PHONE: 317-377-5230 FAX: 317-377-5241

DESIGNED FOR:
FALL CREEK REGIONAL WASTE DISTRICT
SANITARY SEWER ADDITIONAL
CONNECTIONS AND SERVICE CONNECTIONS

SHEET TITLE:

**PLANT CONNECTION
PLAN AND PROFILE SHEET**

JOB NUMBER: 200402E	
SCALE: AS NOTED	CHECKED BY: J.W.F.
PLOT SCALE: 1 = 50	PLOT DATE: 12/20/04
DRAWN BY: DAP	DATE: NOVEMBER 2004
DESIGNED BY: Michael P. Hunter, P.E.	
DRAWING NAME: 200402E-C4	

SHEET No. **4** OF 21