


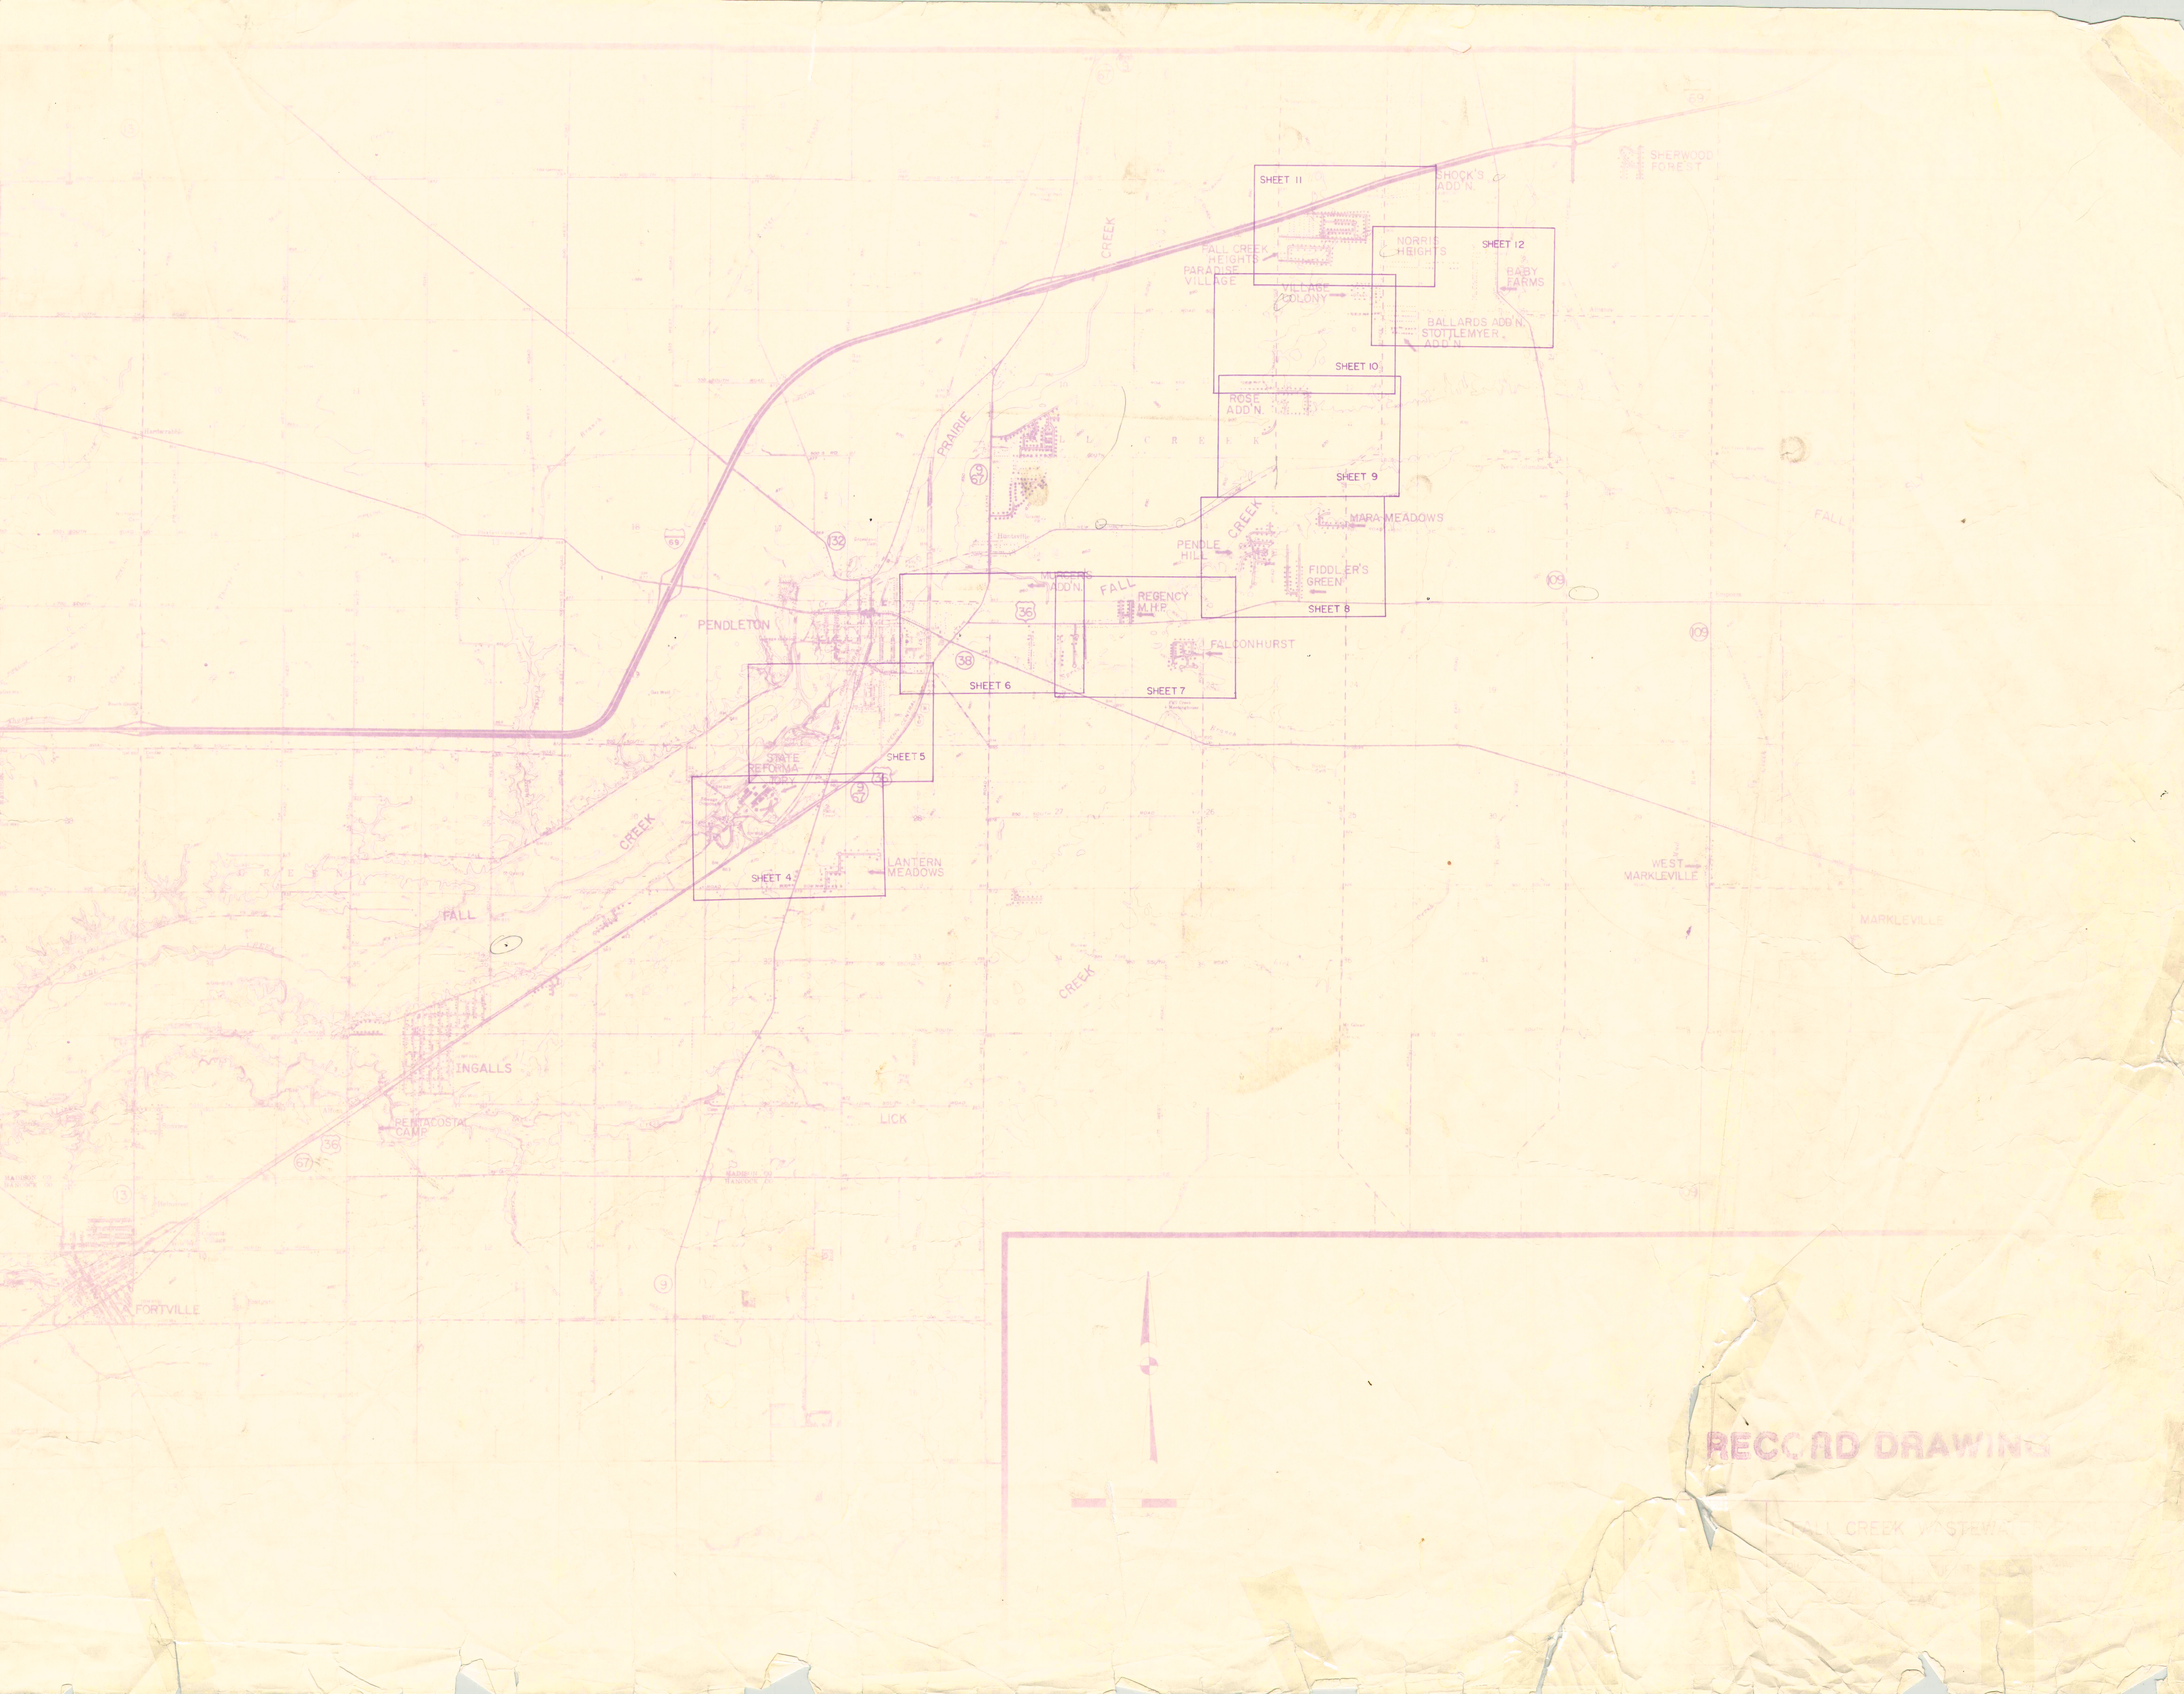

RECORD DRAWING

FALL CREEK WASTEWATER COLLECTION SYSTEM