


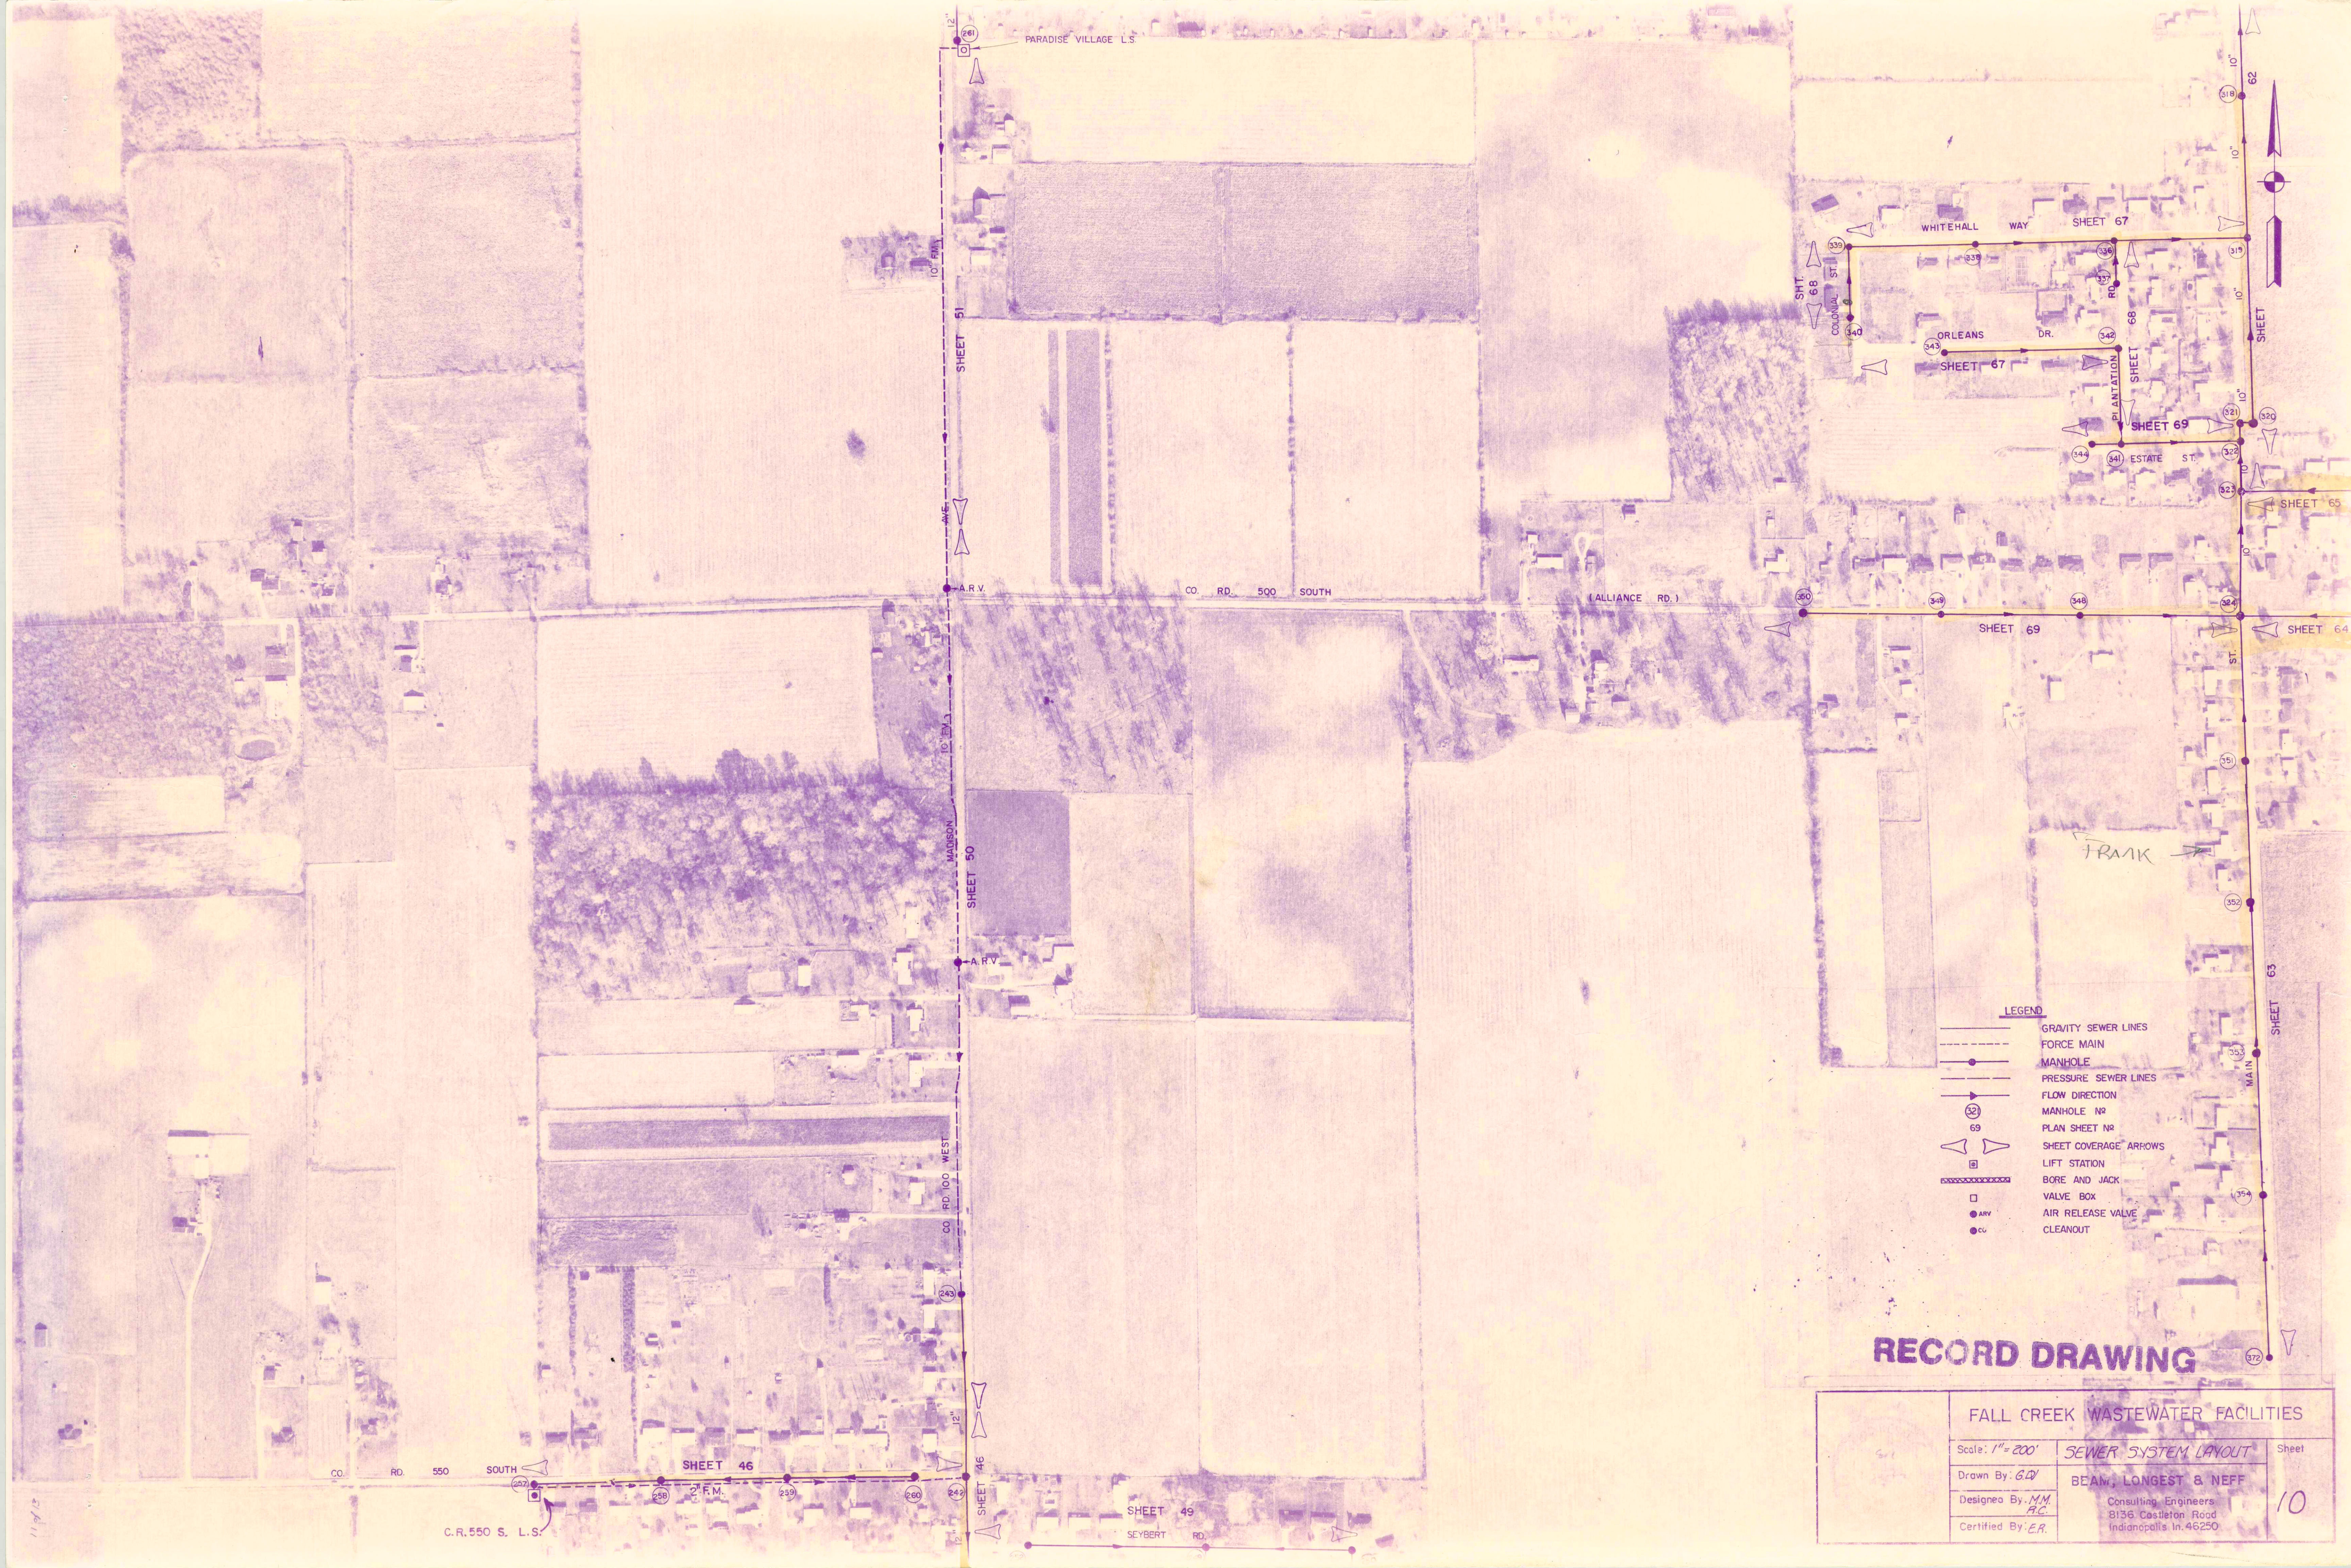

RECORD DRAWING

FALL CREEK WASTEWATER FACILITIES		
Scale: 1"=200'	SEWER SYSTEM LAYOUT	Sheet
Drawn By: G.L.V.	BEAM, LONGEST & NEFF	10
Designed By: M.M. H.C.	Consulting Engineers	
Certified By: E.R.	8136 Castleton Road Indianapolis, In. 46250	