


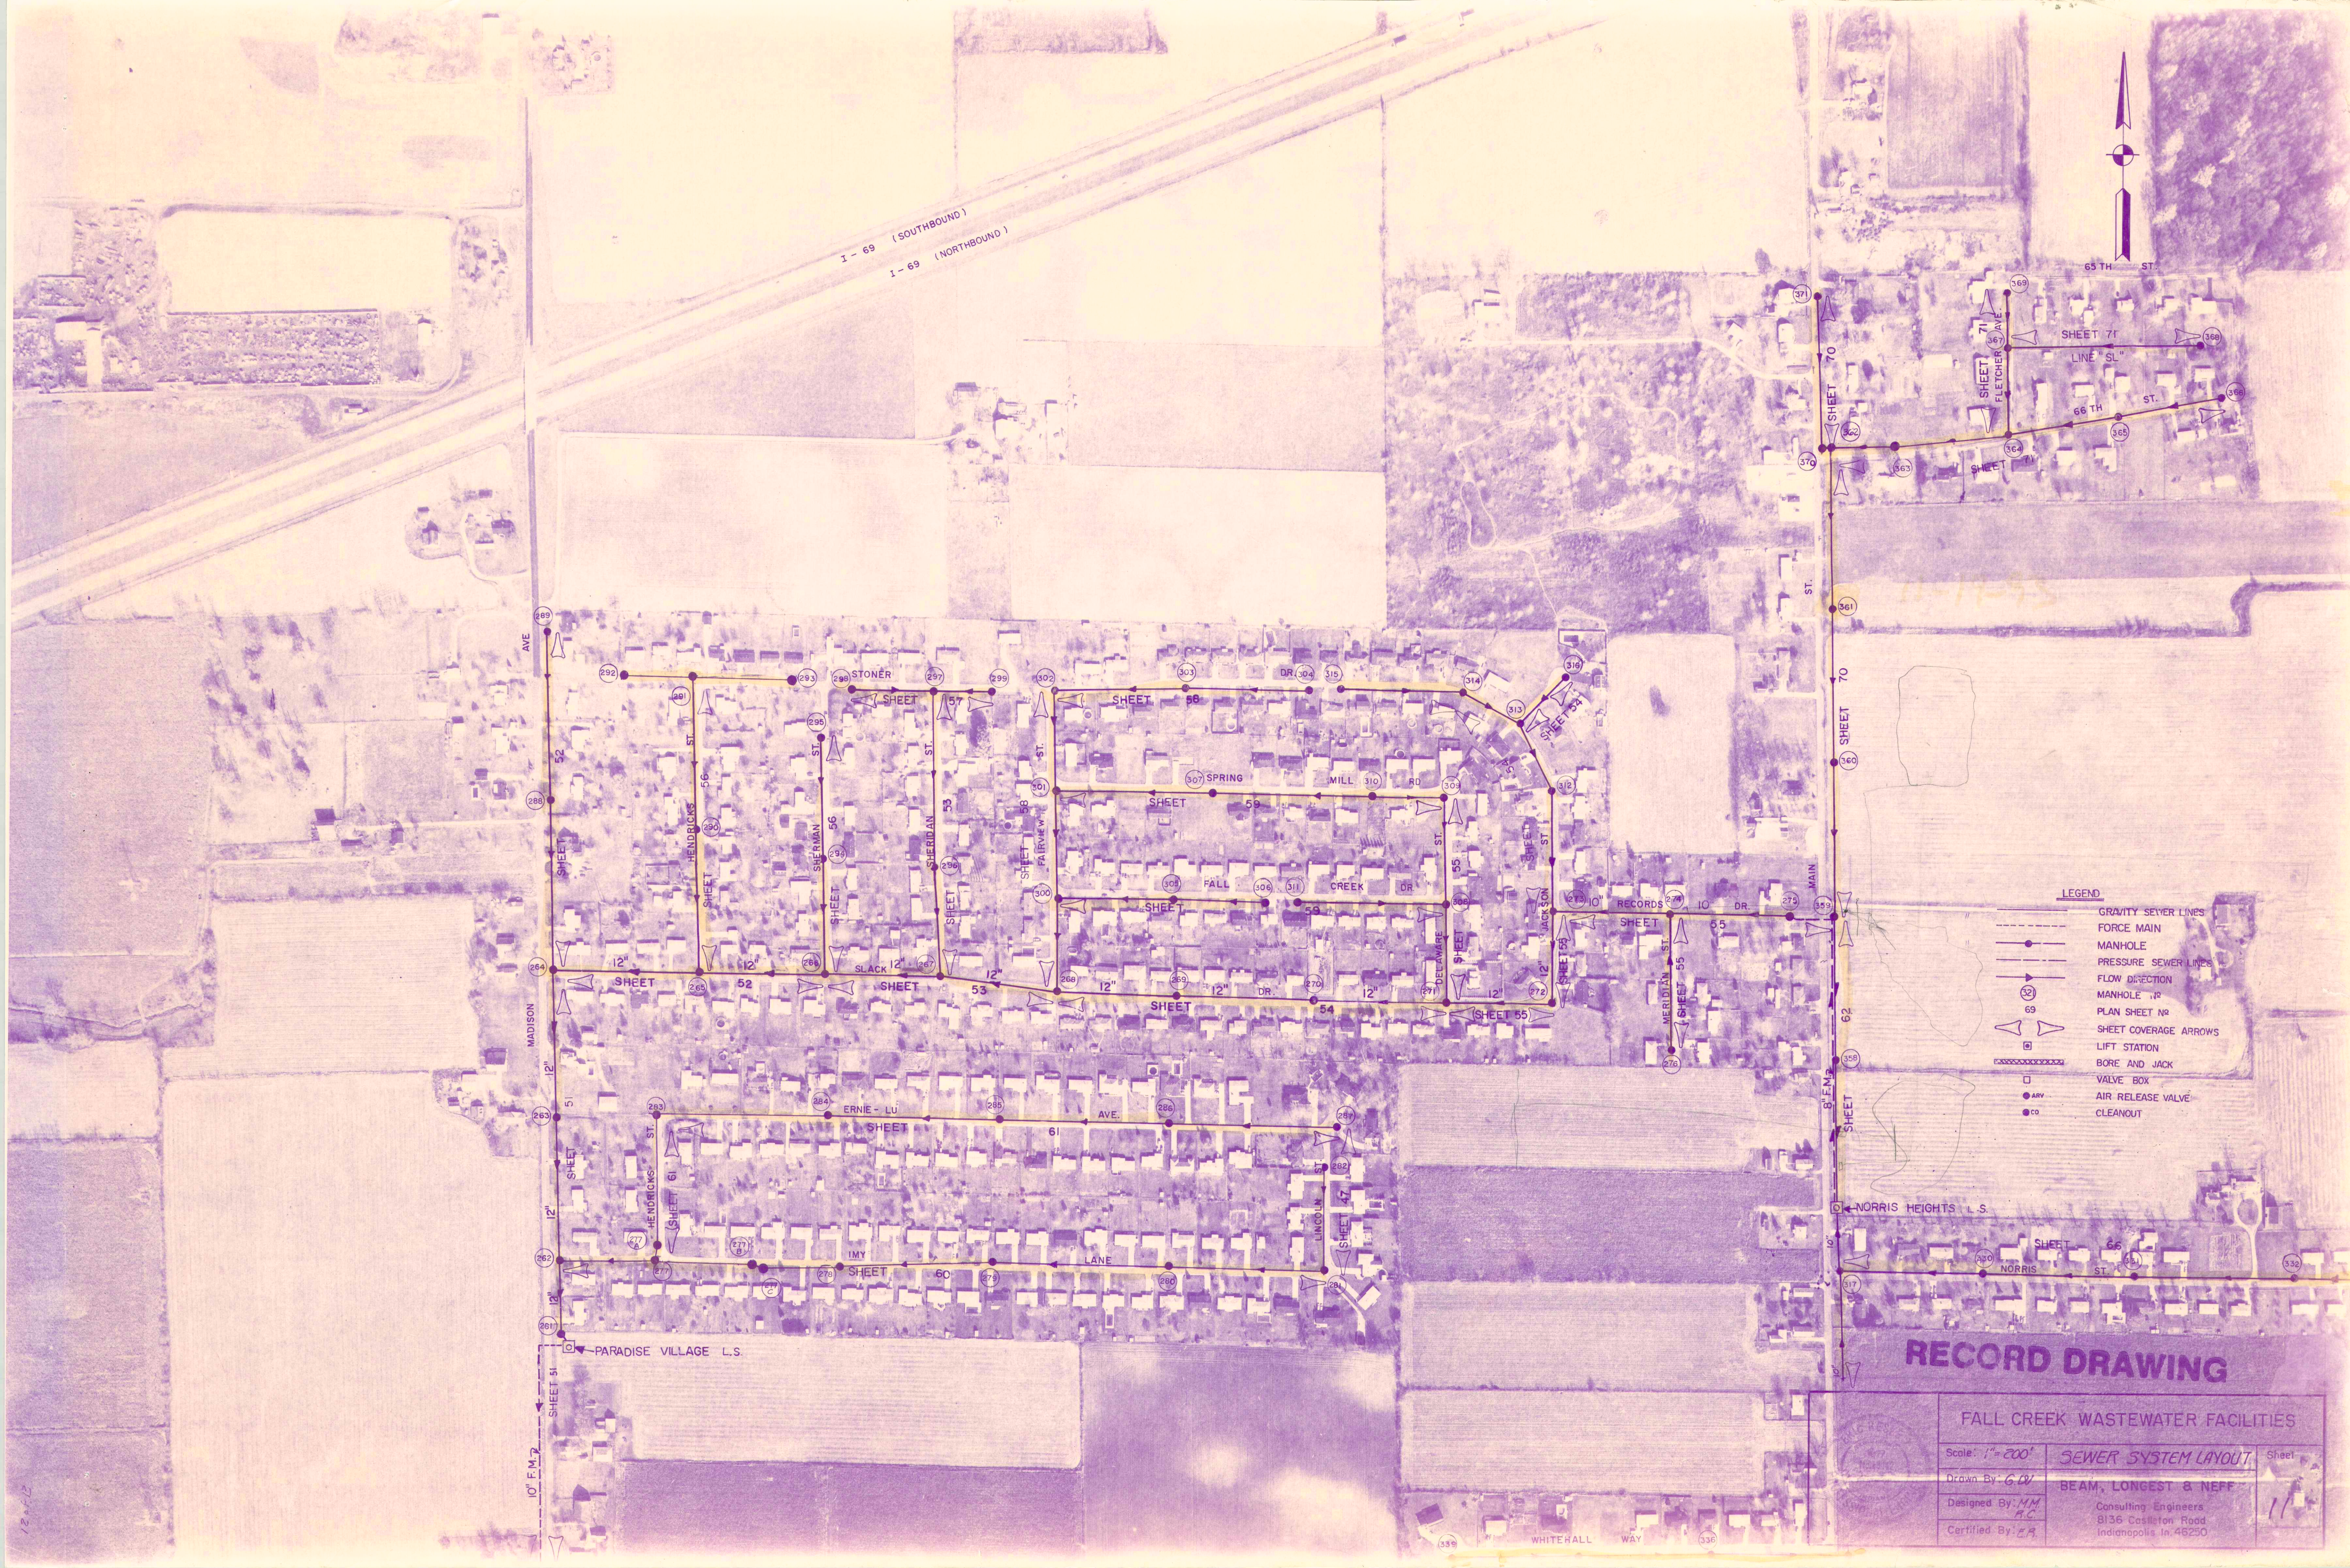

- LEGEND
- GRAVITY SEWER LINES
 - FORCE MAIN
 - MANHOLE
 - PRESSURE SEWER LINES
 - FLOW DIRECTION
 - MANHOLE NO.
 - PLAN SHEET NO.
 - SHEET COVERAGE ARROWS
 - LIFT STATION
 - BORE AND JACK
 - VALVE BOX
 - AIR RELEASE VALVE
 - CLEANOUT

RECORD DRAWING

FALL CREEK WASTEWATER FACILITIES		
Scale: 1"=200'	SEWER SYSTEM LAYOUT	Sheet
Drawn By: G.W.	BEAM, LONGEST & NEFF	11
Designed By: M.M.	Consulting Engineers	
Certified By: E.A.	8136 Casselton Road	
	Indianapolis, IN 46250	