


PLAN
NOTE BOOK
NO.

PROFILE
NOTE BOOK
NO.

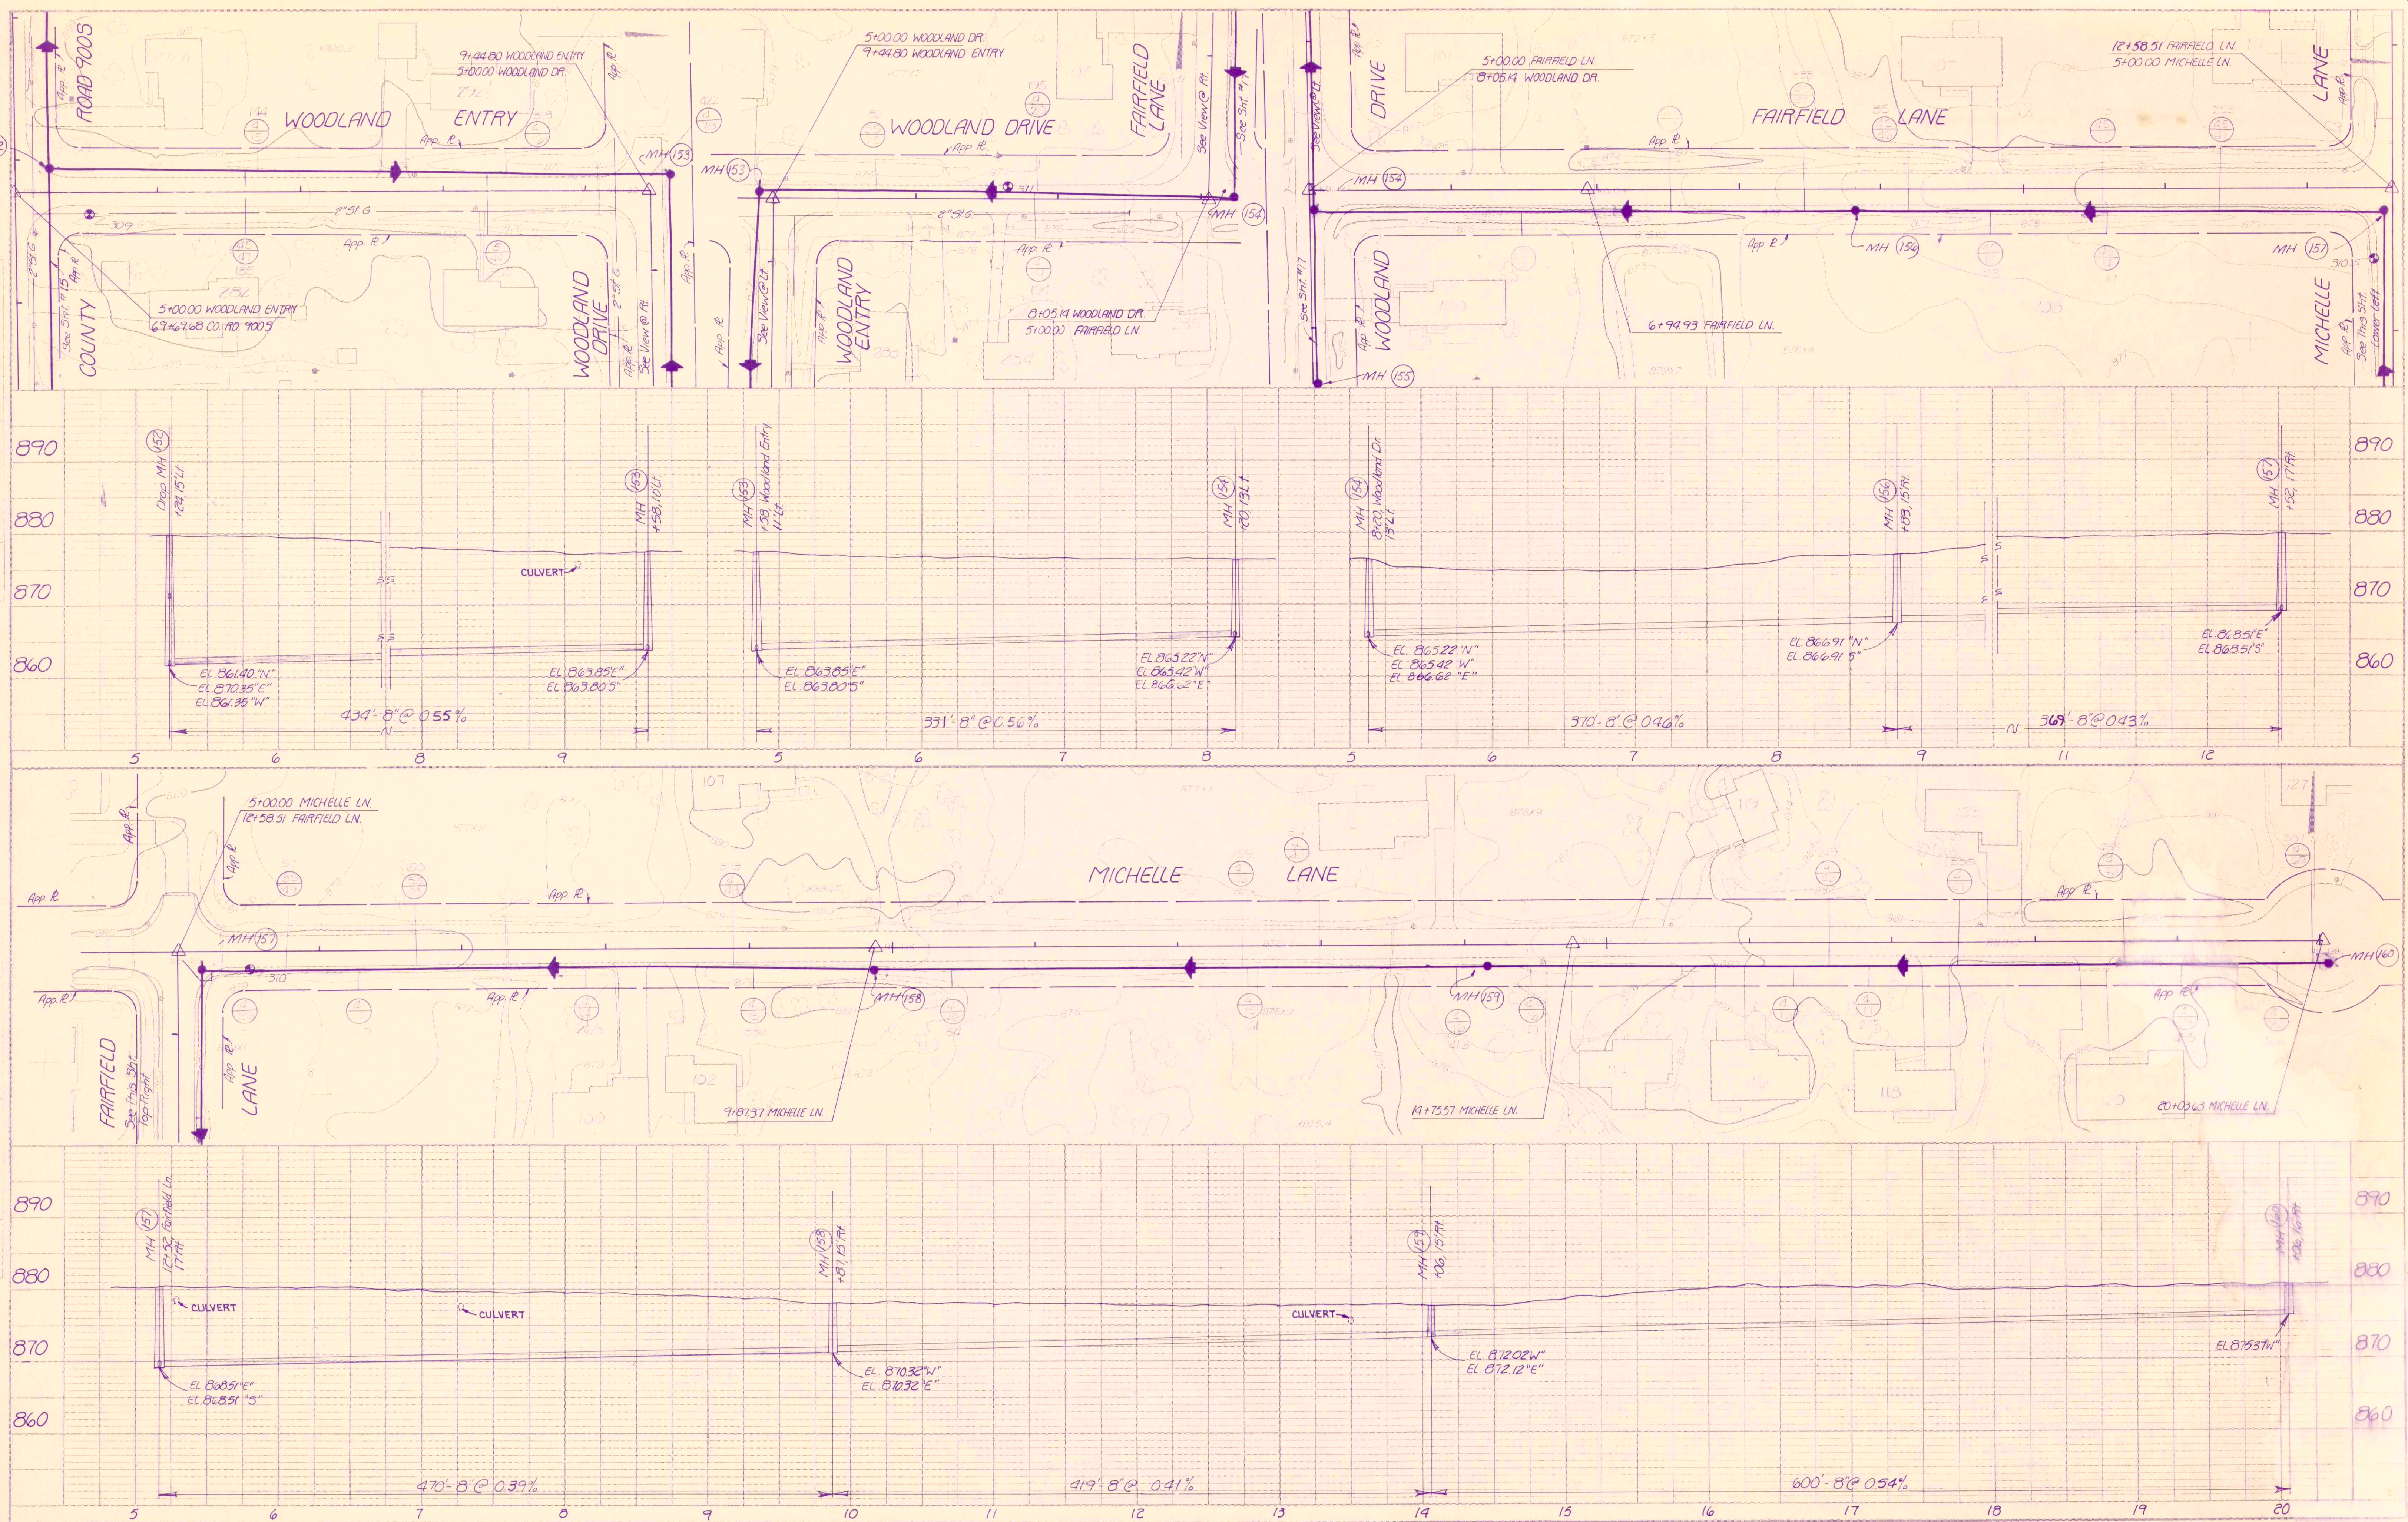

RECORD DRAWING

WOODLAND ENTRY & DR./FAIRFIELD LN
MICHELLE LANE
FALL CREEK R.W.D. PLAN & PROFILE SHEET
HORIZ. 1"=50'
VERT. 1"=10'
BEAM, LONGEST & NEFF, INC.
CONSULTING ENGINEERS
INDIANAPOLIS, INDIANA
14