


PLAN
 NORTH ARROW
 DATE
 NO.

PROFILE
 DATE
 NO.

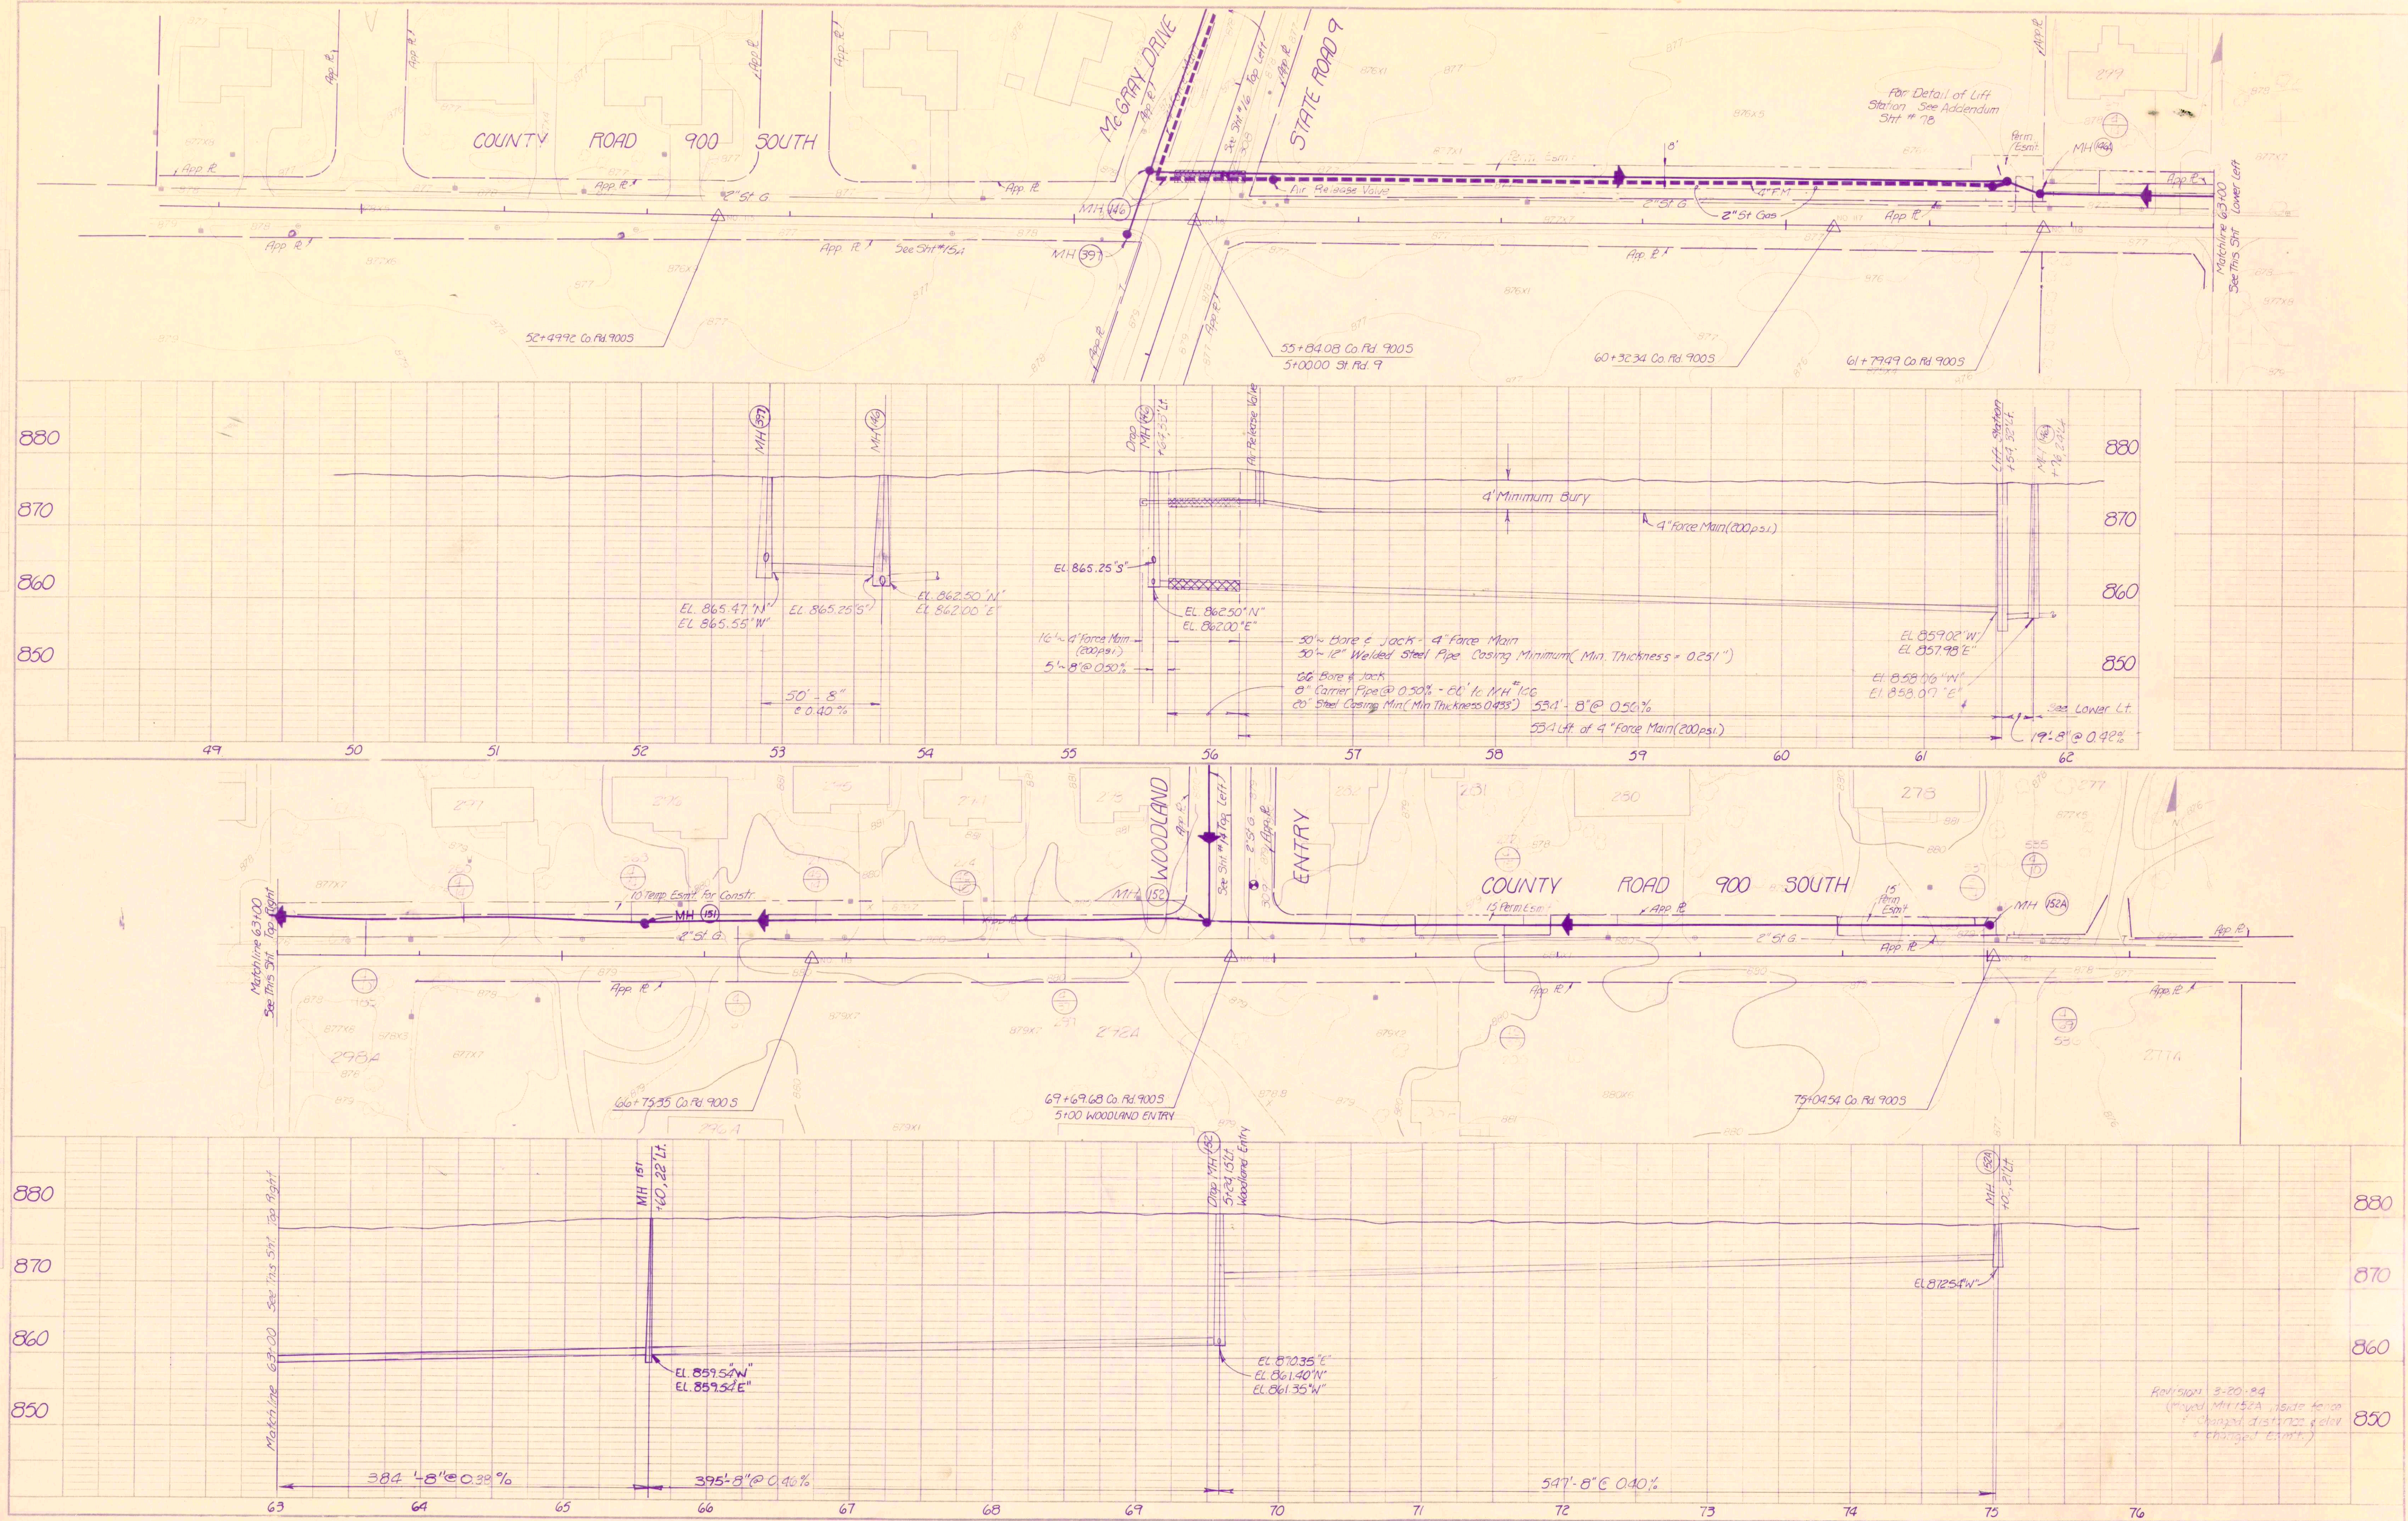

RECORD DRAWING