
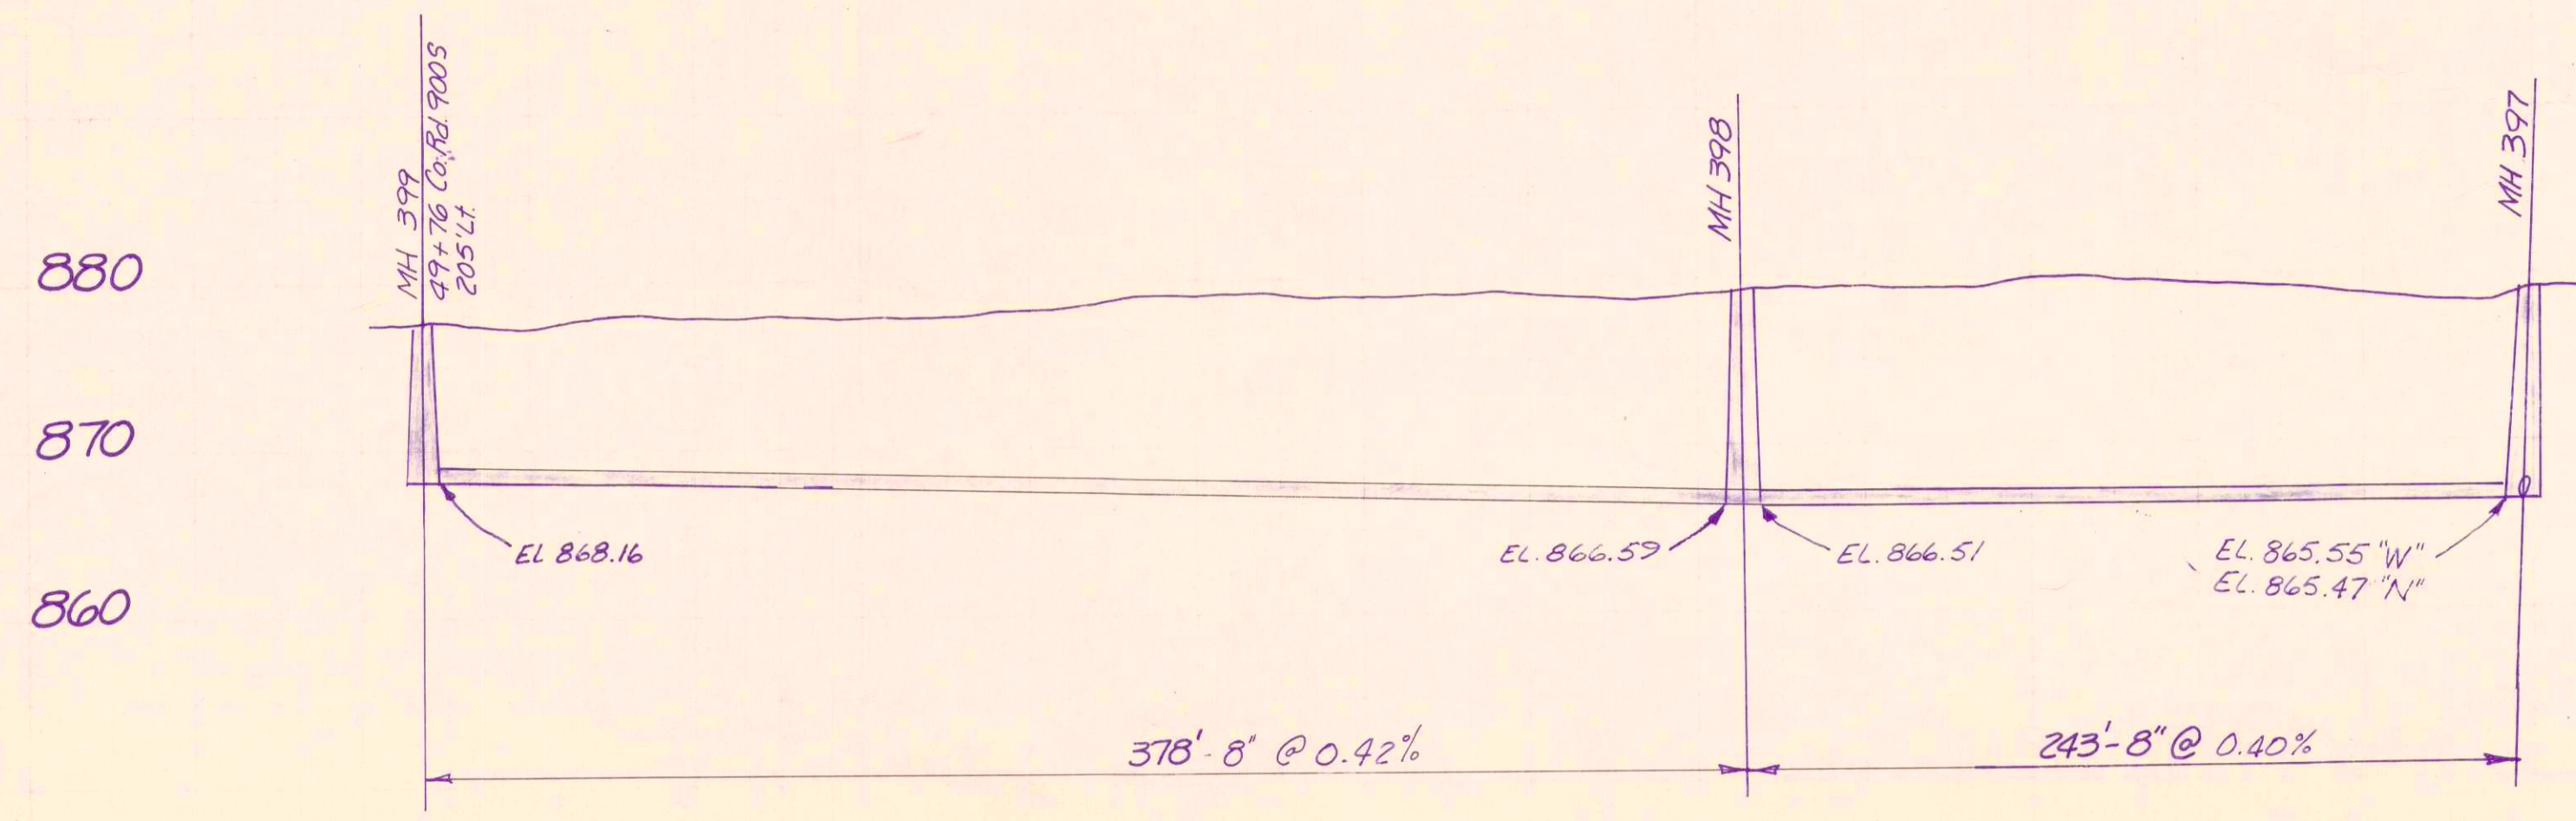


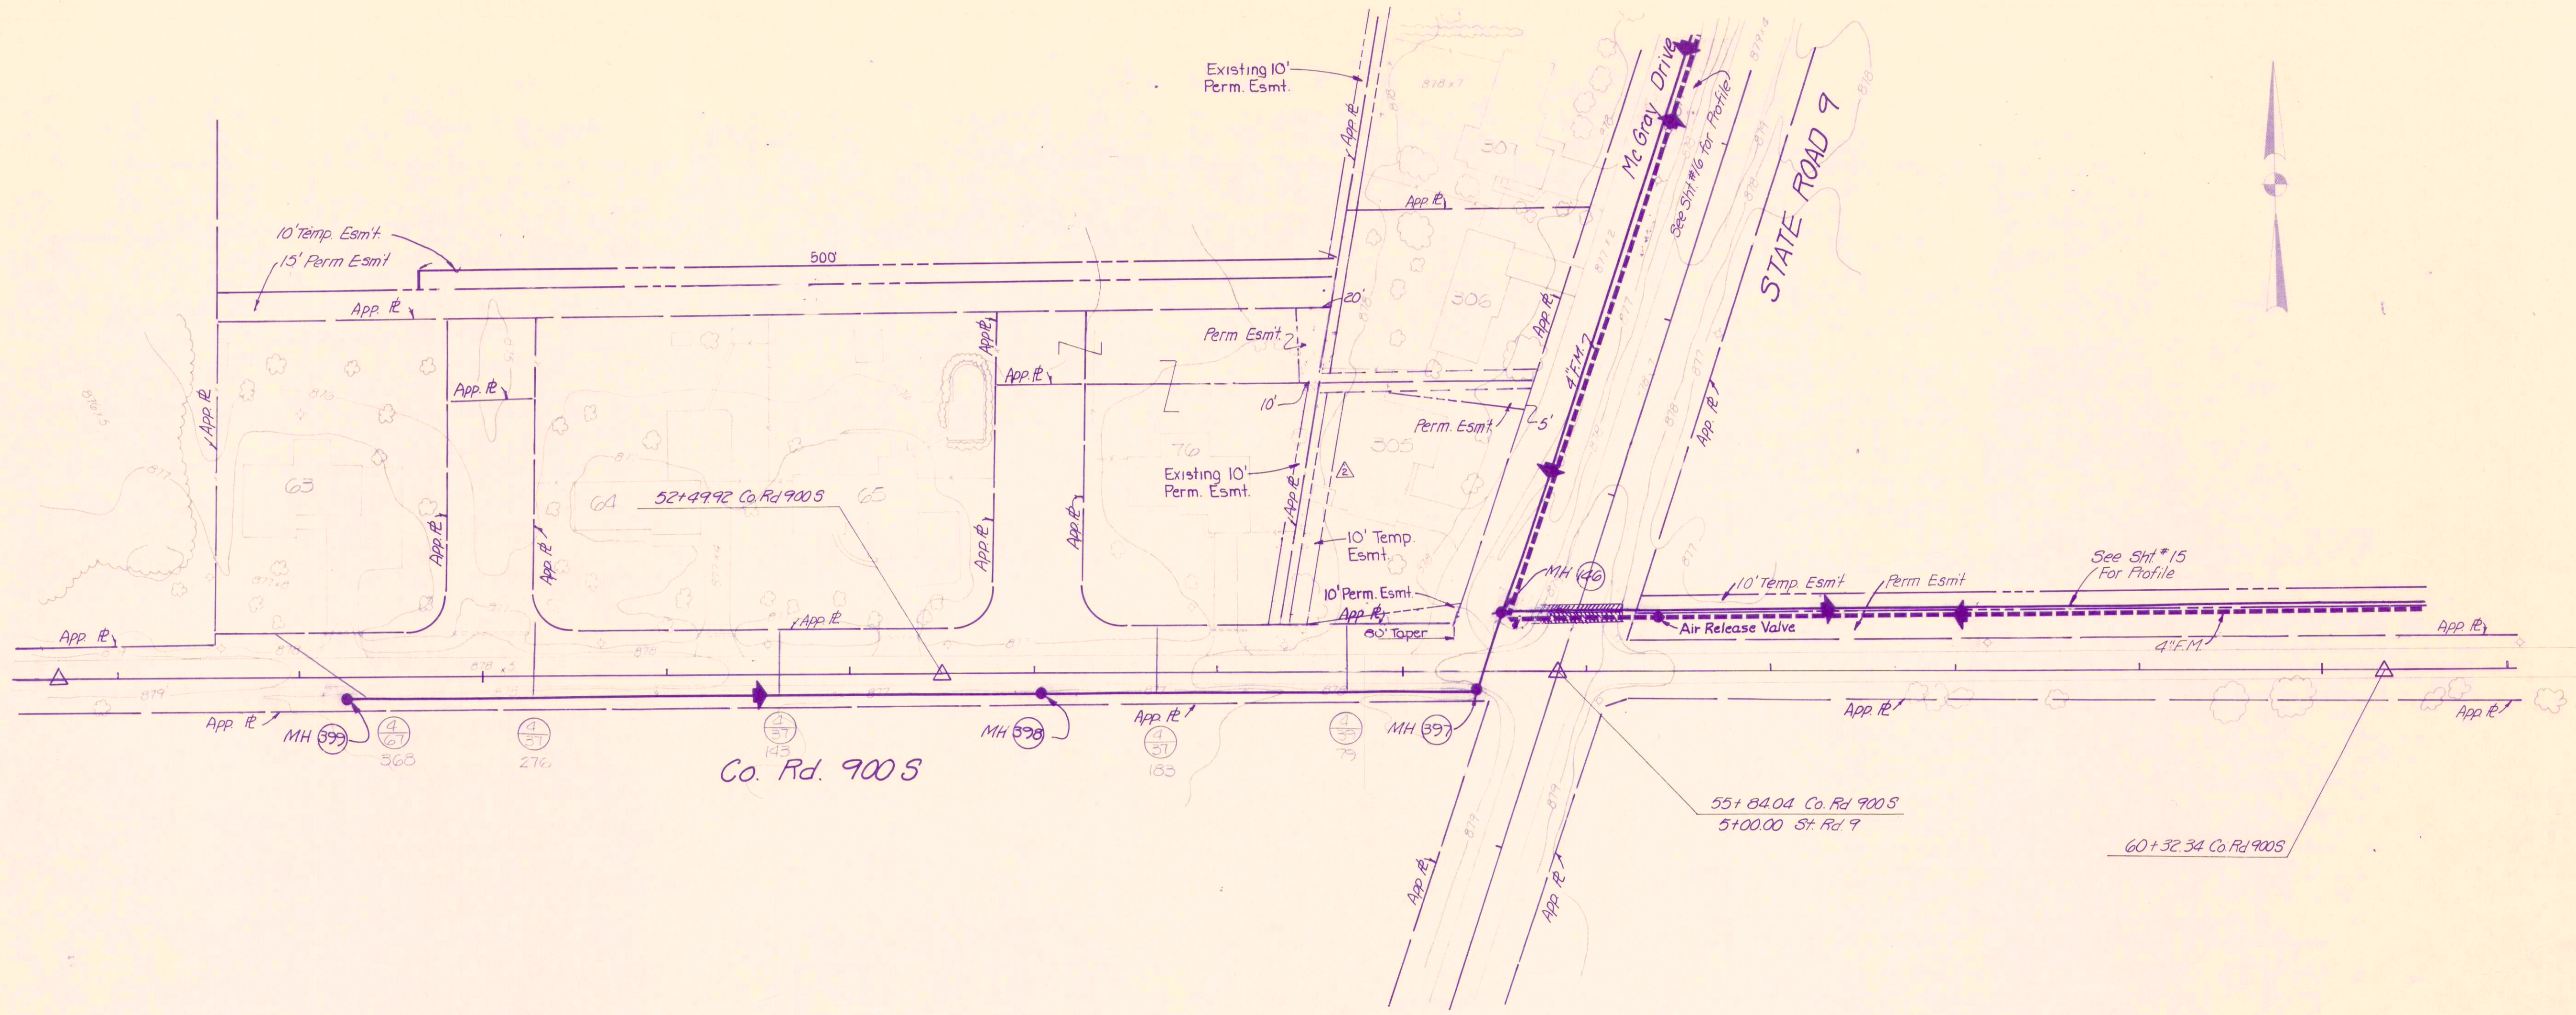

Revision 3-20-84
(Remove App. E)

COUNTY ROAD 900 SOUTH		
FALL CREEK RWD. PLAN & PROFILE SHEET		
HORIZ. 1"=50'	BEAM, LONGEST & NEFF, INC.	
VERT. 1"=10'	CONSULTING ENGINEERS	
	INDIANAPOLIS, INDIANA	

15A

RECORD DRAWING

Rev. 11-3-83 Δ Rev. 7-30-85