


PLAN
NOTE BOOK
NO.

PROFILE
NOTE BOOK
NO.

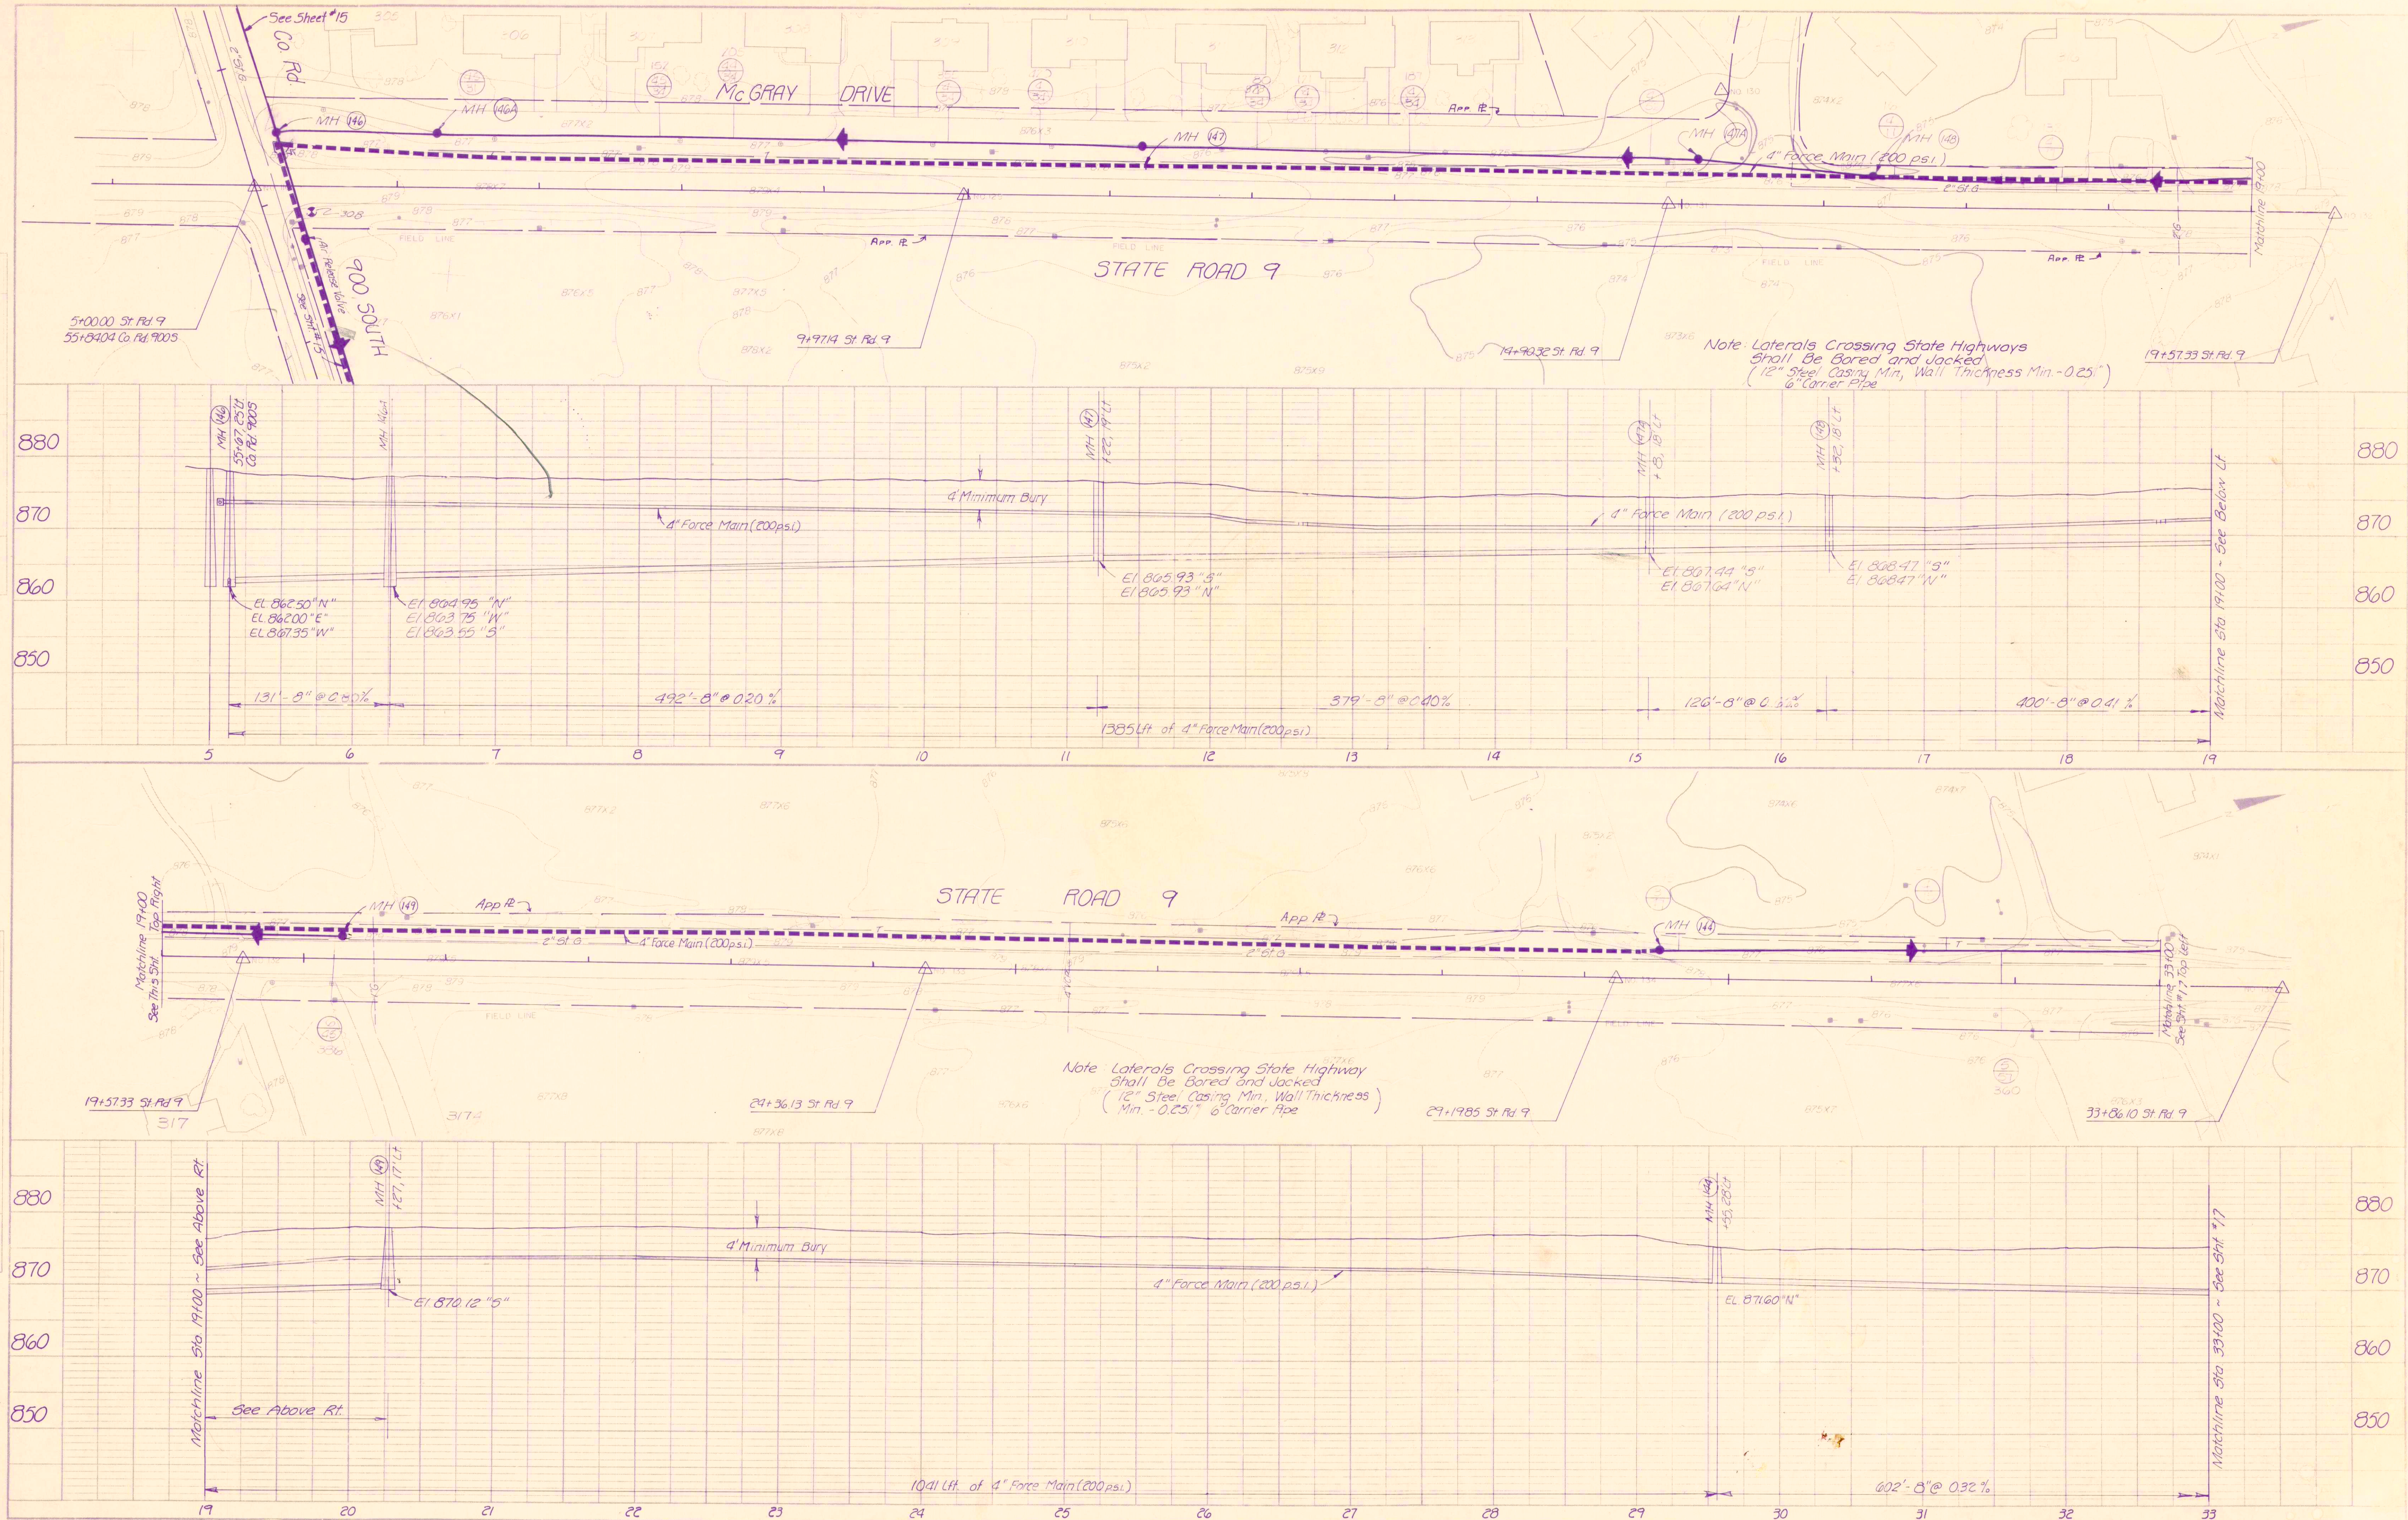

RECORD DRAWING