
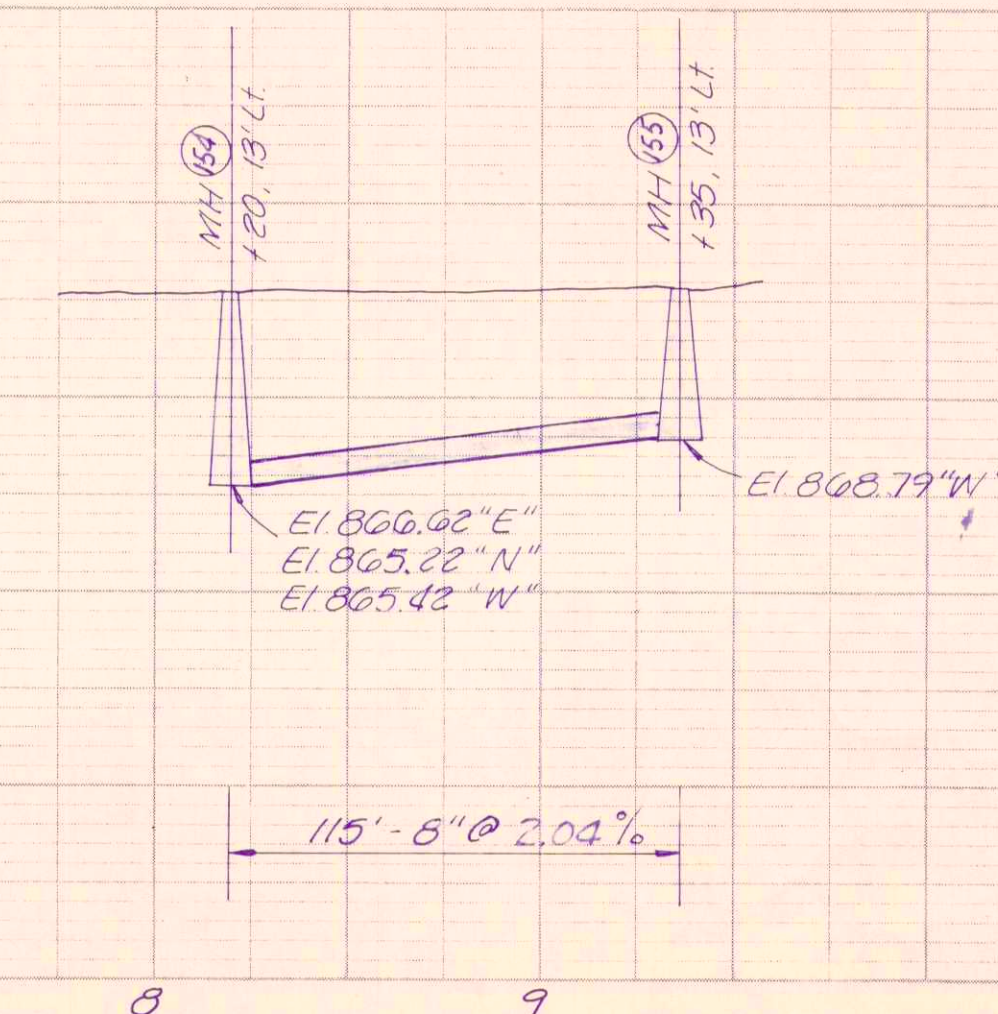
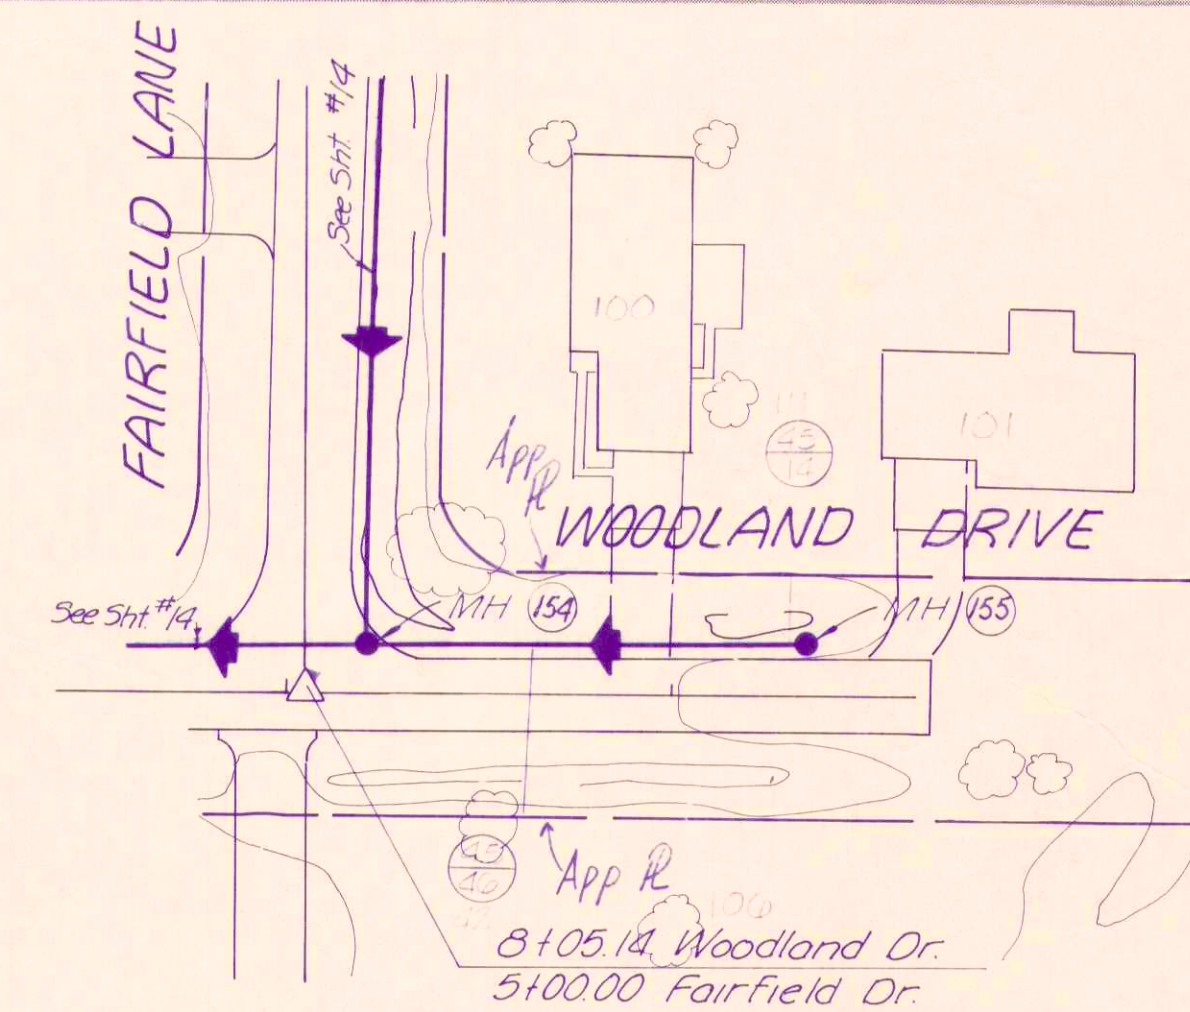
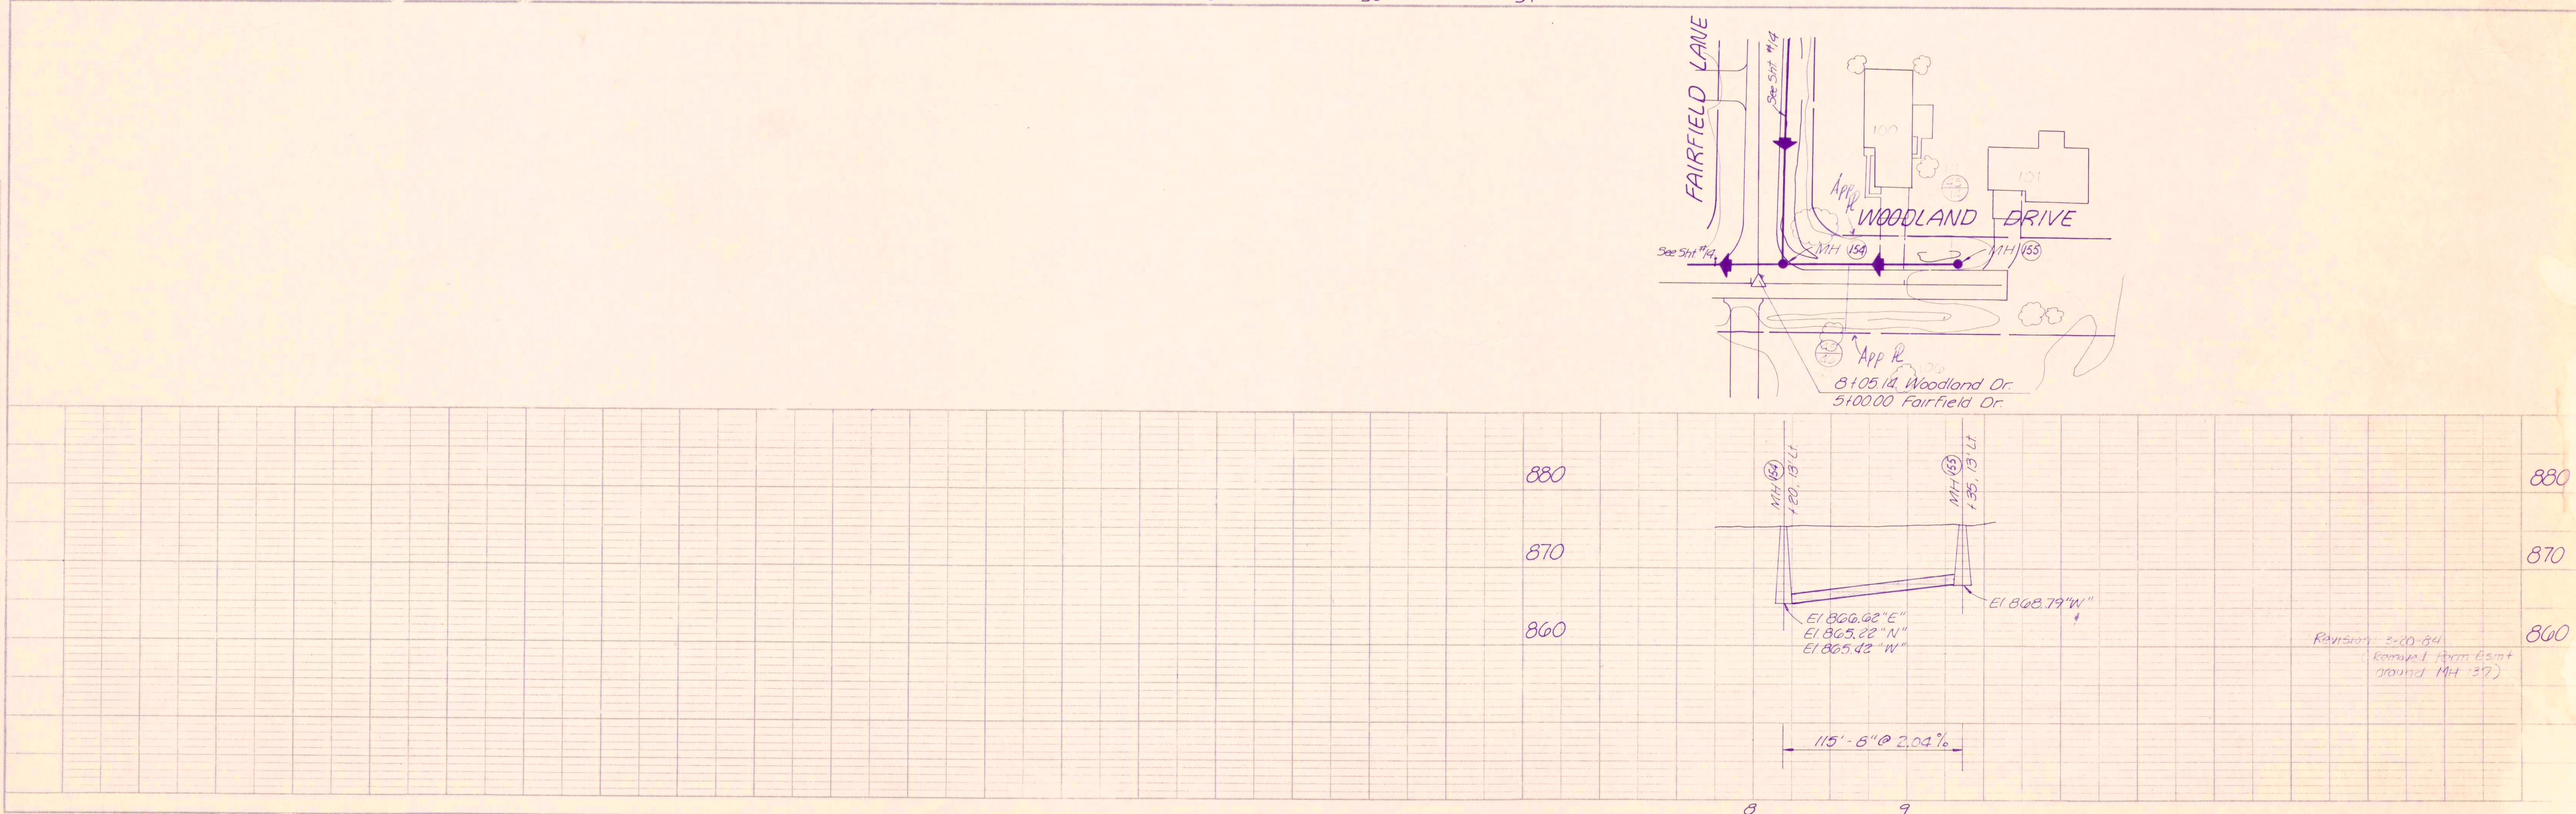


PLAN
 NOTE BOOK
 NO.

PROFILE
 NOTE BOOK
 NO.

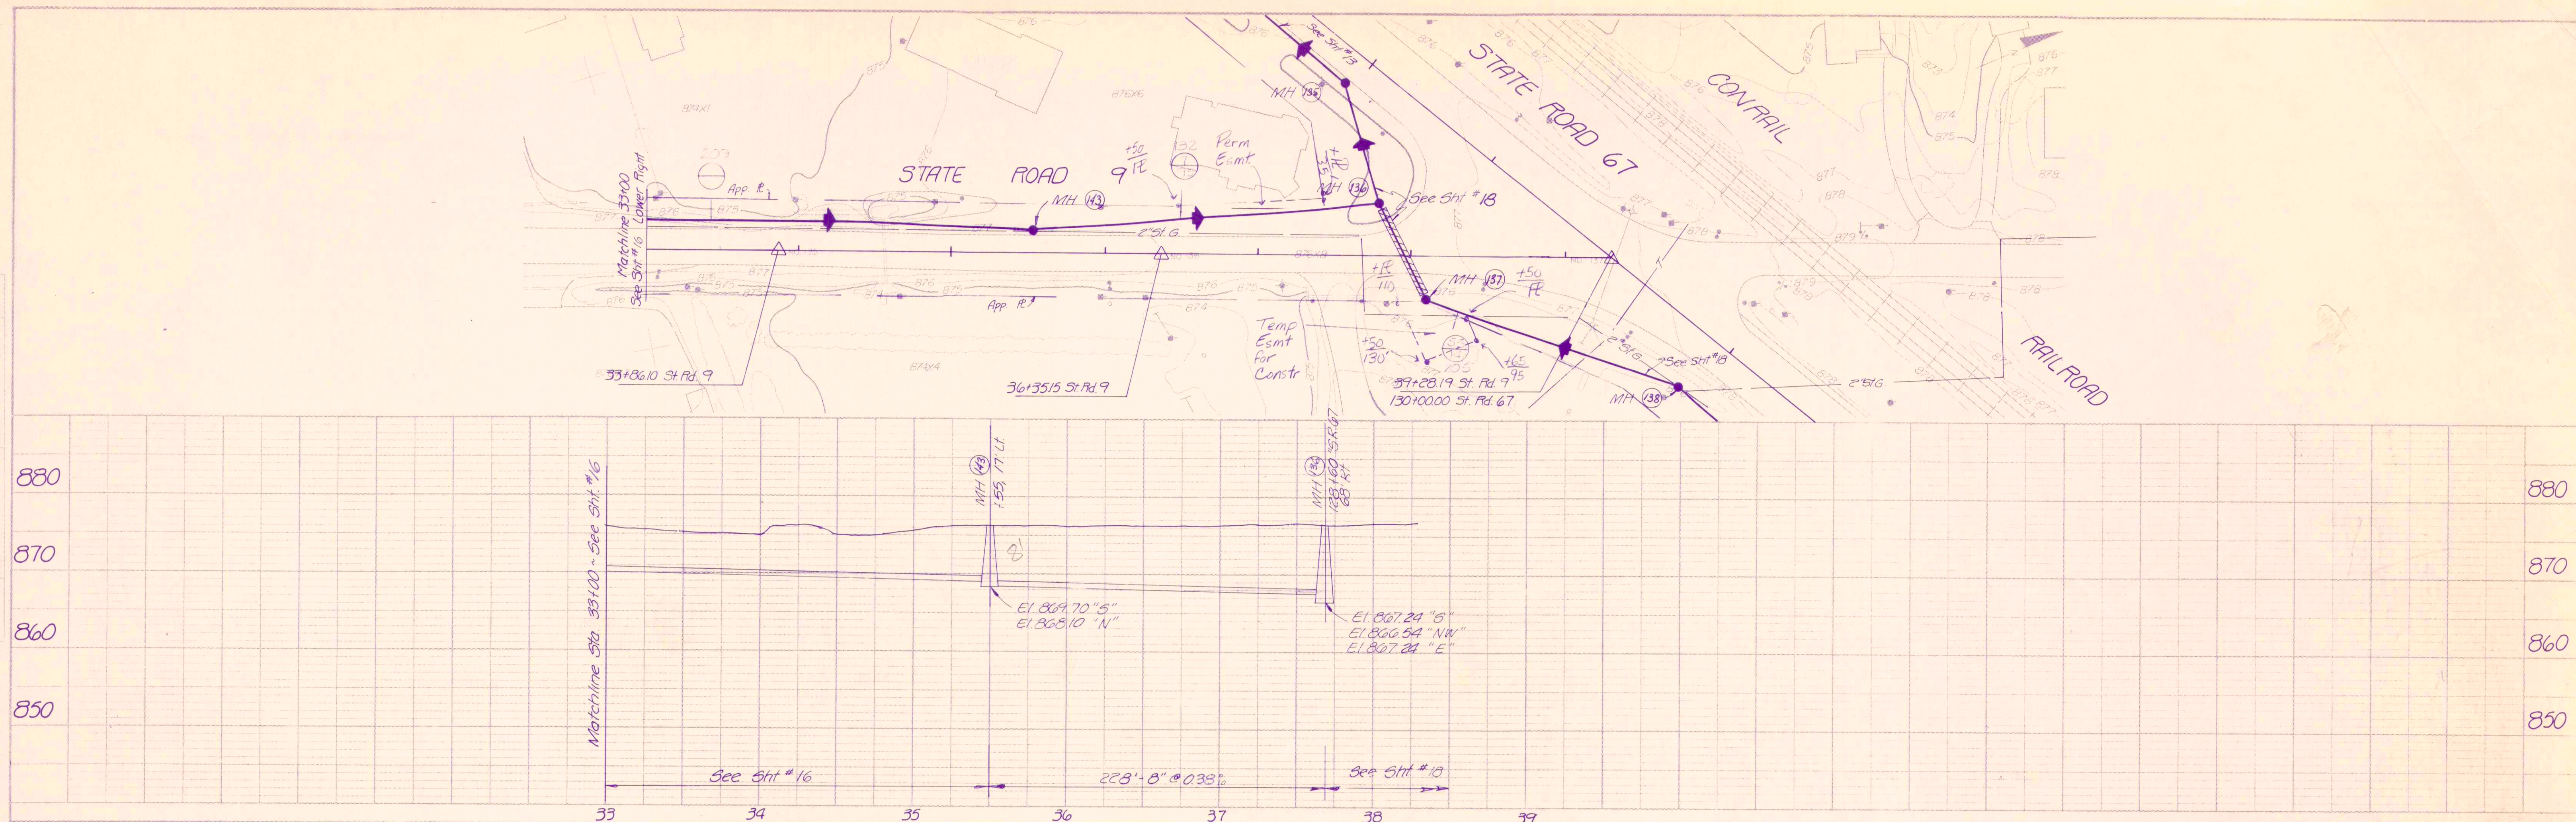

Revised: 2-10-84
 Replaced Form Esmt
 ground MH 137

RECORD DRAWING

STATE ROAD 9 / WOODLAND DRIVE
 FALL CREEK R.W.D. PLAN & PROFILE SHEET
 HORIZ. 1"=50'
 VERT. 1"=10'
 BEAM, LONGEST & NEFF, INC.
 CONSULTING ENGINEERS
 INDIANAPOLIS, INDIANA
 17