


PLAN
 DATE
 DRAWN BY
 CHECKED BY
 NOTE BOOK
 NO.

PROFILE
 DATE
 DRAWN BY
 CHECKED BY
 NOTE BOOK
 NO.

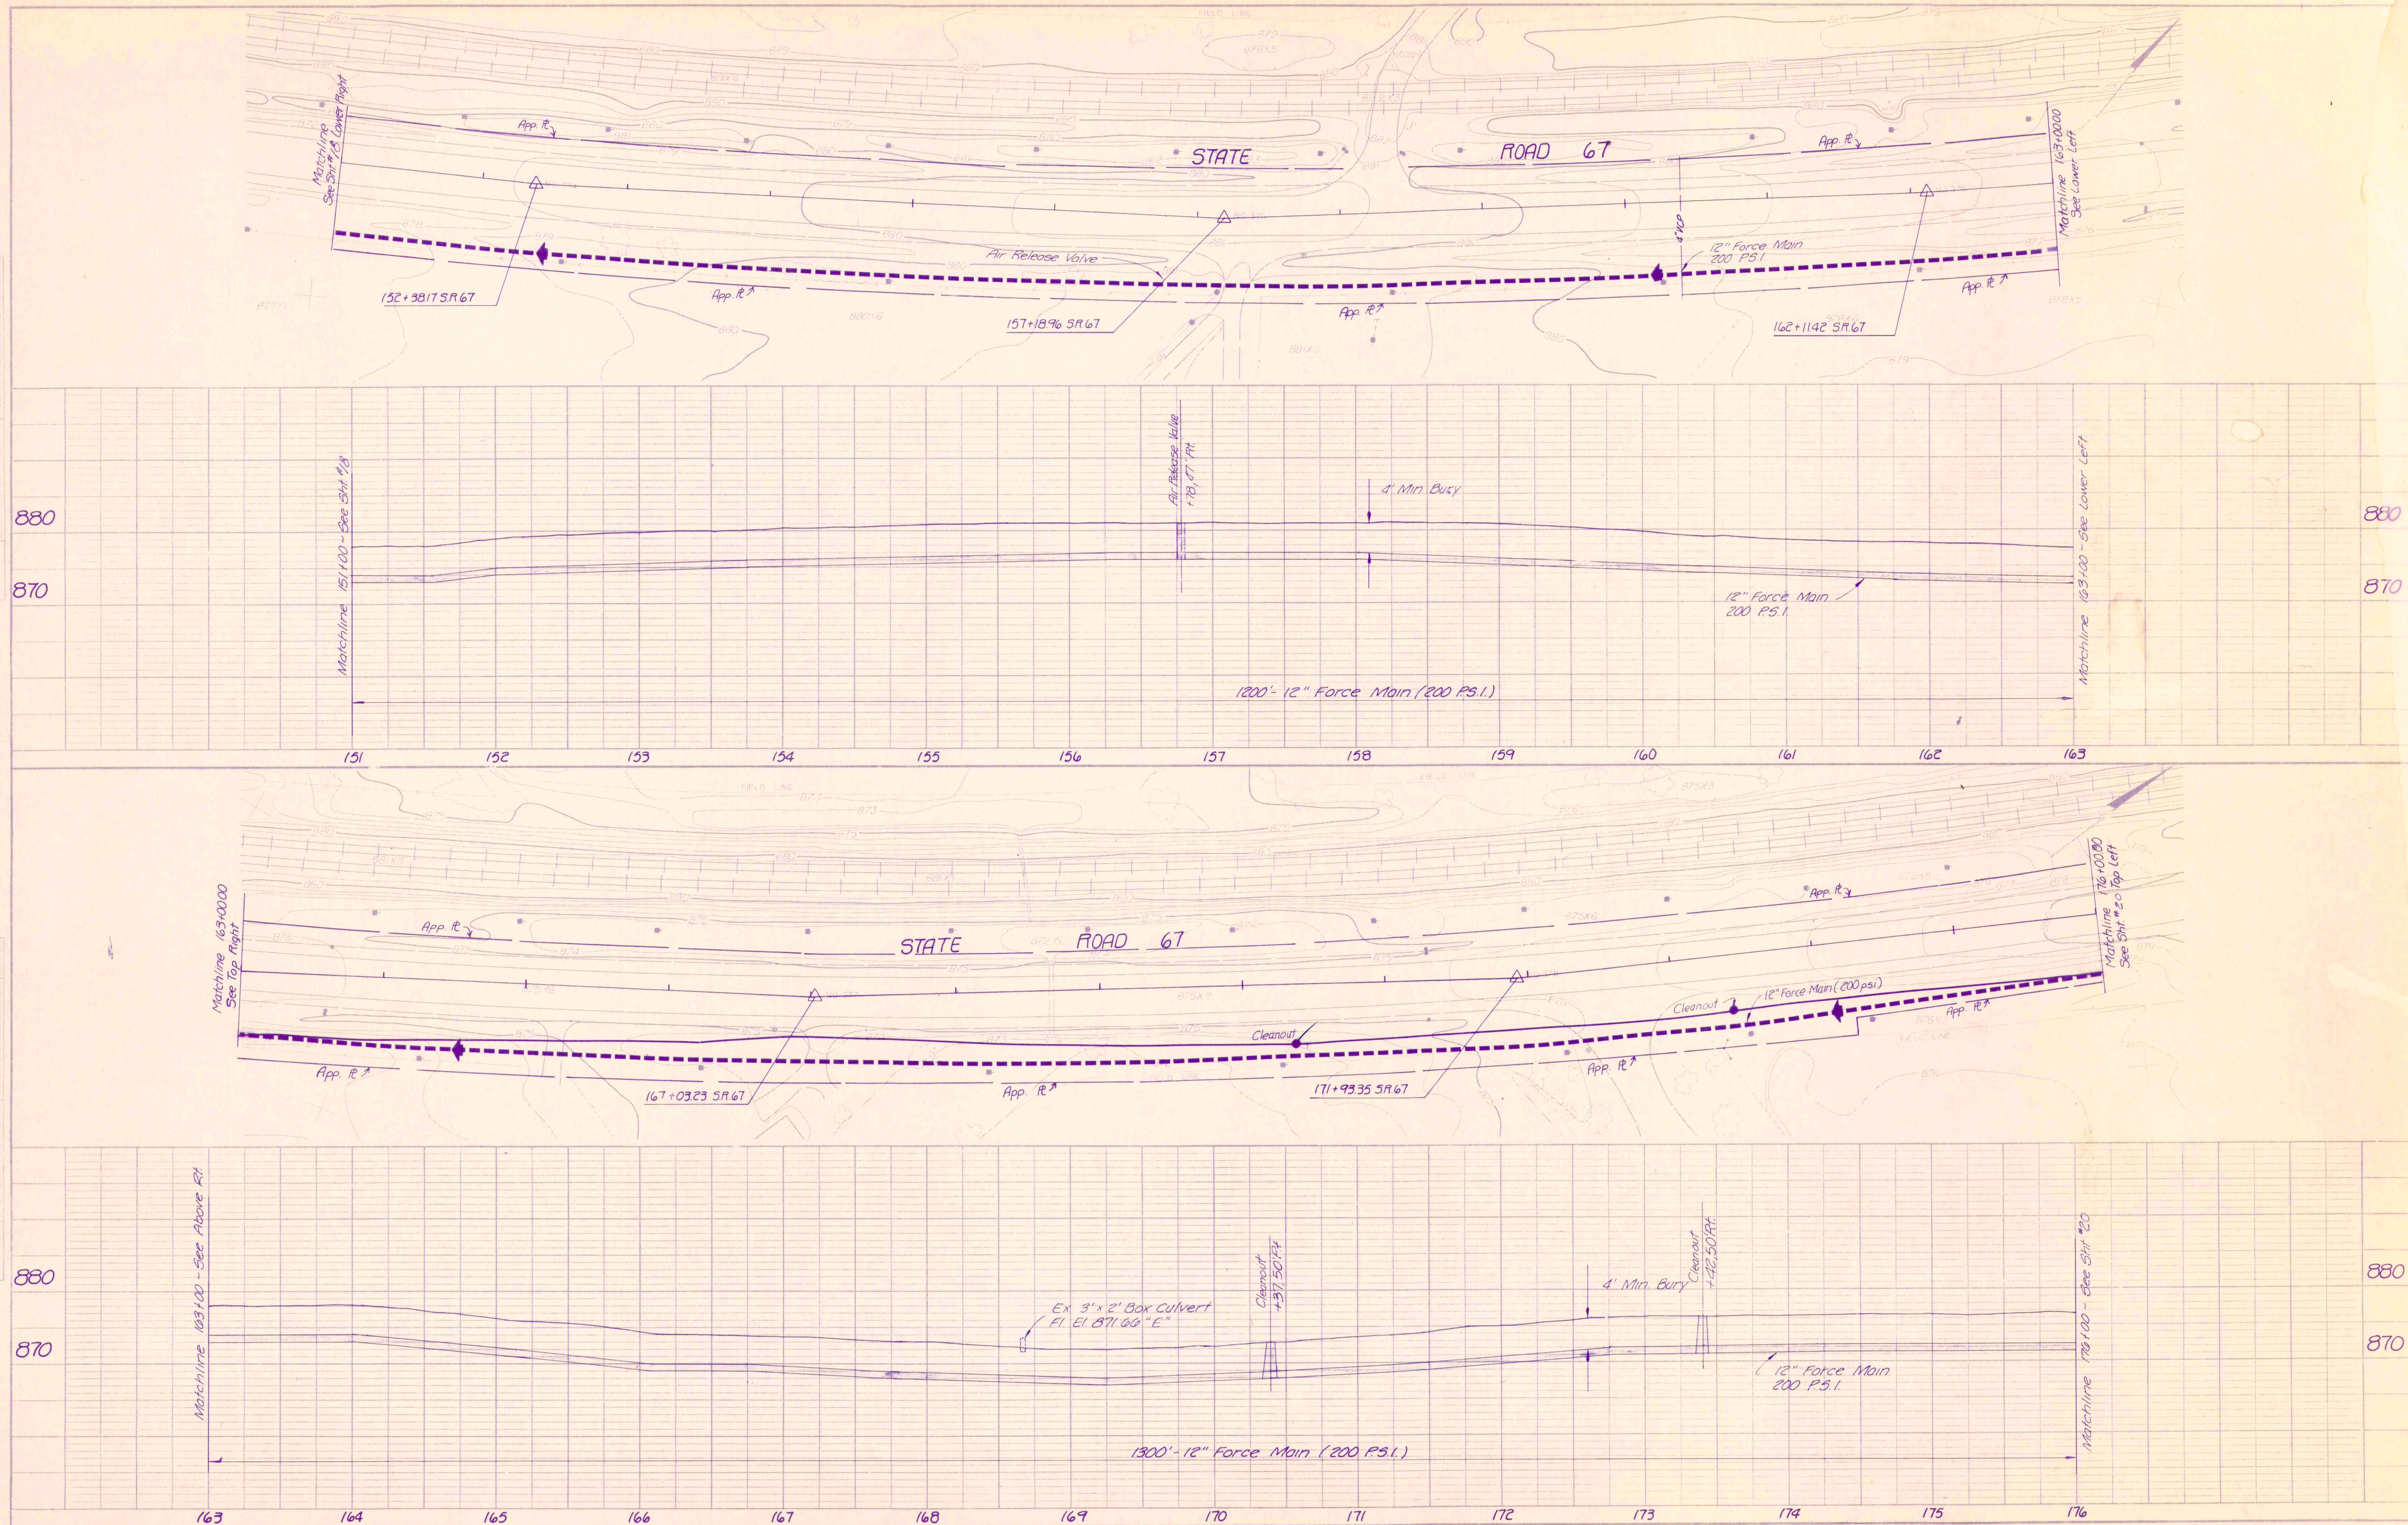

RECORD DRAWING

STATE ROAD 67
 FALL CREEK R.W.D. PLAN & PROFILE SHEET
 HORIZ. 1"=50'
 VERT. 1"=10'
 BEAM, LONGEST & NEFF, INC.
 CONSULTING ENGINEERS
 INDIANAPOLIS, INDIANA
 19