


PLAN	DATE	
	BY	
	CHECKED	
	NOTED	

PROFILE	DATE	
	BY	
	CHECKED	
	NOTED	

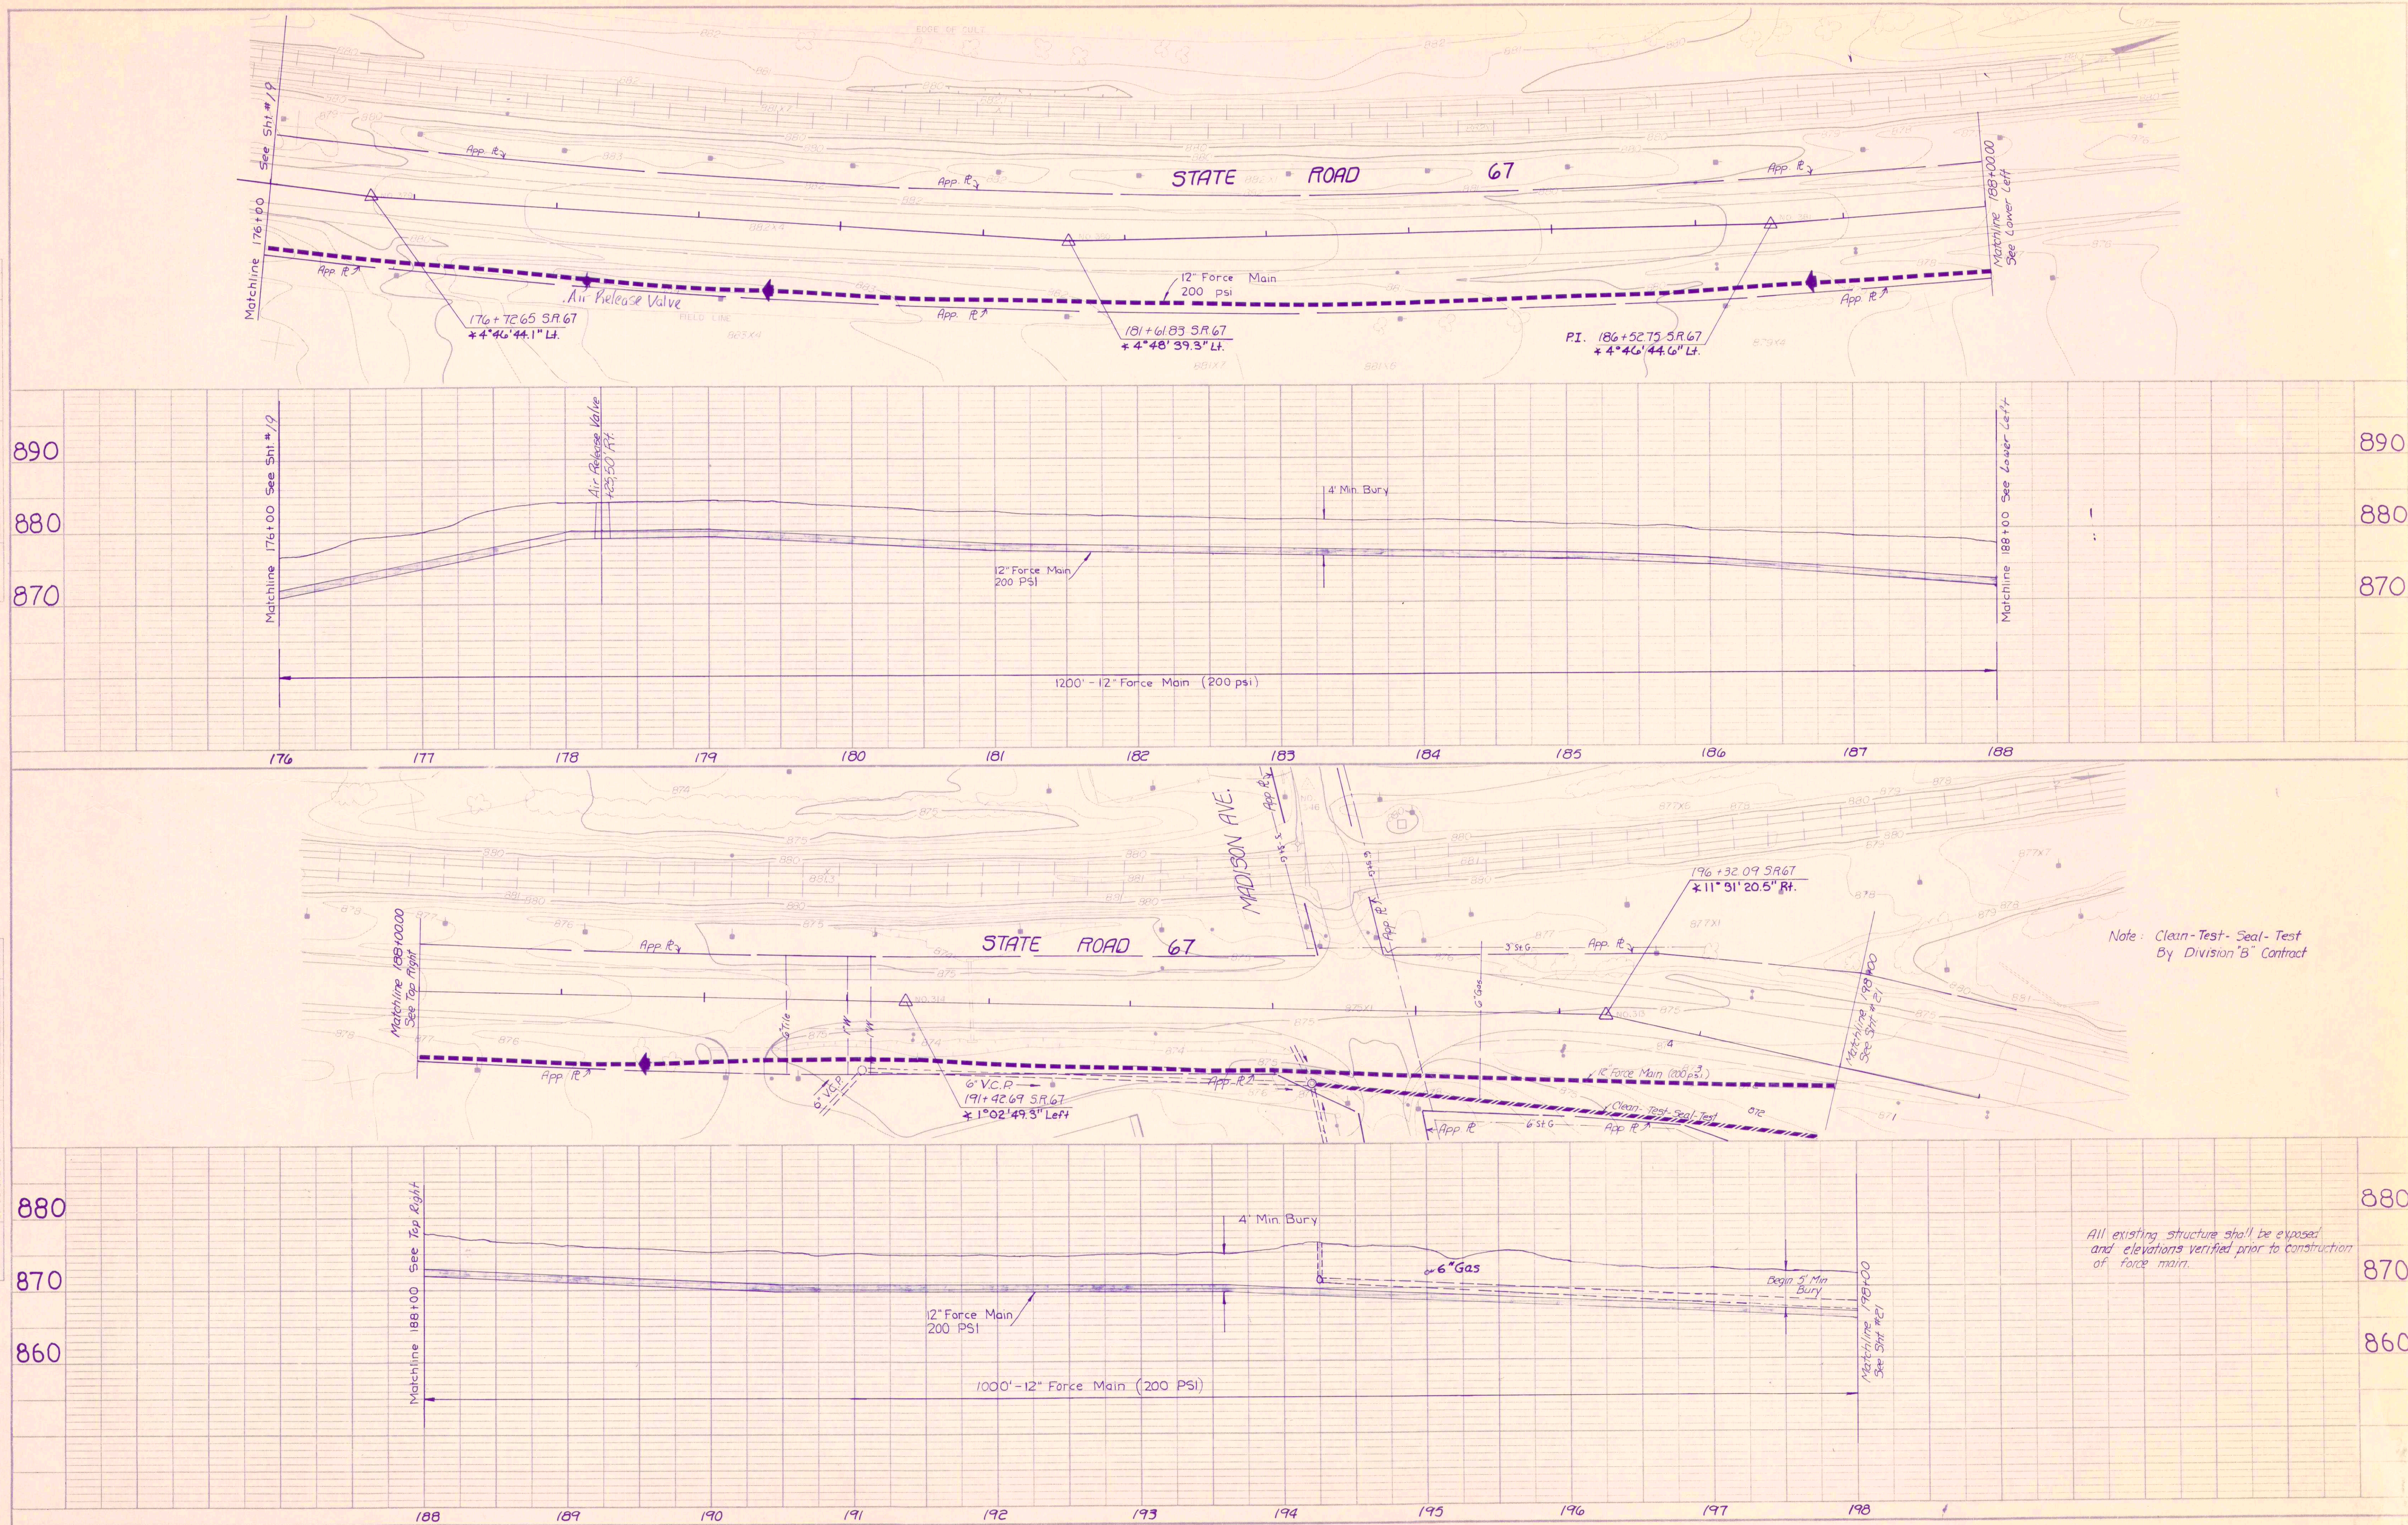

RECORD DRAWING