


DATE	BY	CHECKED
PLAN	DATE	BY
NOTE BOOK	DATE	BY

DATE	BY	CHECKED
PROFILE	DATE	BY
NOTE BOOK	DATE	BY

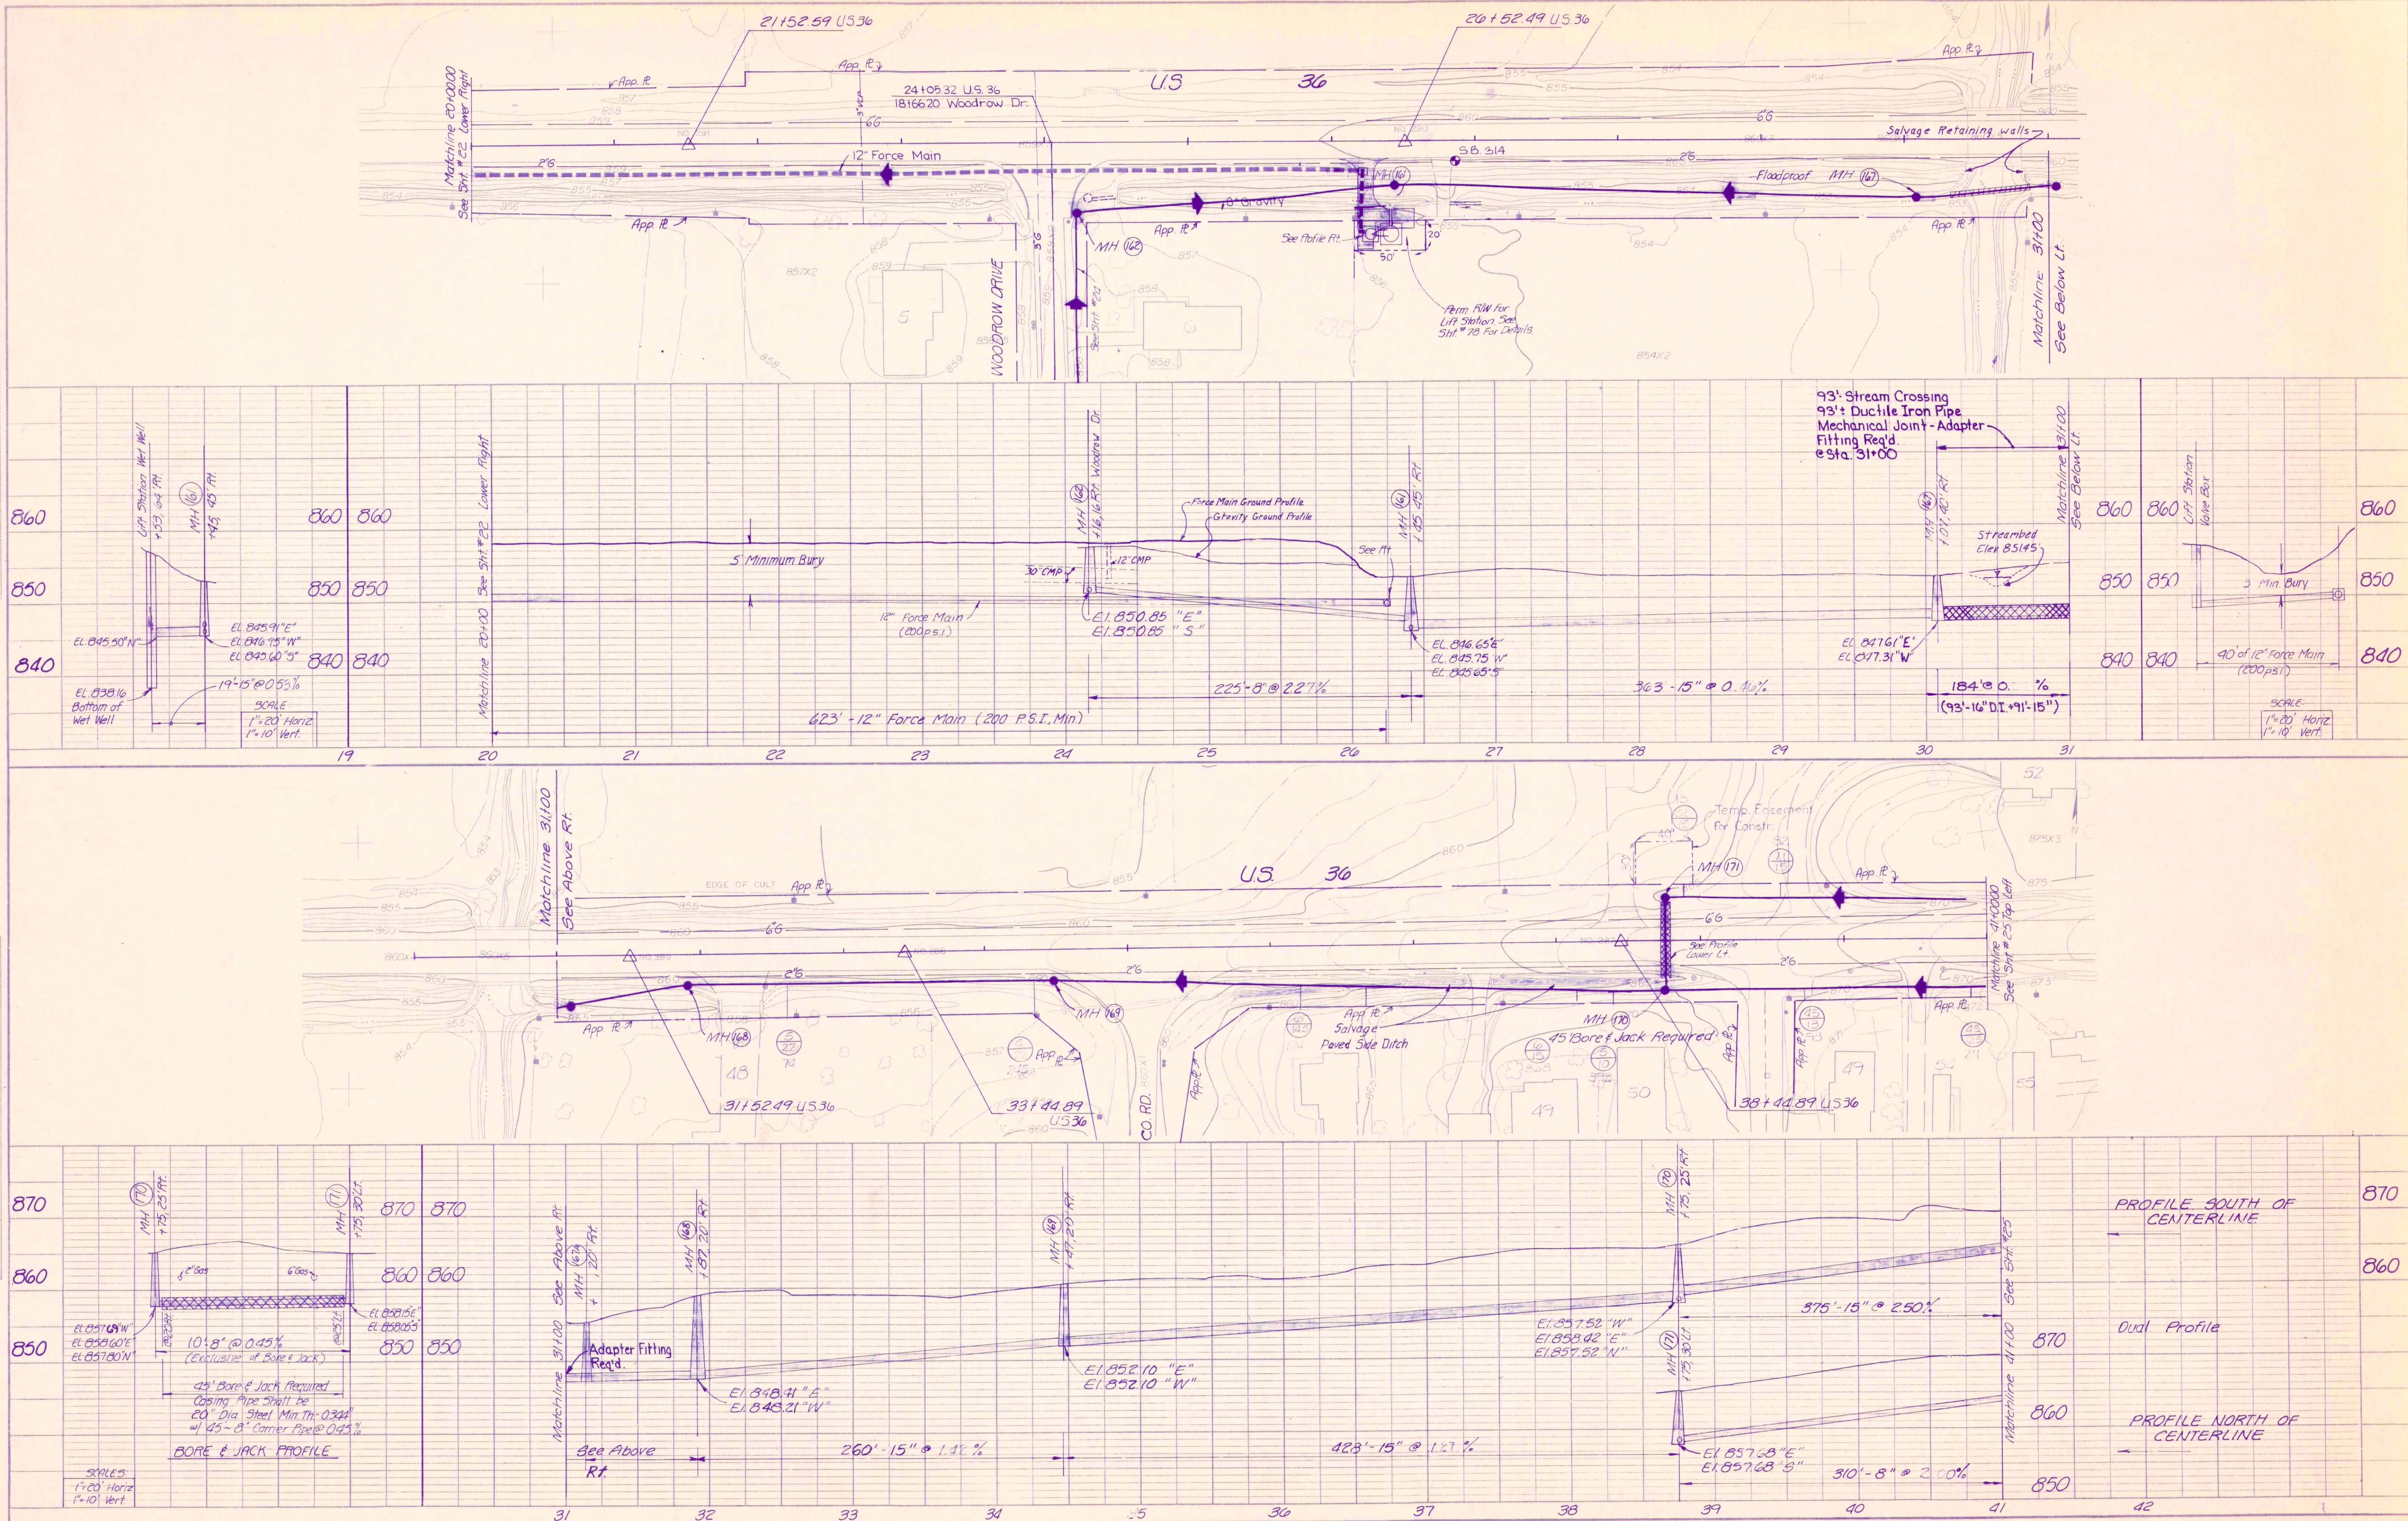

RECORD DRAWING