


PLAN	DATE
PROJECT: FALL CREEK R.W.D. PLAN & PROFILE	DATE: 10/1/2010
NOTED: BEAM, LONGEST & NEFF, INC.	
NO. 1	

PROFILE	DATE
PROJECT: FALL CREEK R.W.D. PLAN & PROFILE	DATE: 10/1/2010
NOTED: BEAM, LONGEST & NEFF, INC.	
NO. 1	

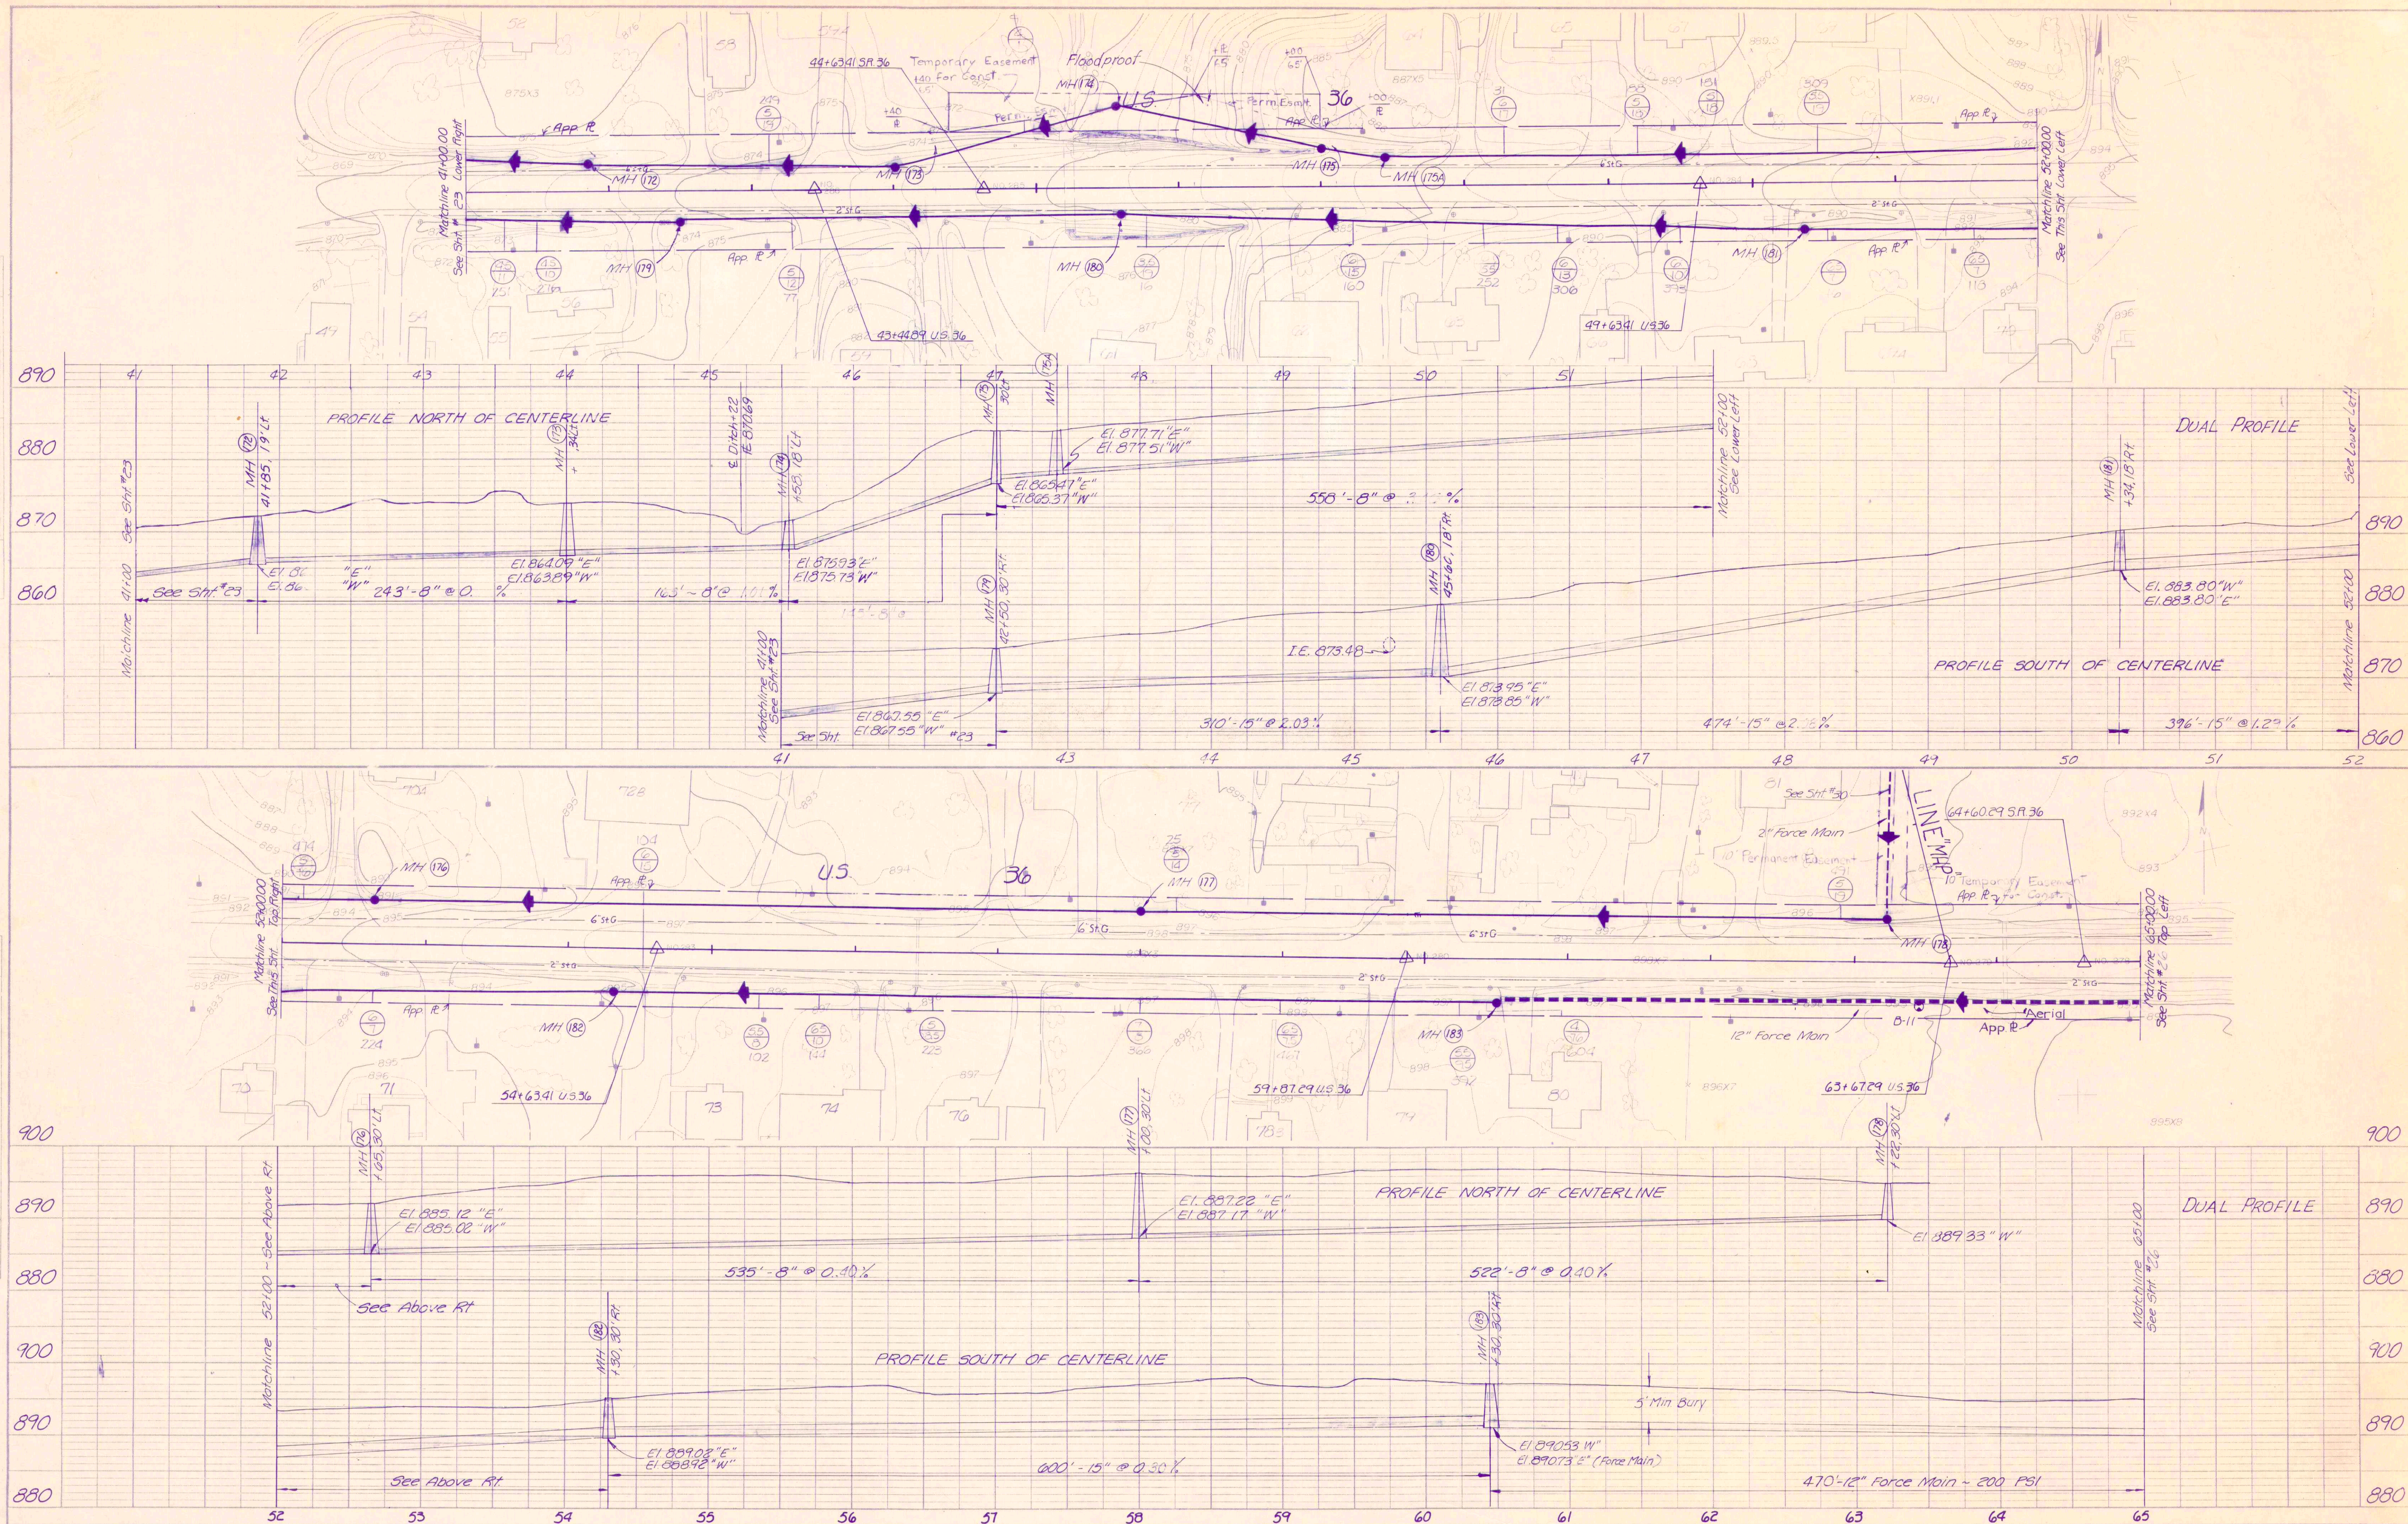

RECORD DRAWING