


PLAN	SURVEYED	BY	DATE
	NOTED	BY	DATE
	NOTED	BY	DATE
	NOTED	BY	DATE

PROFILE	SURVEYED	BY	DATE
	NOTED	BY	DATE
	NOTED	BY	DATE
	NOTED	BY	DATE

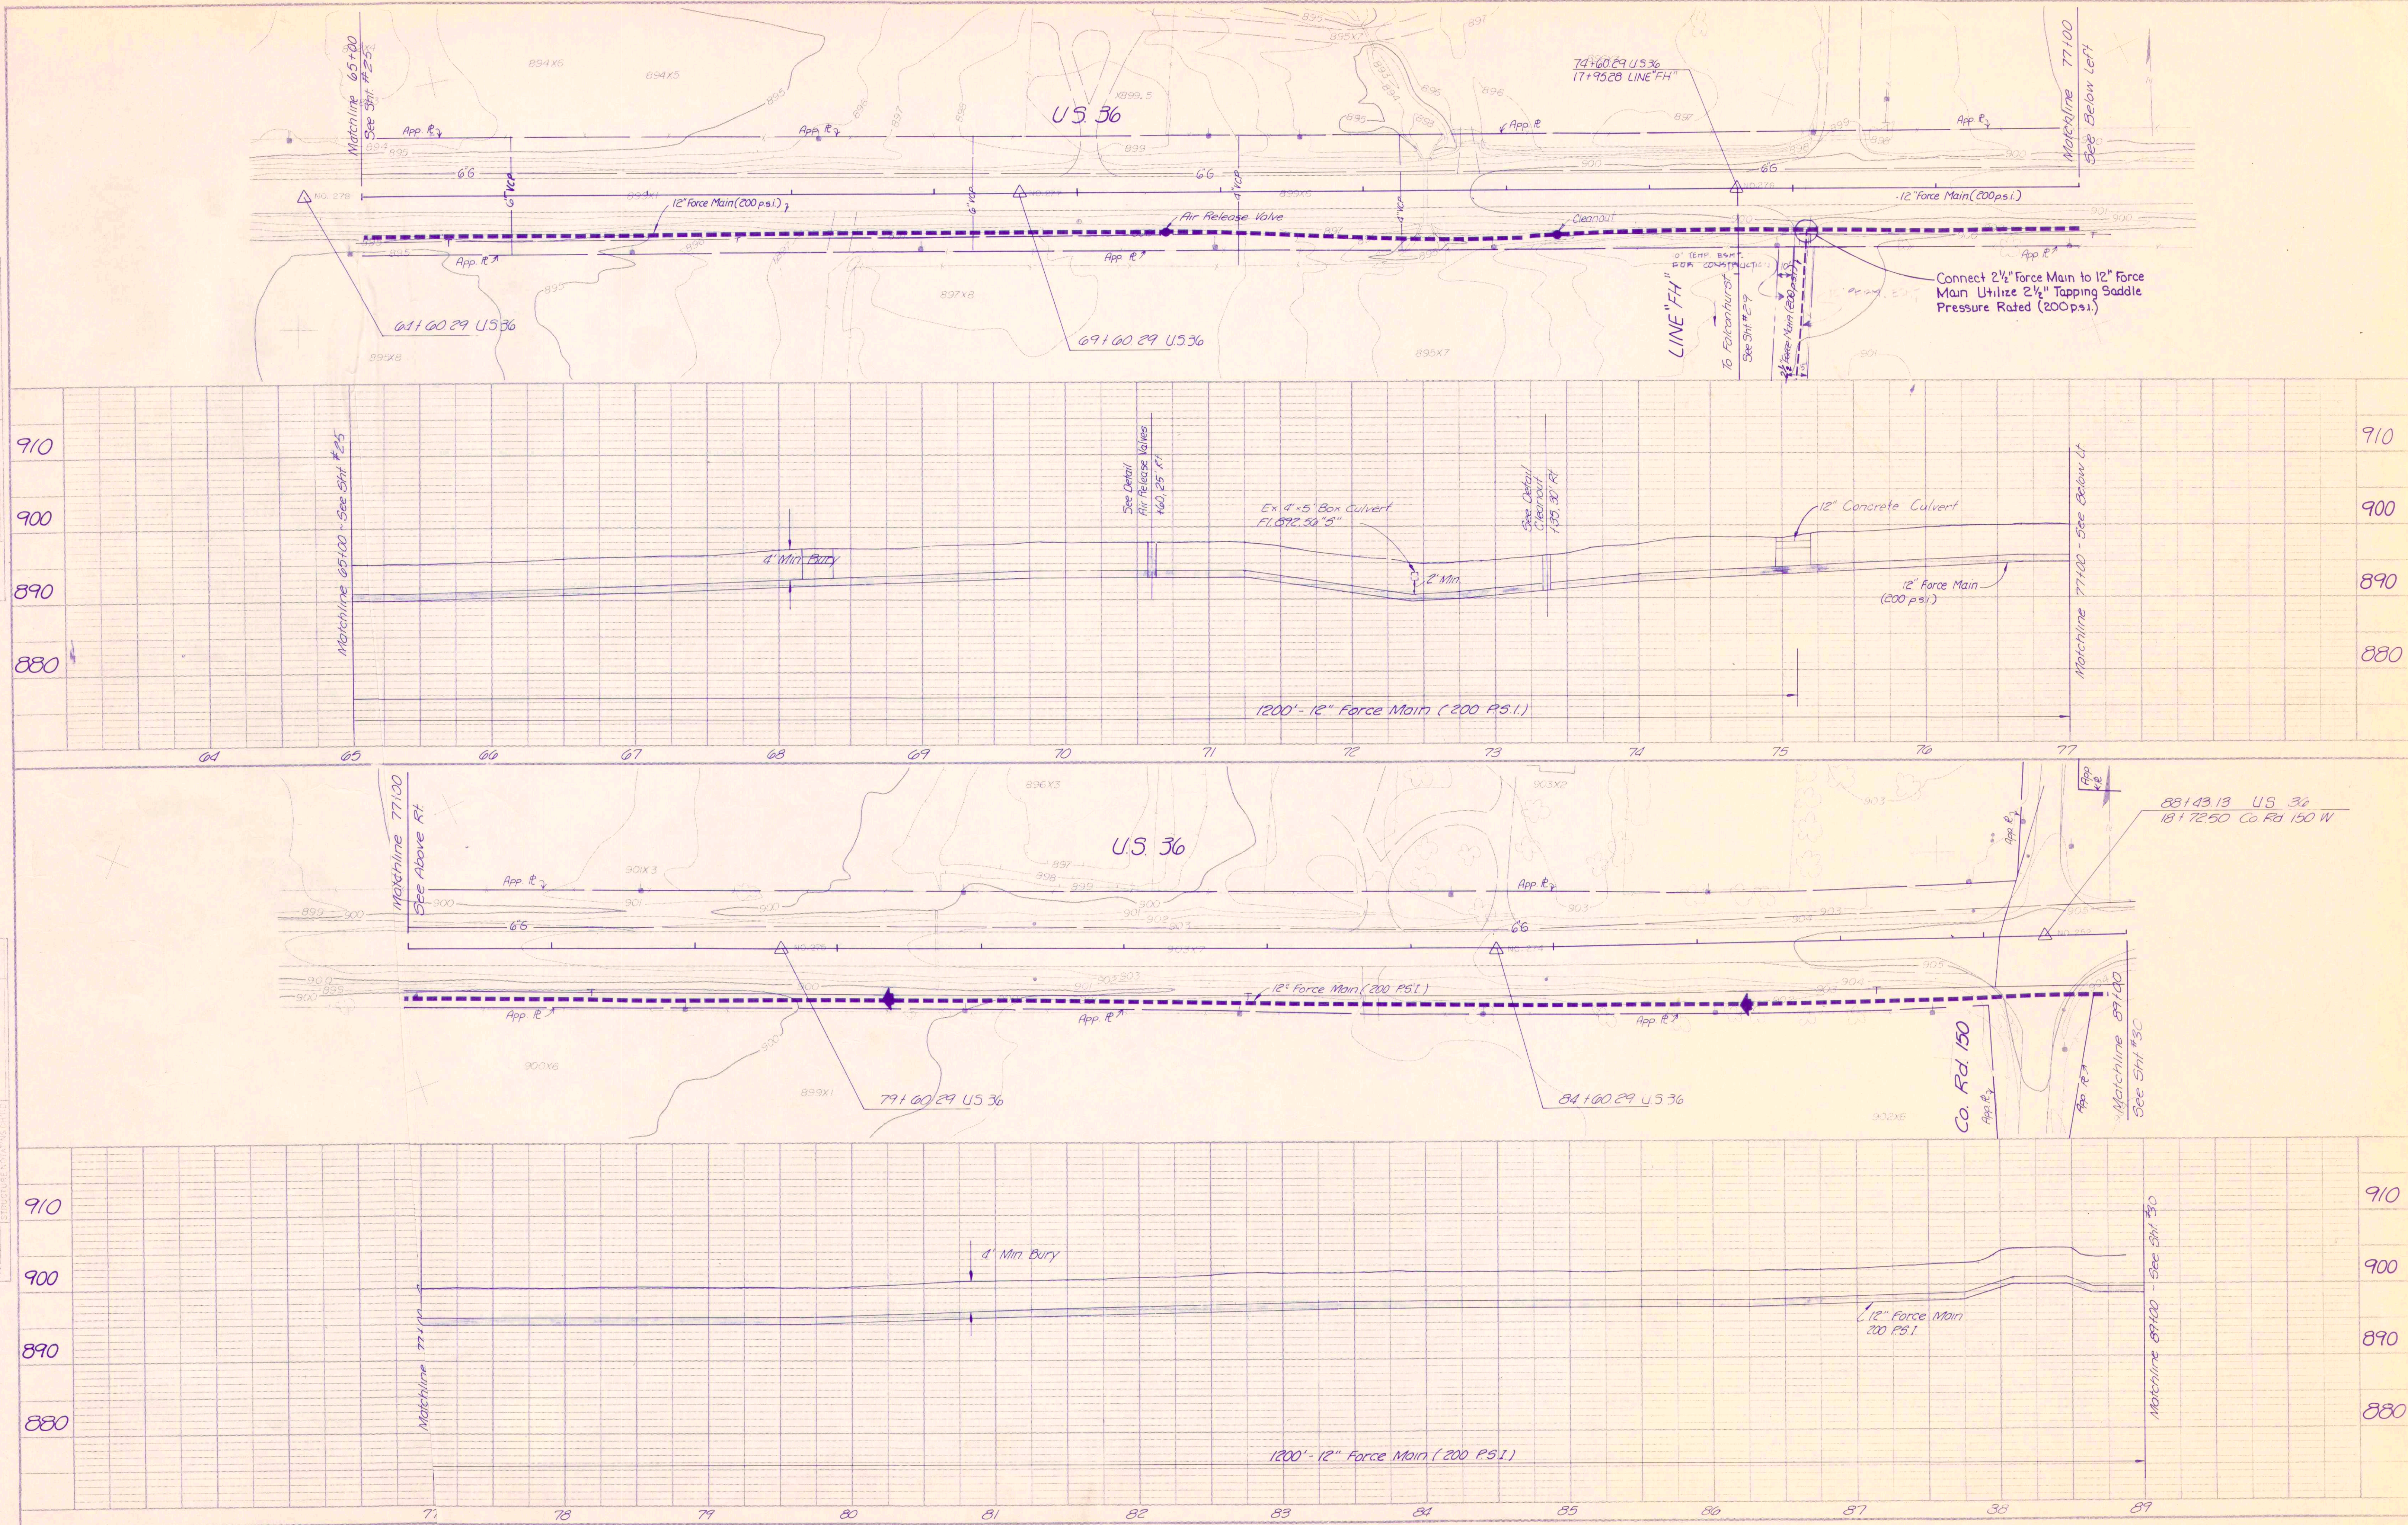

RECORD DRAWING

U.S. 36	
FALL CREEK R.W.D. PLAN & PROFILE SHEET	
HORIZ. 1"=50'	BEAM, LONGEST & NEFF, INC.
VERT. 1"=10'	CONSULTING ENGINEERS
	INDIANAPOLIS, INDIANA