
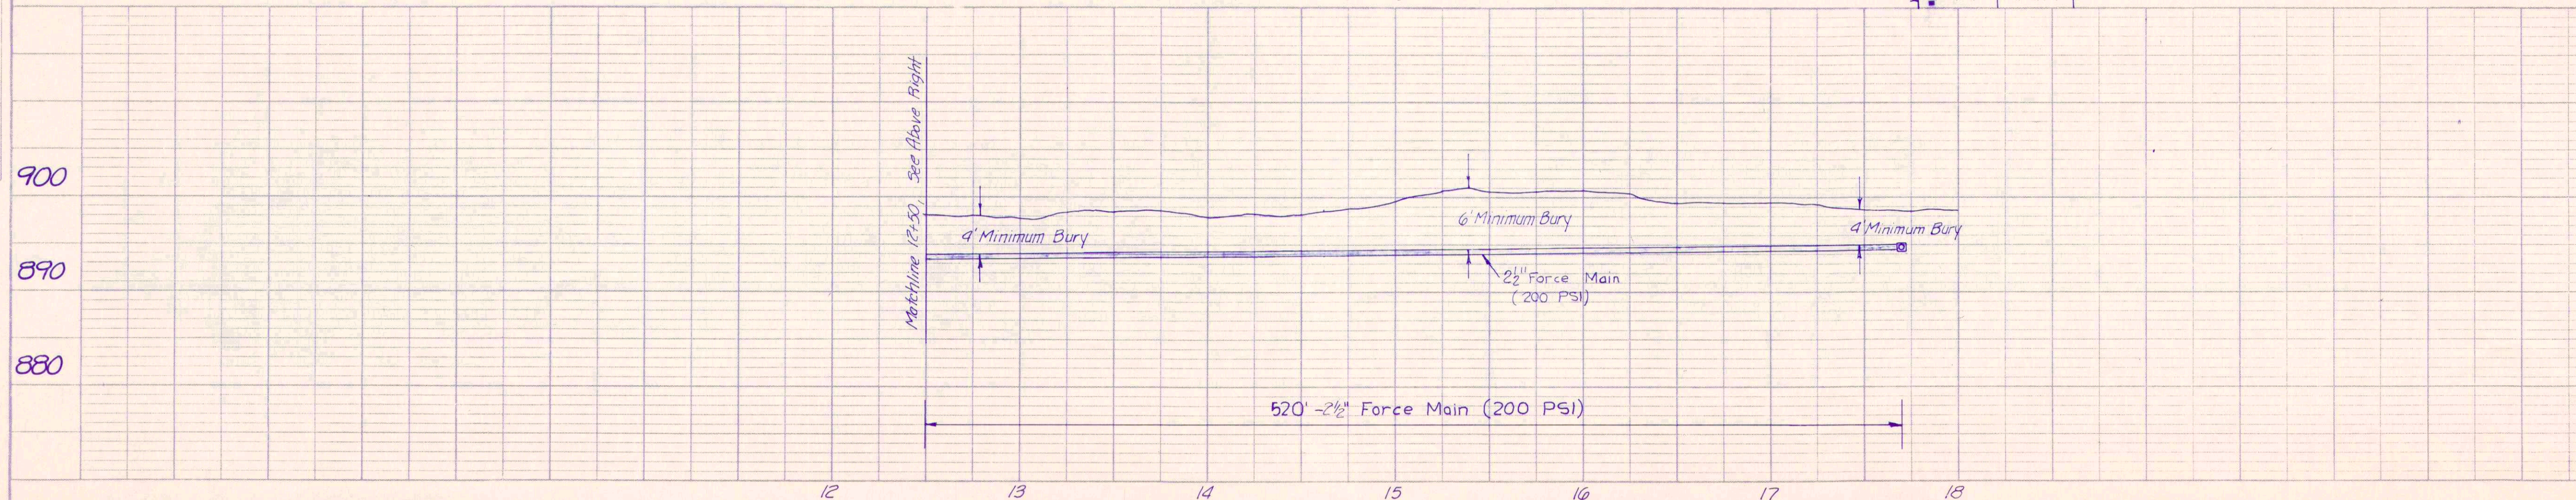
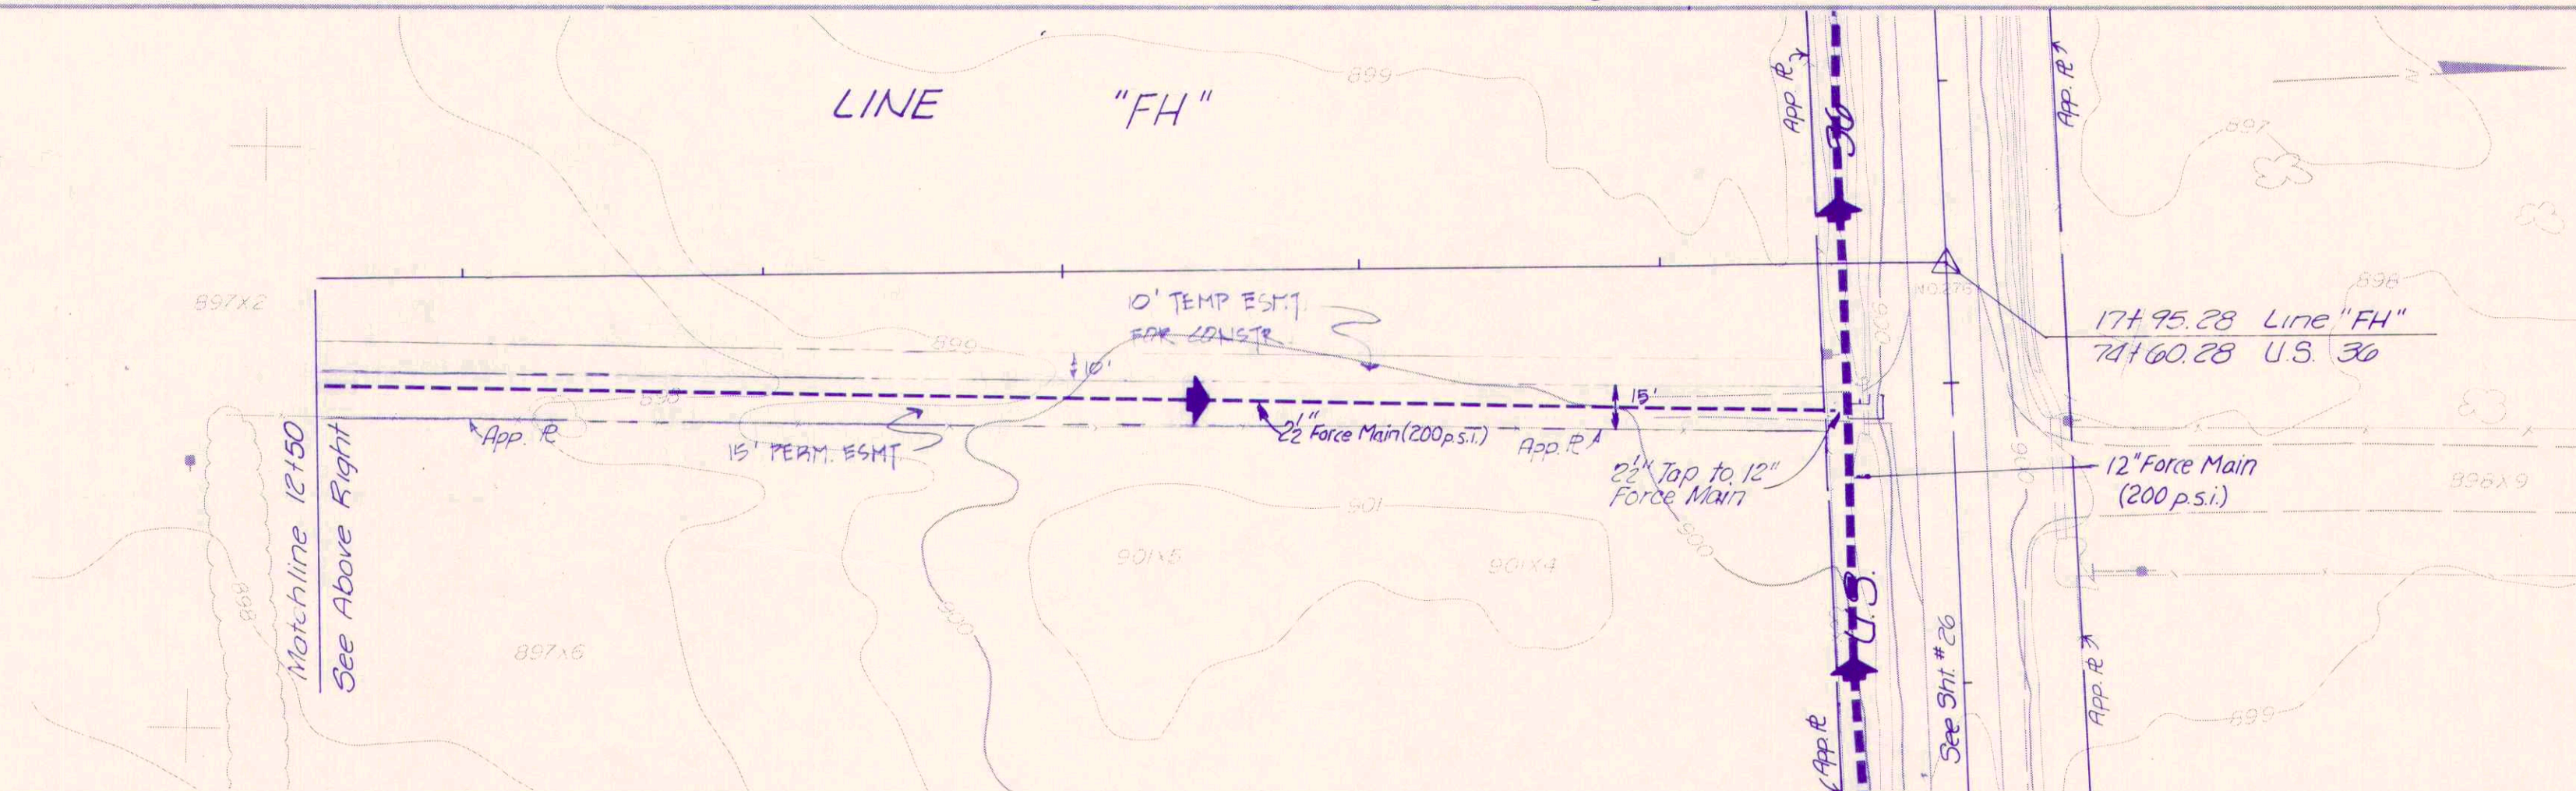
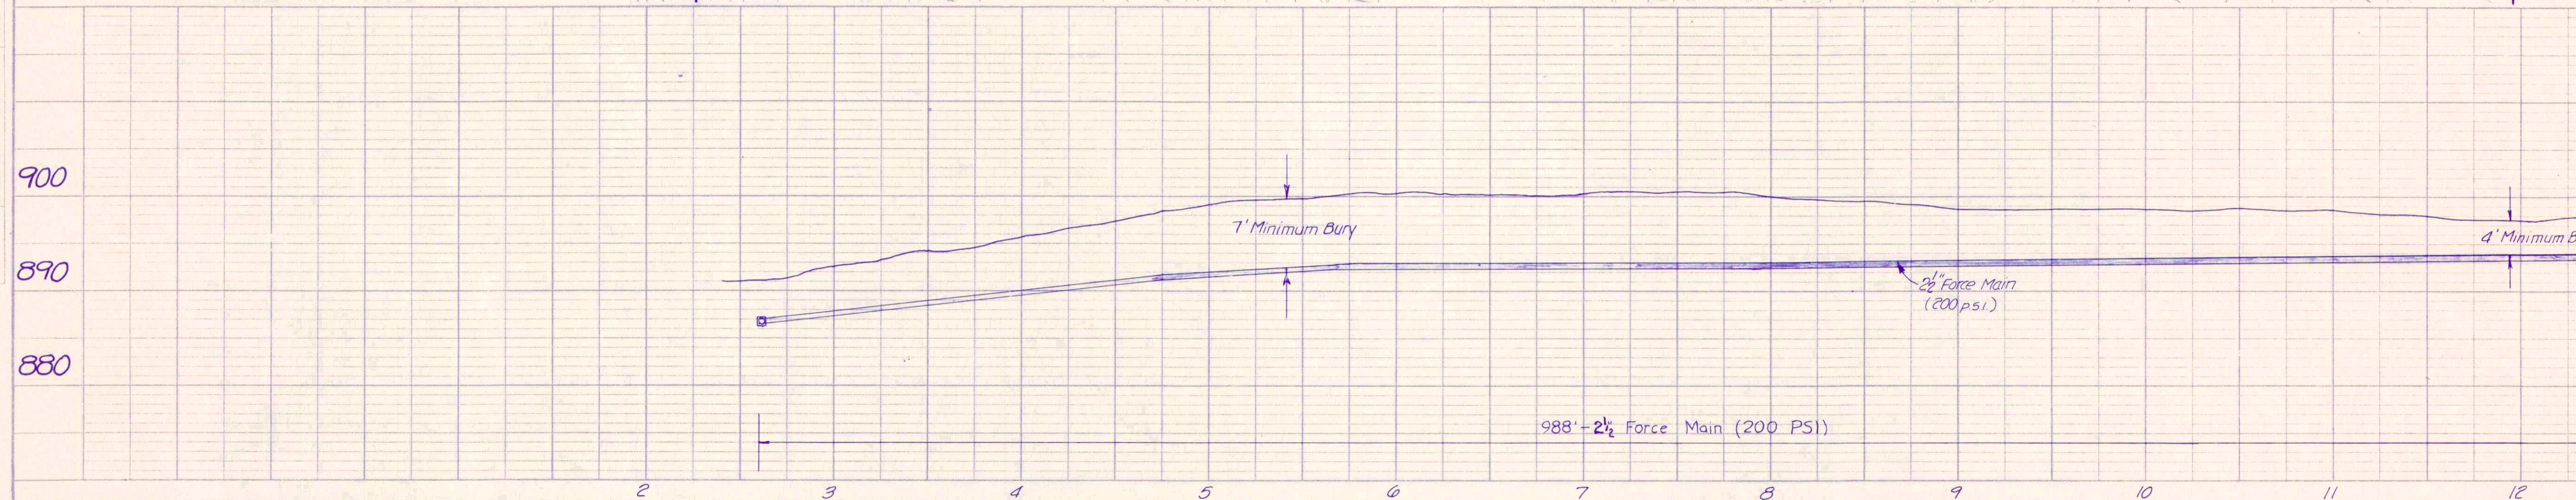


PLAN	DATE	
	DESIGNED BY	
	CHECKED BY	
	NO.	

PROFILE	DATE	
	DESIGNED BY	
	CHECKED BY	
	NO.	

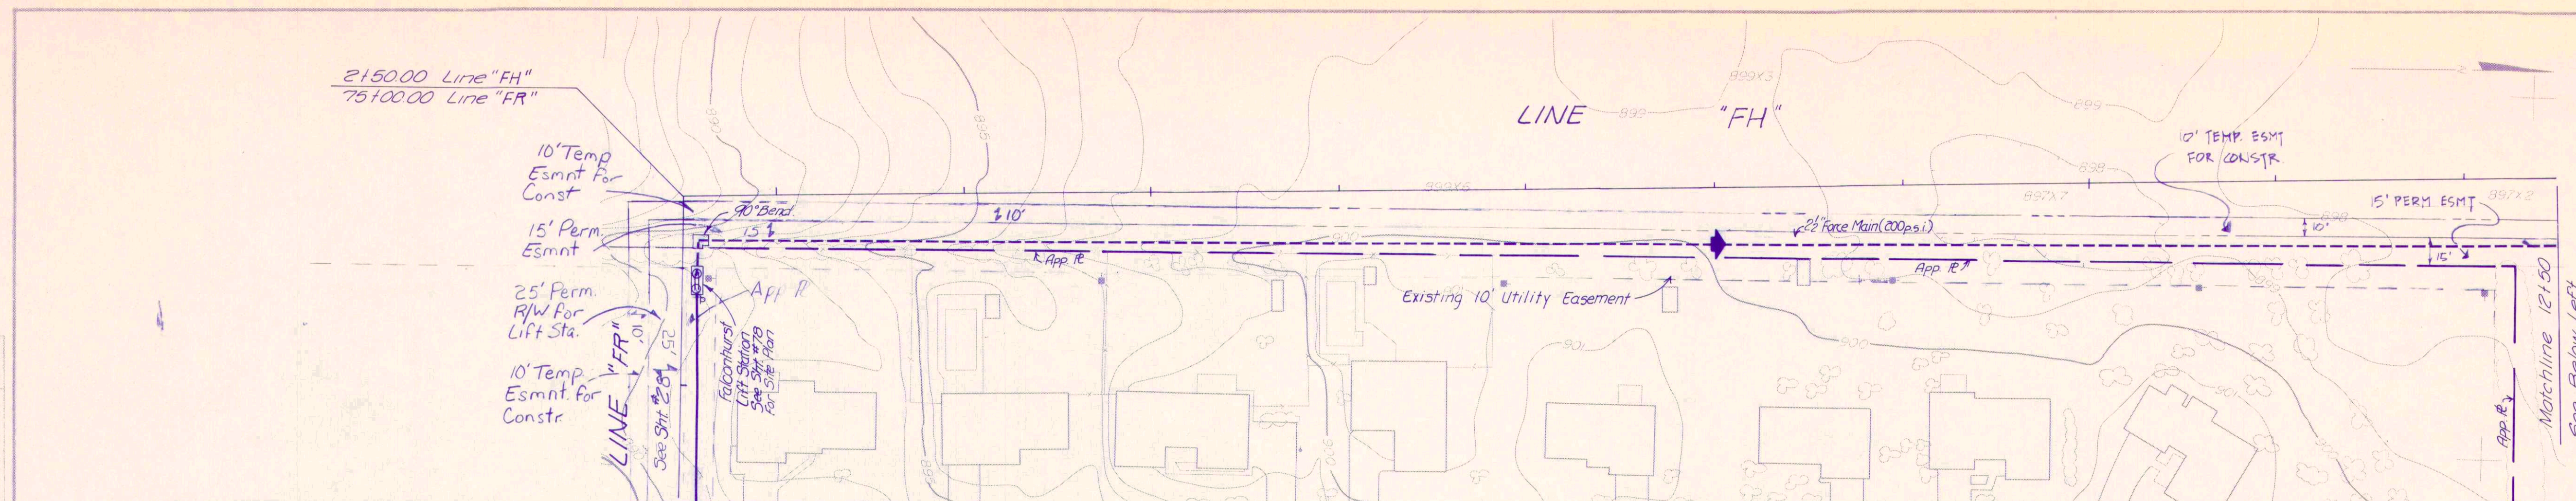

RECORD DRAWING