


PLAN  
NO. 108  
DATE: 10/10/00  
BY: [Signature]  
CHECKED: [Signature]  
NOTED: [Signature]  
REVISIONS: [Signature]

PROFILE  
NO. 108  
DATE: 10/10/00  
BY: [Signature]  
CHECKED: [Signature]  
NOTED: [Signature]  
REVISIONS: [Signature]

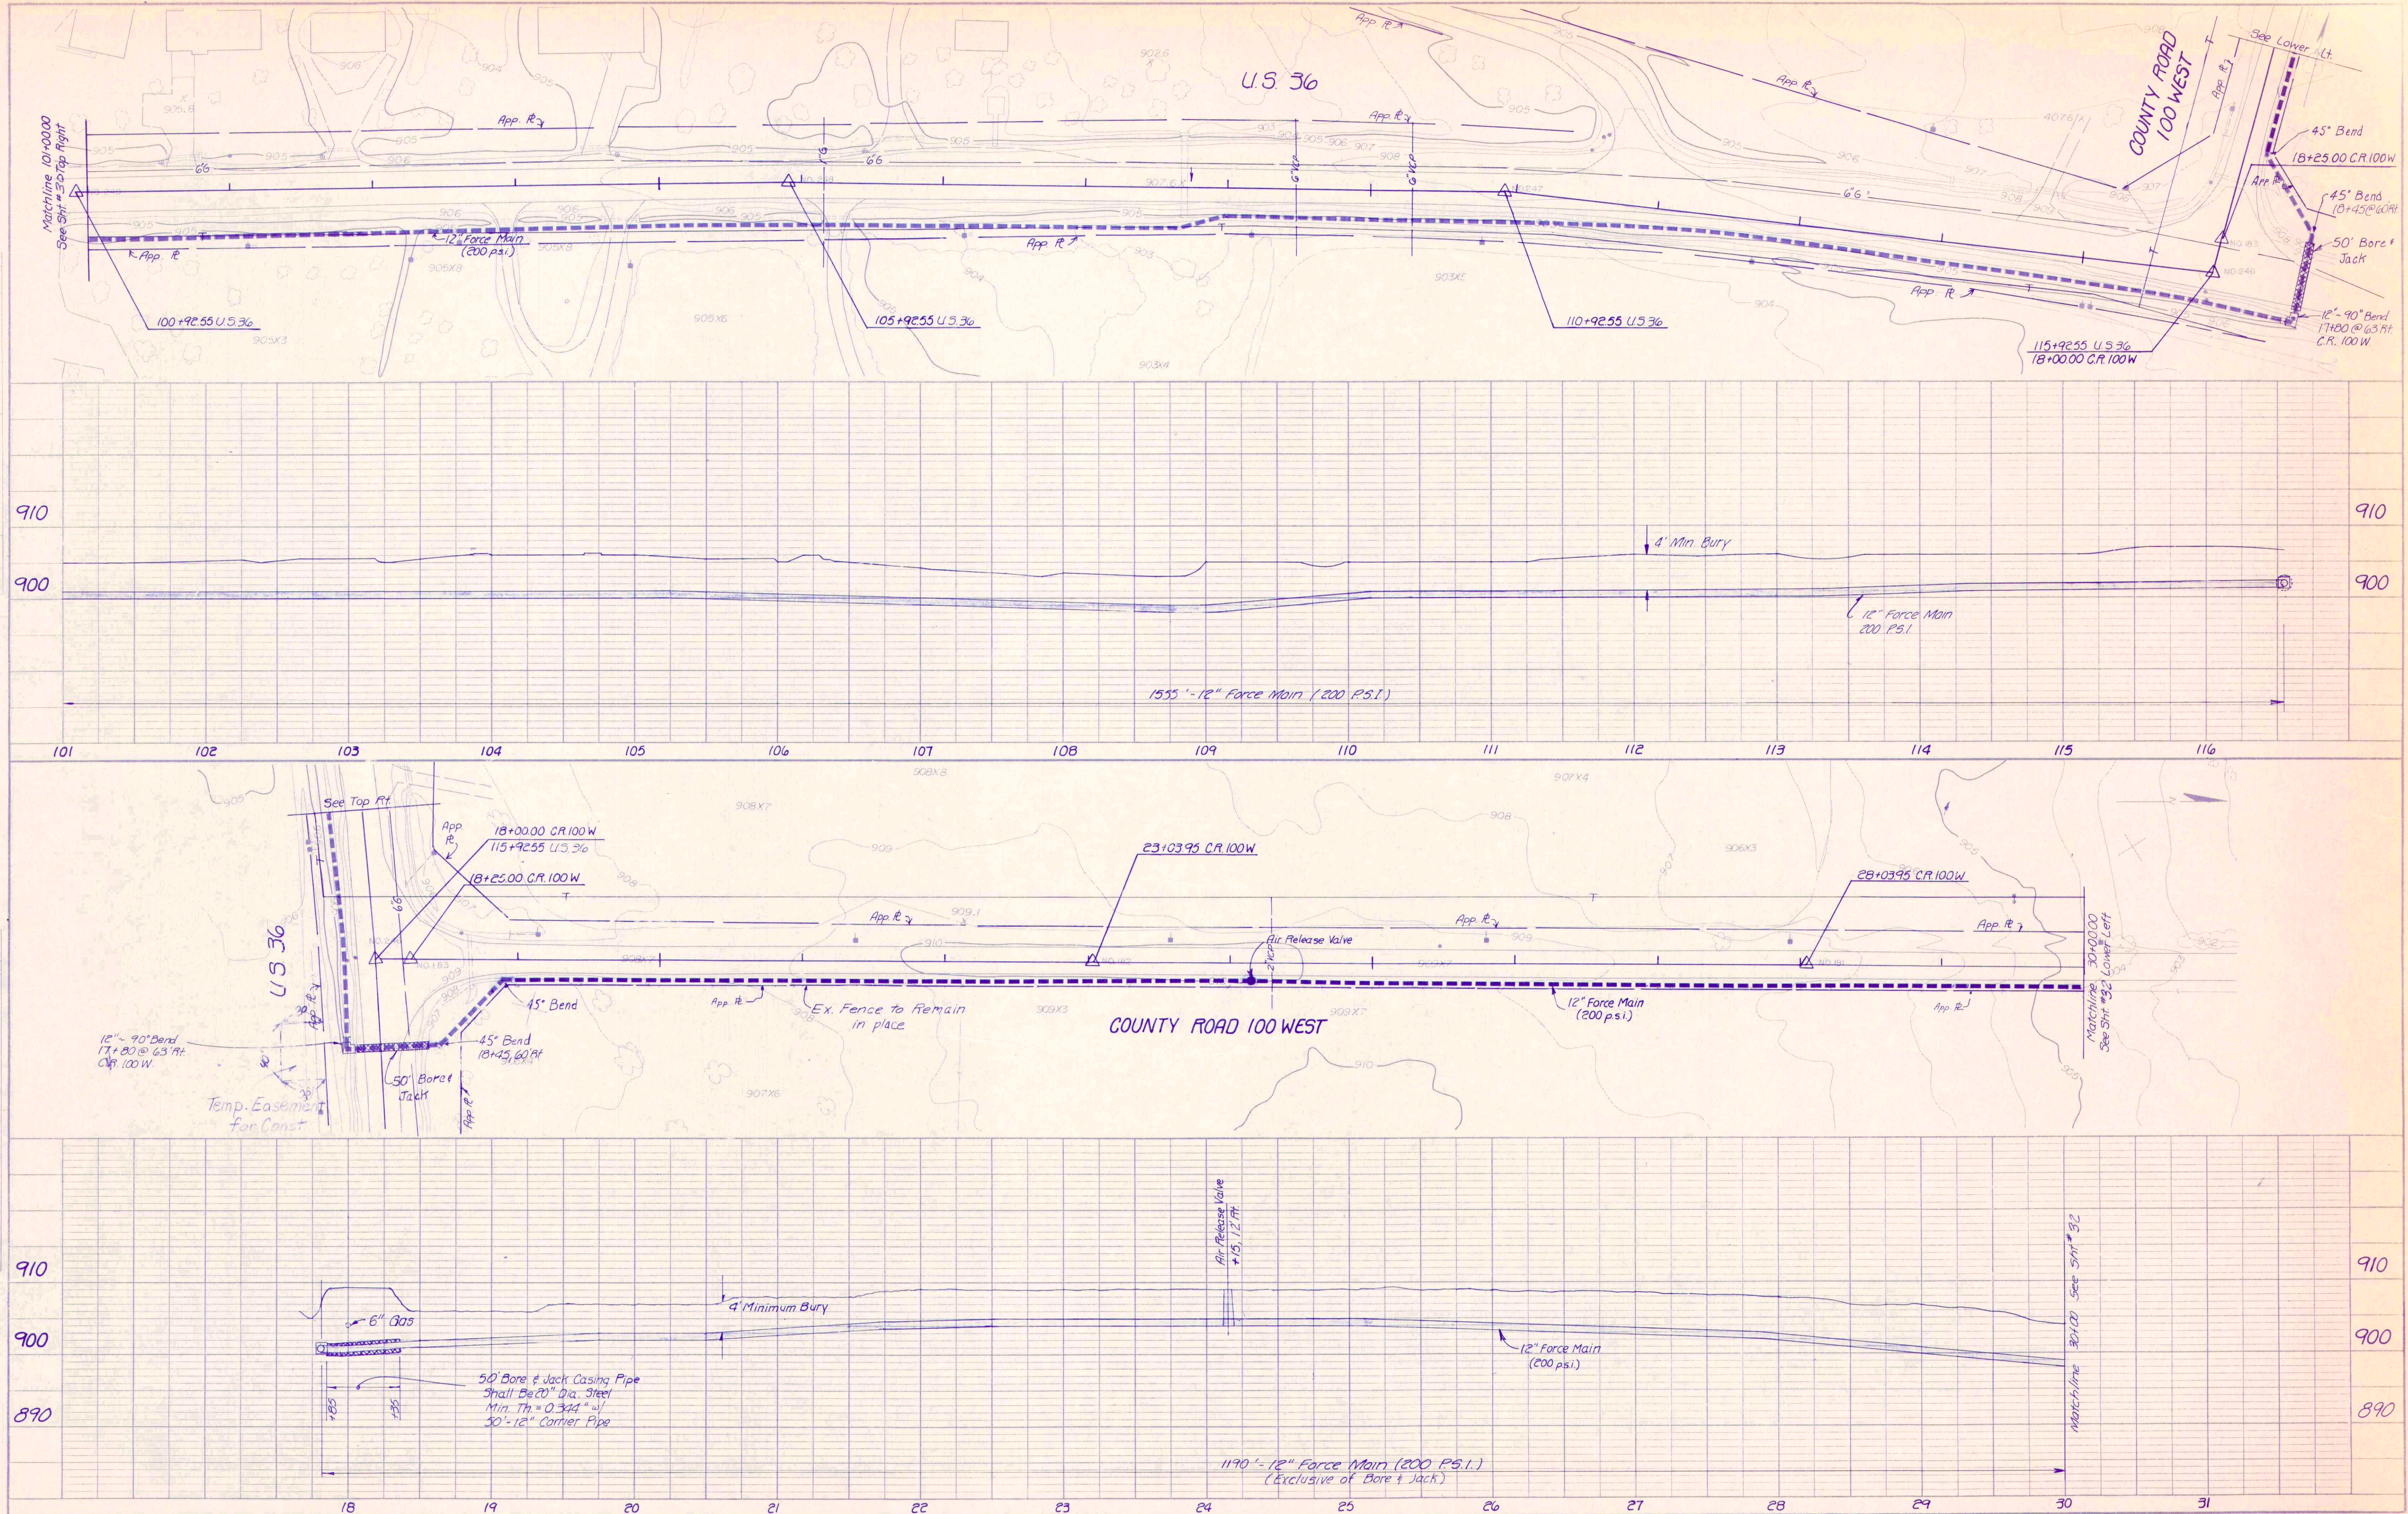

RECORD DRAWING

U.S. 36 / Co. Rd. 100 WEST  
FALL CREEK R.W.D. PLAN & PROFILE SHEET  
HORIZ. 1"=50' BEAM, LONGEST & NEFF, INC.  
VERT. 1"=10' CONSULTING ENGINEERS  
INDIANAPOLIS, INDIANA 31