


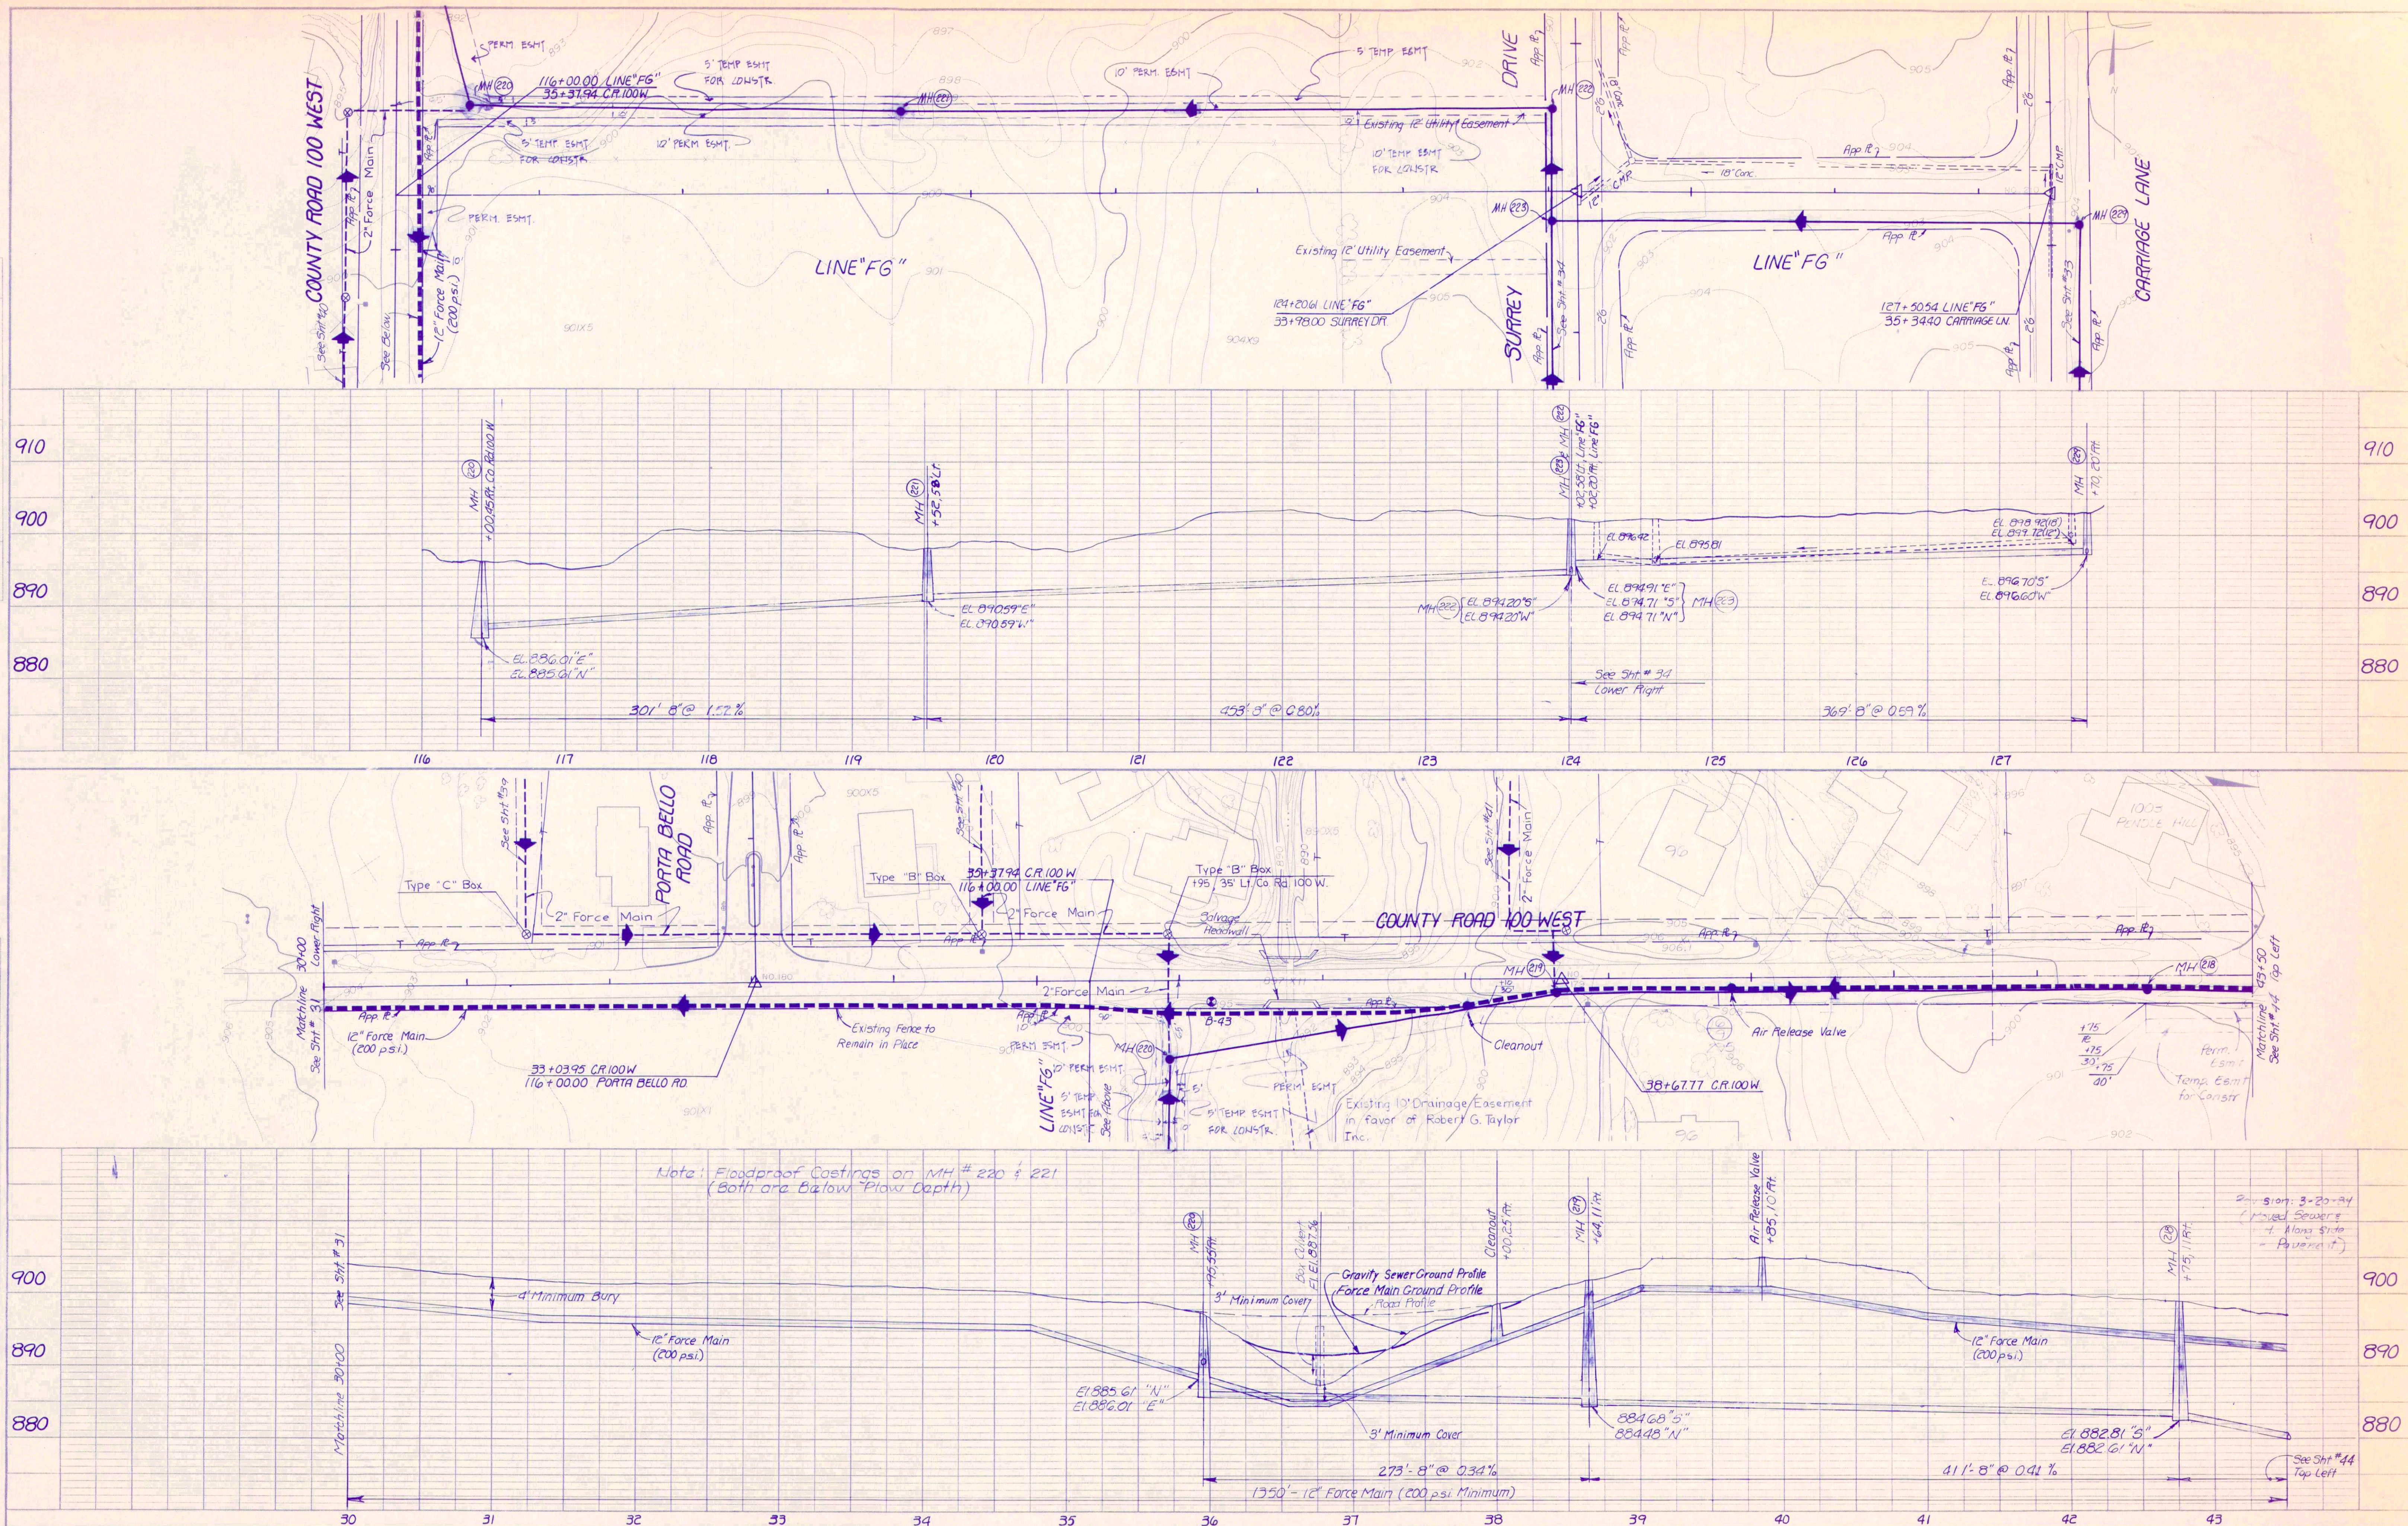

RECORD DRAWING

LINE "FG" Co. Rd. 100 WEST

FALL CREEK R.W.D. PLAN & PROFILE		SHEET
HORIZ. 1"=50'	BEAM, LONGEST & NEFF, INC. CONSULTING ENGINEERS	32
VERT. 1"=10'	INDIANAPOLIS, INDIANA	

32