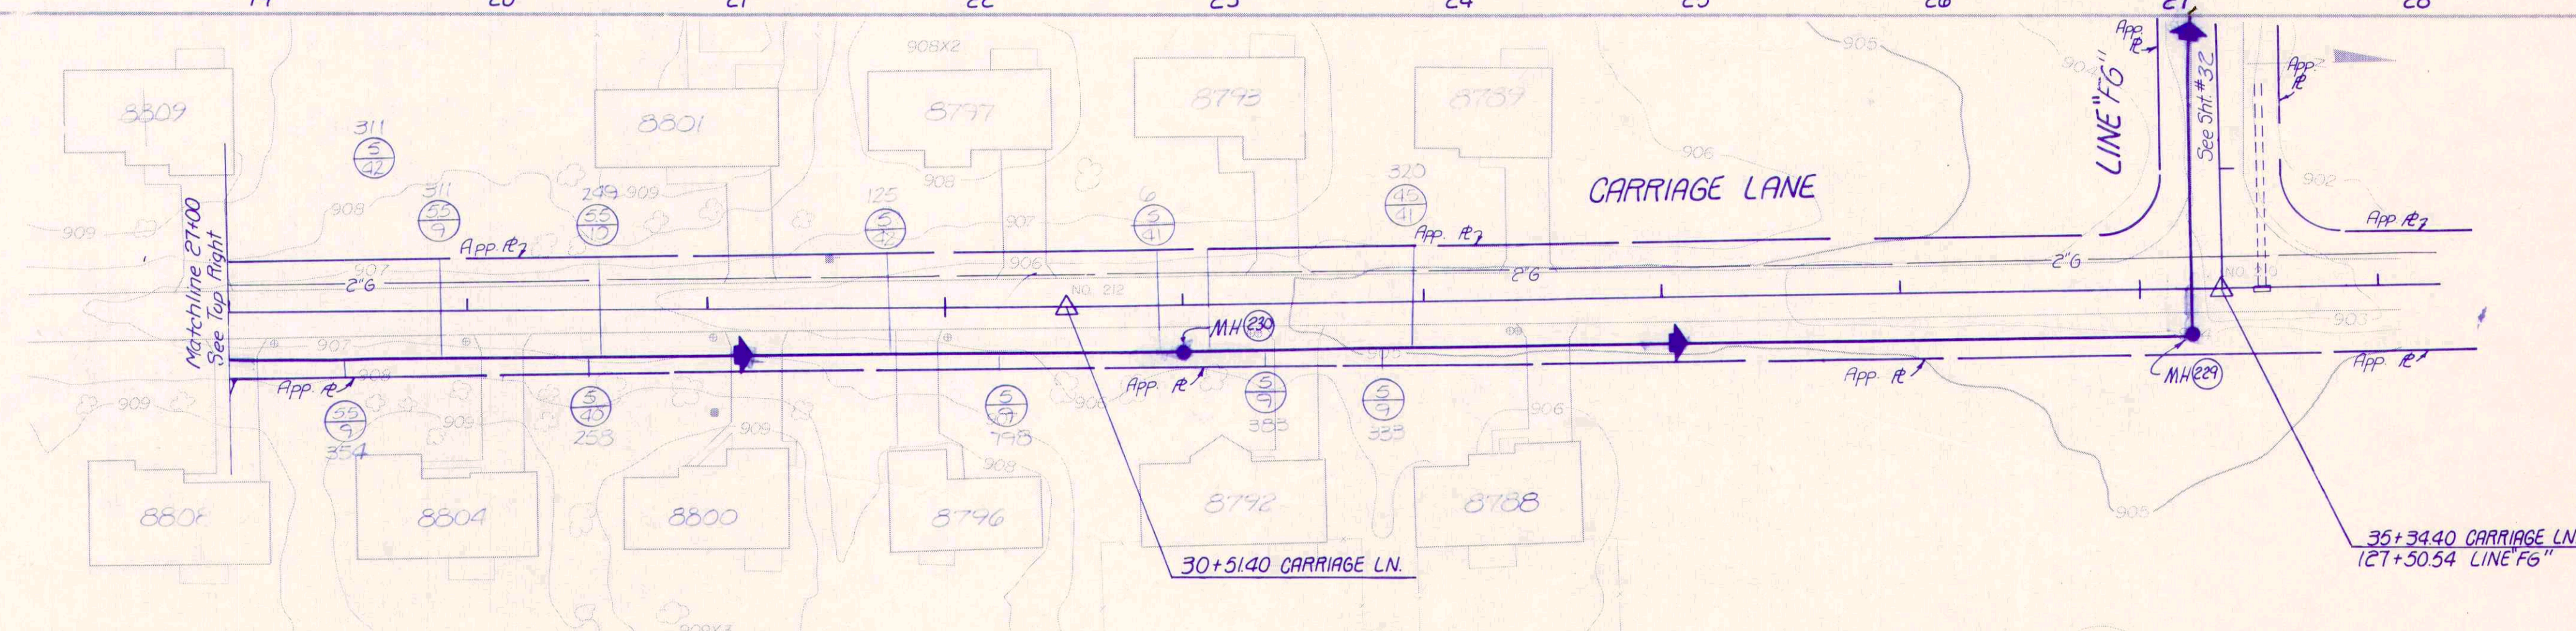
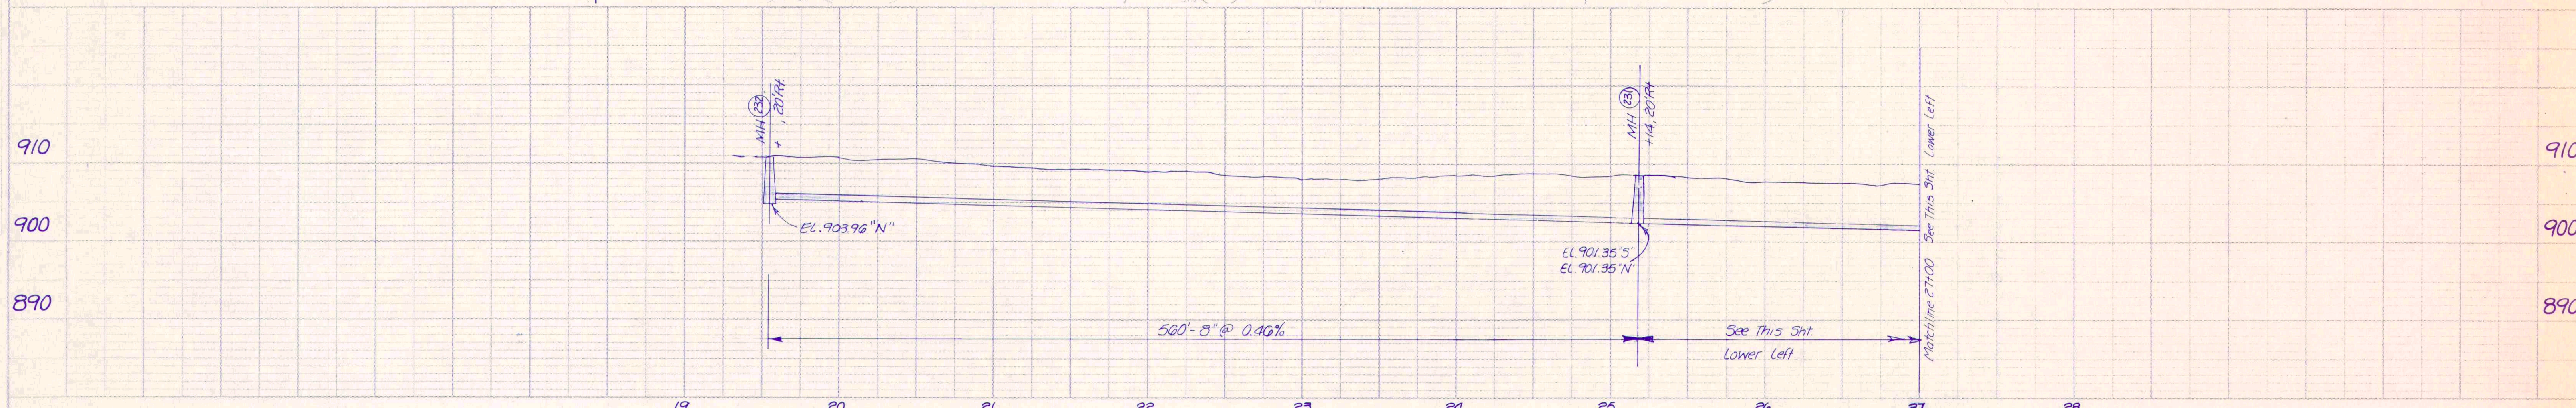
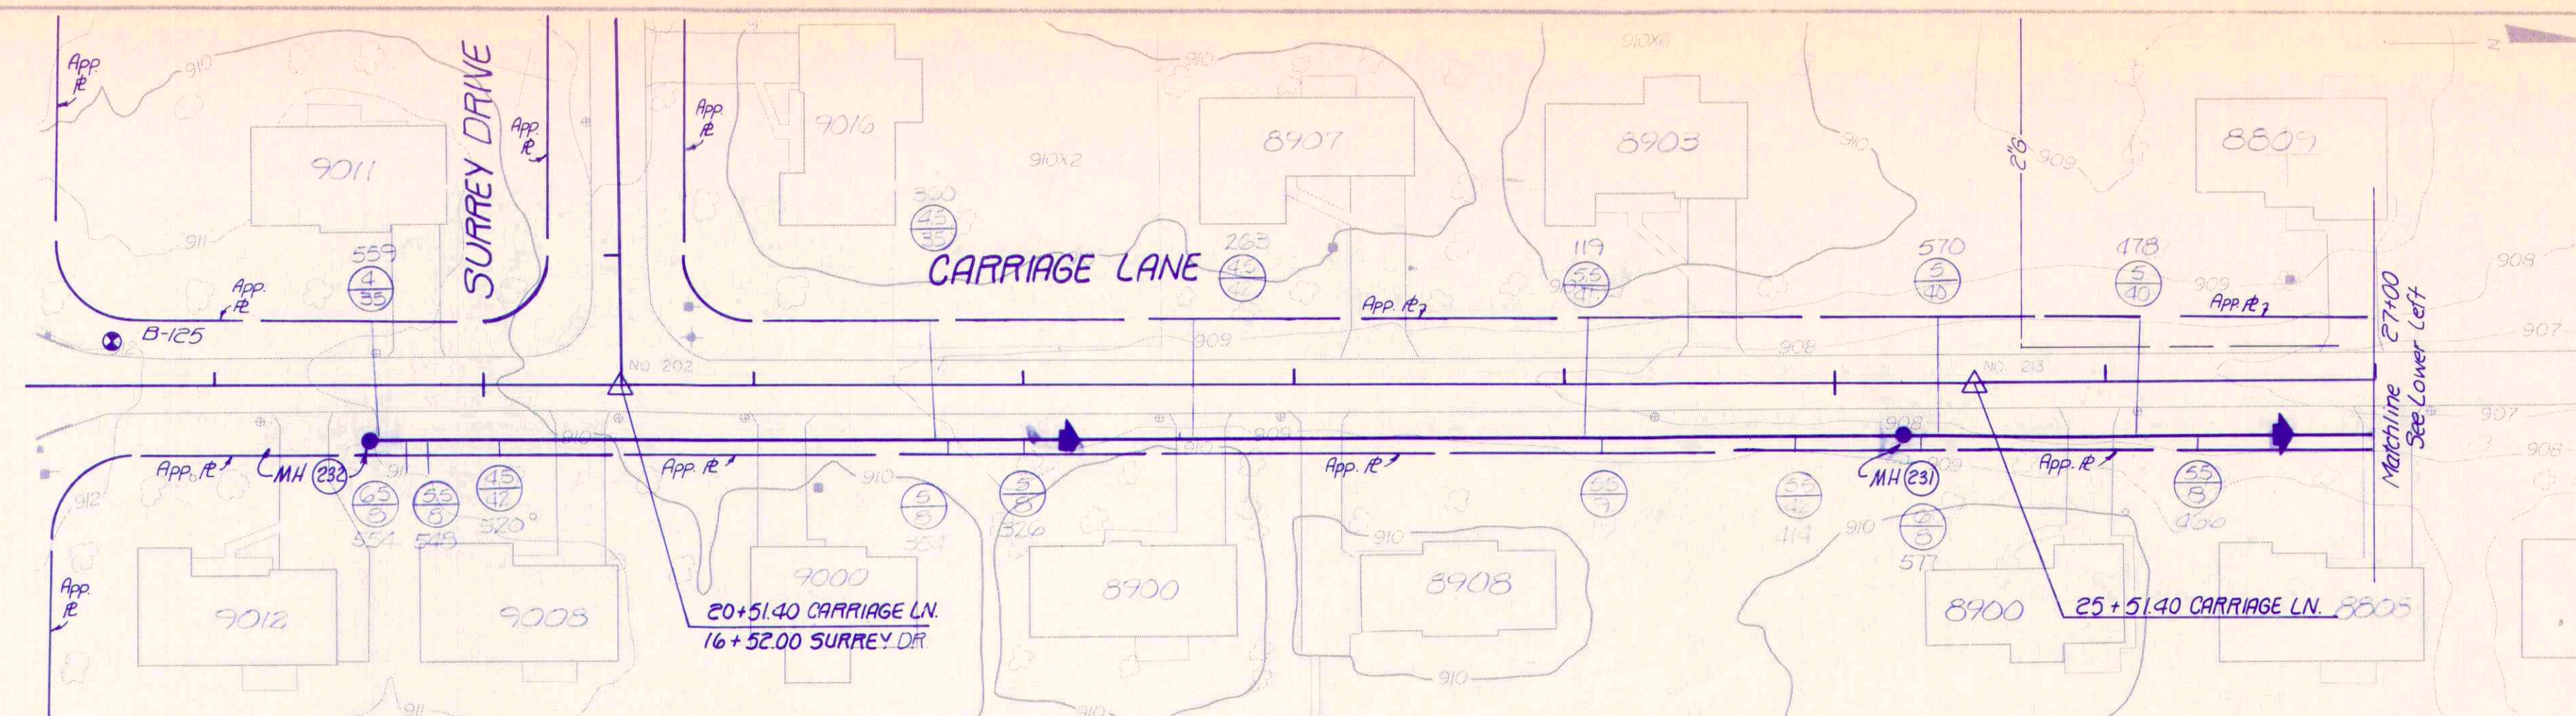


RECORD DRAWING

CARRIAGE LANE			SHEET
FALL CREEK R.W.D. PLAN & PROFILE			33
HORIZ. 1"=50'	BEAM, LONGEST & NEFF, INC.		
VERT. 1"=10'	CONSULTING ENGINEERS		
	INDIANAPOLIS, INDIANA		