
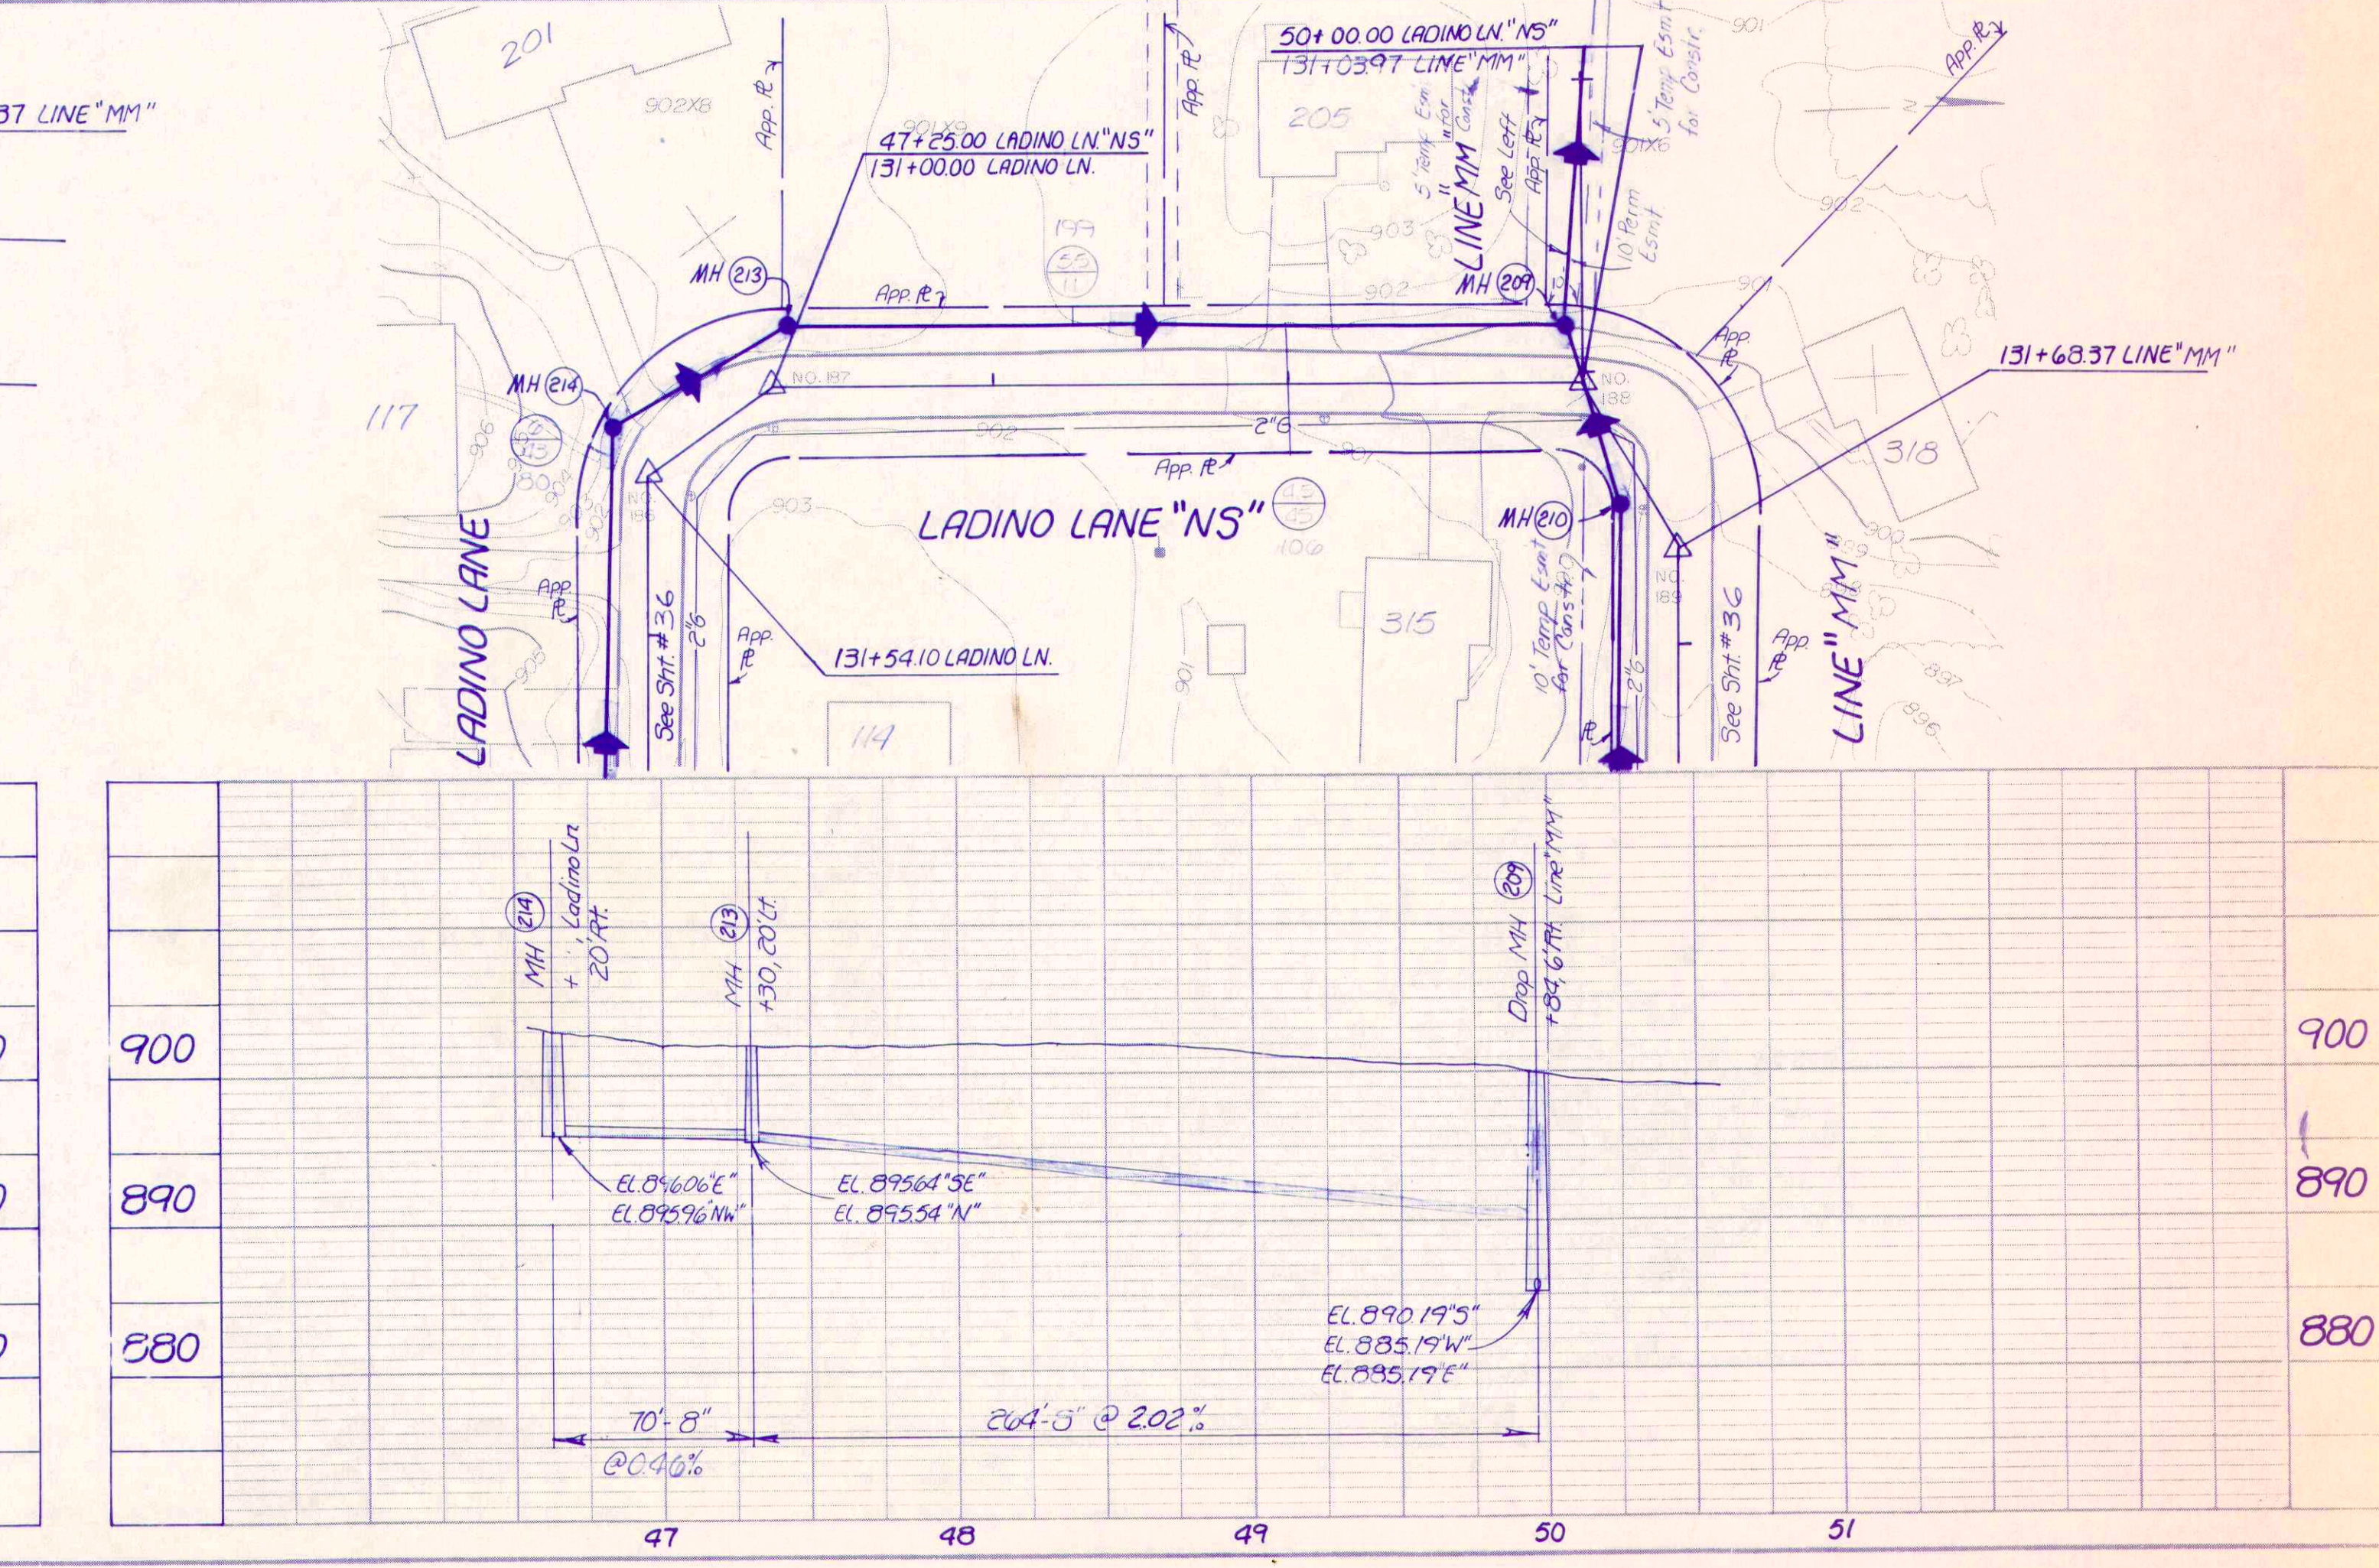
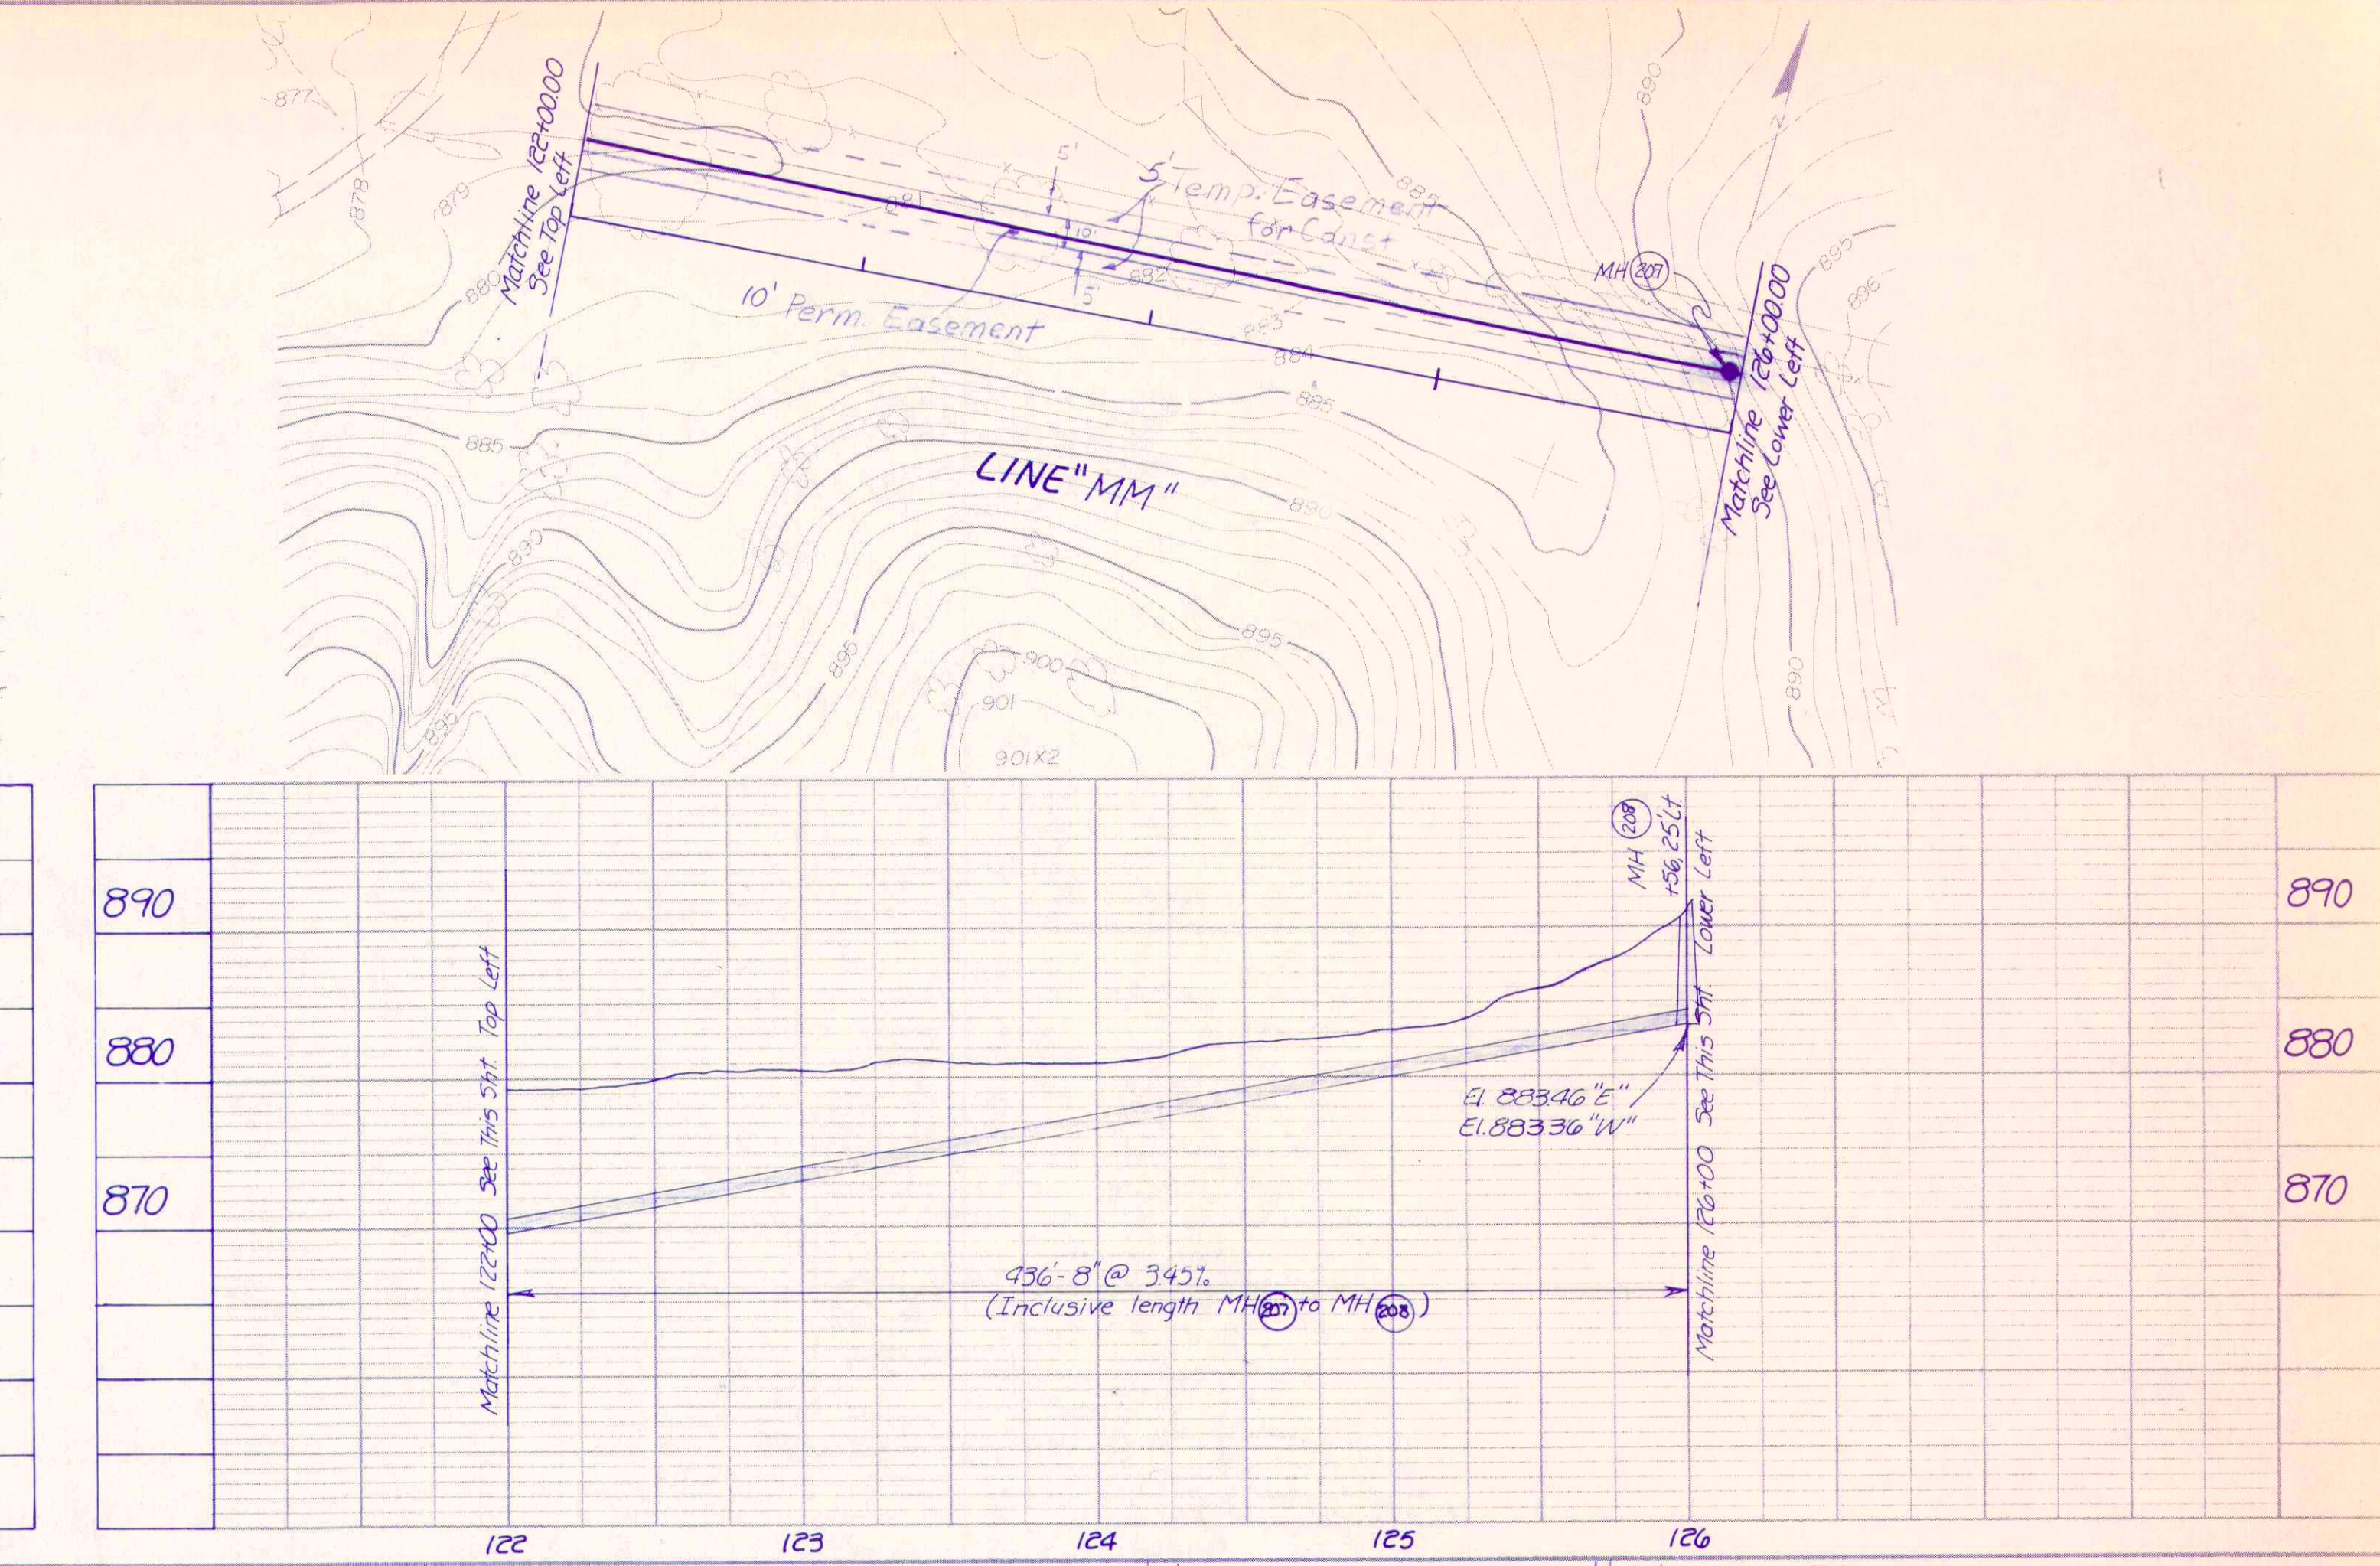
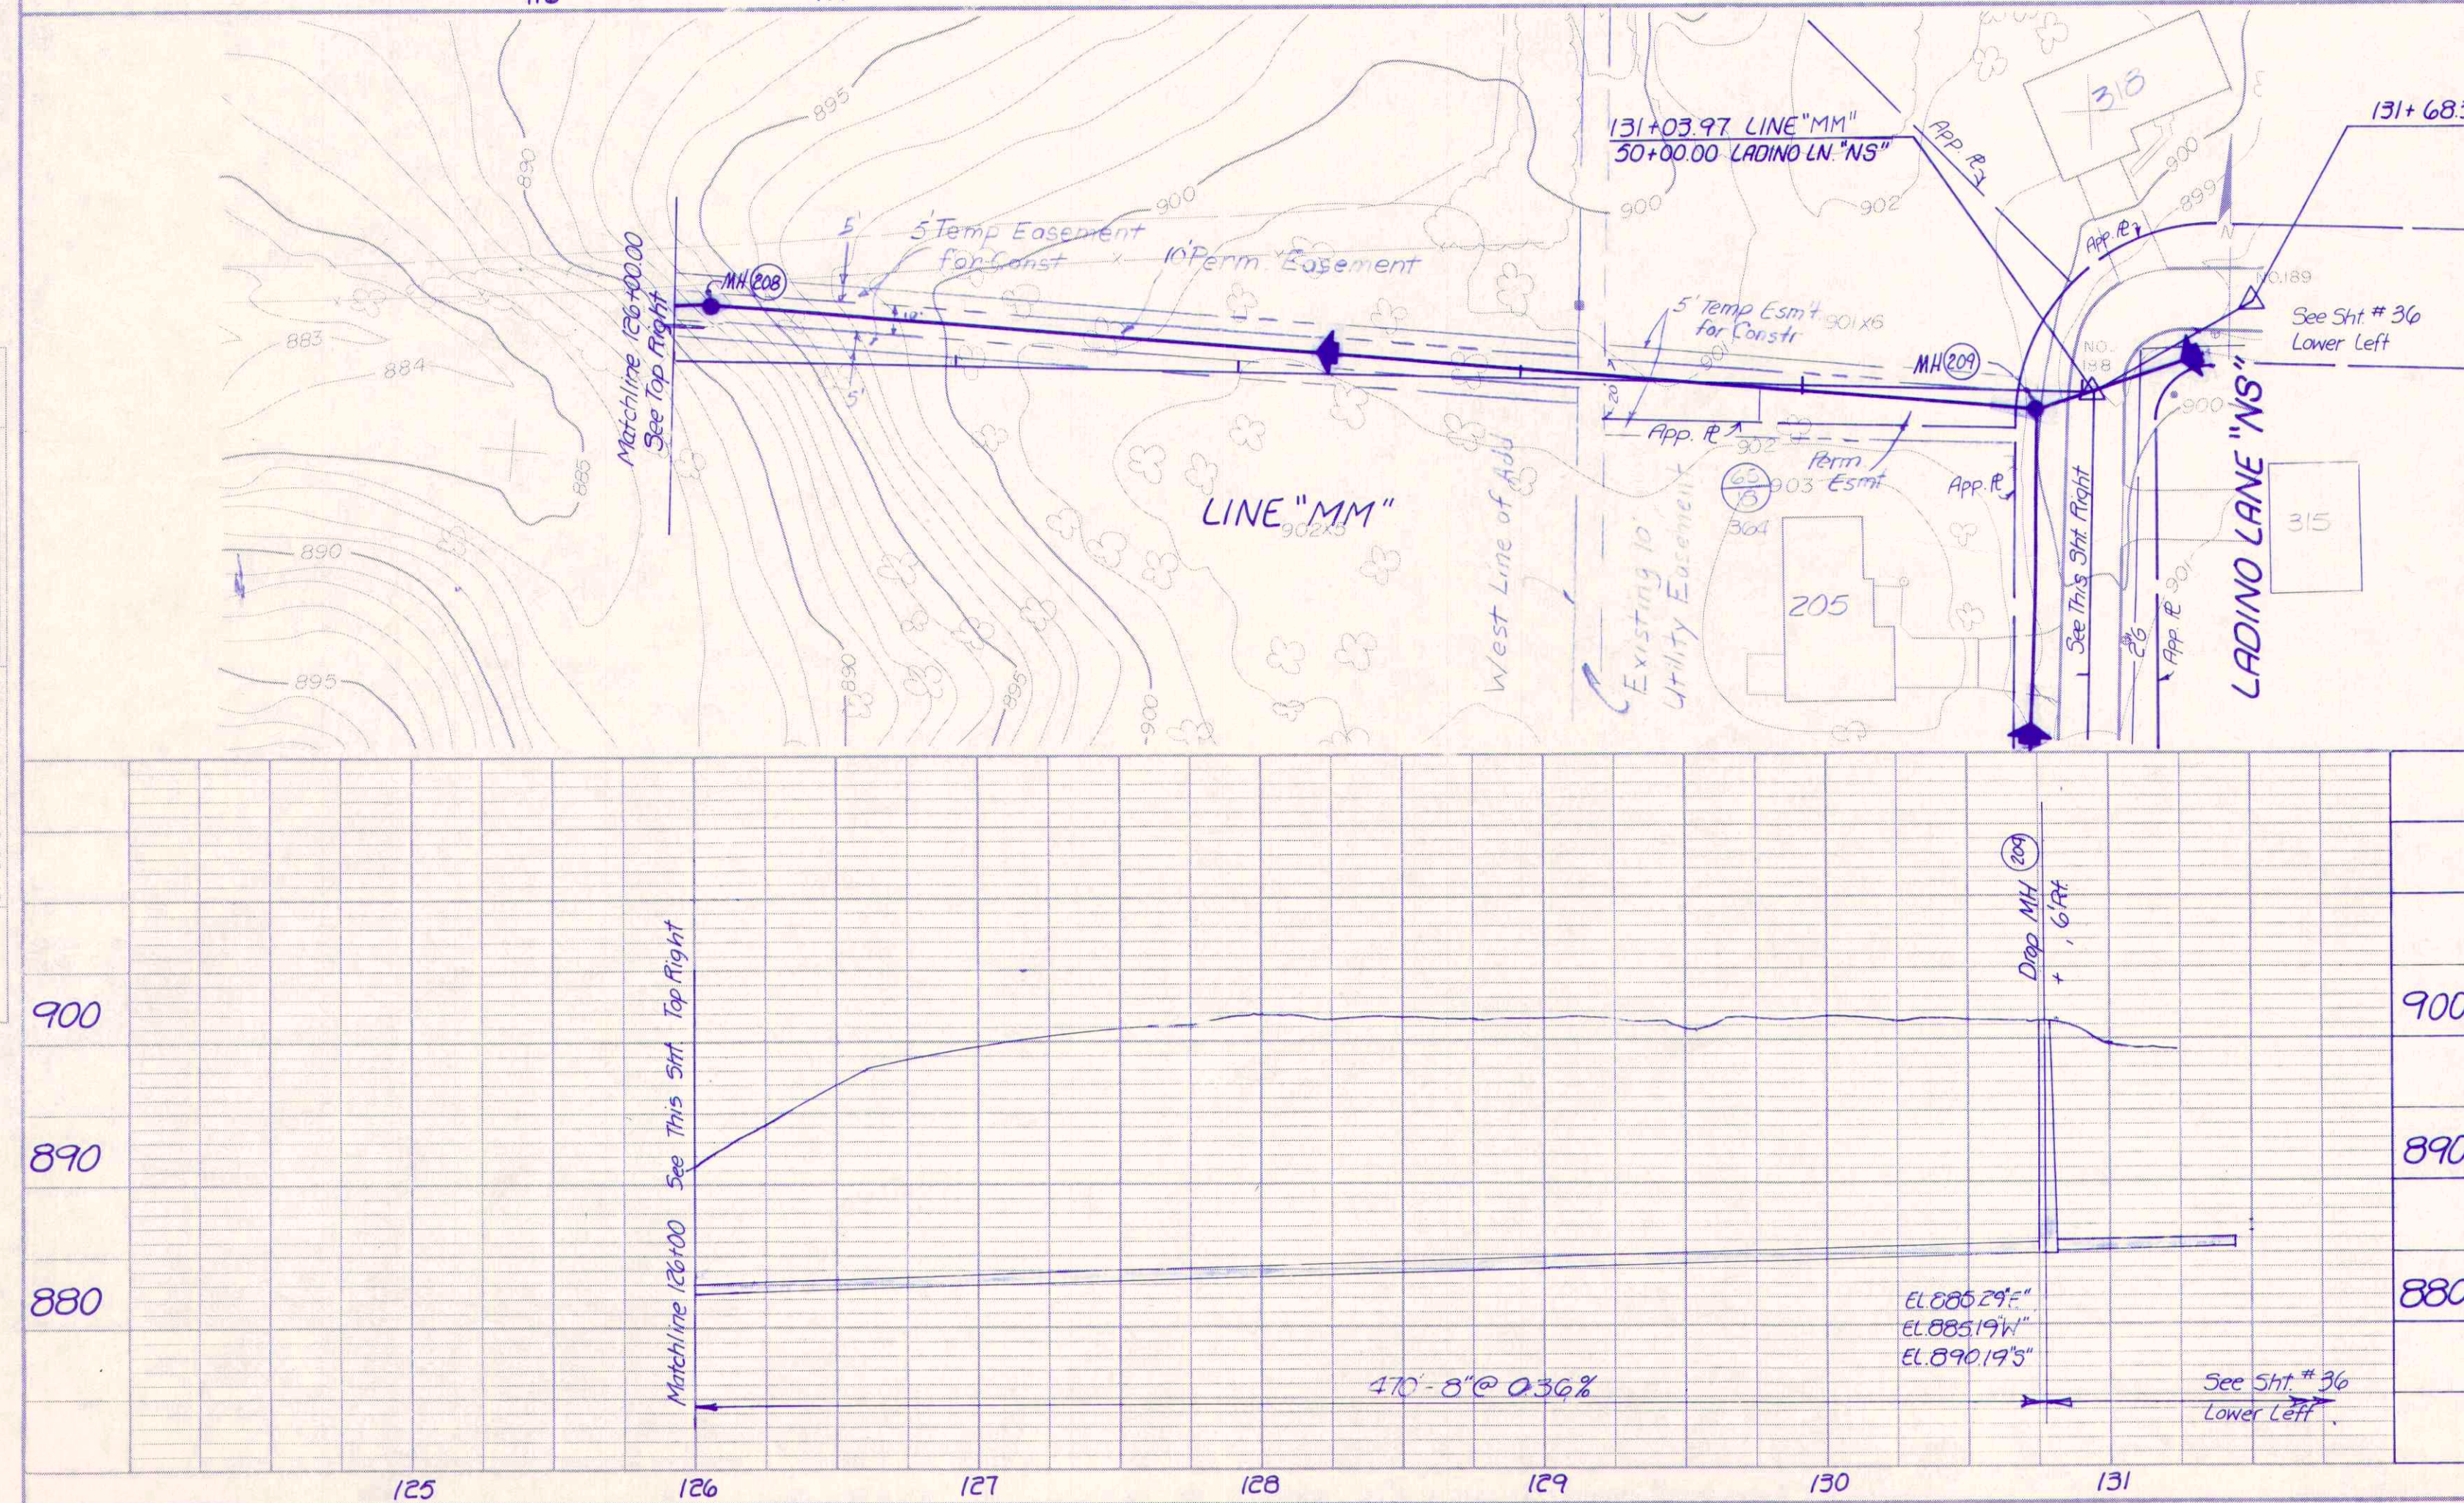


PLAN	DATE	
	BY	
	CHECKED	
	NOTED	

PROFILE	DATE	
	BY	
	CHECKED	
	NOTED	

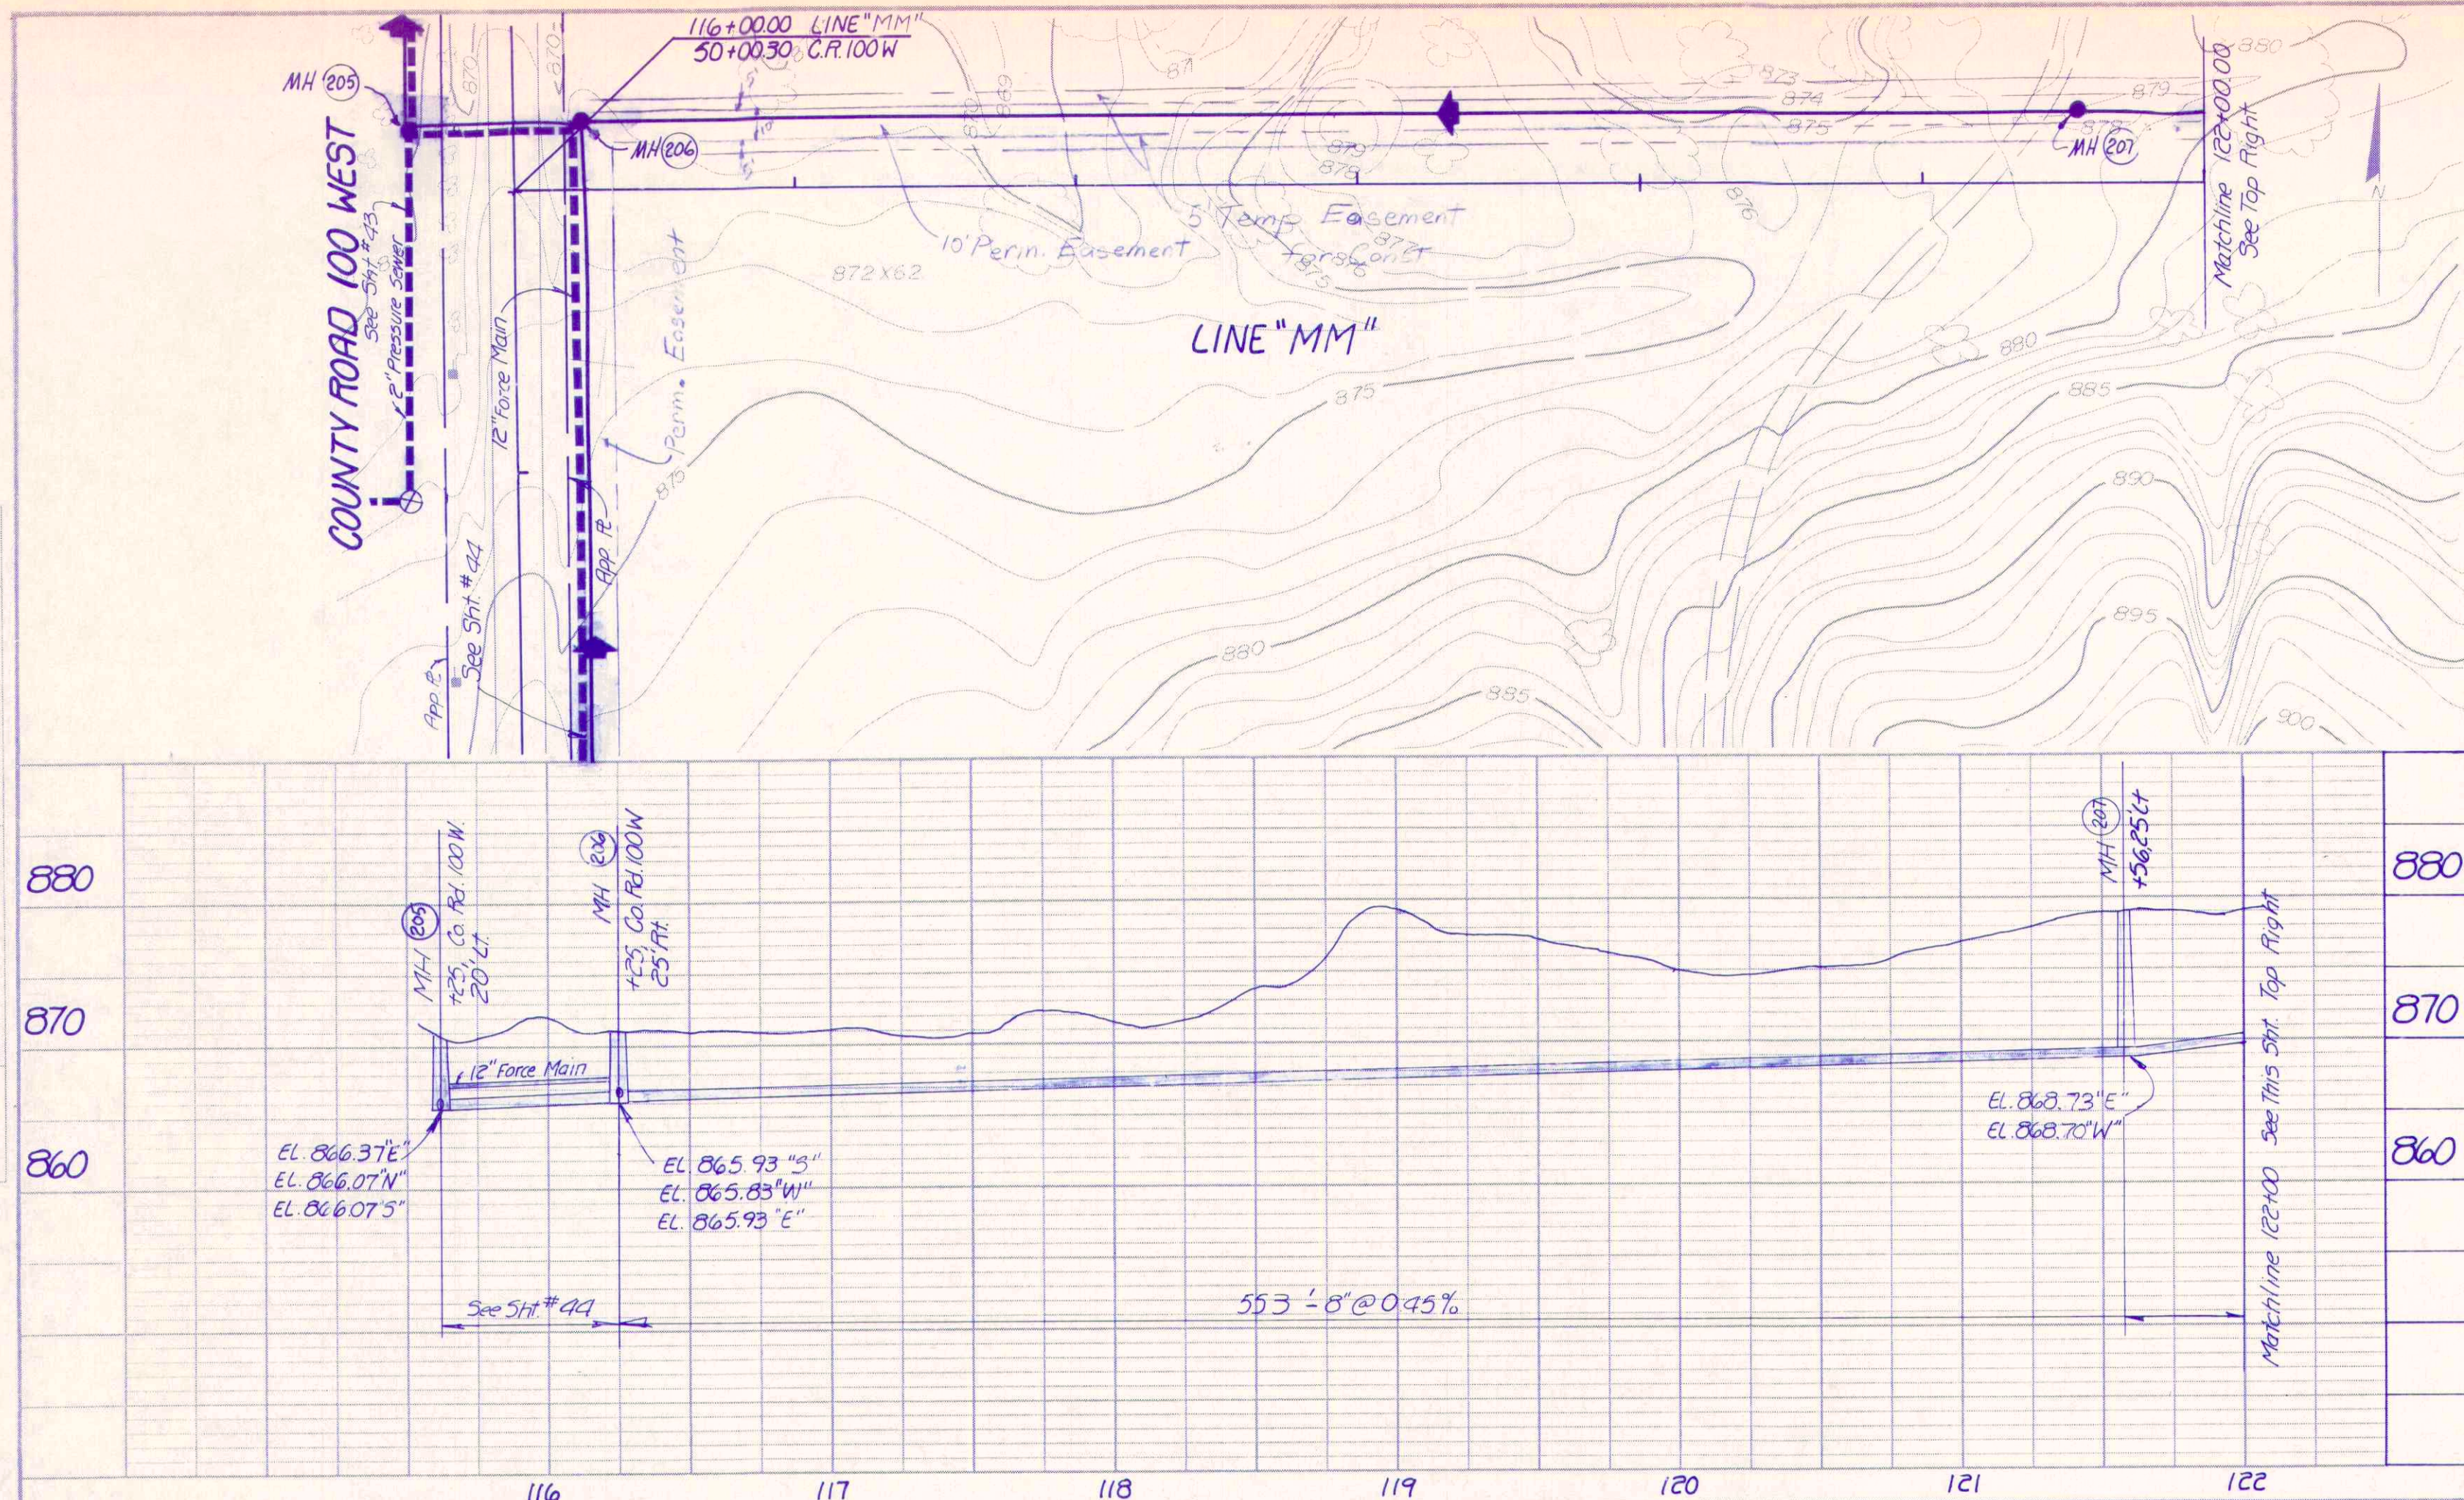

RECORD DRAWING

LINE "MM" / LADINO LANE "NS"	
FALL CREEK R.W.D. PLAN & PROFILE	SHEET
HORIZ. 1"=50'	BEAM, LONGEST & NEFF, INC.
VERT. 1"=10'	CONSULTING ENGINEERS
	INDIANAPOLIS, INDIANA
	35