
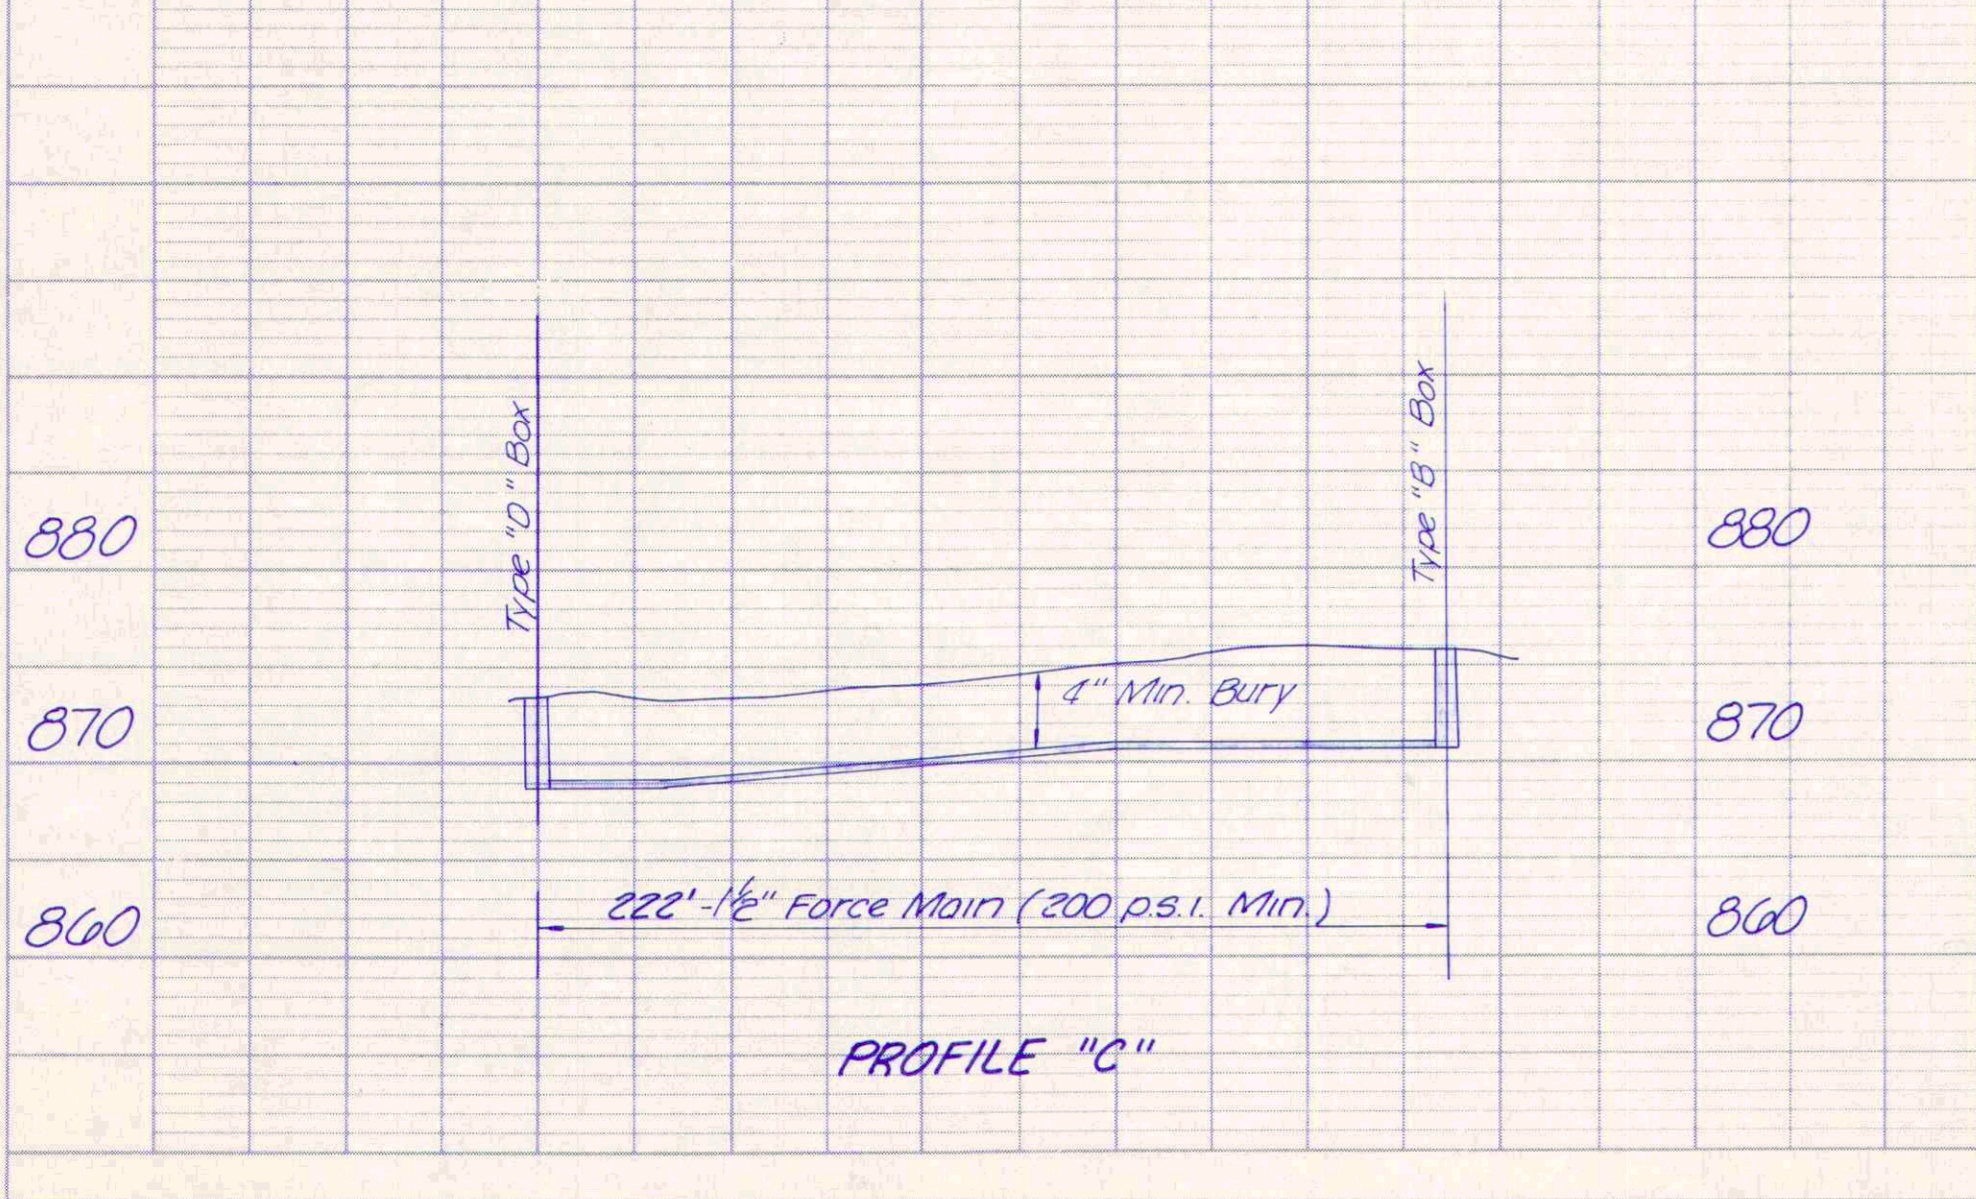
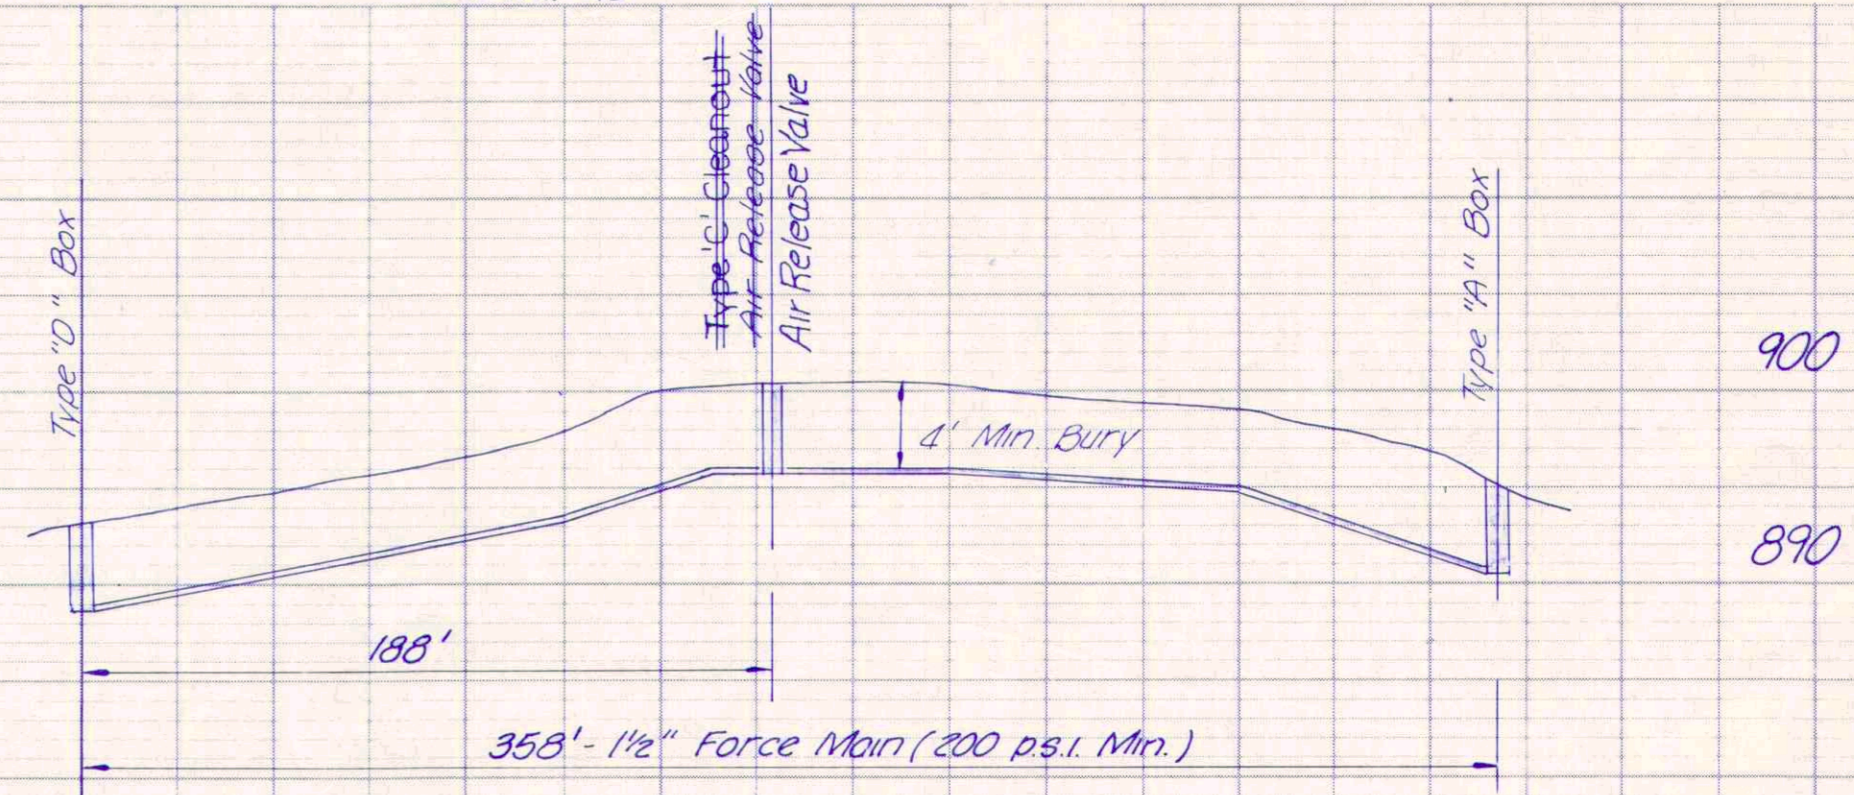
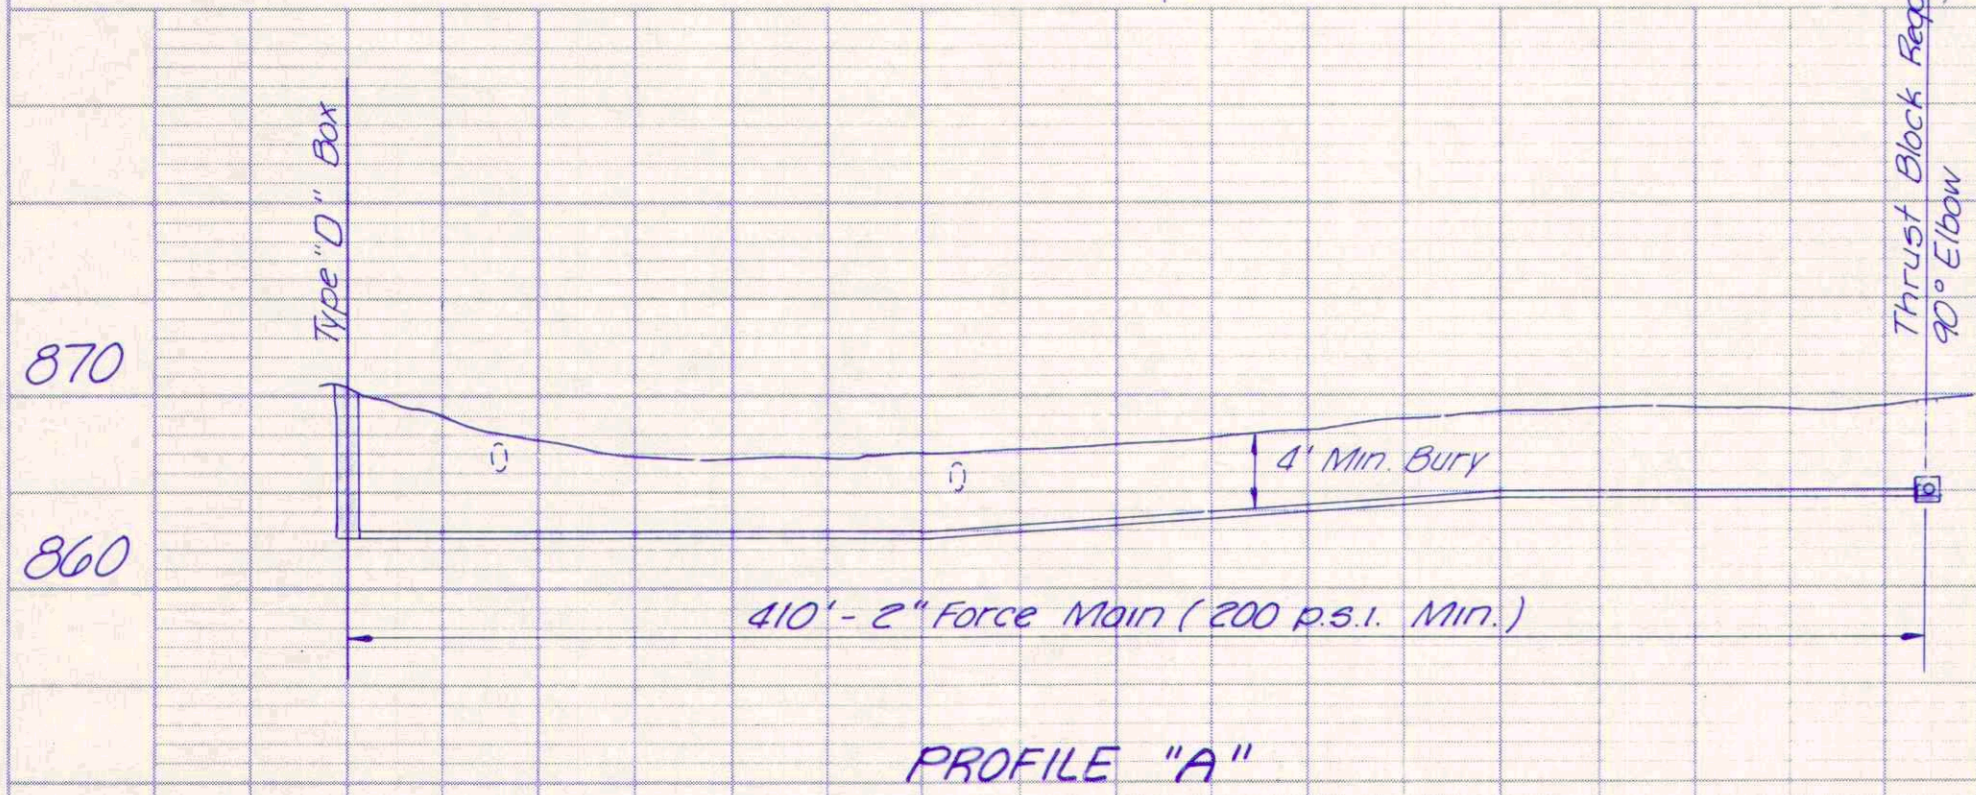
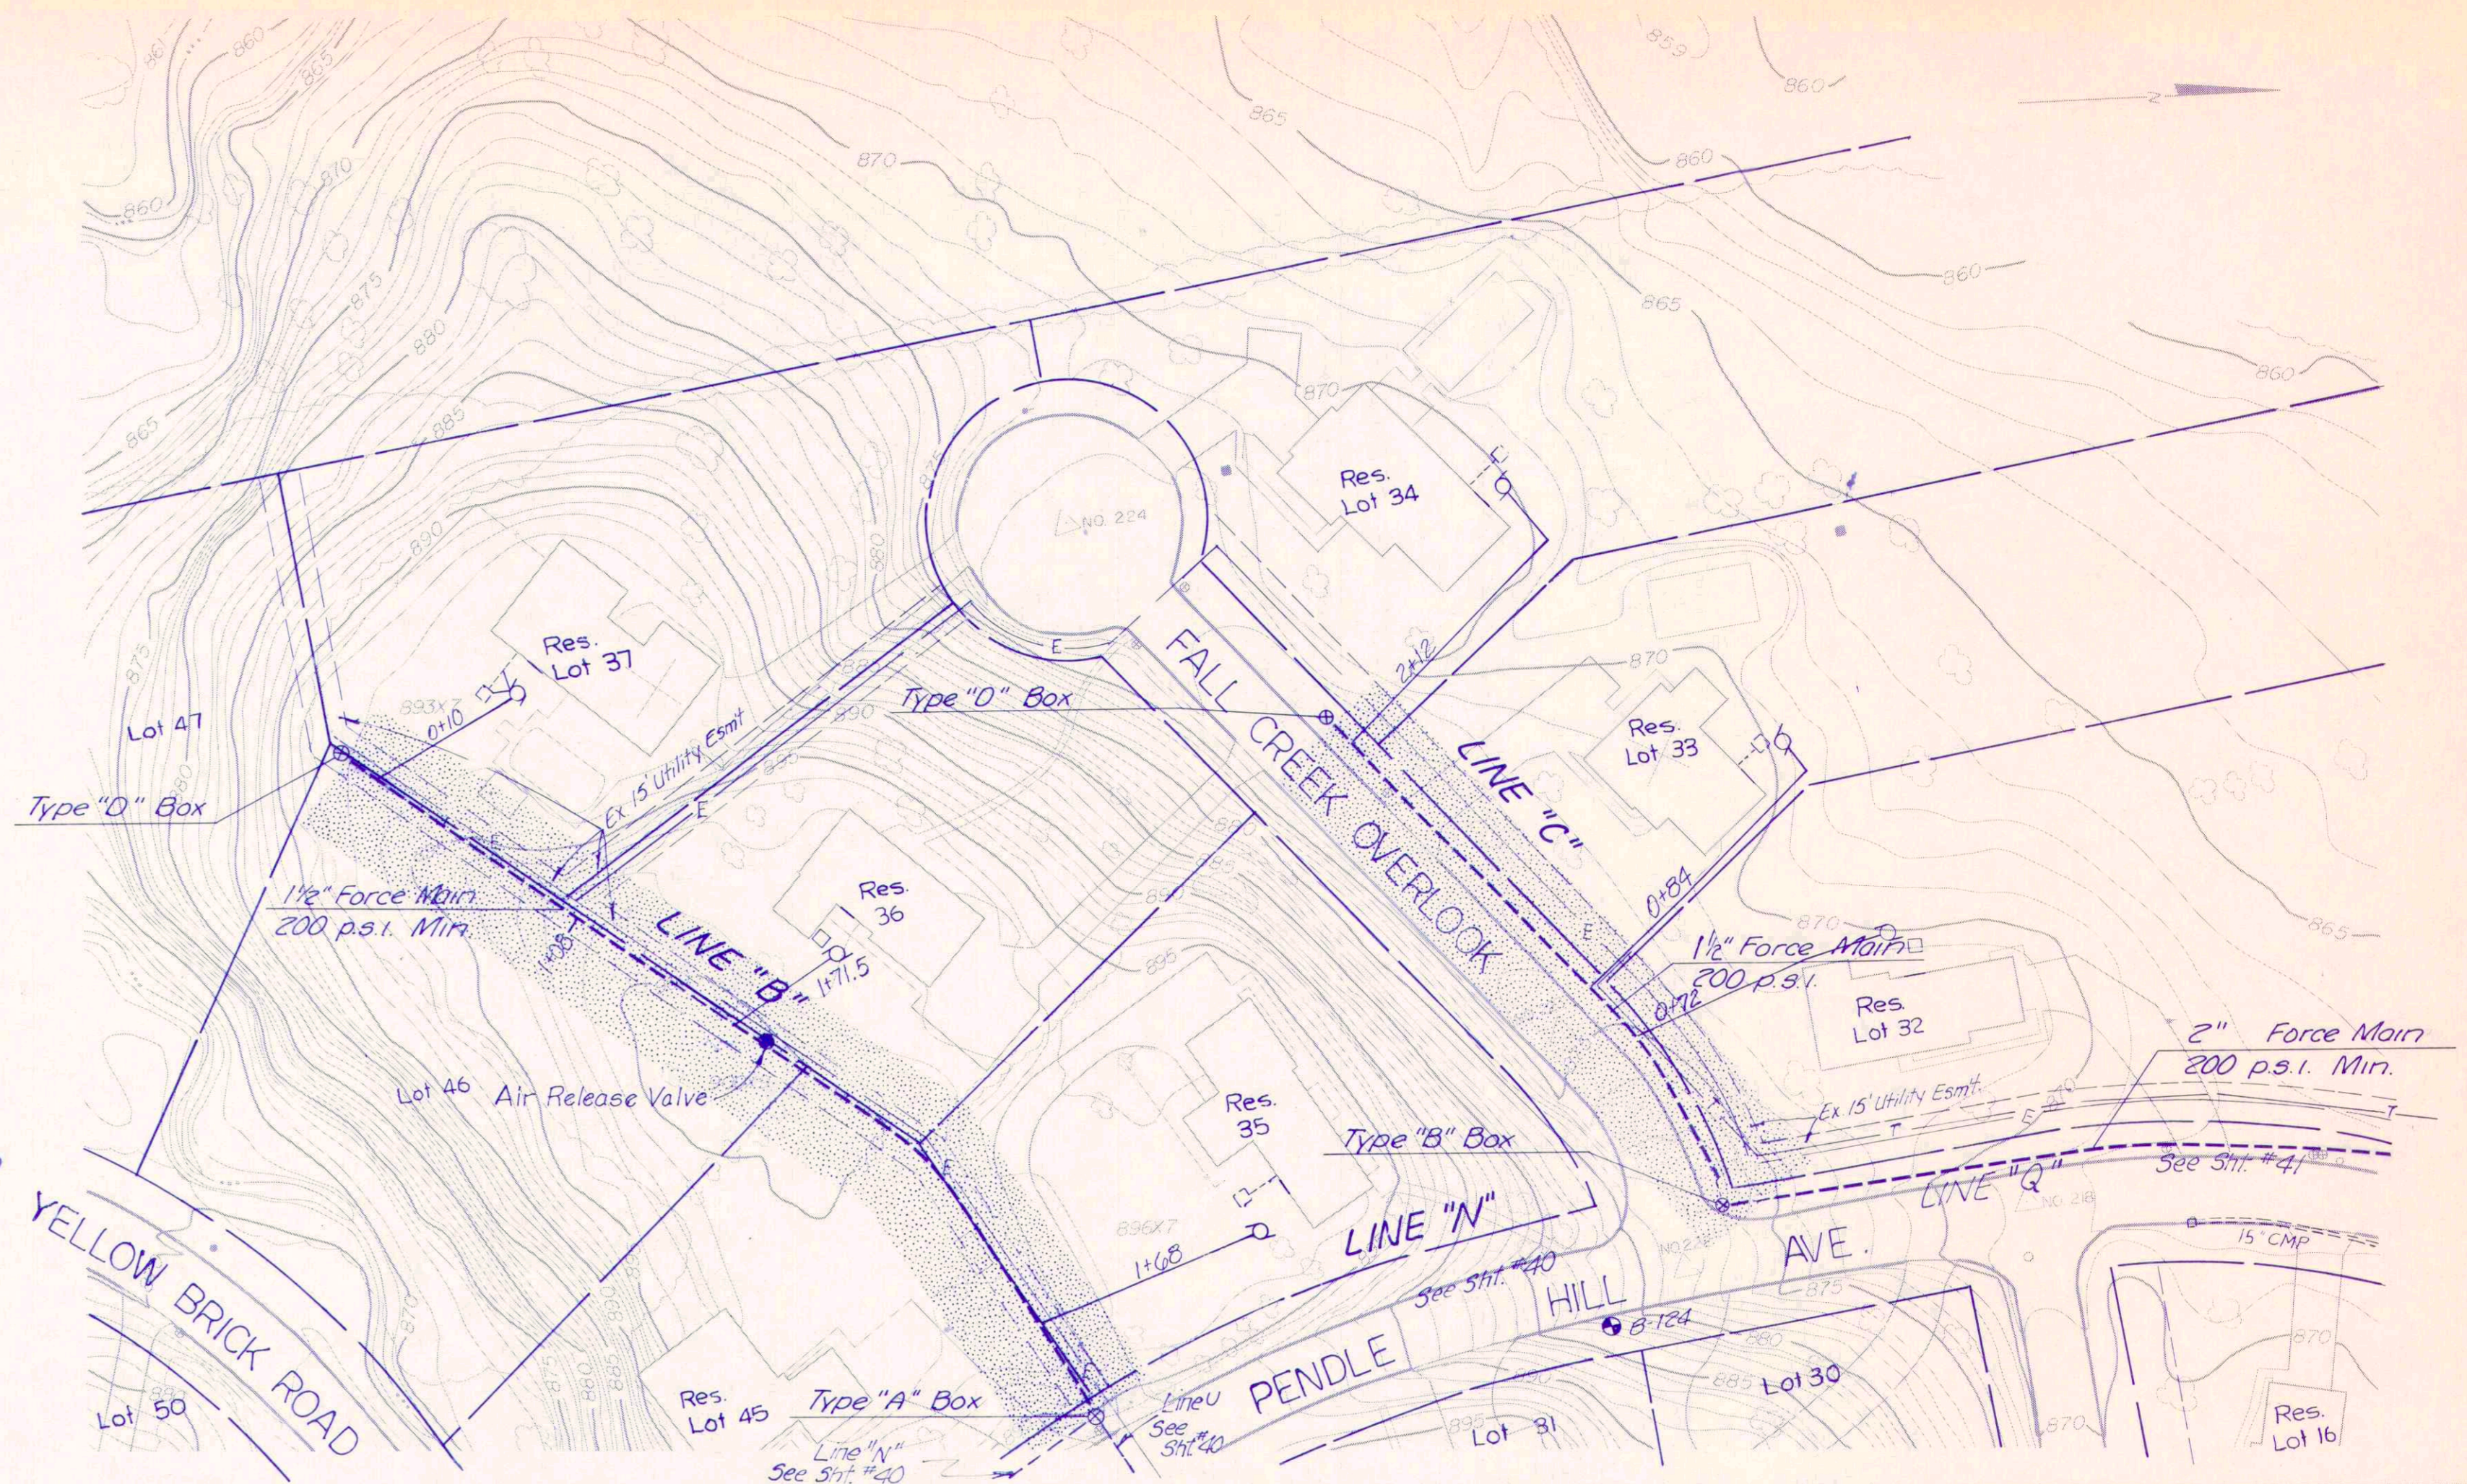


DATE: _____
 BY: _____
 SURVEYED: _____
 PLOTTED: _____
 CHECKED: _____
 NO. OF WAY CHECKED: _____
 No. _____

DATE: _____
 BY: _____
 SURVEYED: _____
 PLOTTED: _____
 CHECKED: _____
 NO. OF WAY CHECKED: _____
 No. _____

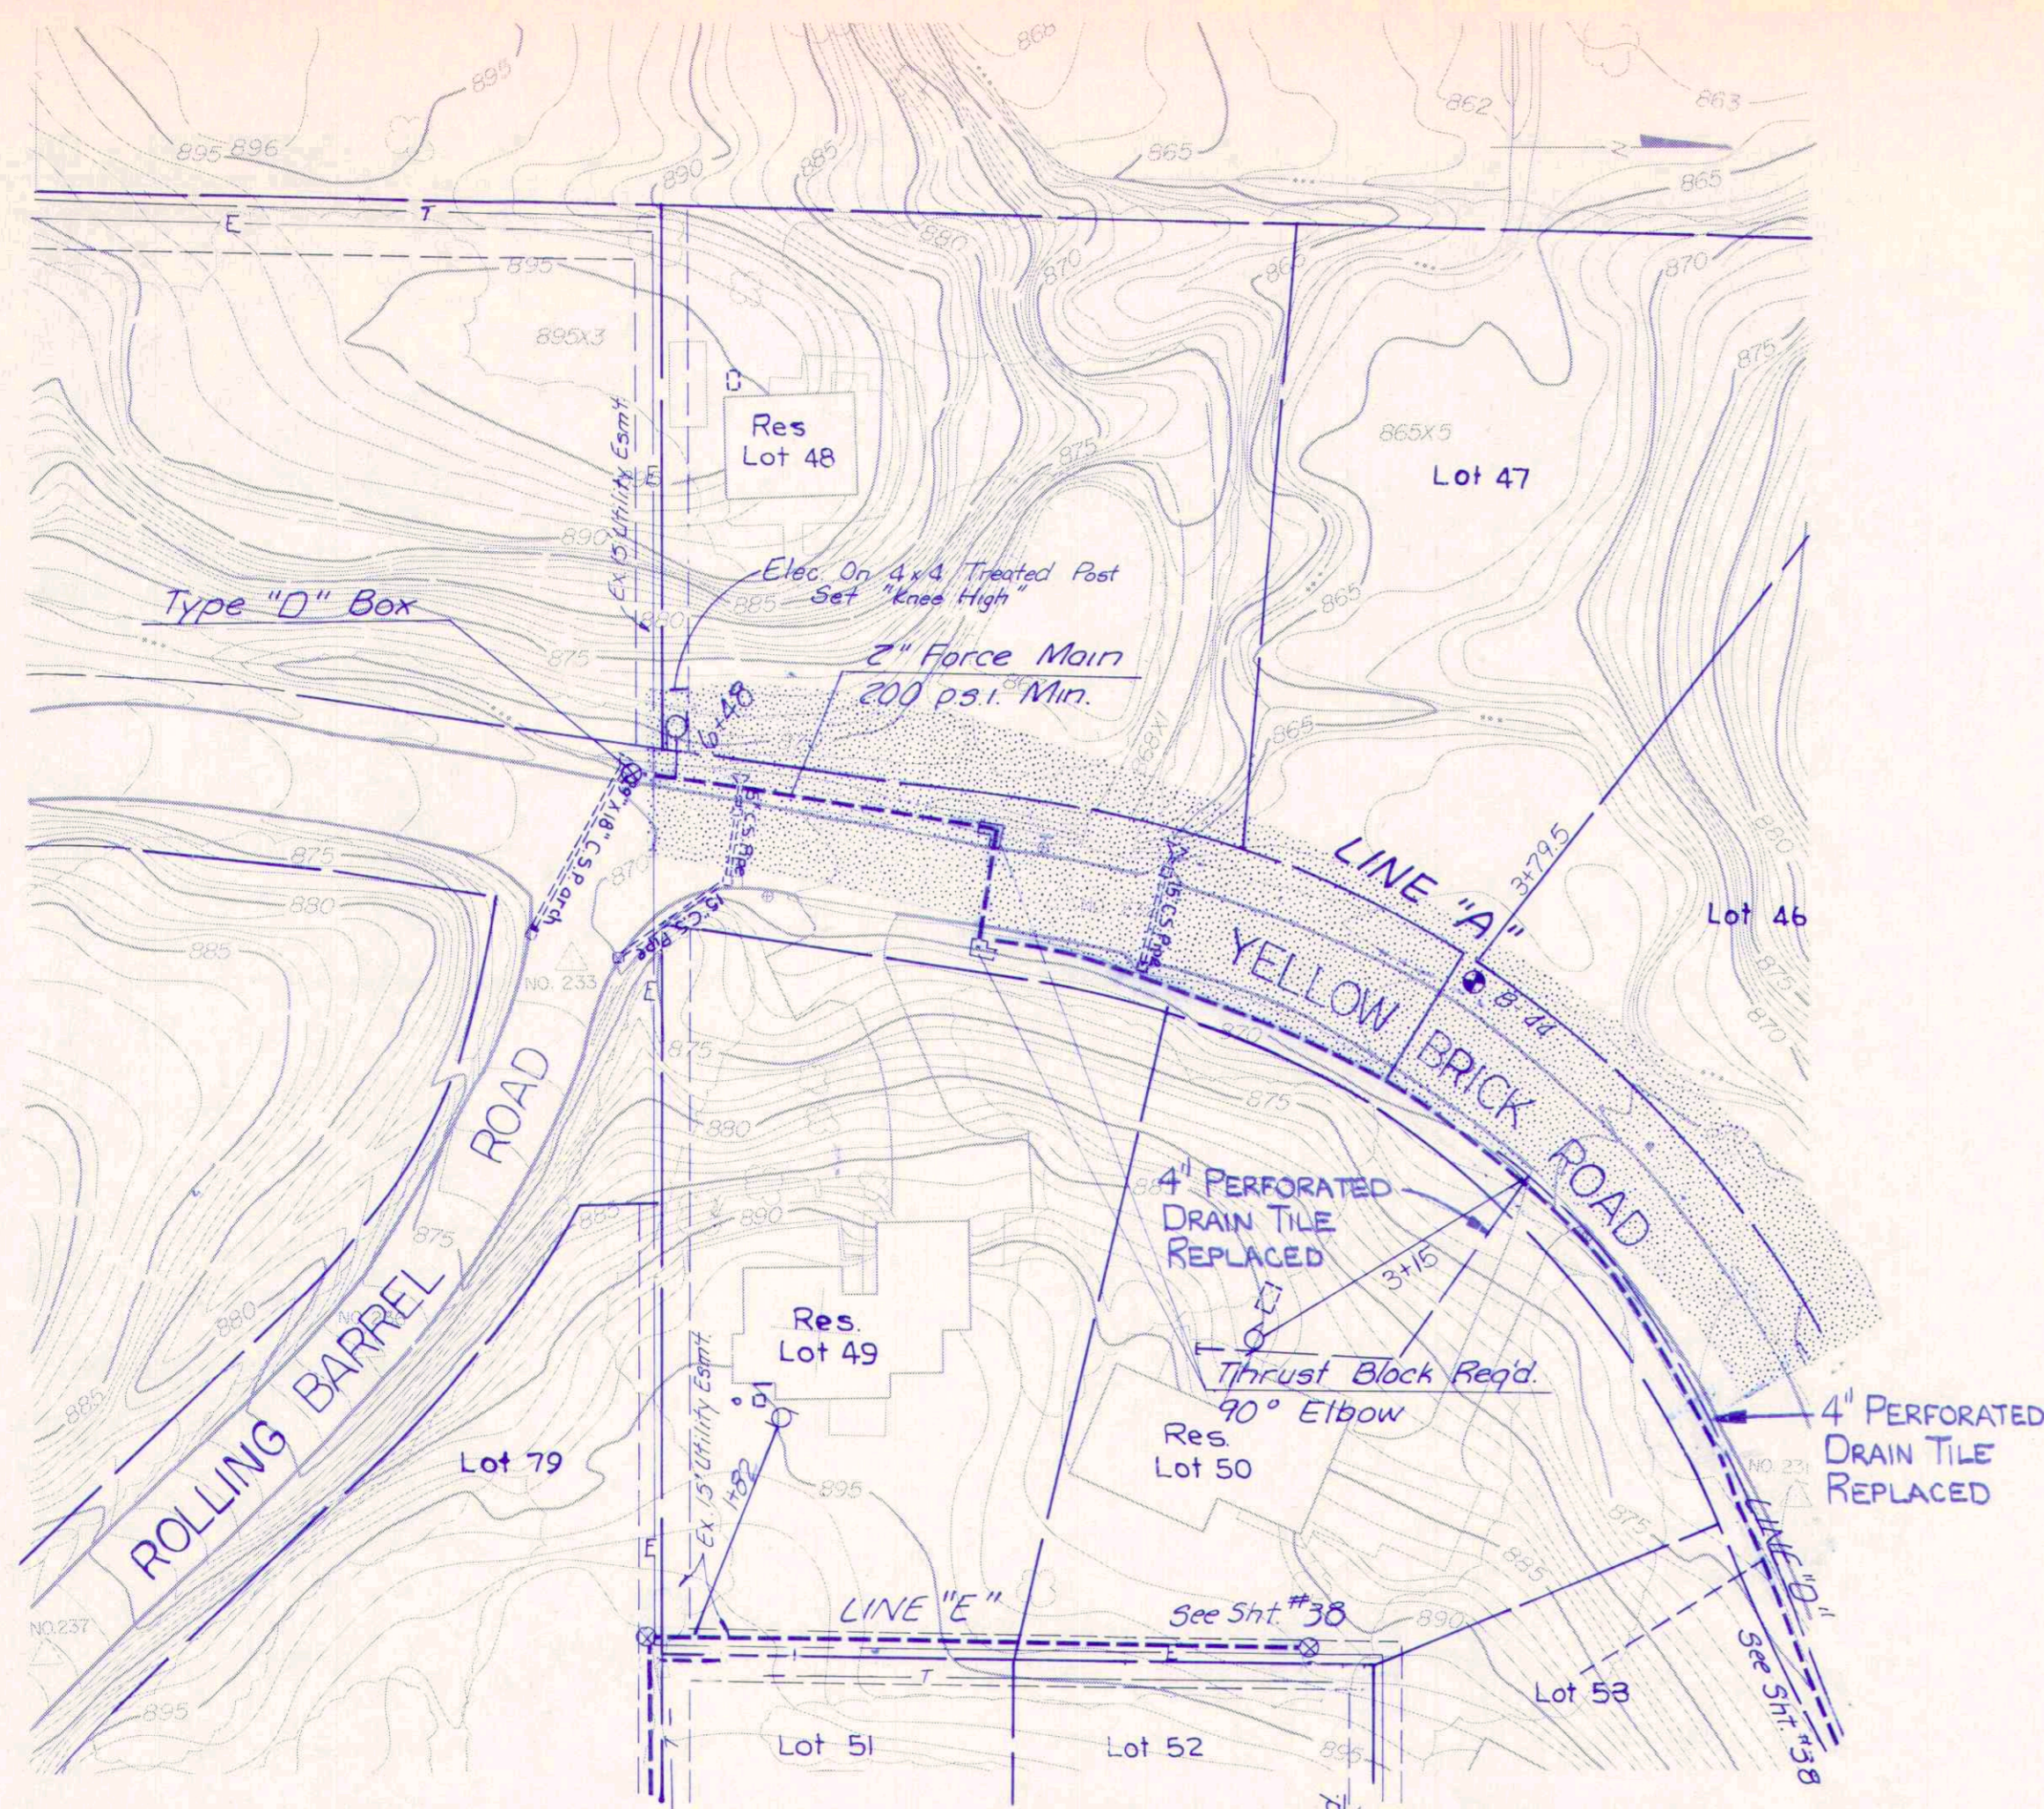

Rev. 4-9-84
 Move 2" Force Main (Line A)
 across the Street.
 Rev. 9-5-85
 Air Release Valve on Line B

Note: All Vacant lots Have Shut-off Valve Installed. @ Tee

RECORD DRAWING



YELLOW BRICK RD. - ROLLING BARREL RD.
 FALL CREEK OVERLOOK - PENDLE HILL AVE.
 FALL CREEK R.W.D. PLAN & PROFILE SHEET
 HORIZ. 1"=50'
 VERT. 1"=10'
 BEAM, LONGEST & NEFF, INC.
 CONSULTING ENGINEERS
 INDIANAPOLIS, INDIANA
 37