
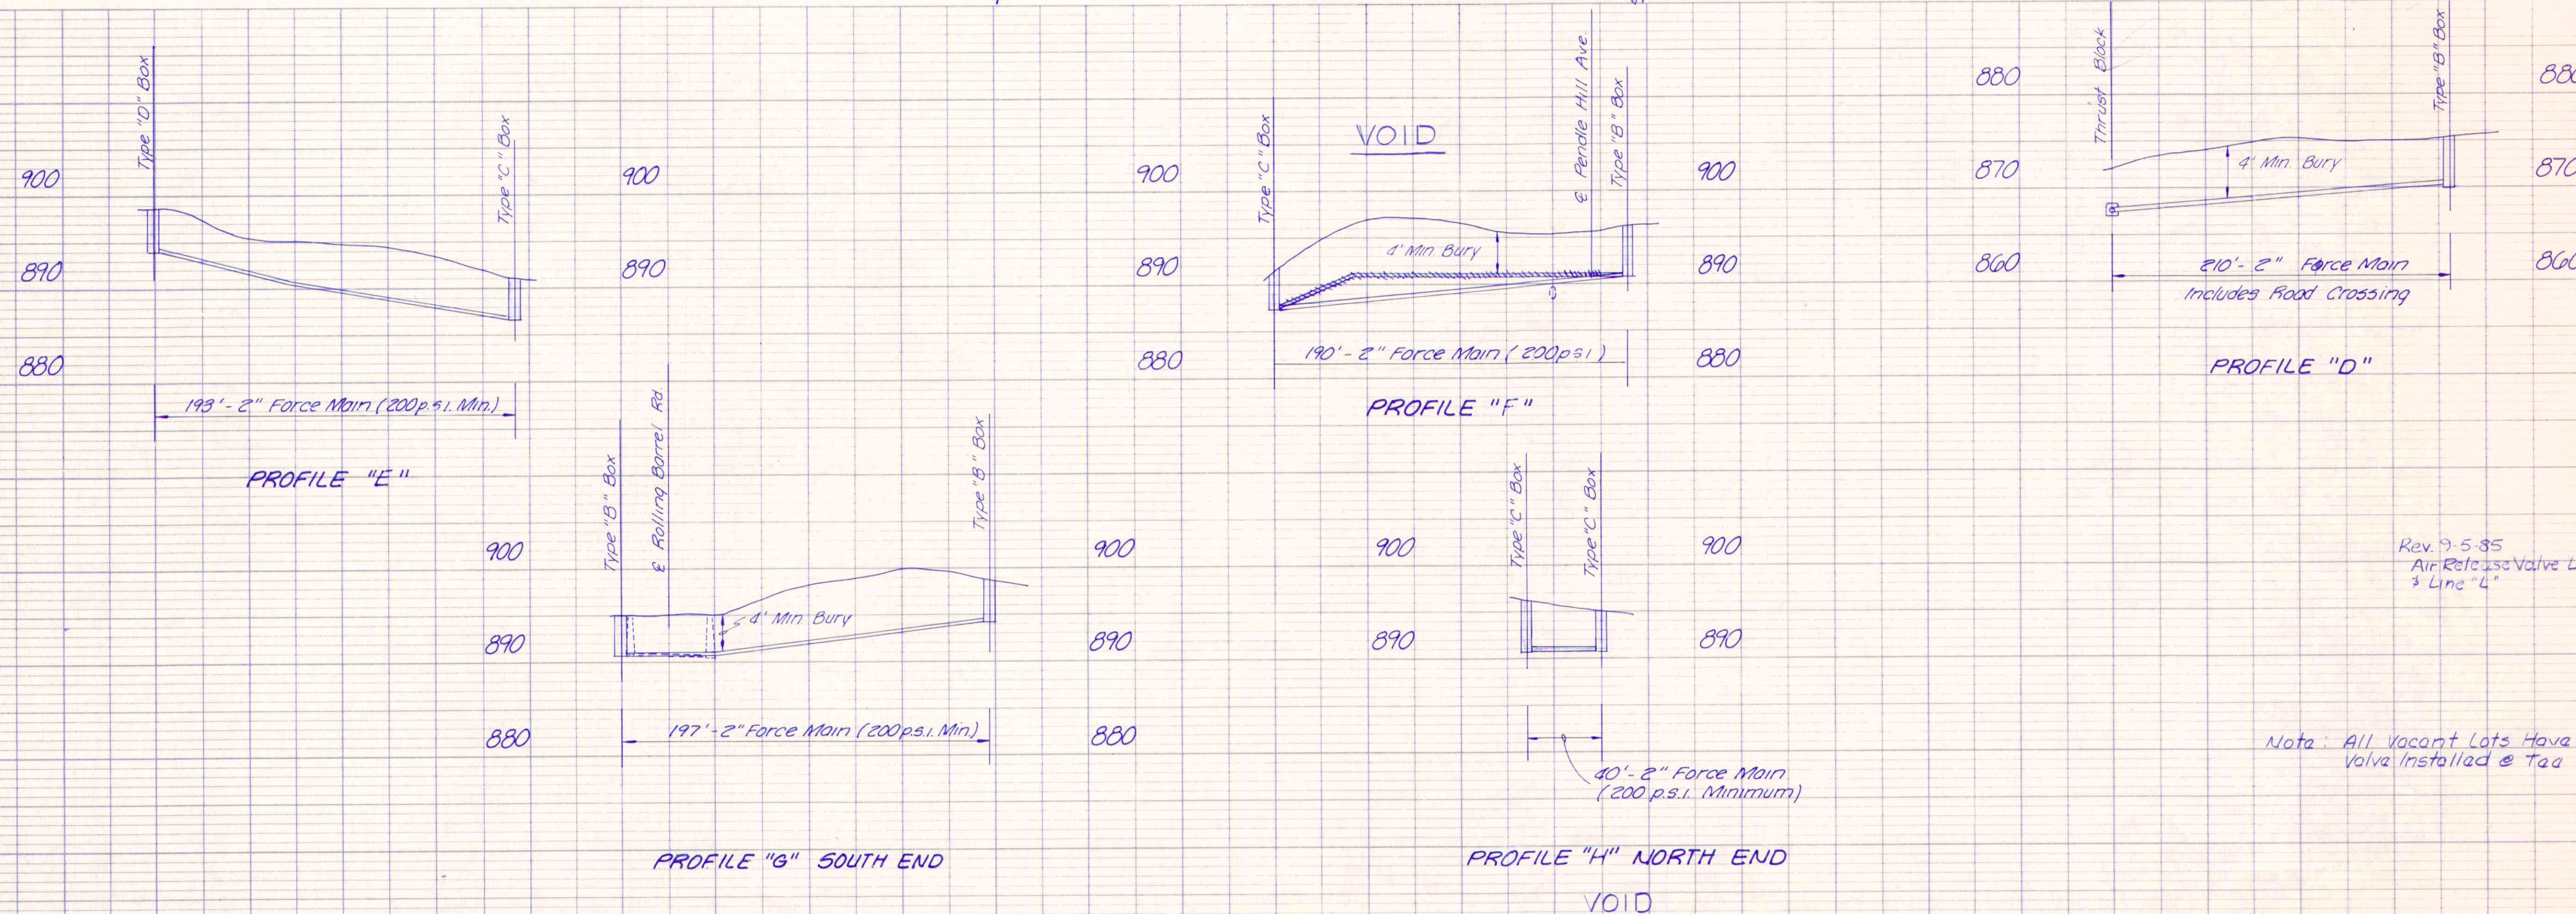


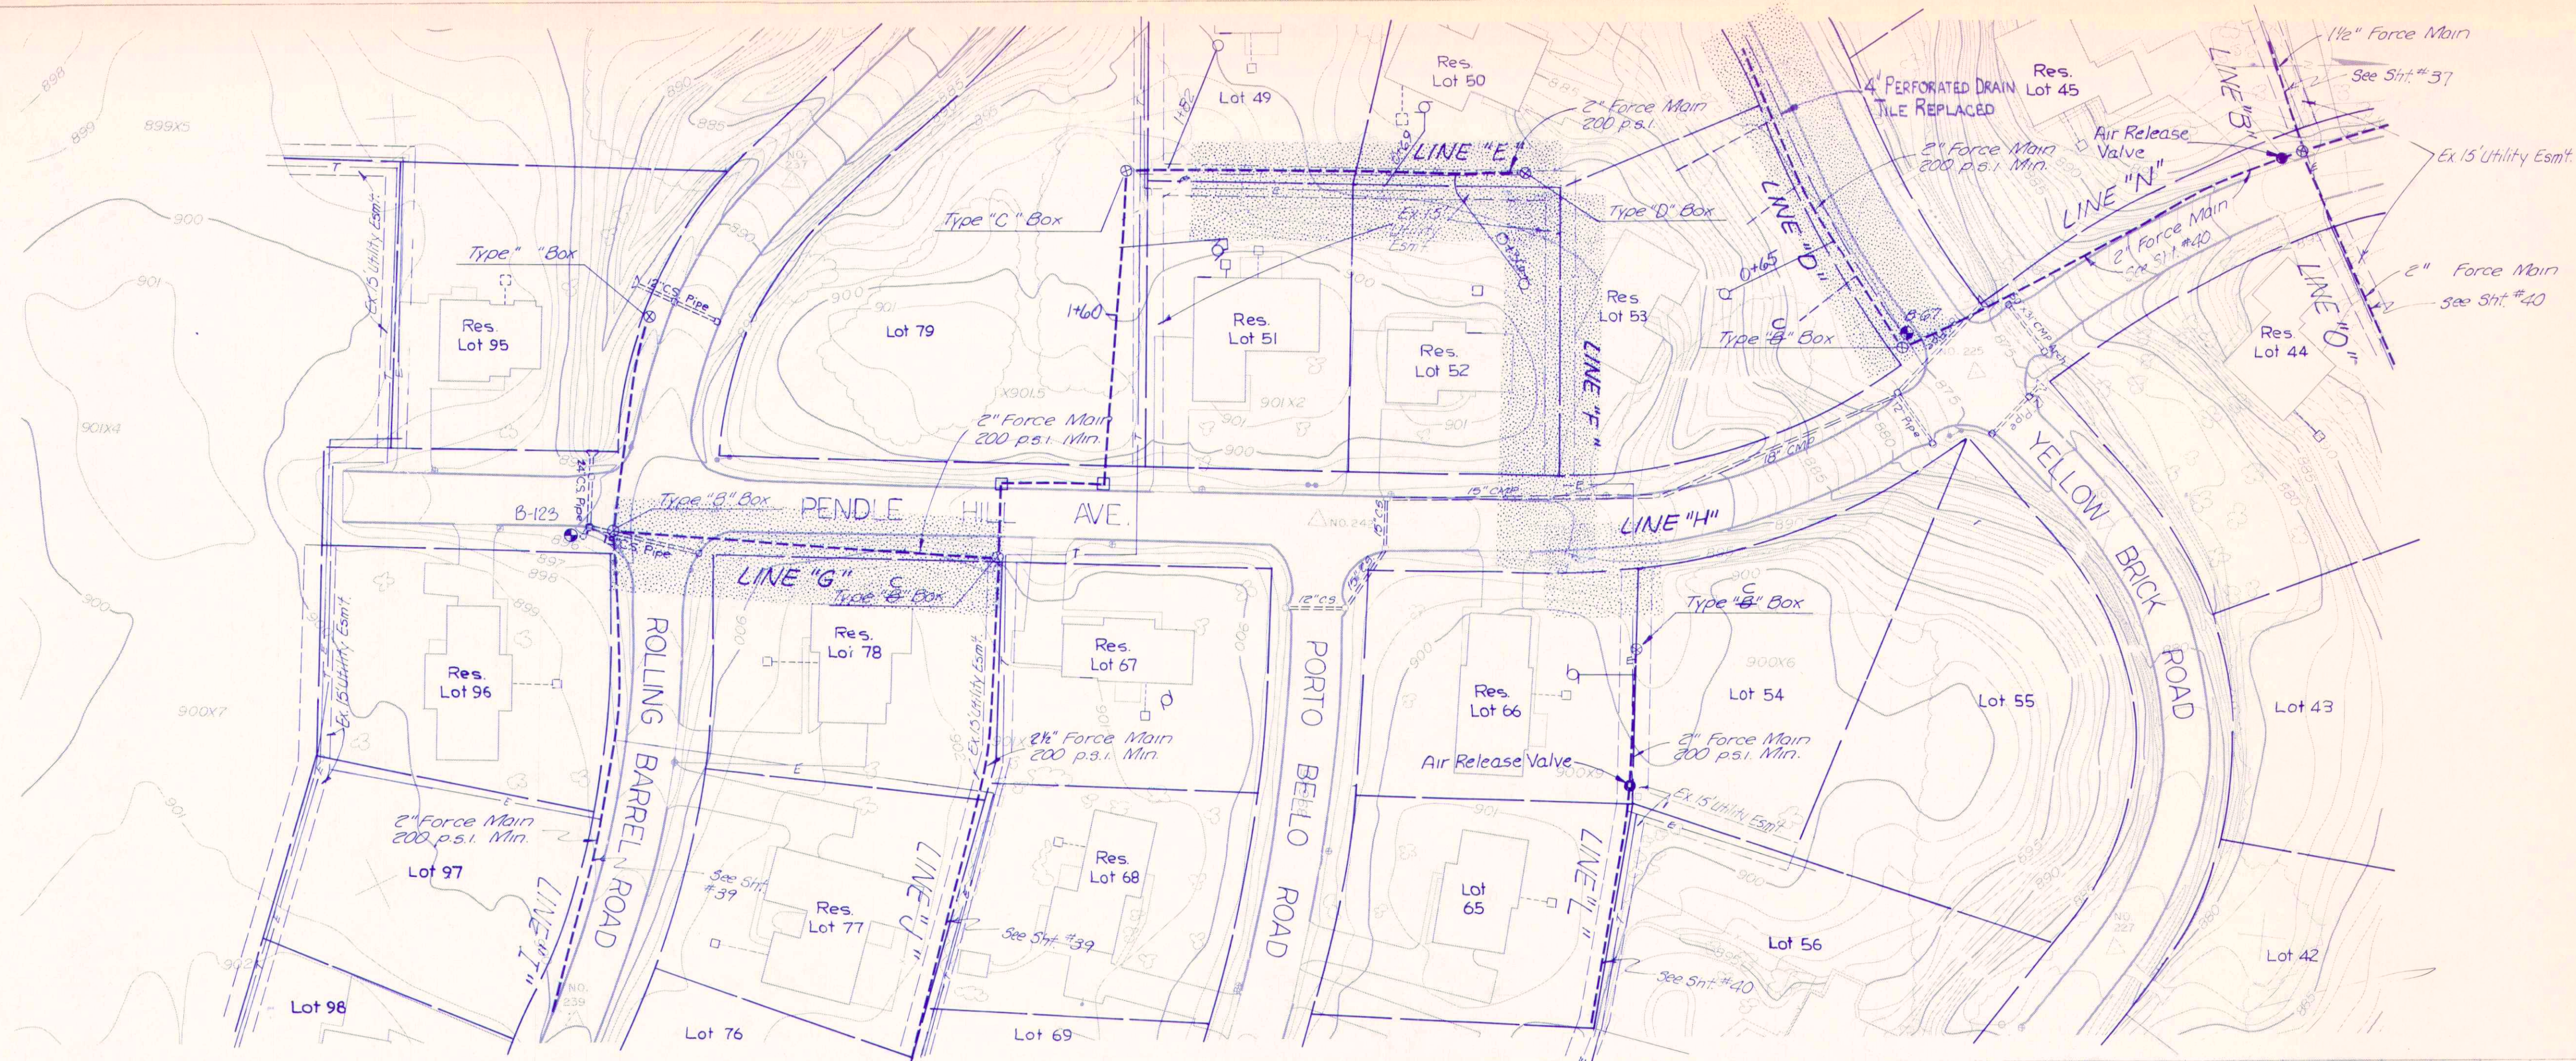

Rev. 9-5-85
Air Release Valve Line "N"
& Line "L"

Note: All Vacant Lots Have Shut-off
Valve Installed @ Tag

RECORD DRAWING