
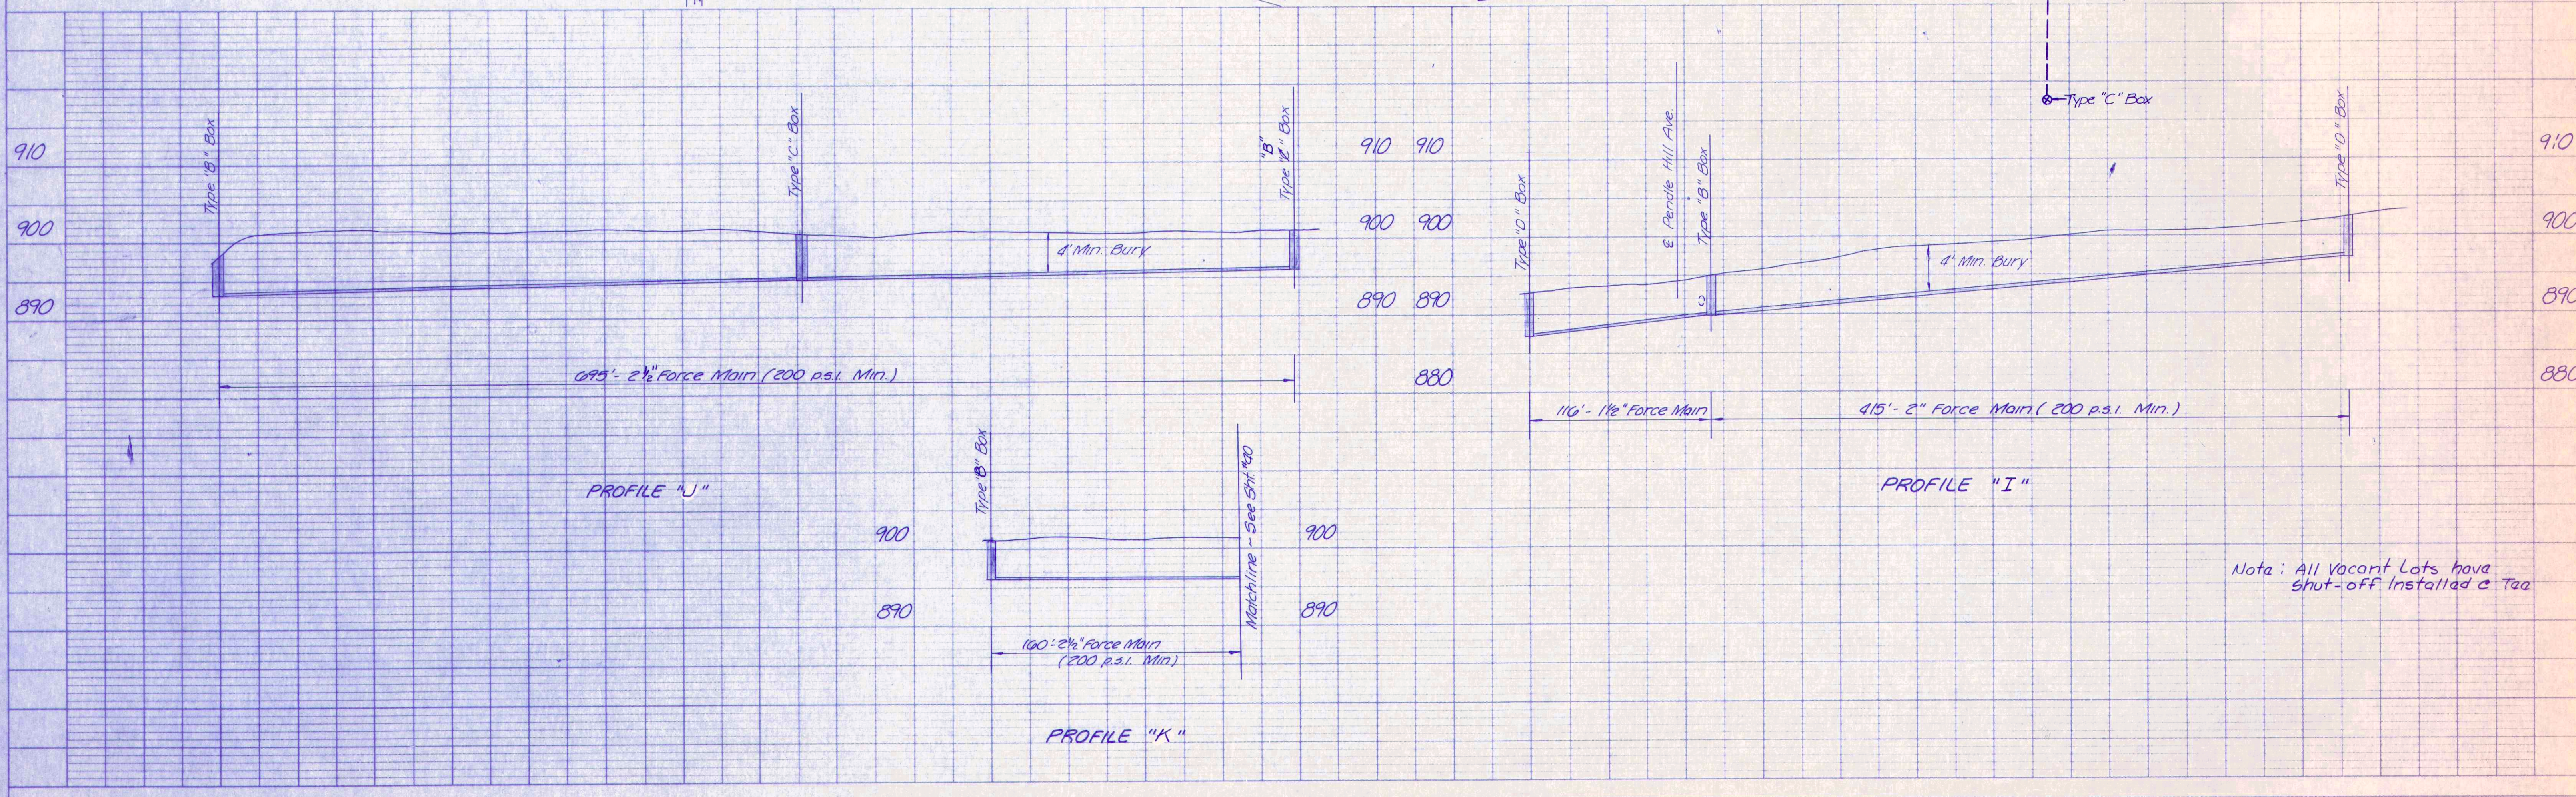



PLAN	DATE	BY
	NOTED	CHECKED
NOTE BOOK	BY OF ANY OTHER	
No.		

PROFILE	DATE	BY
	NOTED	CHECKED
NOTE BOOK	BY OF ANY OTHER	
No.		

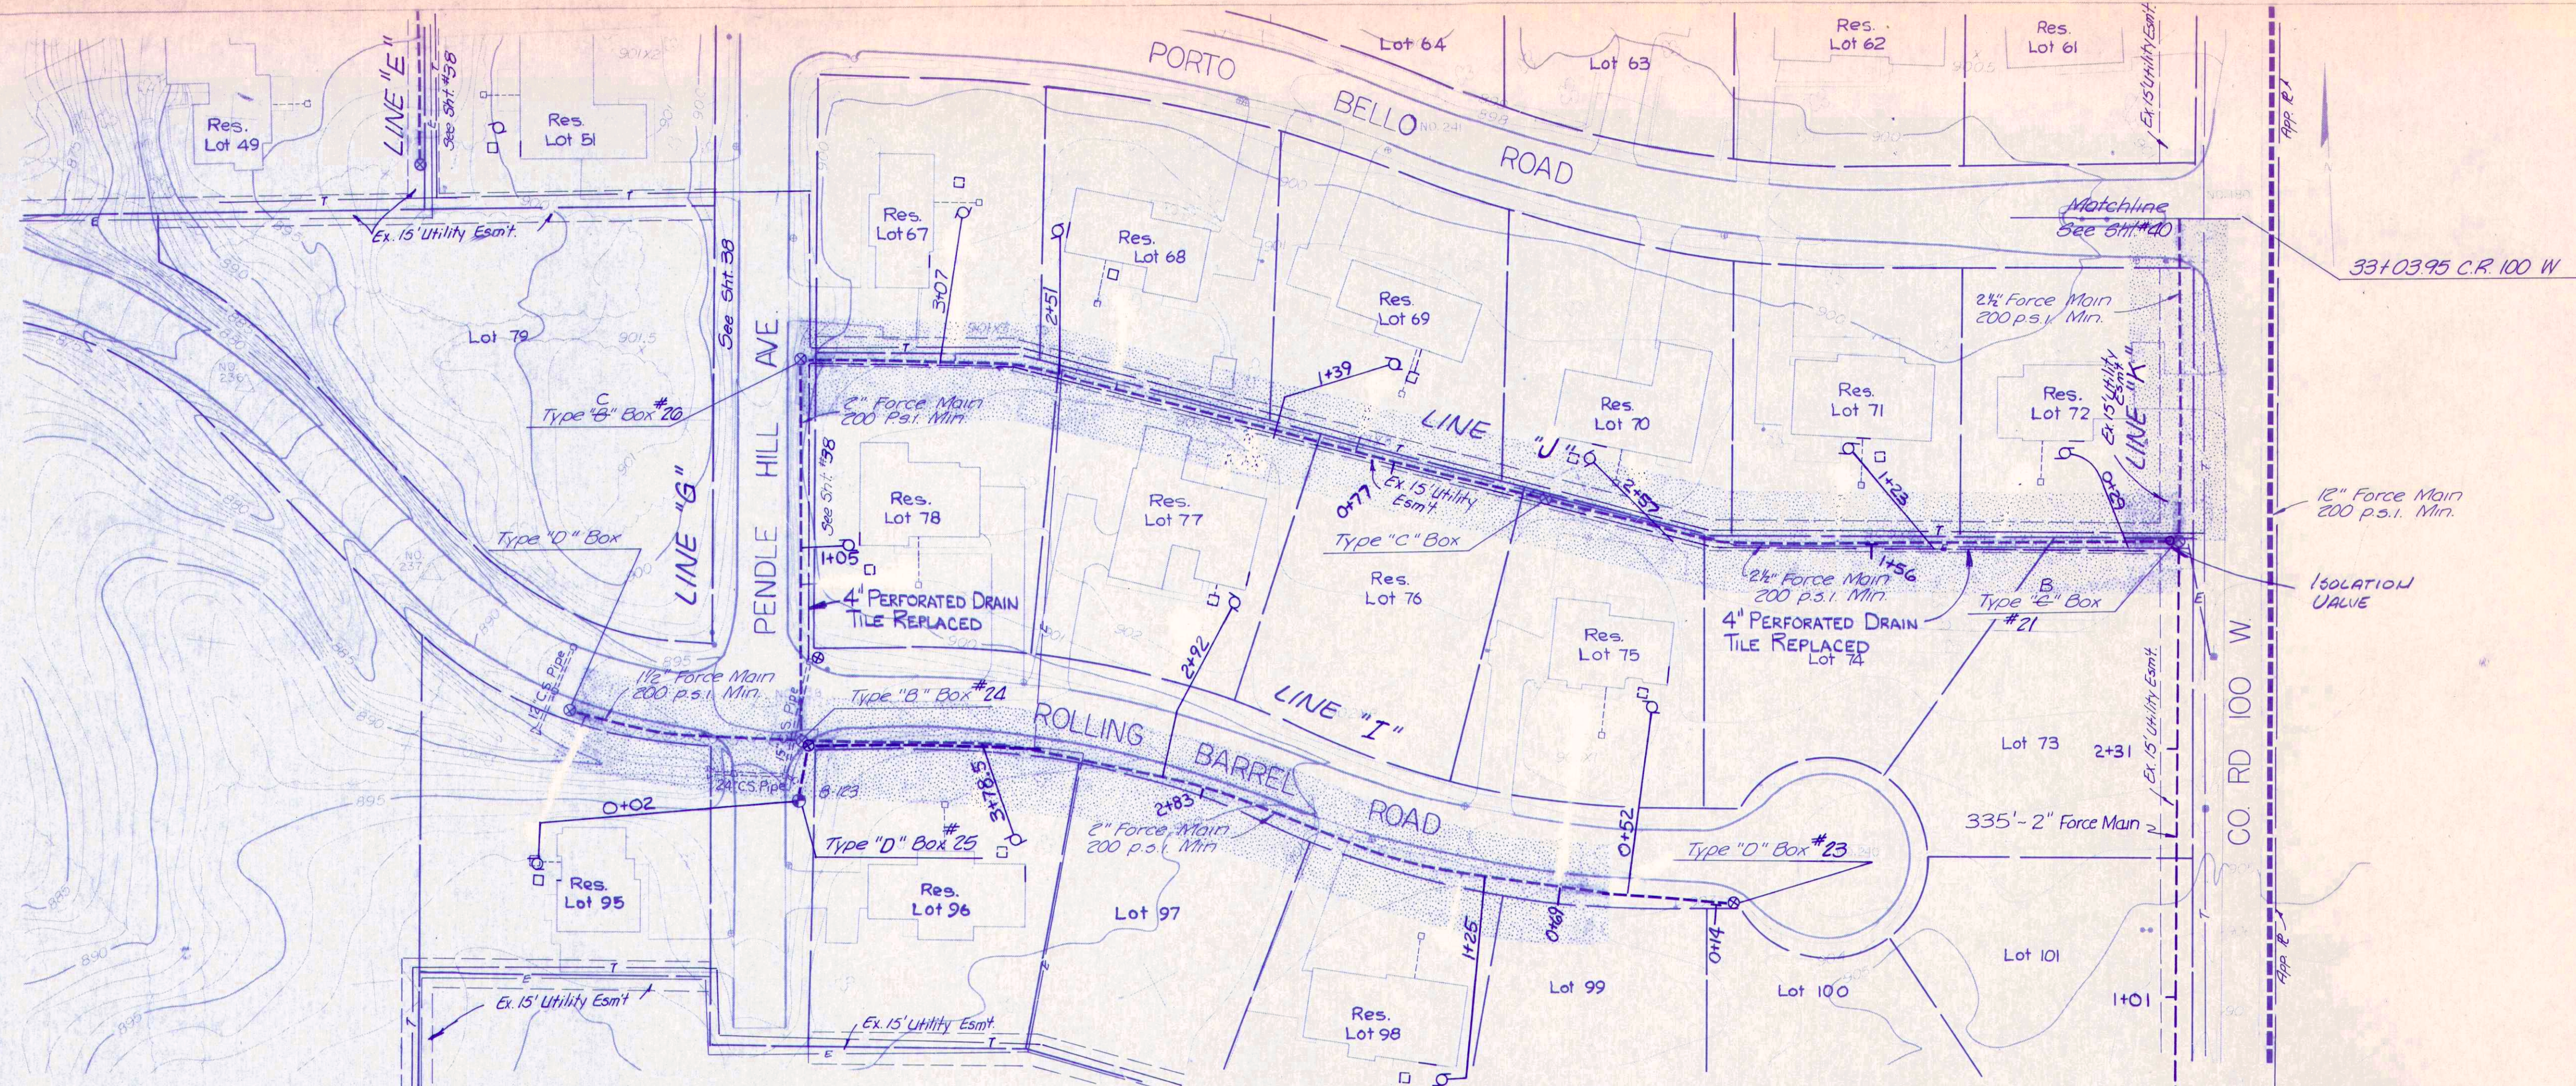

Note: All Vacant Lots have shut-off installed & Tag

RECORD DRAWING

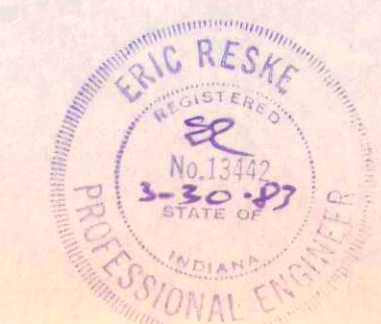

PORTO-BELLO RD - ROLLING BARREL RD PENDLE HILL AVE.	
FALL CREEK R.W.D. PLAN & PROFILE	SHEET
HORIZ. 1"=50'	BEAM, LONGEST & NEFF, INC.
VERT. 1"=10'	CONSULTING ENGINEERS
	INDIANAPOLIS, INDIANA
	39