
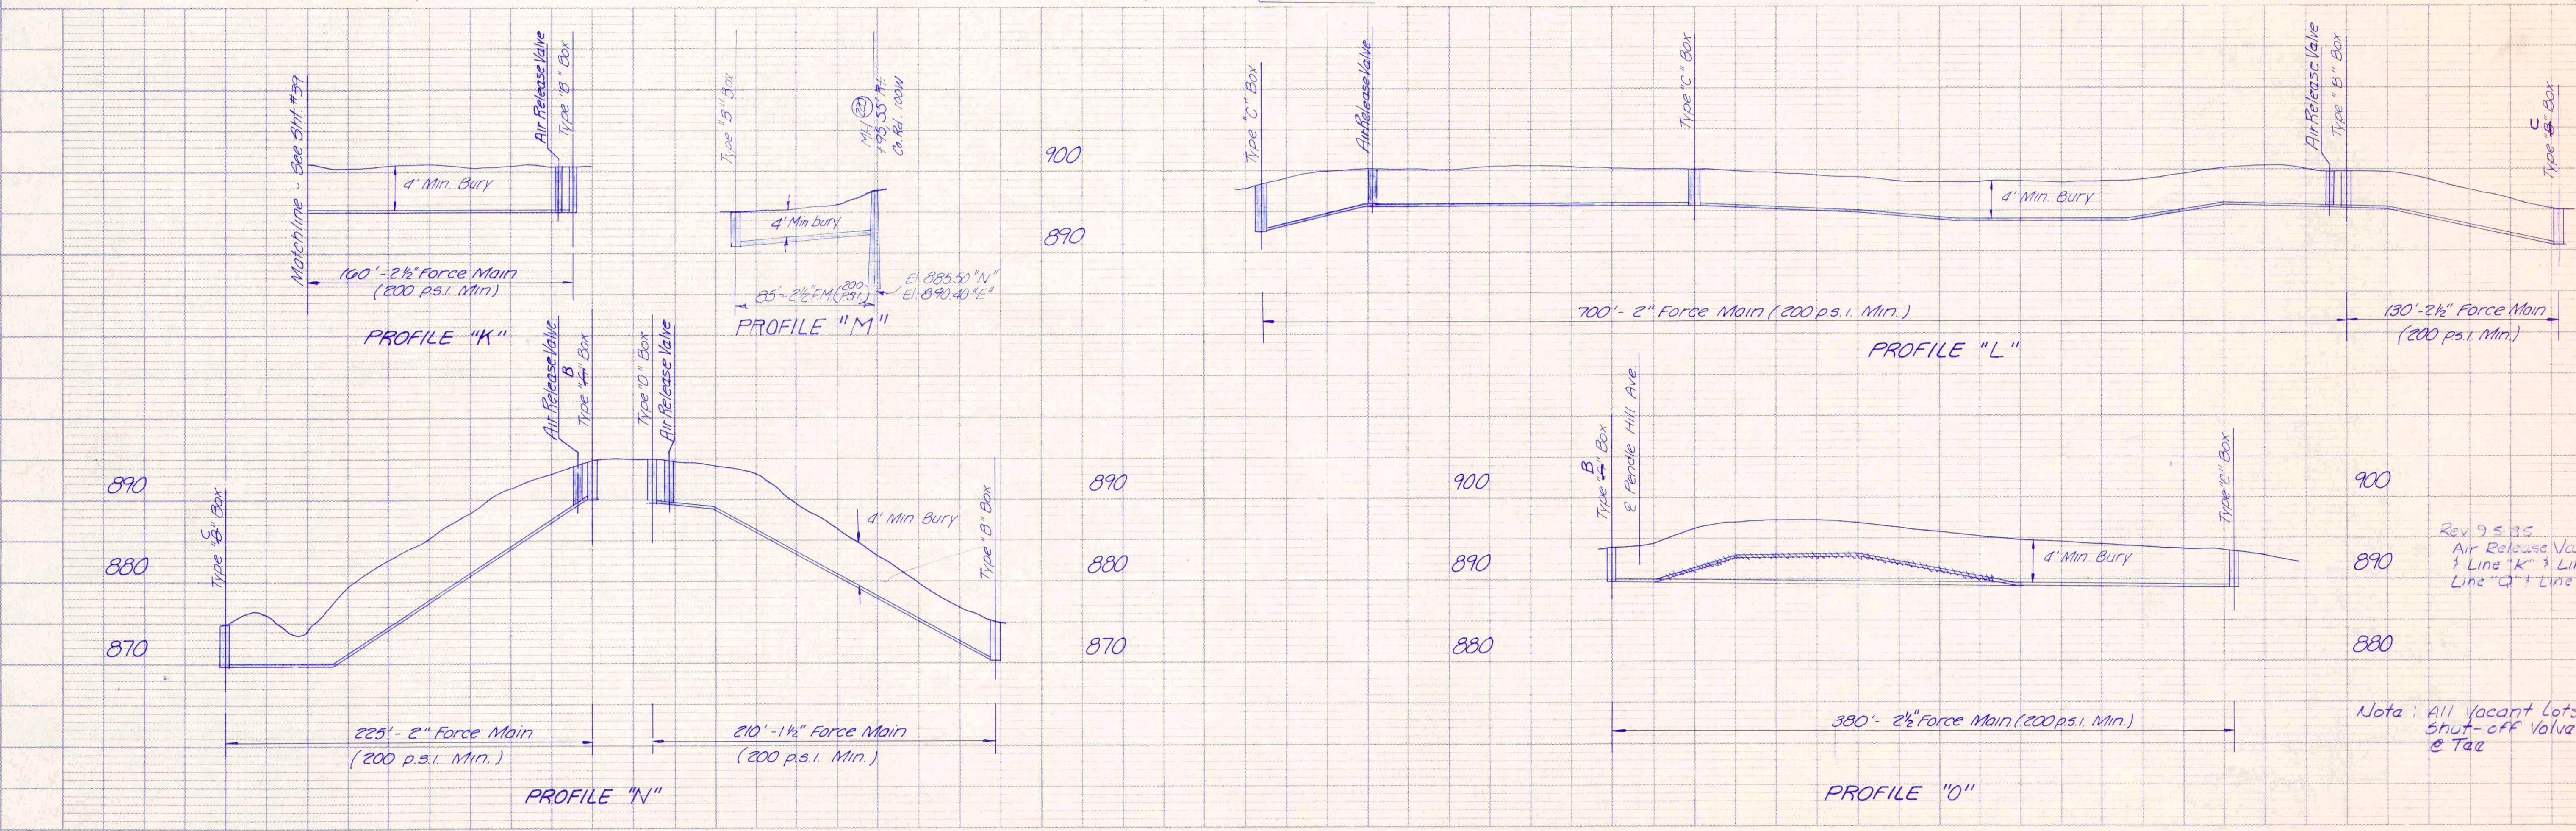


PLAN	DATE	
	BY	
	SURVEYED	
	NOTE BOOK	

PROFILE	DATE	
	BY	
	SURVEYED	
	NOTE BOOK	

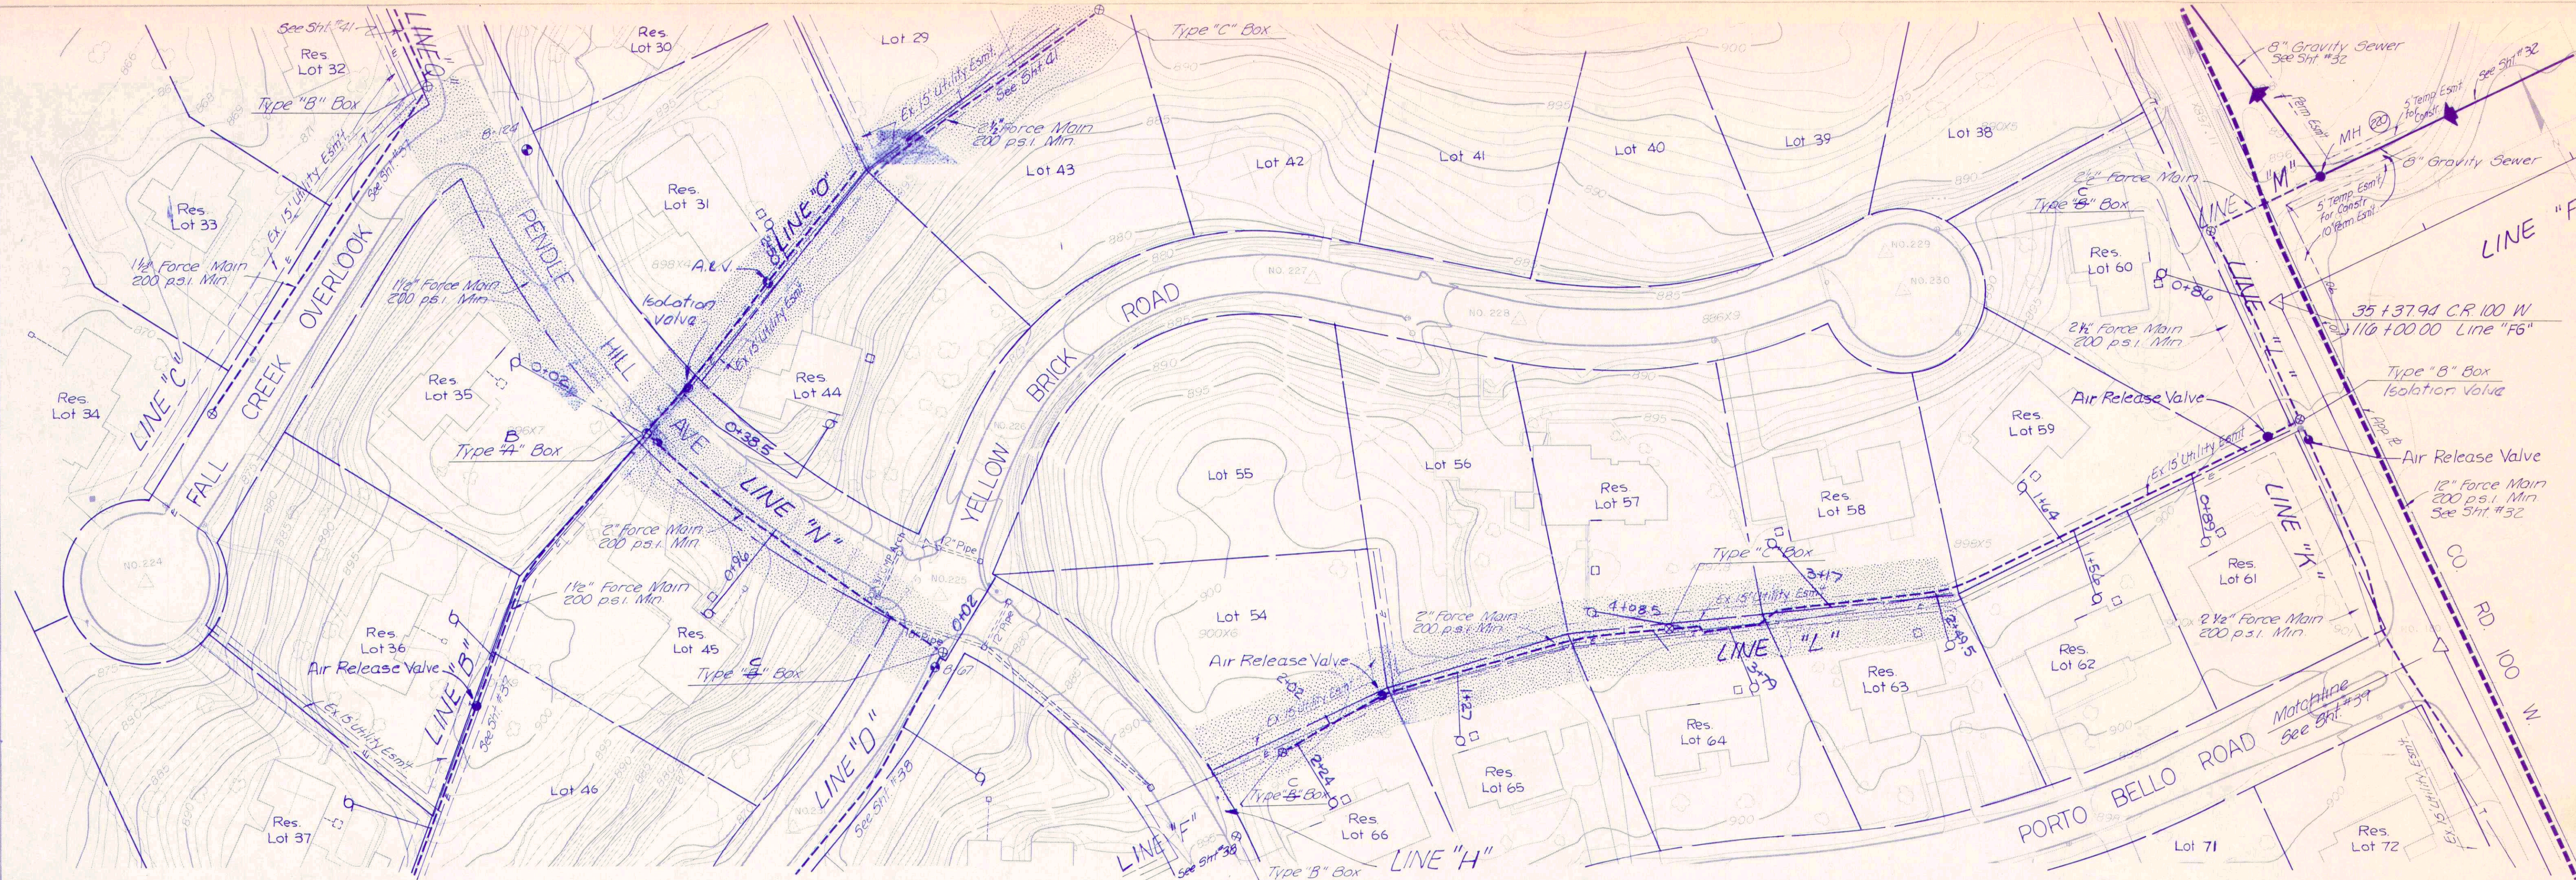

RECORD DRAWING