
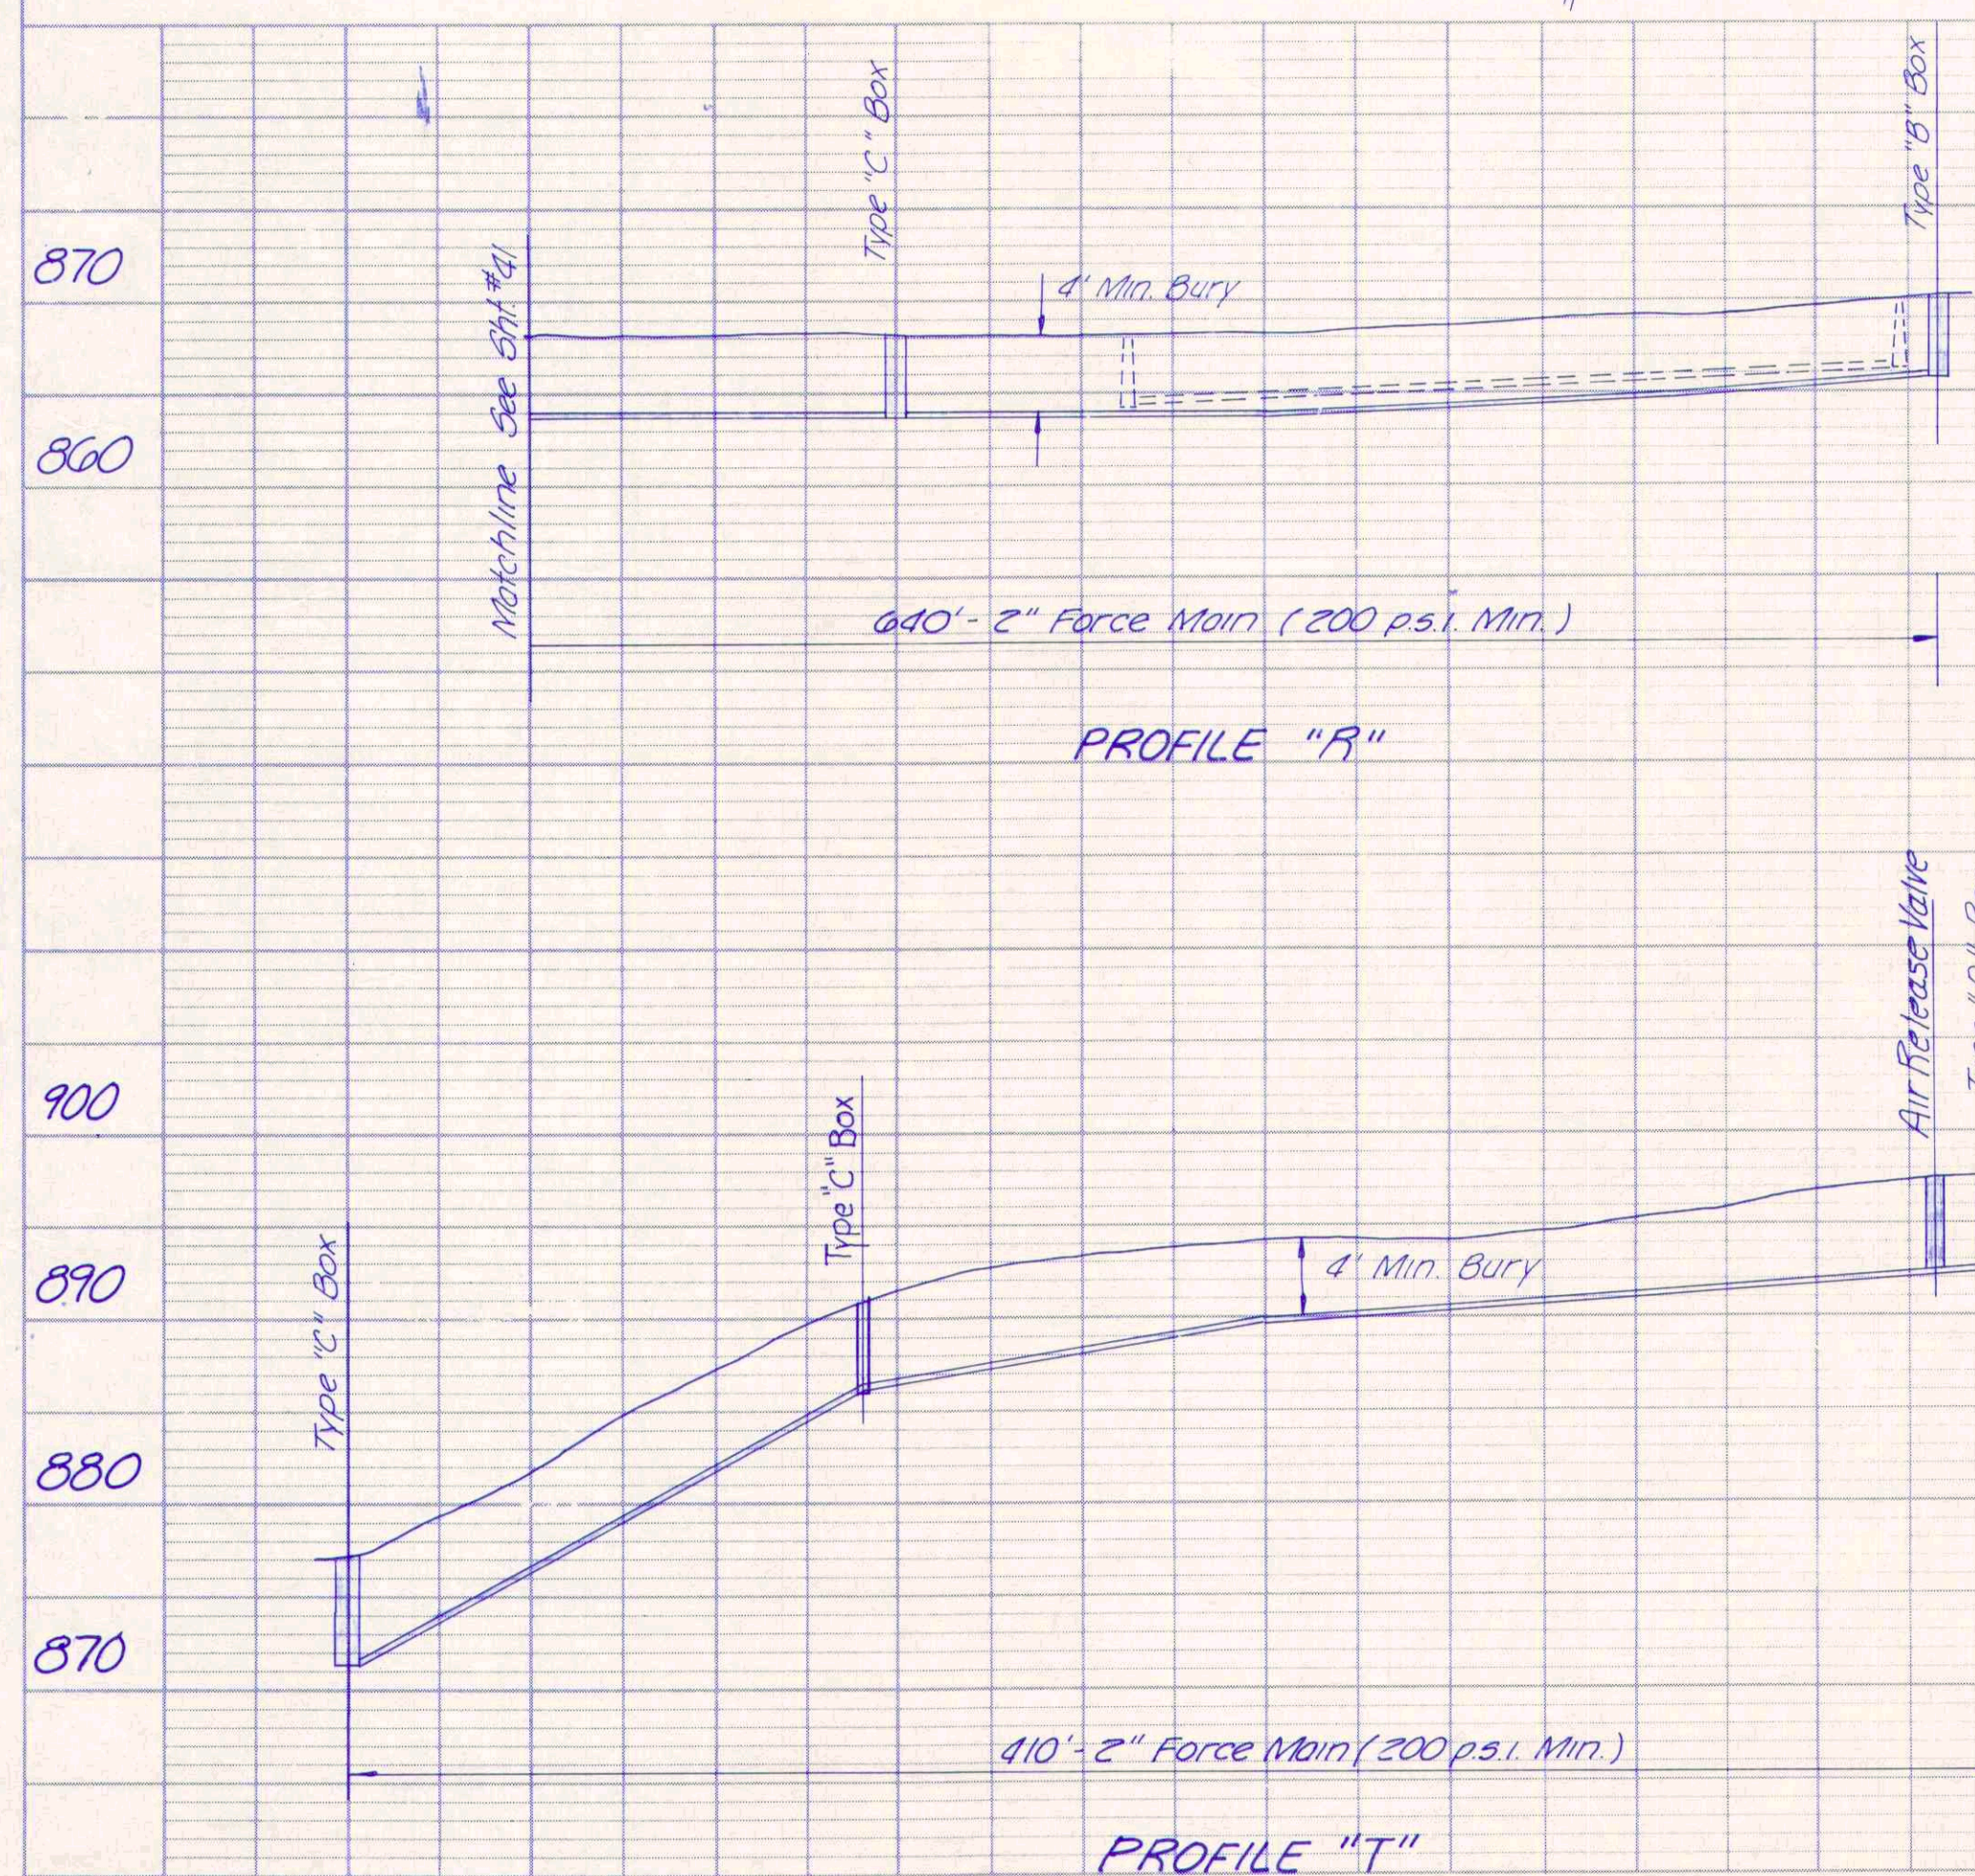


PLAN	DATE	BY	REVIEWED
	NO.	NO.	NO.
	NOTE: BOOK, PLOTTED, ALIGNMENT CHECKED, RT. OF WAY CHECKED		
	No.		

PROFILE	DATE	BY	REVIEWED
	NO.	NO.	NO.
	NOTE: BOOK, PLOTTED, GRADES CHECKED, E. & M. NOTED, STRUCTURE LOCATIONS CHECKED		
	No.		

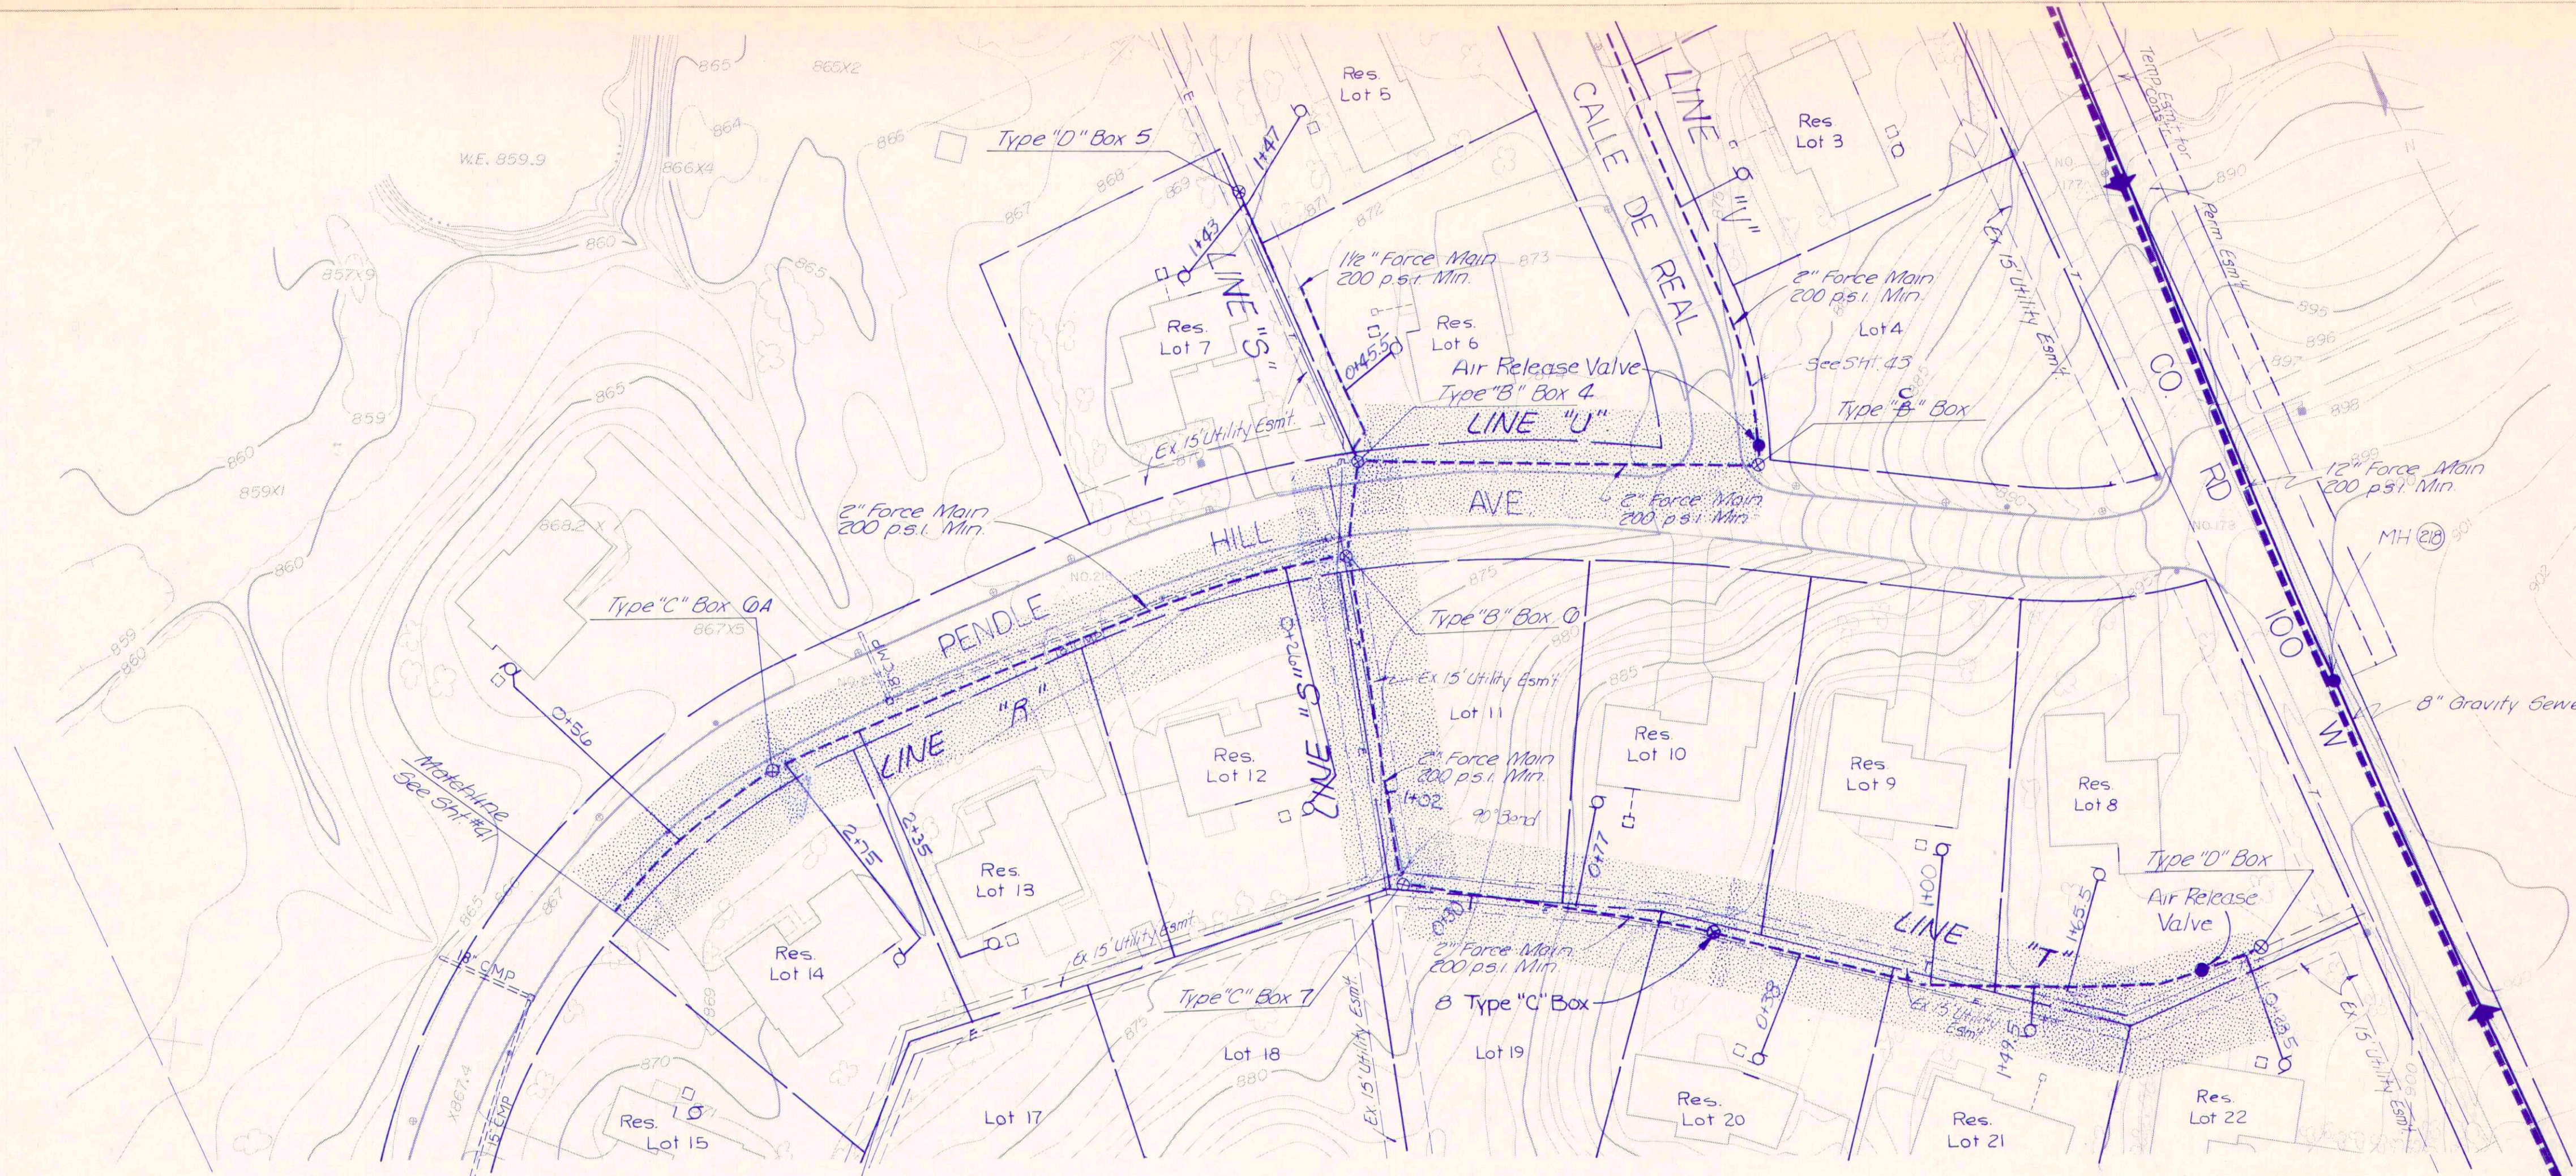

NOTE: PROFILE "S" SHIFTED TO FAR EAST SIDE OF EASEMENT IN ORDER TO SAVE EVERGREENS.

Revision 3-20-84 (As per Sht 32)

Note: All Vacant lots have 5" off valves installed & Td.

Rev 9-5-85 Air Release Valve Line "T" & Line "V"

RECORD DRAWING

