
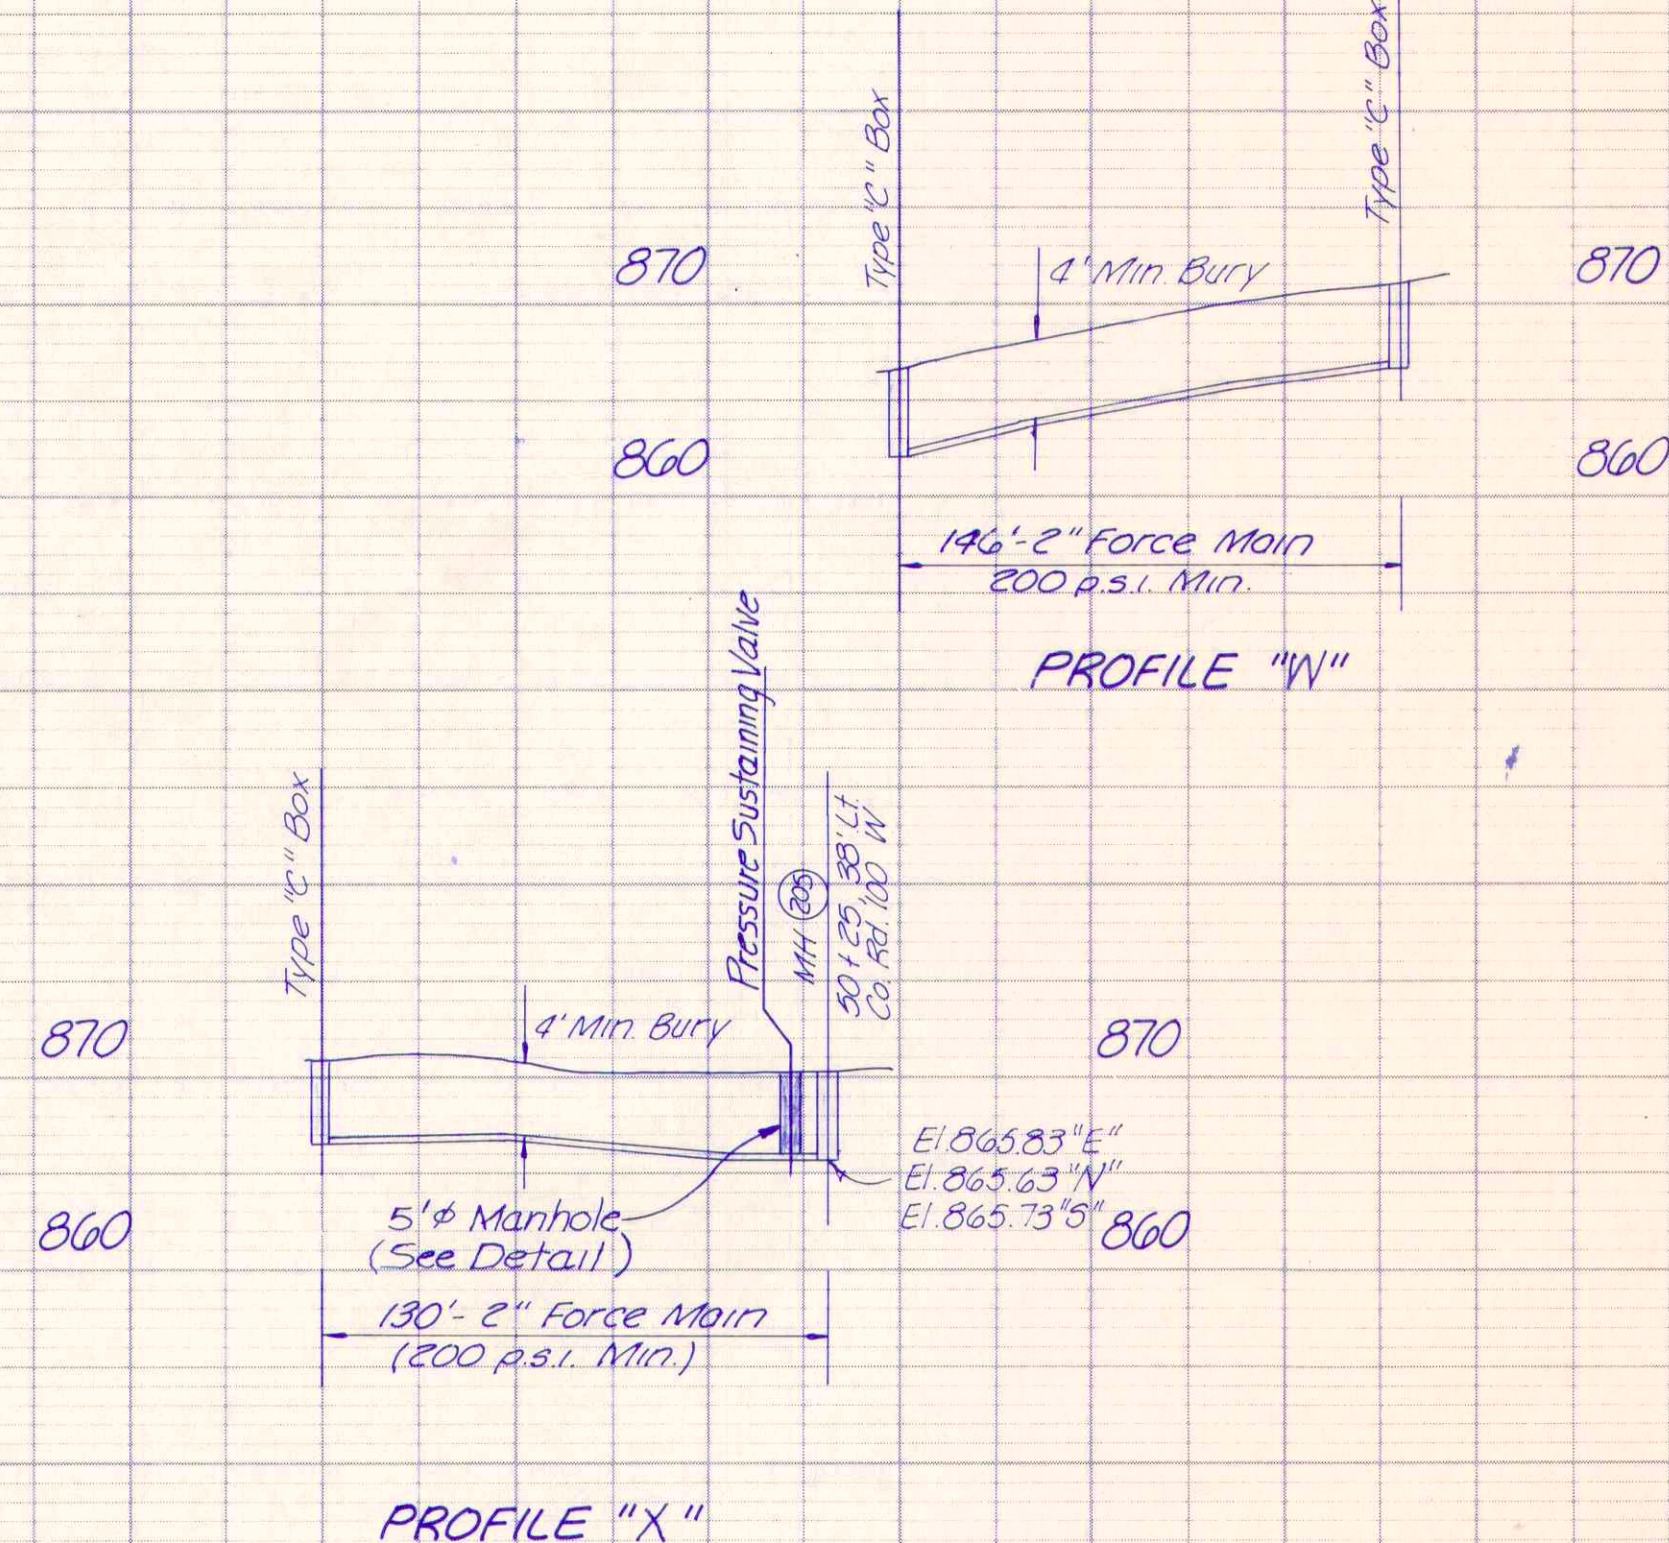
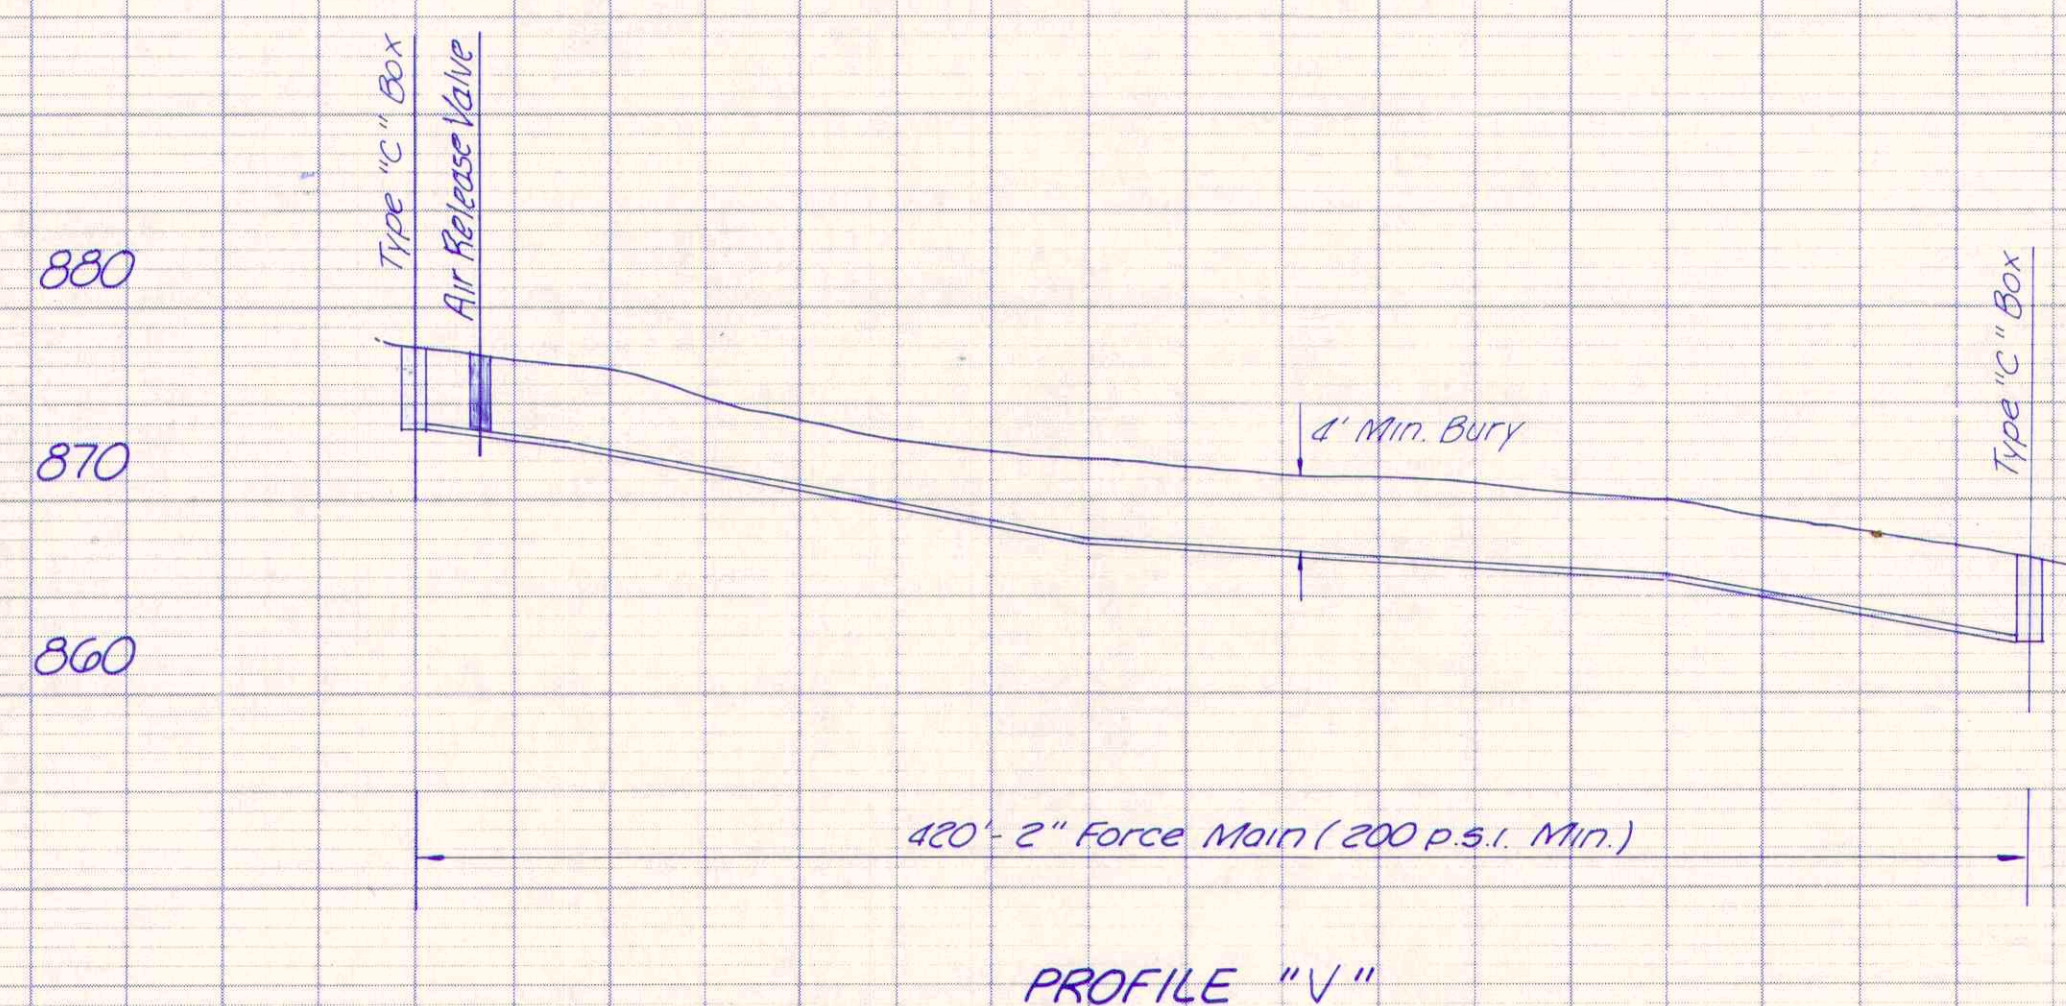


PLAN	DATE	BY
	CHECKED	NOTED
	ALIGNMENT CHECKED	BT OF WAY CHECKED
	NOTE BOOK	No.

PROFILE	DATE	BY
	CHECKED	NOTED
	GRADES CHECKED	E. M. NOTED
	NOTE BOOK	No.

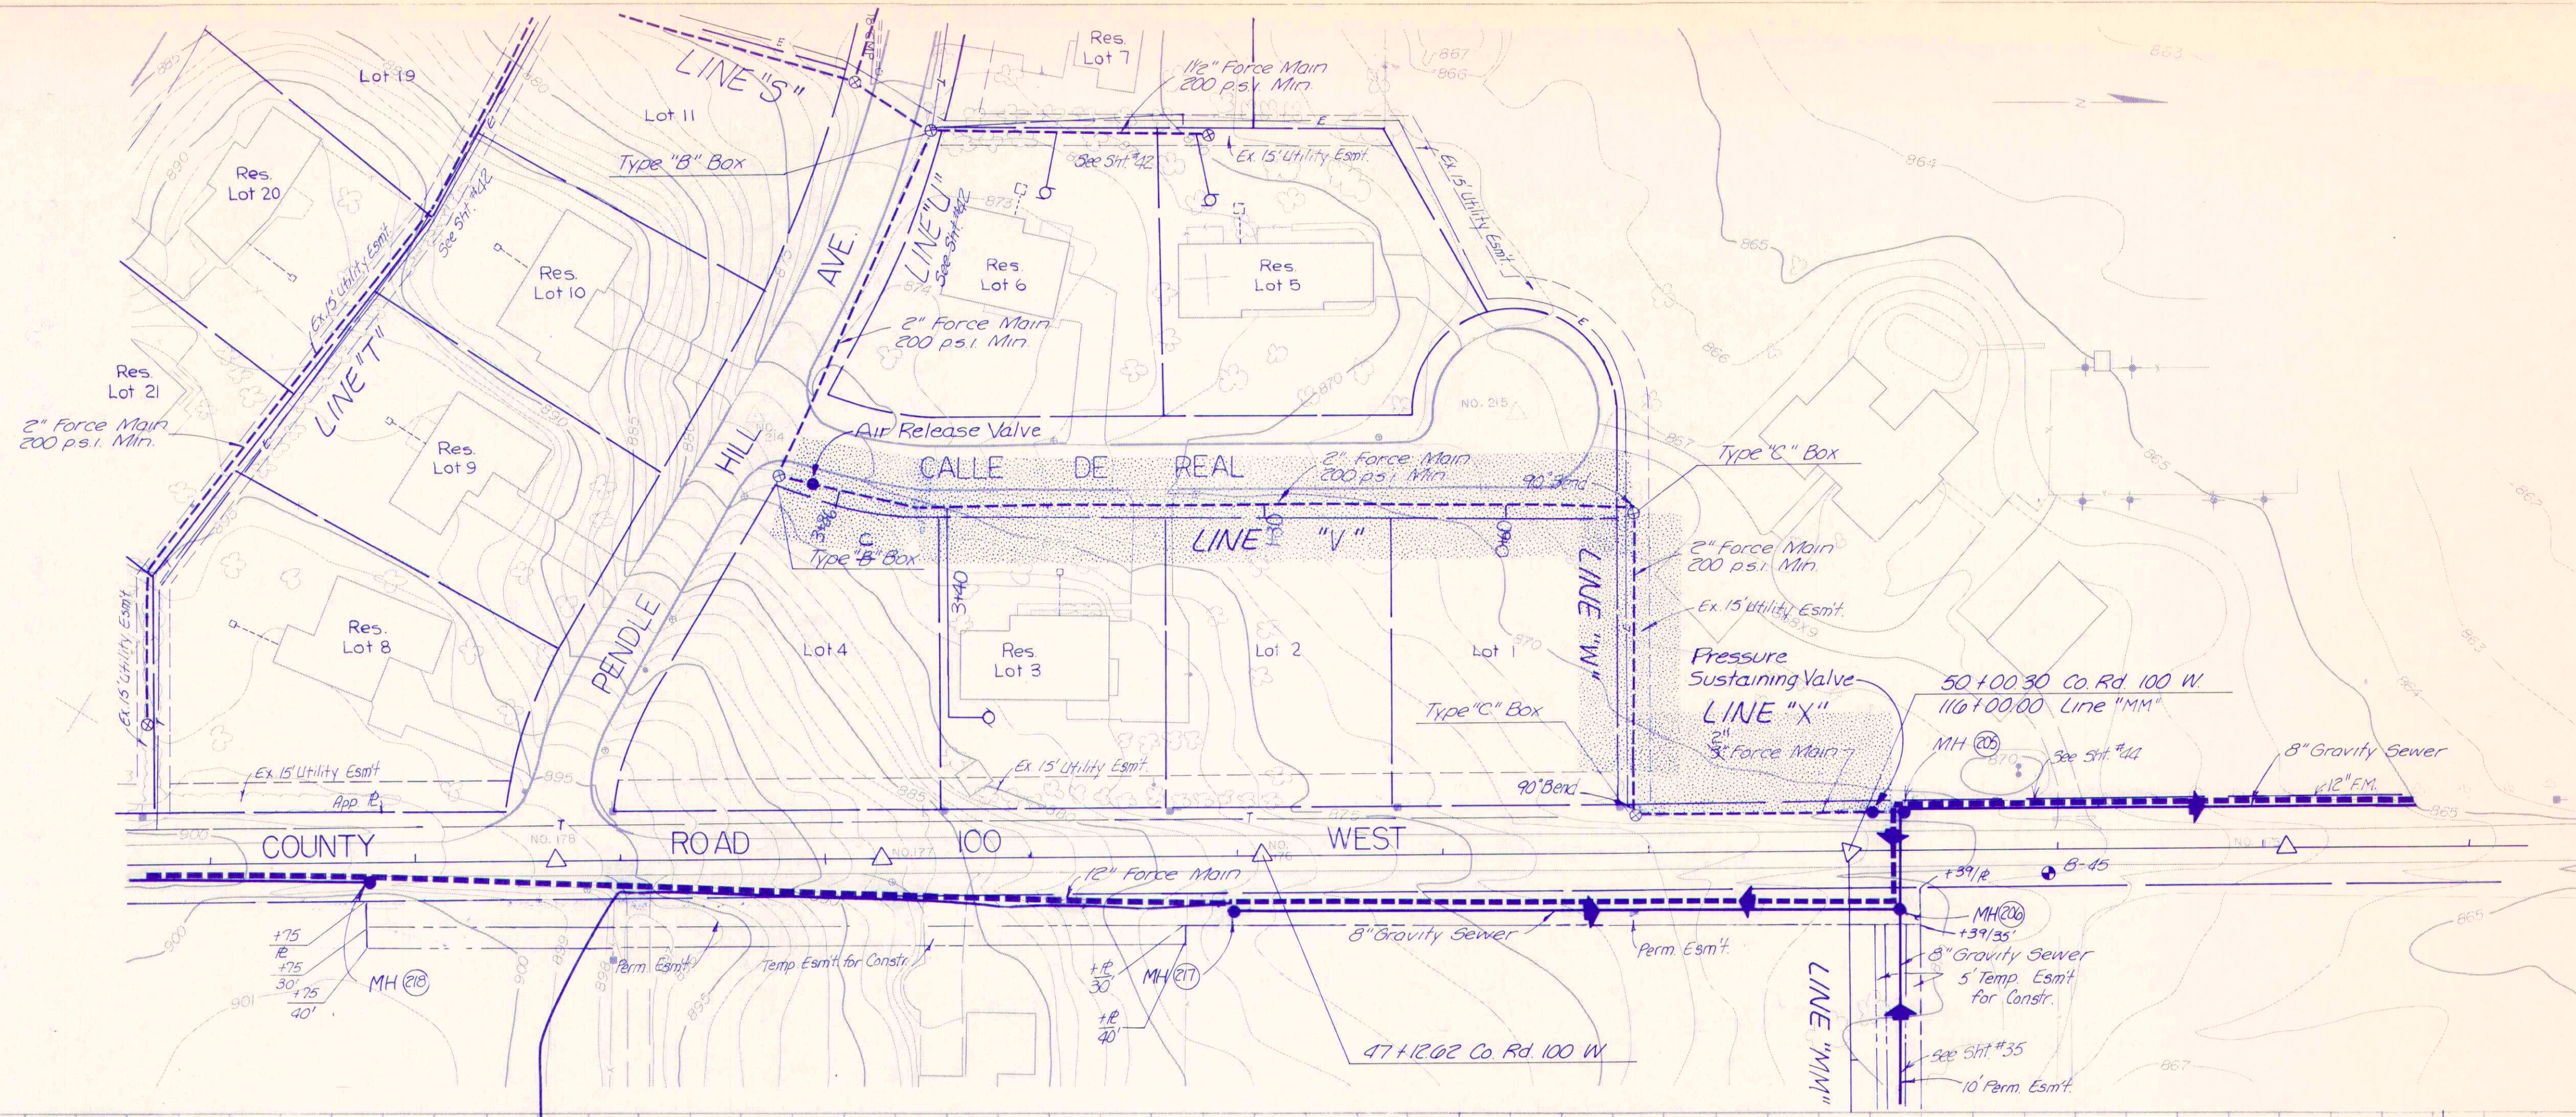

Revision: 3-21-84
(Change Distance of Line "W" & Revision as/ Sht. 32)

Rev. 9-5-85
Air Release Valve/ Pressure Sustaining Valve Line "X"

Note: All Vacant Lots Have shut-off Valve installed @ T&A

RECORD DRAWING



PENDLE HILL AVE. - CO. RD 100
CALLE DE REAL
FALL CREEK R.W.D. PLAN & PROFILE
HORIZ. 1"=50'
VERT. 1"=10'

BEAM, LONGEST & NEFF, INC.
CONSULTING ENGINEERS
INDIANAPOLIS, INDIANA